



4 INCH WHITE LINE, WATERBORNE PAINT &
 TEMPORARY 4 INCH WHITE LINE, PAINT
 (ALL LINES WILL INCLUDE EDGE LINE BREAKS
 AND RADII AT TOWN HIGHWAYS)
 MM 0.000 - MM 1.200 (SOLID LT & RT)

4 INCH YELLOW LINE, WATERBORNE PAINT &
 TEMPORARY 4 INCH YELLOW LINE, PAINT
 (ALL LINES WILL INCLUDE CENTERLINE BREAKS
 AT TOWN HIGHWAYS)
 MM 0.000 - MM 1.200 (SOLID LT & RT)

RAILROAD CROSSING SYMBOL, WATERBORNE PAINT &
 TEMPORARY RAILROAD CROSSING SYMBOL, PAINT
 MM 1.176 RT

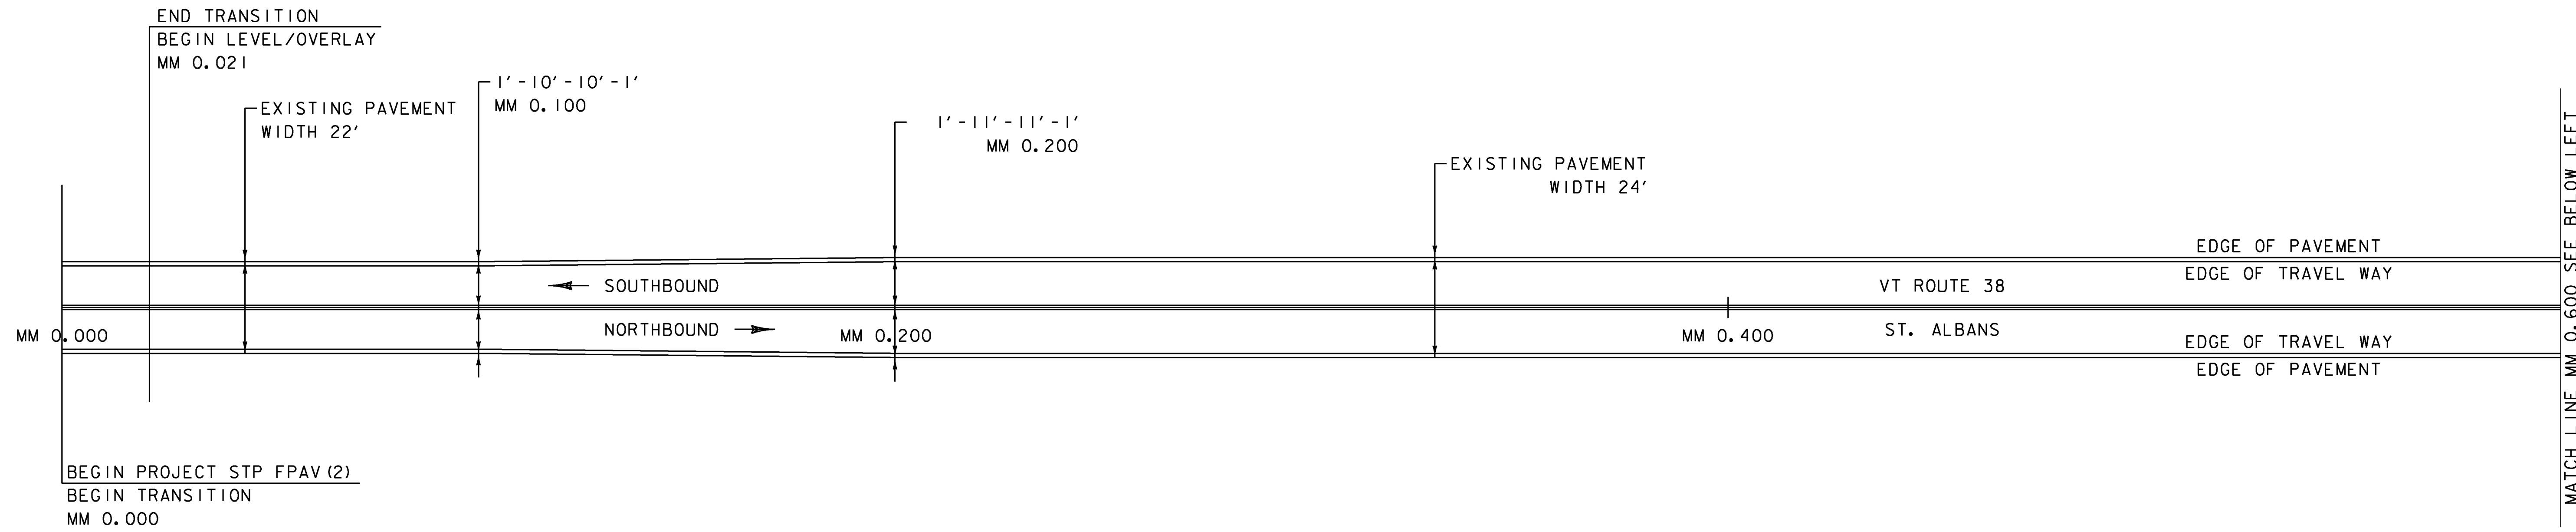

BEGIN PROJECT STP FPAV(2)
 BEGIN TRANSITION
 MM 0.000

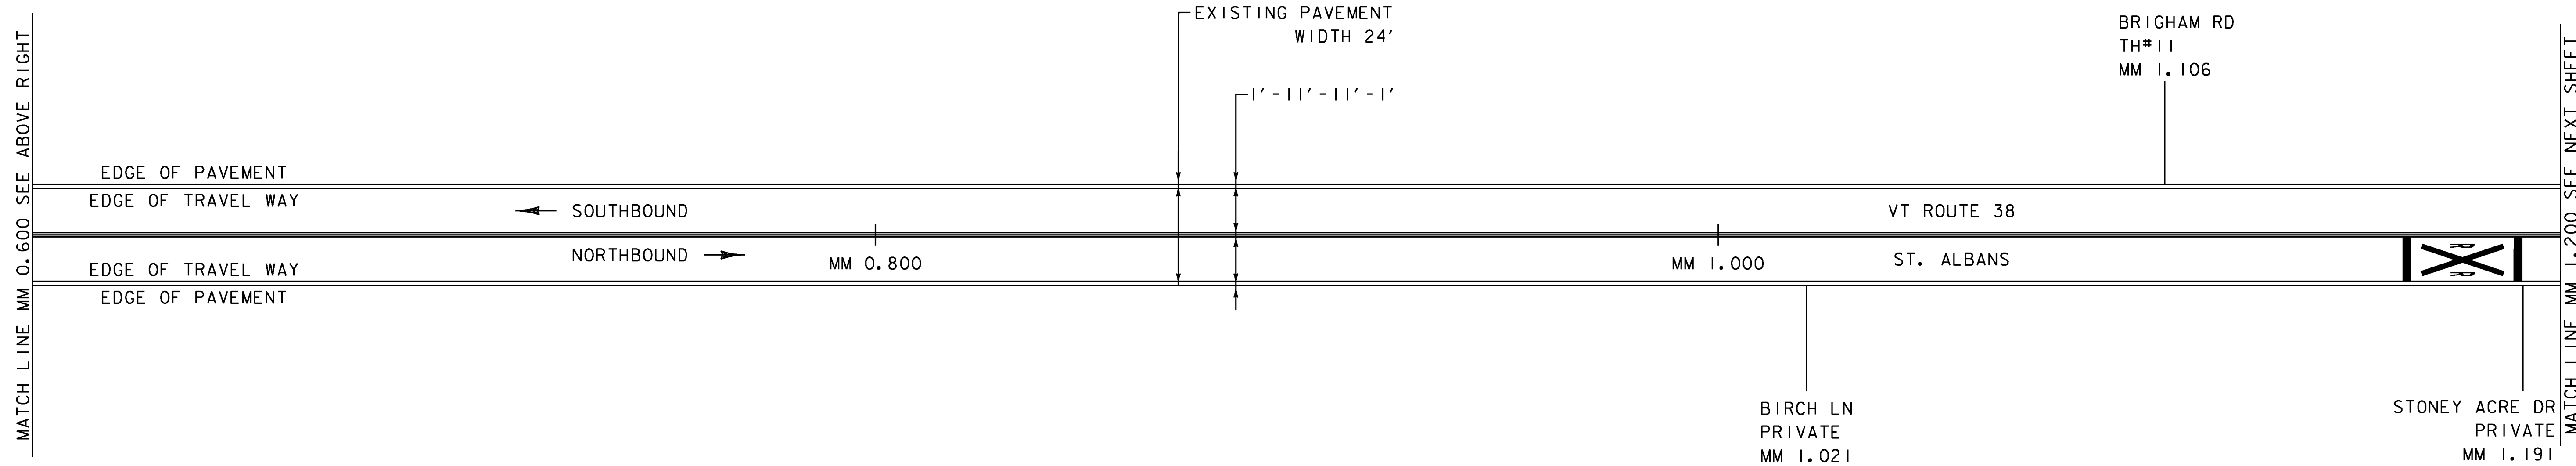

PROJECT NAME:	ST ALBANS TOWN
PROJECT NUMBER:	STP FPAV(2)
FILE NAME:	z16v023bdr.dgn
PROJECT LEADER:	C. LATHROP
DESIGNED BY:	J. GOODALL
PLAN SHEET I	
PLOT DATE:	05/10/2016
DRAWN BY:	J. GOODALL
CHECKED BY:	C. LATHROP
SHEET	29 OF 32

NOT TO SCALE