

STEEL BEAM GUARDRAIL, GALVANIZED

MM 2.331 - MM 2.338 LT
MM 2.331 - MM 2.338 RT
MM 2.349 - MM 2.356 LT
MM 2.354 - MM 2.361 RT

ANCHOR FOR STEEL BEAM RAIL

MM 2.331 LT
MM 2.331 RT
MM 2.356 LT
MM 2.361 RT

REMOVAL AND DISPOSAL OF GUARDRAIL

MM 2.331 - MM 2.338 LT
MM 2.331 - MM 2.338 RT
MM 2.349 - MM 2.356 LT
MM 2.354 - MM 2.361 RT

4 INCH WHITE LINE, WATERBORNE PAINT & TEMPORARY 4 INCH WHITE LINE, PAINT


(ALL LINES WILL INCLUDE EDGE LINE BREAKS AND RADII AT TOWN HIGHWAYS)
MM 1.200 - MM 2.400 (SOLID LT & RT)

4 INCH YELLOW LINE, WATERBORNE PAINT & TEMPORARY 4 INCH YELLOW LINE, PAINT

(ALL LINES WILL INCLUDE CENTERLINE BREAKS AT TOWN HIGHWAYS)
MM 1.200 - MM 2.060 (SOLID LT & RT)
MM 2.060 - MM 2.140 (SOLID LT, DASHED RT)
MM 2.140 - MM 2.260 (DASHED CTR)
MM 2.260 - MM 2.335 (DASHED LT, SOLID RT)
MM 2.335 - MM 2.400 (SOLID LT, DASHED RT)

RAILROAD CROSSING SYMBOL, WATERBORNE PAINT & TEMPORARY RAILROAD CROSSING SYMBOL

MM 1.486 LT

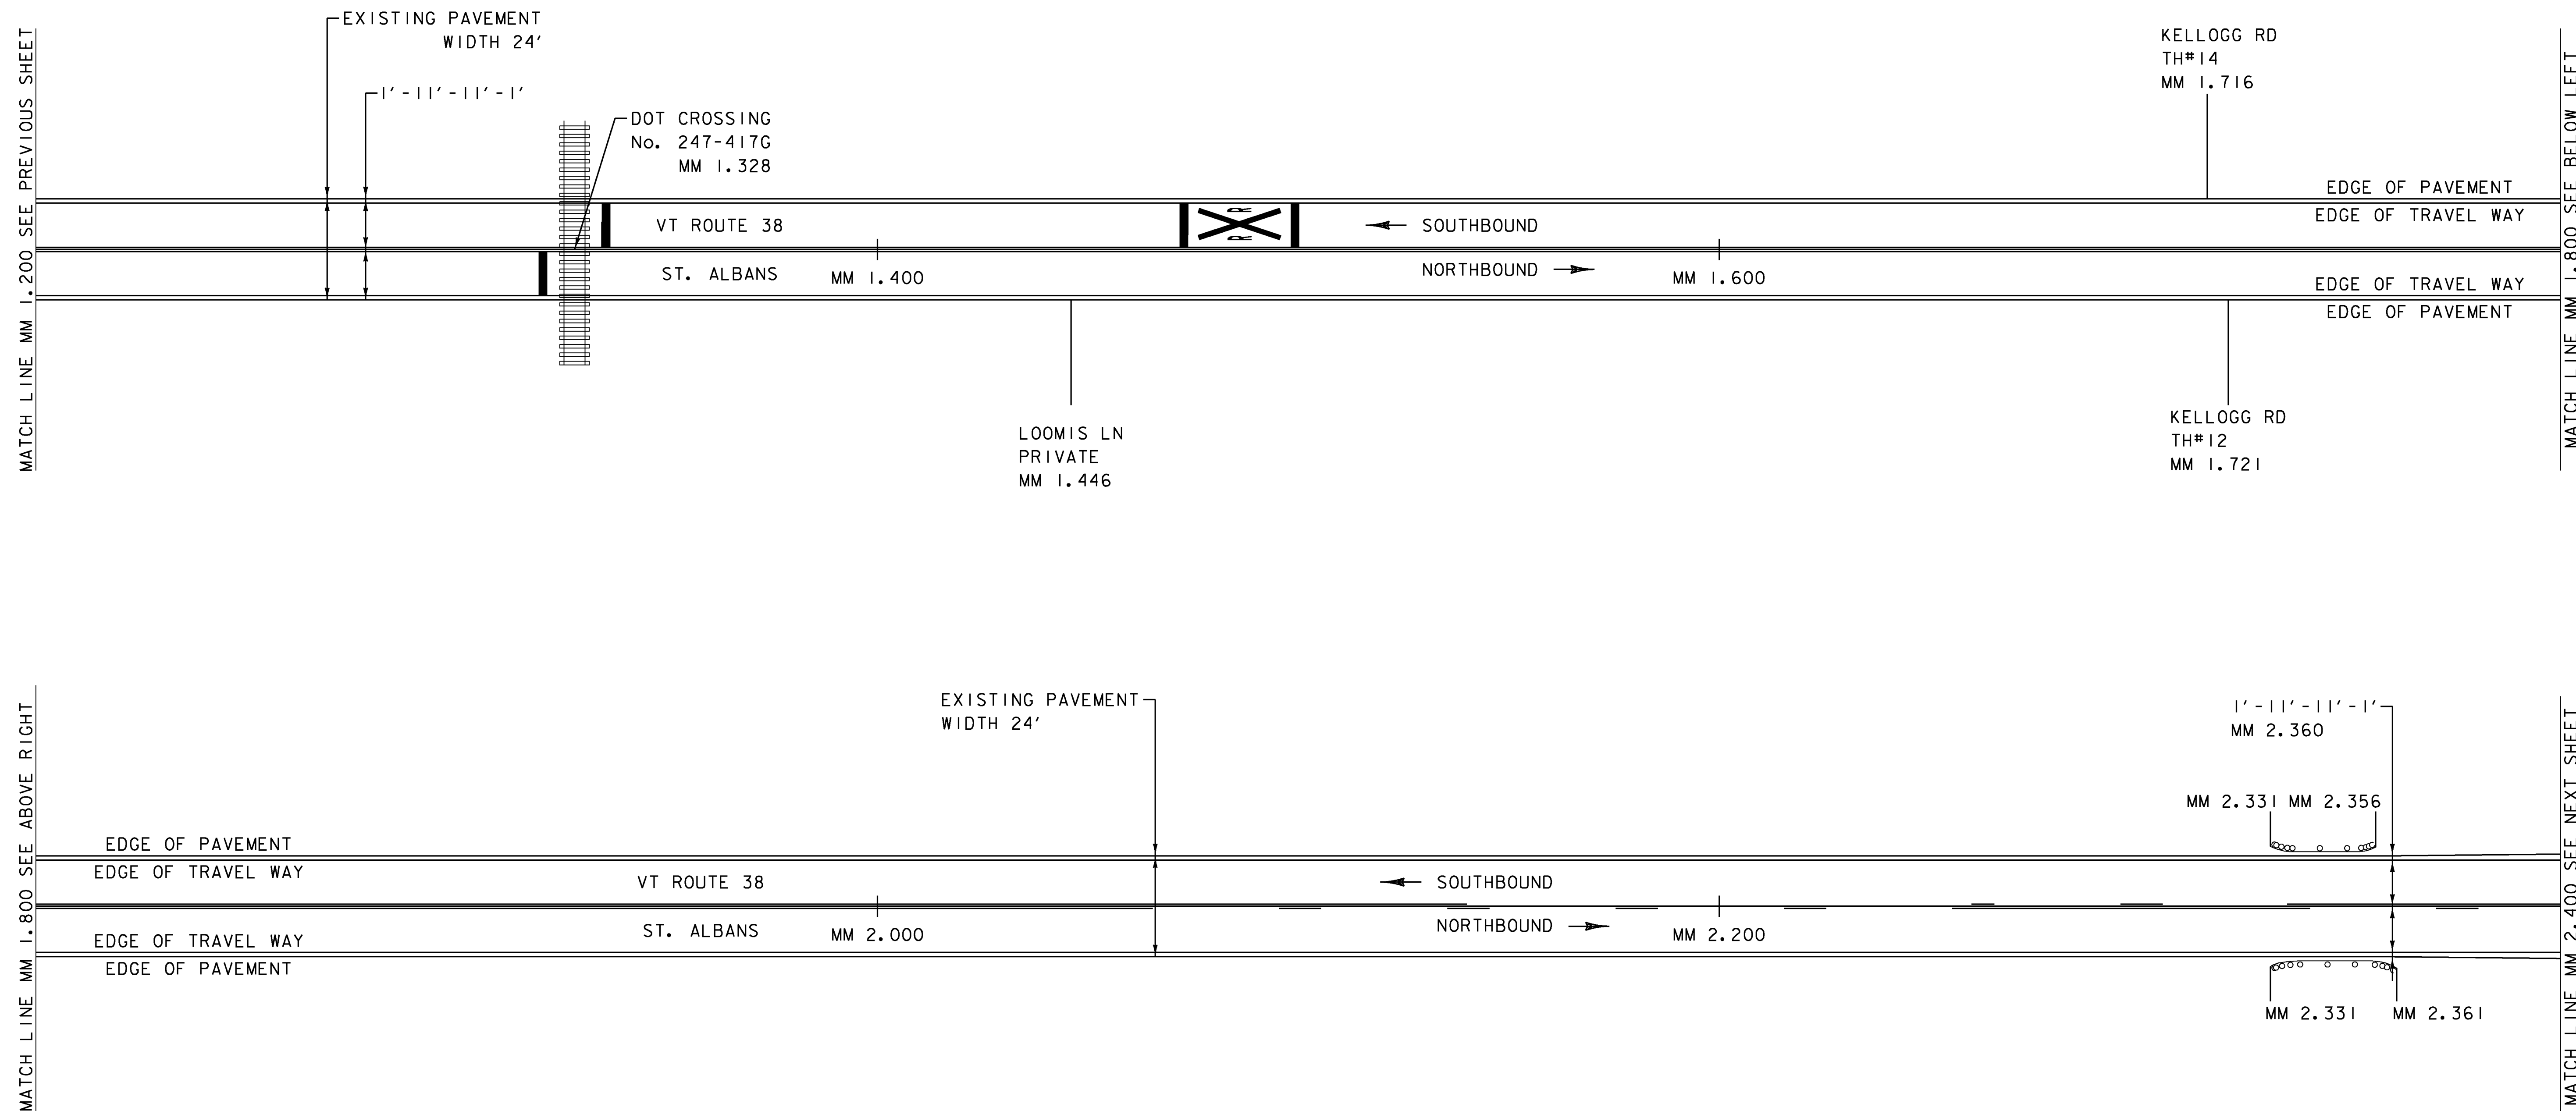

PROJECT NAME:	ST ALBANS TOWN
PROJECT NUMBER:	STP FPAV(2)
FILE NAME:	z16v023bdr.dgn
PROJECT LEADER:	C. LATHROP
DESIGNED BY:	J. GOODALL
PLAN SHEET 2	
PLOT DATE:	05/10/2016
DRAWN BY:	J. GOODALL
CHECKED BY:	C. LATHROP
SHEET	30 OF 32

NOT TO SCALE