



STATE OF VERMONT AGENCY OF TRANSPORTATION

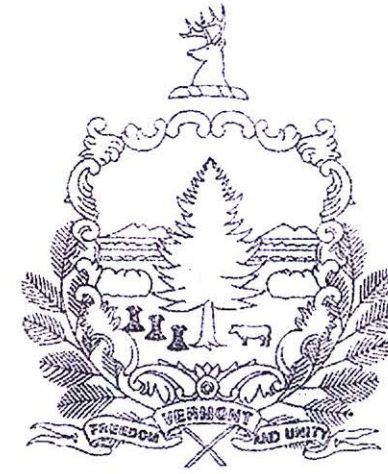

PROPOSED IMPROVEMENT TOWNS OF ST. GEORGE AND WILLISTON COUNTY OF CHITTENDEN VT ROUTE 2A - MINOR ARTERIAL / MAJOR COLLECTOR

BEGINNING IN THE TOWN OF ST. GEORGE AT THE INTERSECTION OF
VT ROUTE 116 AND VT ROUTE 2A (MM 0.018) AND EXTENDING NORTHERLY
ALONG VT ROUTE 2A THROUGH THE TOWN OF ST. GEORGE AND INTO WILLISTON
FOR A DISTANCE OF APPROXIMATELY 4.768 MILES TO MM 2.804


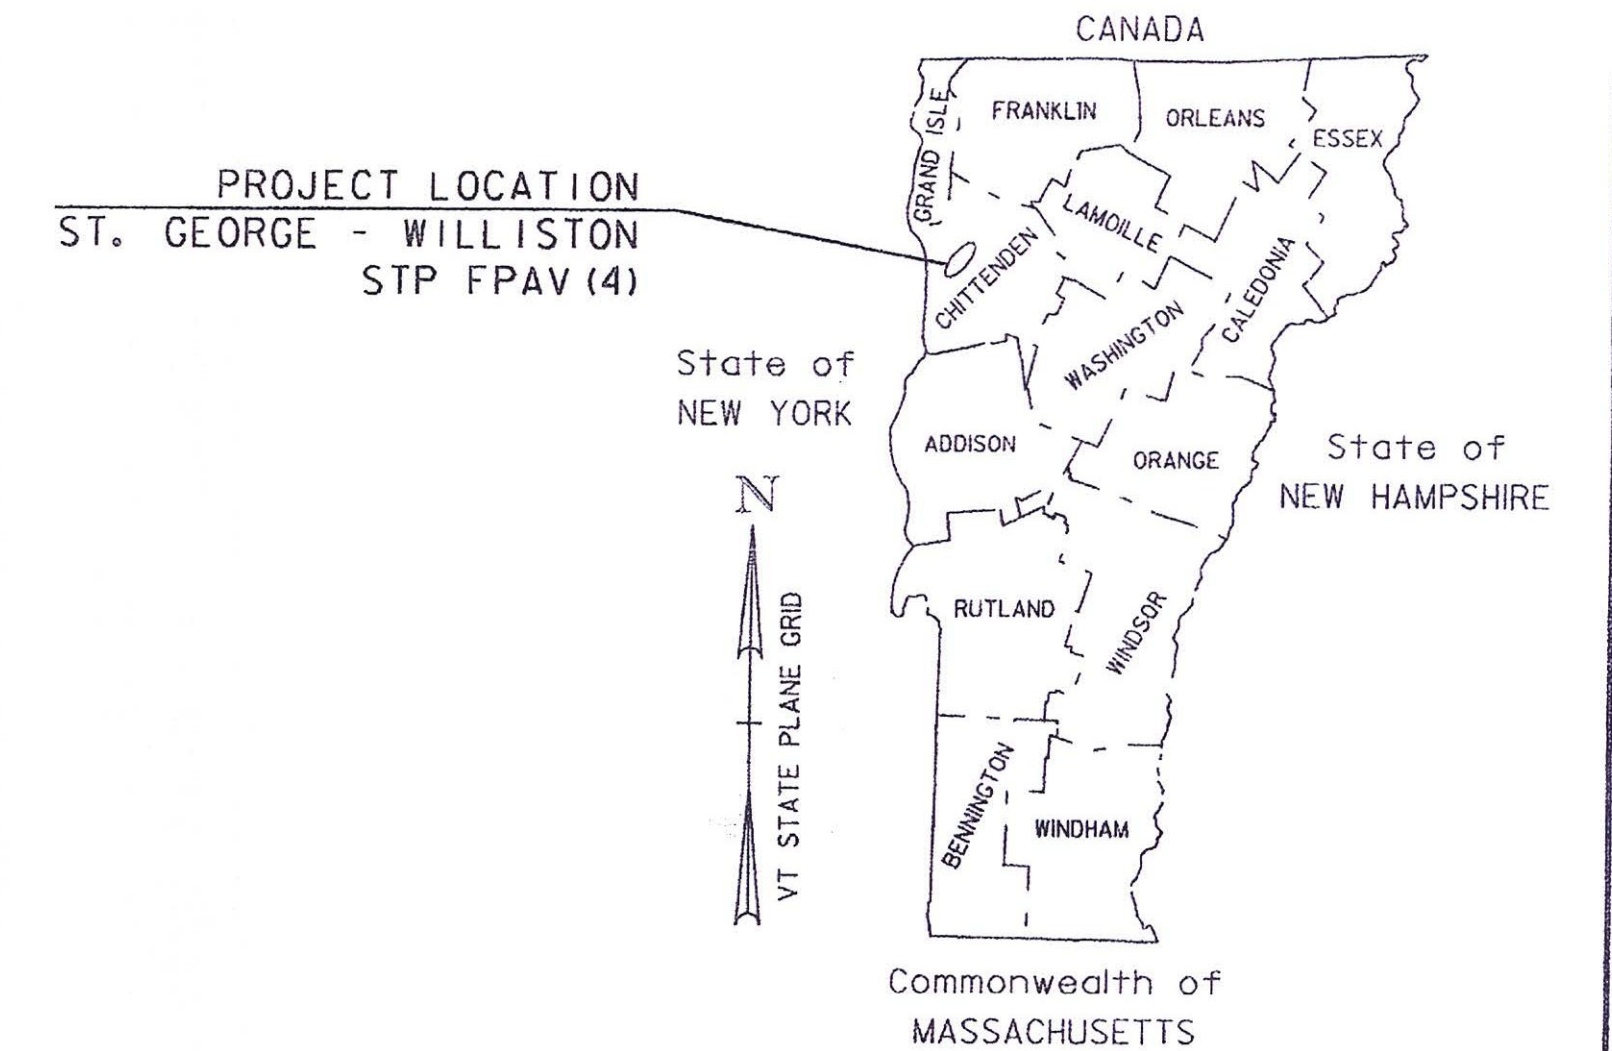


RECORD PLANS	
CONTRACTOR:	ENGINEERS CONSTRUCTION, INC. - S. BURLINGTON, VT
RESIDENT ENGINEER:	CHRIS ACHILLES
CONSTRUCTION BEGAN:	AUGUST 26, 2016
CONSTRUCTION COMPLETE:	NOVEMBER 9, 2016
RECORD PLANS BY:	CHRIS ACHILLES & JESSE IVES
I HEREBY CERTIFY THAT ALL THE CONSTRUCTION REQUIRED BY THIS SET OF DRAWINGS HAS BEEN ACCOMPLISHED AS INDICATED HEREIN.	
BY	RESIDENT ENGINEER
DATE	12/22/17
NOTE: Any further information concerning final quantities, amounts or other details relative to this project may be found at Central Files in the electronic archives.	

	LENGTH
	(FEET) (MILES)
TOWN OF ST. GEORGE MM 0.018 TO MM 1.982	10,369.92 = 1.964
TOWN OF WILLISTON MM 0.000 TO MM BT 2.804	14,805.12 = 2.804
PROJECT TOTALS	25,175.04 = 4.768

RECORD PLANS
See changes on pages 10,11,12,13


WORK TO BE PERFORMED UNDER THIS PROJECT INCLUDES COLD PLANING, RESURFACING EXISTING HIGHWAY WITH A BITUMINOUS CONCRETE LEVELING COURSE AND A WEARING COURSE, NEW GUARDRAIL, PAVEMENT MARKINGS, AND OTHER HIGHWAY RELATED ITEMS.

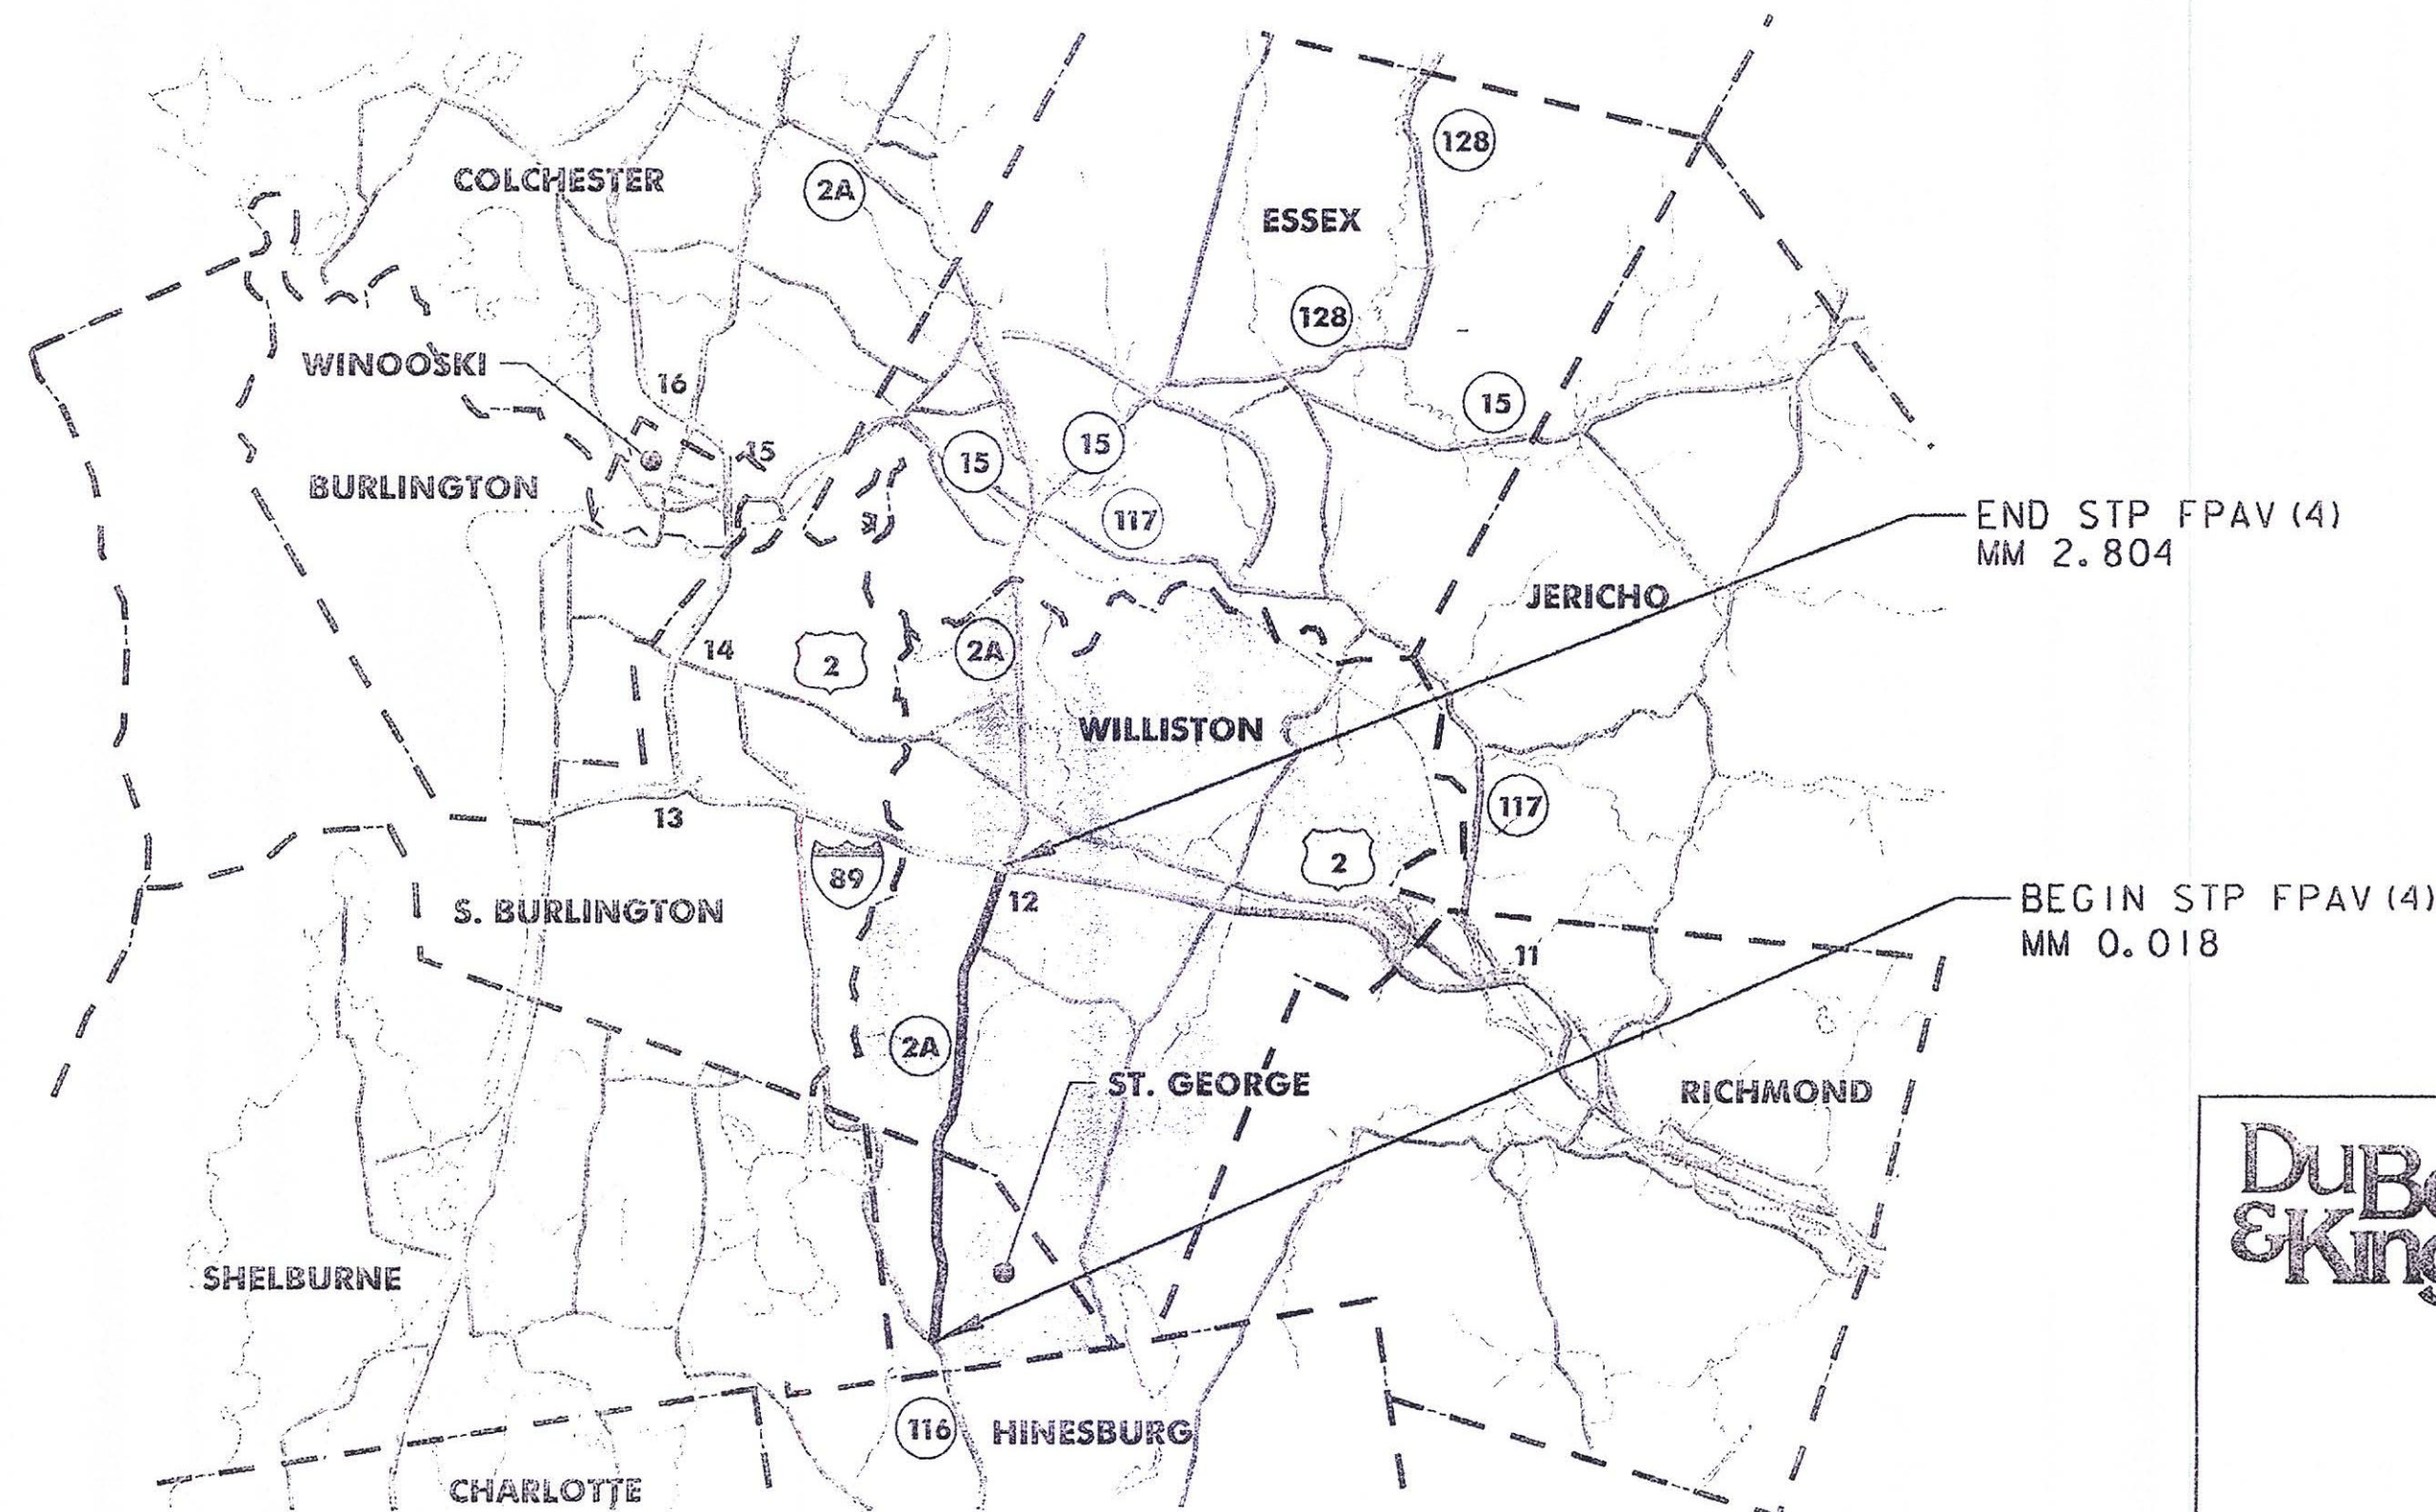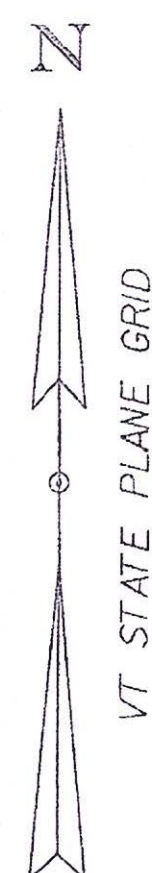

CONSTRUCTION IS TO BE CARRIED ON IN ACCORDANCE WITH THESE PLANS AND THE STANDARD SPECIFICATIONS FOR CONSTRUCTION DATED 2011, AS APPROVED BY THE FEDERAL HIGHWAY ADMINISTRATION ON JULY 20, 2011 FOR USE ON THIS PROJECT, INCLUDING ALL SUBSEQUENT REVISIONS AND SUCH REVISED SPECIFICATIONS AND SPECIAL PROVISIONS AS ARE INCORPORATED IN THESE PLANS.

QUALITY ASSURANCE PROGRAM : LEVEL 3	
SURVEYED BY :	N/A
SURVEYED DATE :	N/A
DATUM	
VERTICAL	N/A
HORIZONTAL	N/A

DuBois & King inc.

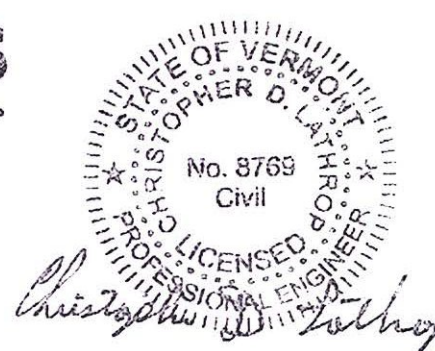

DIRECTOR OF PROJECT DELIVERY	
APPROVED	DATE 6/6/16
PROJECT MANAGER : MICHAEL J. FOWLER, P.E.	
PROJECT NAME : ST. GEORGE - WILLISTON	
PROJECT NUMBER : STP FPAV(4)	
SHEET 1 OF 18 SHEETS	