


Refreshed existing paint lines/symbols/lettering due to poor visibility and at request of district.

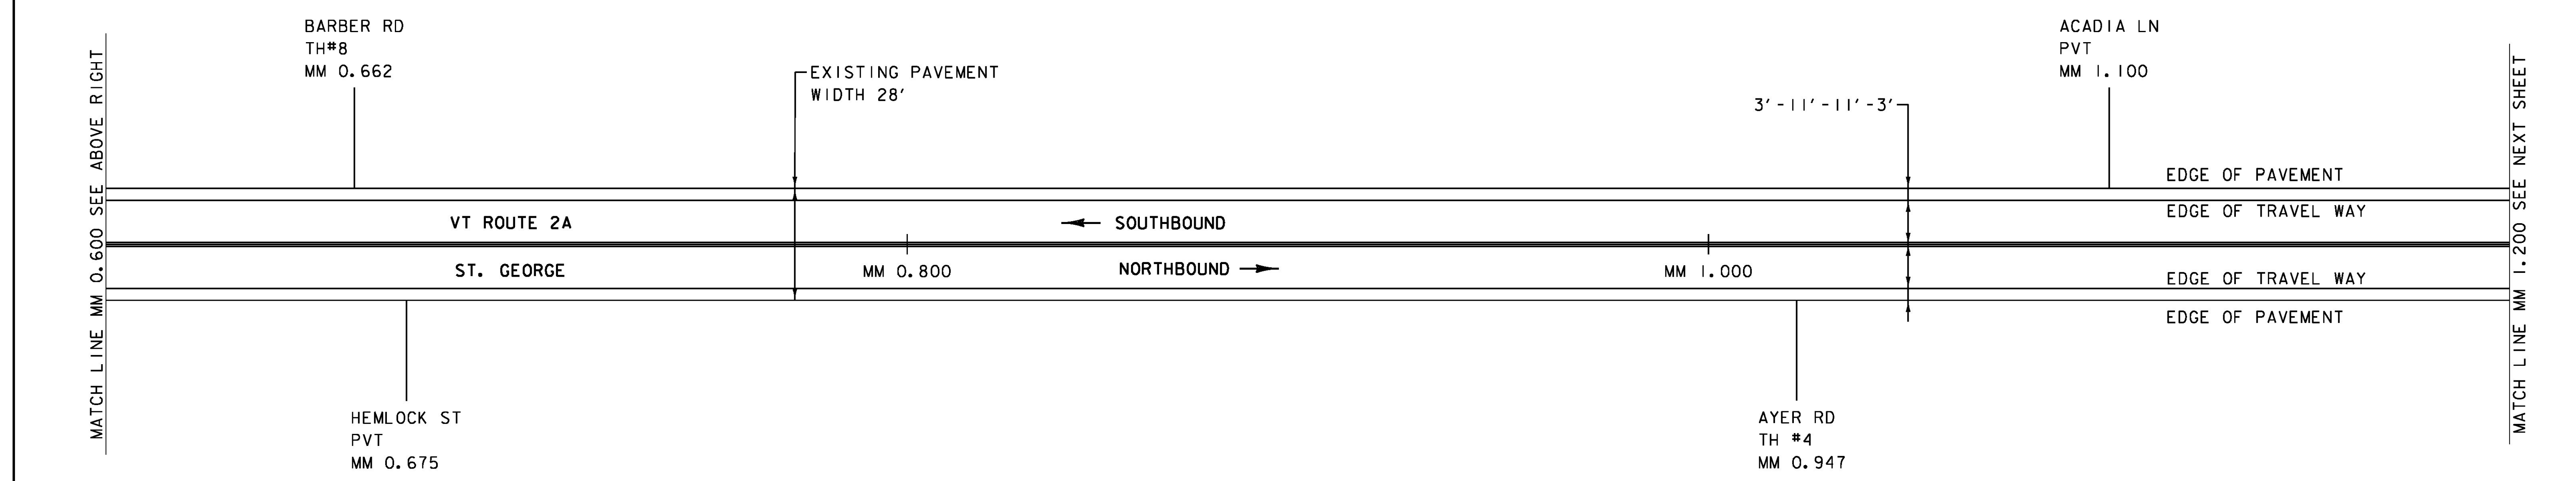

PROJECT NAME:	ST. GEORGE-WILLISTON
PROJECT NUMBER:	STP FPAV(4)
FILE NAME: z16v025bdr.dgn	PLOT DATE: 05/16/2016
PROJECT LEADER: C. LATHROP	DRAWN BY: J. GOODALL
DESIGNED BY: J. GOODALL	CHECKED BY: C. LATHROP
PLAN SHEET 1	SHEET 10 OF 18

NOT TO SCALE