
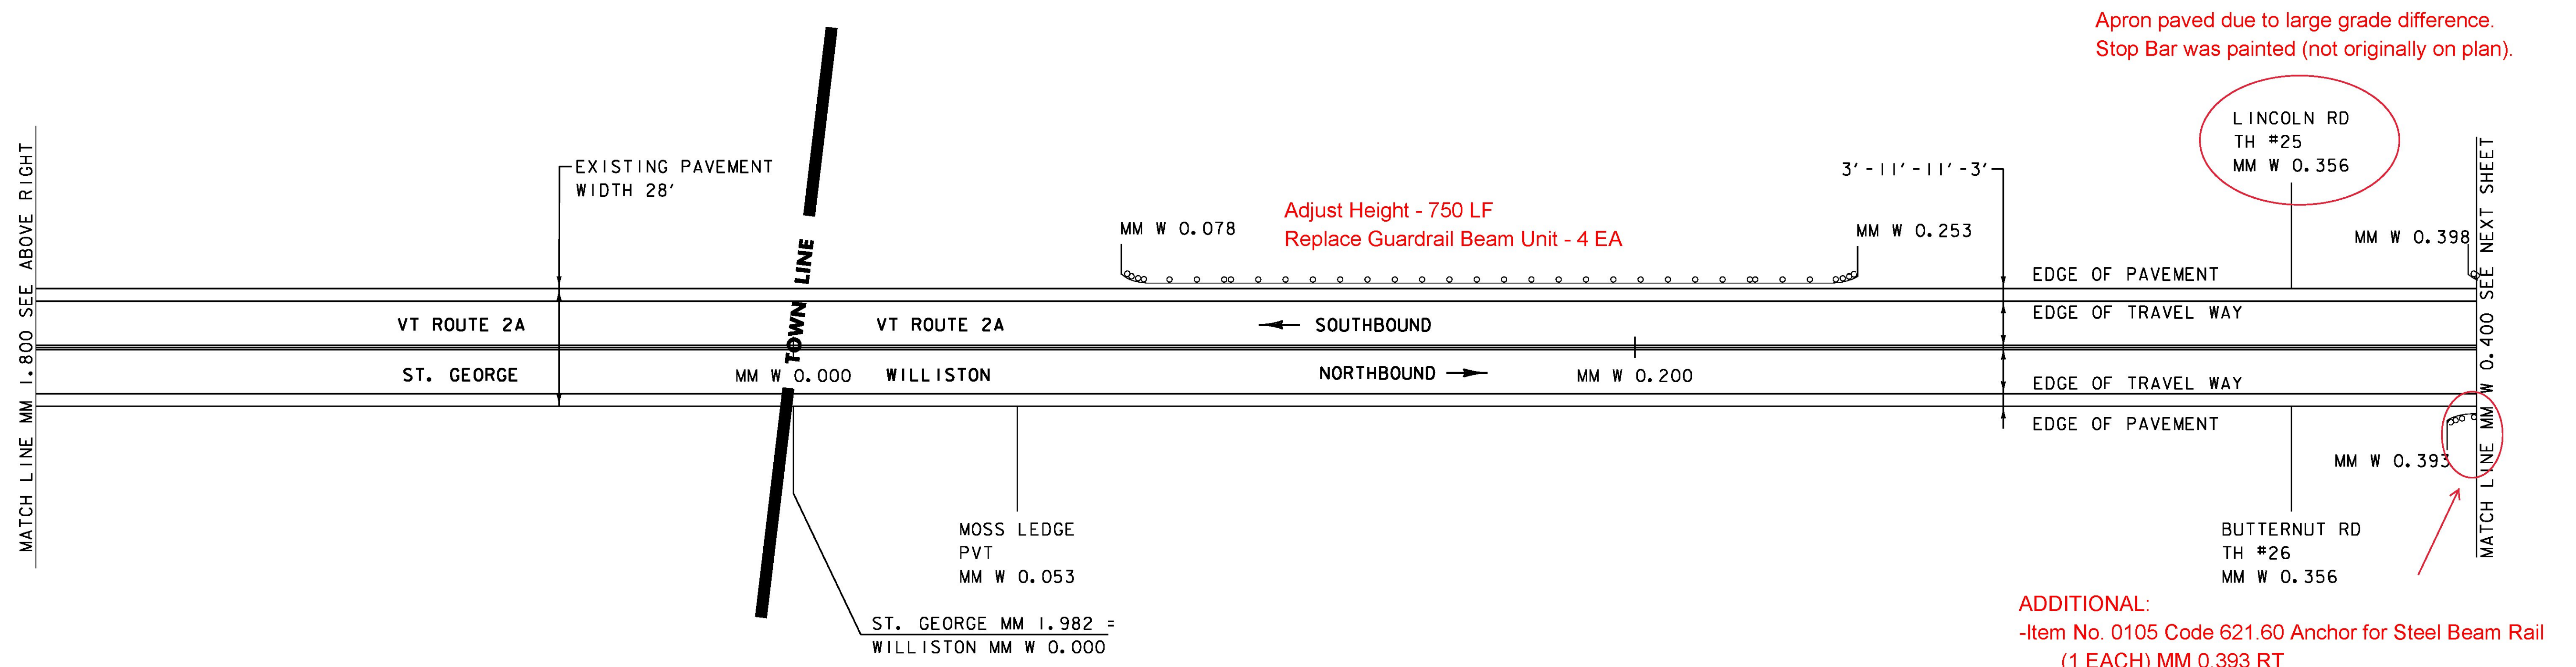


ADJUST HEIGHT OF GUARDRAIL
 MM W 0.393 - MM W 0.400 RT
 MM W 0.398 - MM W 0.400 LT

4 INCH WHITE LINE, WATERBORNE PAINT &
 TEMPORARY 4 INCH WHITE LINE, PAINT
 (ALL LINES WILL INCLUDE EDGE LINE BREAKS
 AND RADII AT TOWN HIGHWAYS)
 MM 1.200 - MM 1.982 (SOLID LT & RT EDGE LINE)
 MM W 0.000 - MM W 0.400 (SOLID LT & RT EDGE LINE)

4 INCH YELLOW LINE, WATERBORNE PAINT &
 TEMPORARY 4 INCH YELLOW LINE, PAINT
 (ALL LINES WILL INCLUDE CENTERLINE BREAKS
 AT TOWN HIGHWAYS)
 MM 1.200 - MM 1.982 (SOLID LT & RT)
 MM W 0.000 - MM W 0.400 (SOLID LT & RT)

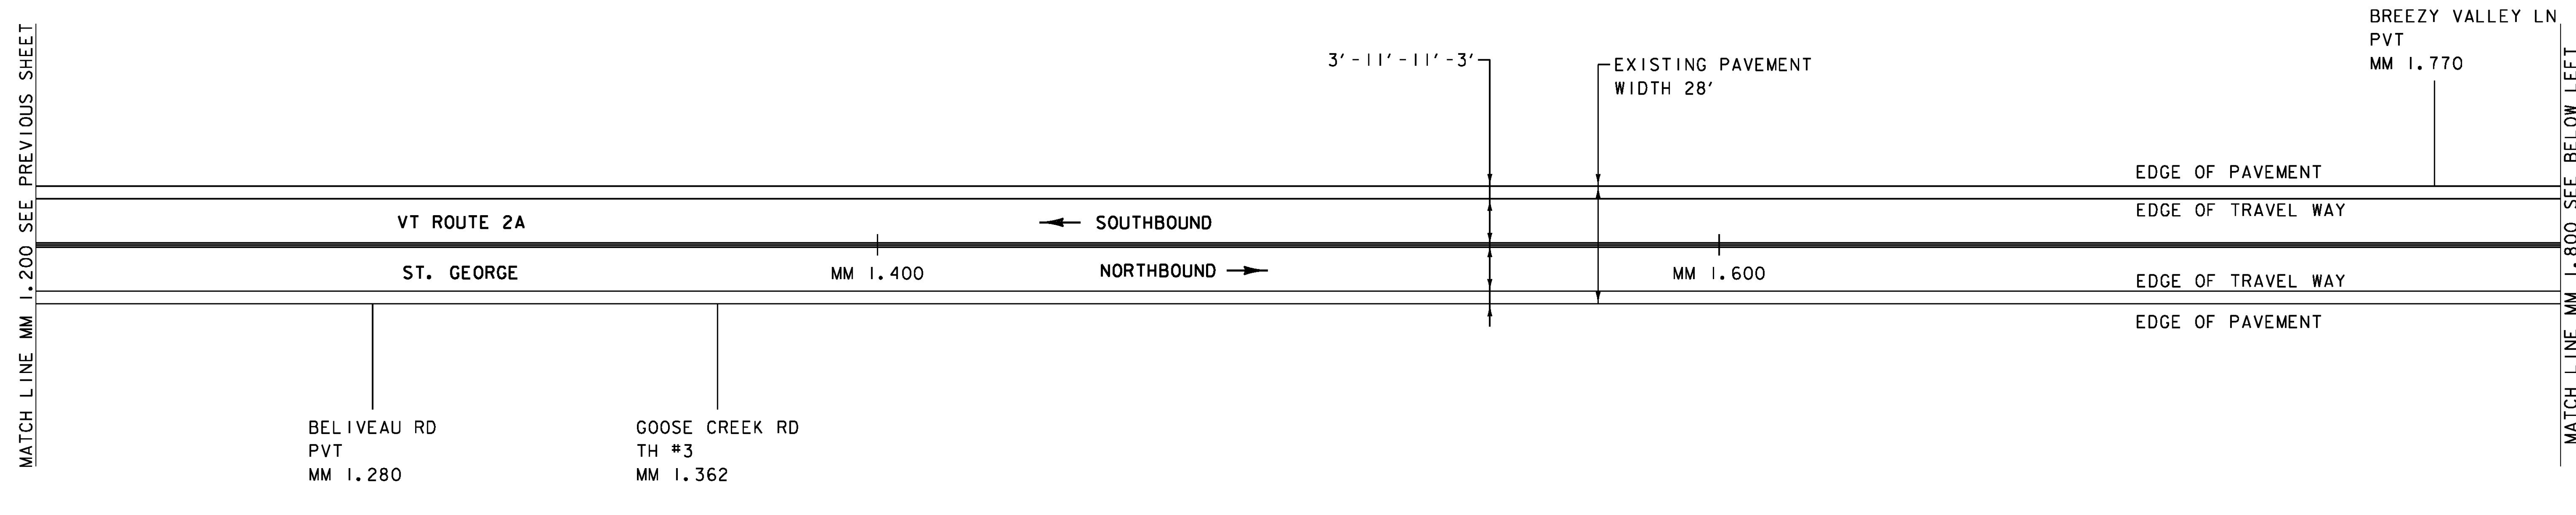

ADDITIONAL:
 -Item No. 0105 Code 621.60 Anchor for Steel Beam Rail
 (1 EACH) MM 0.393 RT
 -Item No. 0225 Code 676.10 Delineator with Steel Post
 (1 EACH) MM 0.393 RT
 -Item No. 0120 Code 621.80 Removal and Disposal of Guardrail
 Williston MM 0.393-0.400 RT and MM 0.416- 0.423 RT
 = 2 ends x 37.5' = 75 LF
TOTAL = 75 LF

PROJECT NAME:	ST. GEORGE-WILLISTON
PROJECT NUMBER:	STP FPAV(4)
FILE NAME: z16v025bdr.dgn	PLOT DATE: 05/16/2016
PROJECT LEADER: C. LATHROP	DRAWN BY: J. GOODALL
DESIGNED BY: J. GOODALL	CHECKED BY: C. LATHROP
PLAN SHEET 2	SHEET II OF 18

NOT TO SCALE