

STEEL BEAM GUARDRAIL, GALVANIZED
 MM W 0.503 - MM W 0.510 LT
 MM W 0.508 - MM W 0.515 RT
 MM W 0.527 - MM W 0.534 RT
 MM W 0.531 - MM W 0.538 LT

REMOVAL AND DISPOSAL OF GUARDRAIL
 MM W 0.503 - MM W 0.510 LT
 MM W 0.508 - MM W 0.515 RT
 MM W 0.527 - MM W 0.534 RT
 MM W 0.531 - MM W 0.538 LT

4 INCH WHITE LINE, WATERBORNE PAINT & TEMPORARY 4 INCH WHITE LINE, PAINT
 (ALL LINES WILL INCLUDE EDGE LINE BREAKS AND RADII AT TOWN HIGHWAYS
 MM W 0.400 - MM W 1.600 (SOLID LT & RT EDGE LINE)

4 INCH YELLOW LINE, WATERBORNE PAINT & TEMPORARY 4 INCH YELLOW LINE, PAINT
 (ALL LINES WILL INCLUDE CENTERLINE BREAKS AT TOWN HIGHWAYS)
 MM W 0.400 - MM W 0.795 (SOLID LT & RT)
 MM W 0.795 - MM W 0.920 (SOLID LT, DASHED RT)
 MM W 0.920 - MM W 0.950 (DASHED RT)
 MM W 0.950 - MM W 1.100 (DASHED LT, SOLID RT)
 MM W 1.100 - MM W 1.600 (SOLID LT & RT)

LETTER OR SYMBOL, WATERBORNE PAINT & TEMPORARY LETTER OR SYMBOL, PAINT
 MM W 0.500 RT (SCHOOL)
 MM W 0.508 RT (AHEAD)
 MM W 0.759 LT (AHEAD)
 MM W 0.767 LT (SCHOOL)


ANCHOR FOR STEEL BEAM GUARDRAIL
 MM W 0.503 LT
 MM W 0.508 RT
 MM W 0.534 RT
 MM W 0.538 LT

ADJUST HEIGHT OF GUARDRAIL
 MM W 0.400 - MM W 0.423 RT
 MM W 0.400 - MM W 0.434 LT

ADJUST HEIGHT - FIELD MEASURED:
 MM W 0.398 - 0.434 LT = 112.5+175 = 287.5 LF
 MM W 0.393 - 0.423 RT = 100 LF
 MM W 0.503 - 0.538 LT = 100 LF
 MM W 0.508 - 0.534 RT = 100 LF

Additional Item No. 0120 Code 621.80
 Removal and Disposal of Guardrail:
 Williston MM 0.393-0.400 RT and MM
 0.416- 0.423 RT = 2 ends x 37.5' = 75 LF
TOTAL = 75 LF

Replace Guardrail Beam Unit: 1 @ MM 0.520 LT.

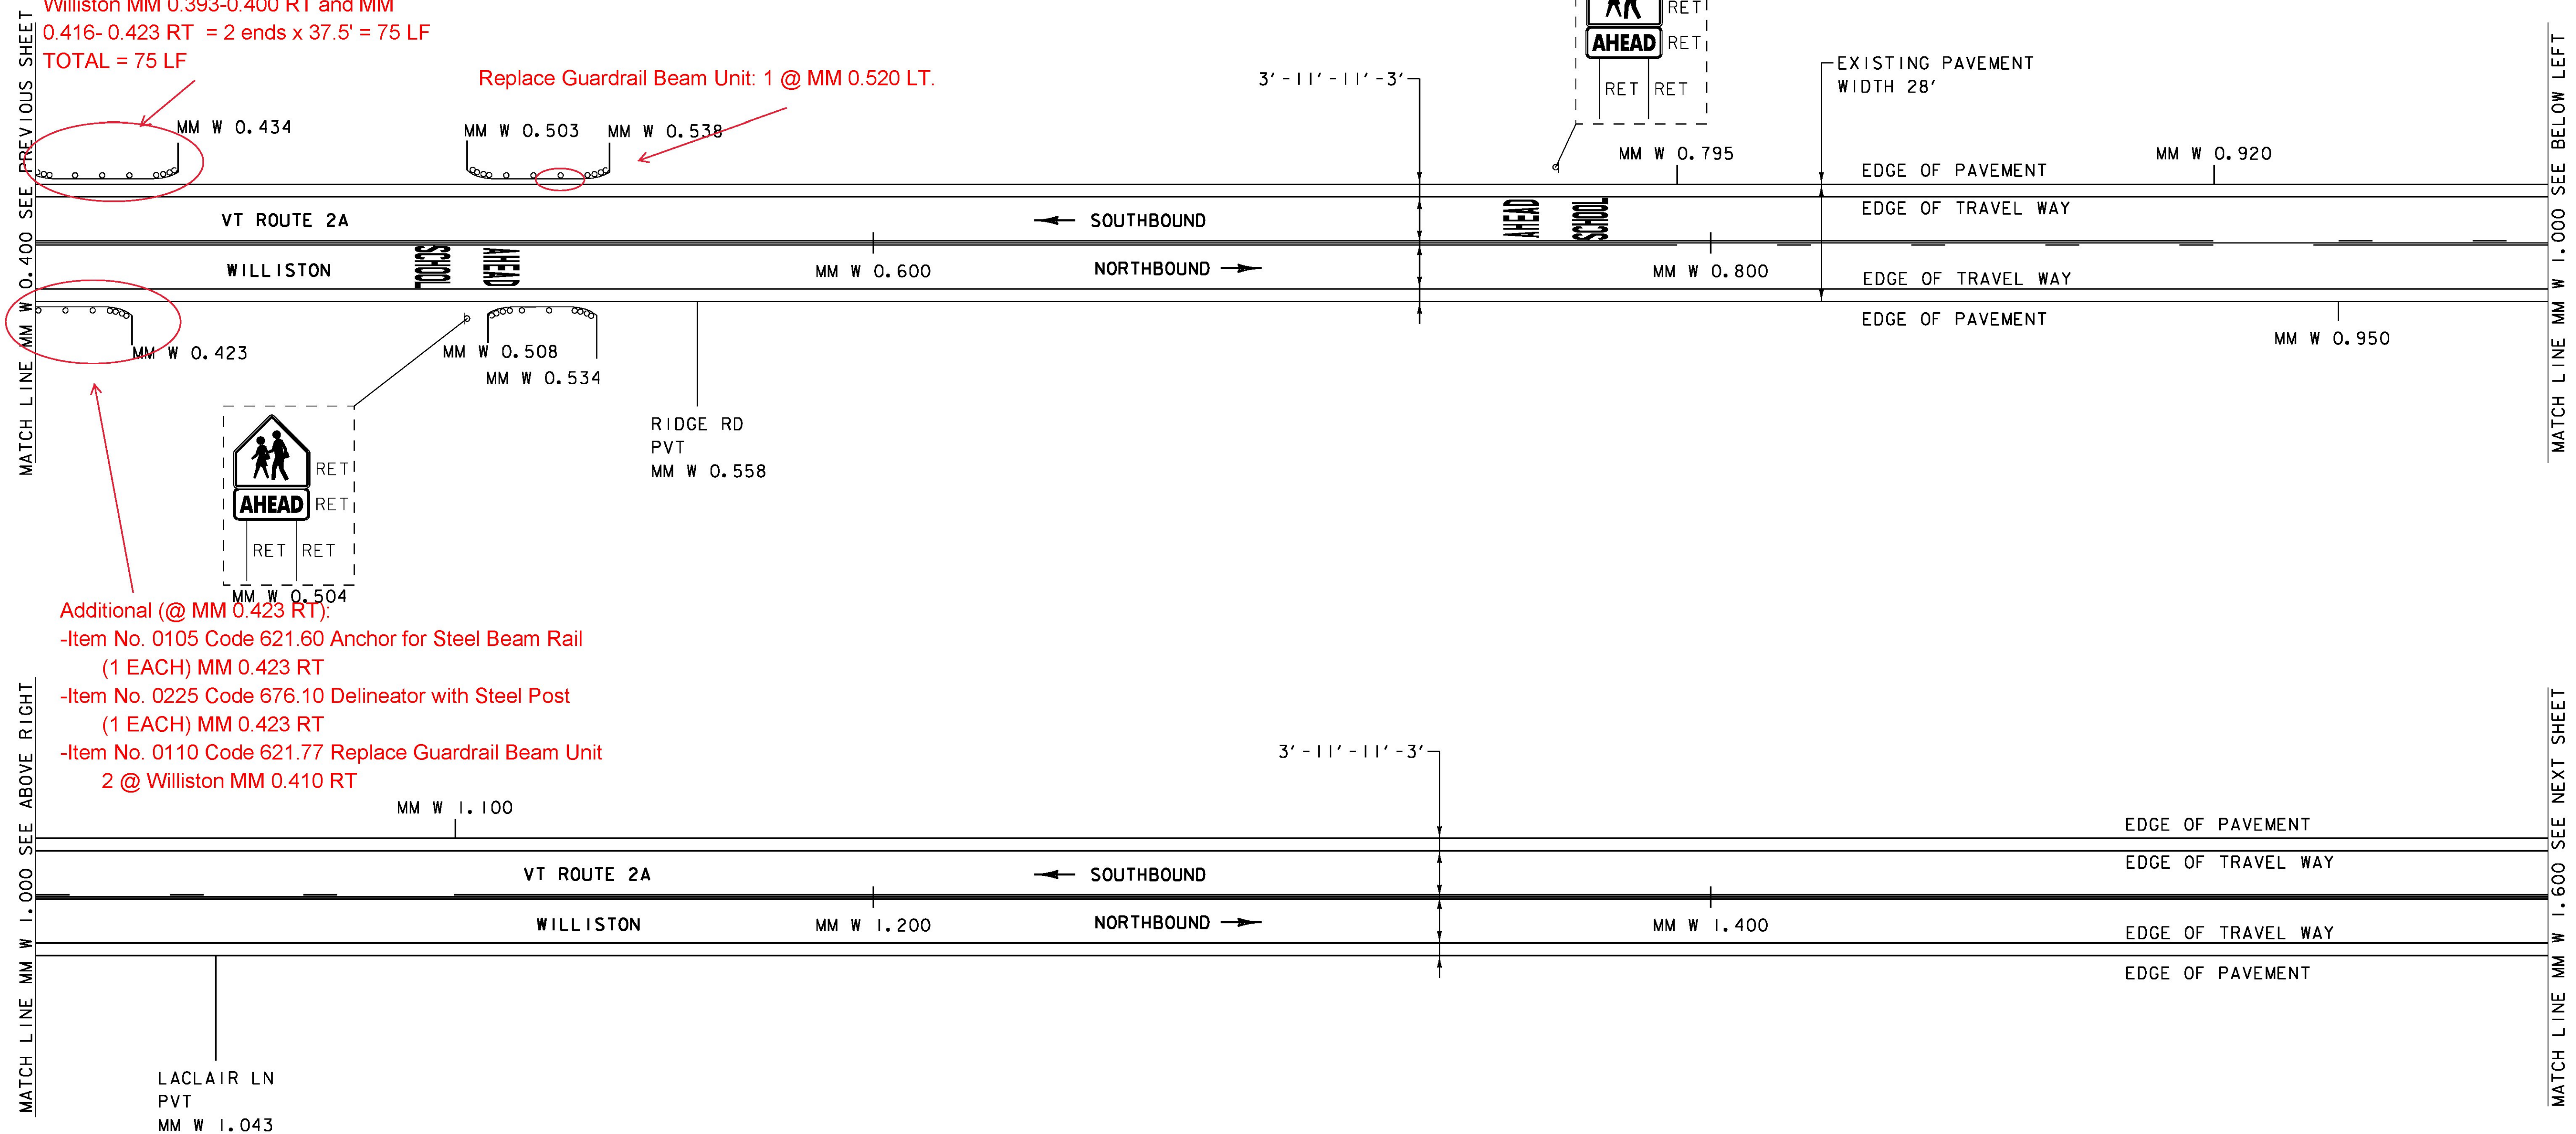

Additional (@ MM 0.423 RT):
 -Item No. 0105 Code 621.60 Anchor for Steel Beam Rail
 (1 EACH) MM 0.423 RT
 -Item No. 0225 Code 676.10 Delineator with Steel Post
 (1 EACH) MM 0.423 RT
 -Item No. 0110 Code 621.77 Replace Guardrail Beam Unit
 2 @ Williston MM 0.410 RT

NOT TO SCALE

PROJECT NAME:	ST. GEORGE-WILLISTON
PROJECT NUMBER:	STP FPAV(4)
FILE NAME: z16v025bdr.dgn	PLOT DATE: 05/16/2016
PROJECT LEADER: C. LATHROP	DRAWN BY: J. GOODALL
DESIGNED BY: J. GOODALL	CHECKED BY: C. LATHROP
PLAN SHEET 3	SHEET 12 OF 18