


4 INCH WHITE LINE, WATERBORNE PAINT &
 TEMPORARY 4 INCH WHITE LINE, PAINT
 (ALL LINES WILL INCLUDE EDGE LINE BREAKS
 AND RADII AT TOWN HIGHWAYS)
 MM W 1.600 - MM W 2.700 (SOLID LT & RT EDGE LINE)

4 INCH YELLOW LINE, WATERBORNE PAINT &
 TEMPORARY 4 INCH YELLOW LINE, PAINT
 (ALL LINES WILL INCLUDE CENTERLINE BREAKS
 AT TOWN HIGHWAYS)
 MM W 1.600 - MM W 2.700 (SOLID LT & RT)

24 INCH STOP BAR, WATERBORNE PAINT &
 TEMPORARY 24 INCH STOP BAR, PAINT
 MM W 2.116 - MM W 2.123 RT

LETTER OR SYMBOL, WATERBORNE PAINT &
 TEMPORARY LETTER OR SYMBOL, PAINT
 MM W 2.119 RT (STOP)

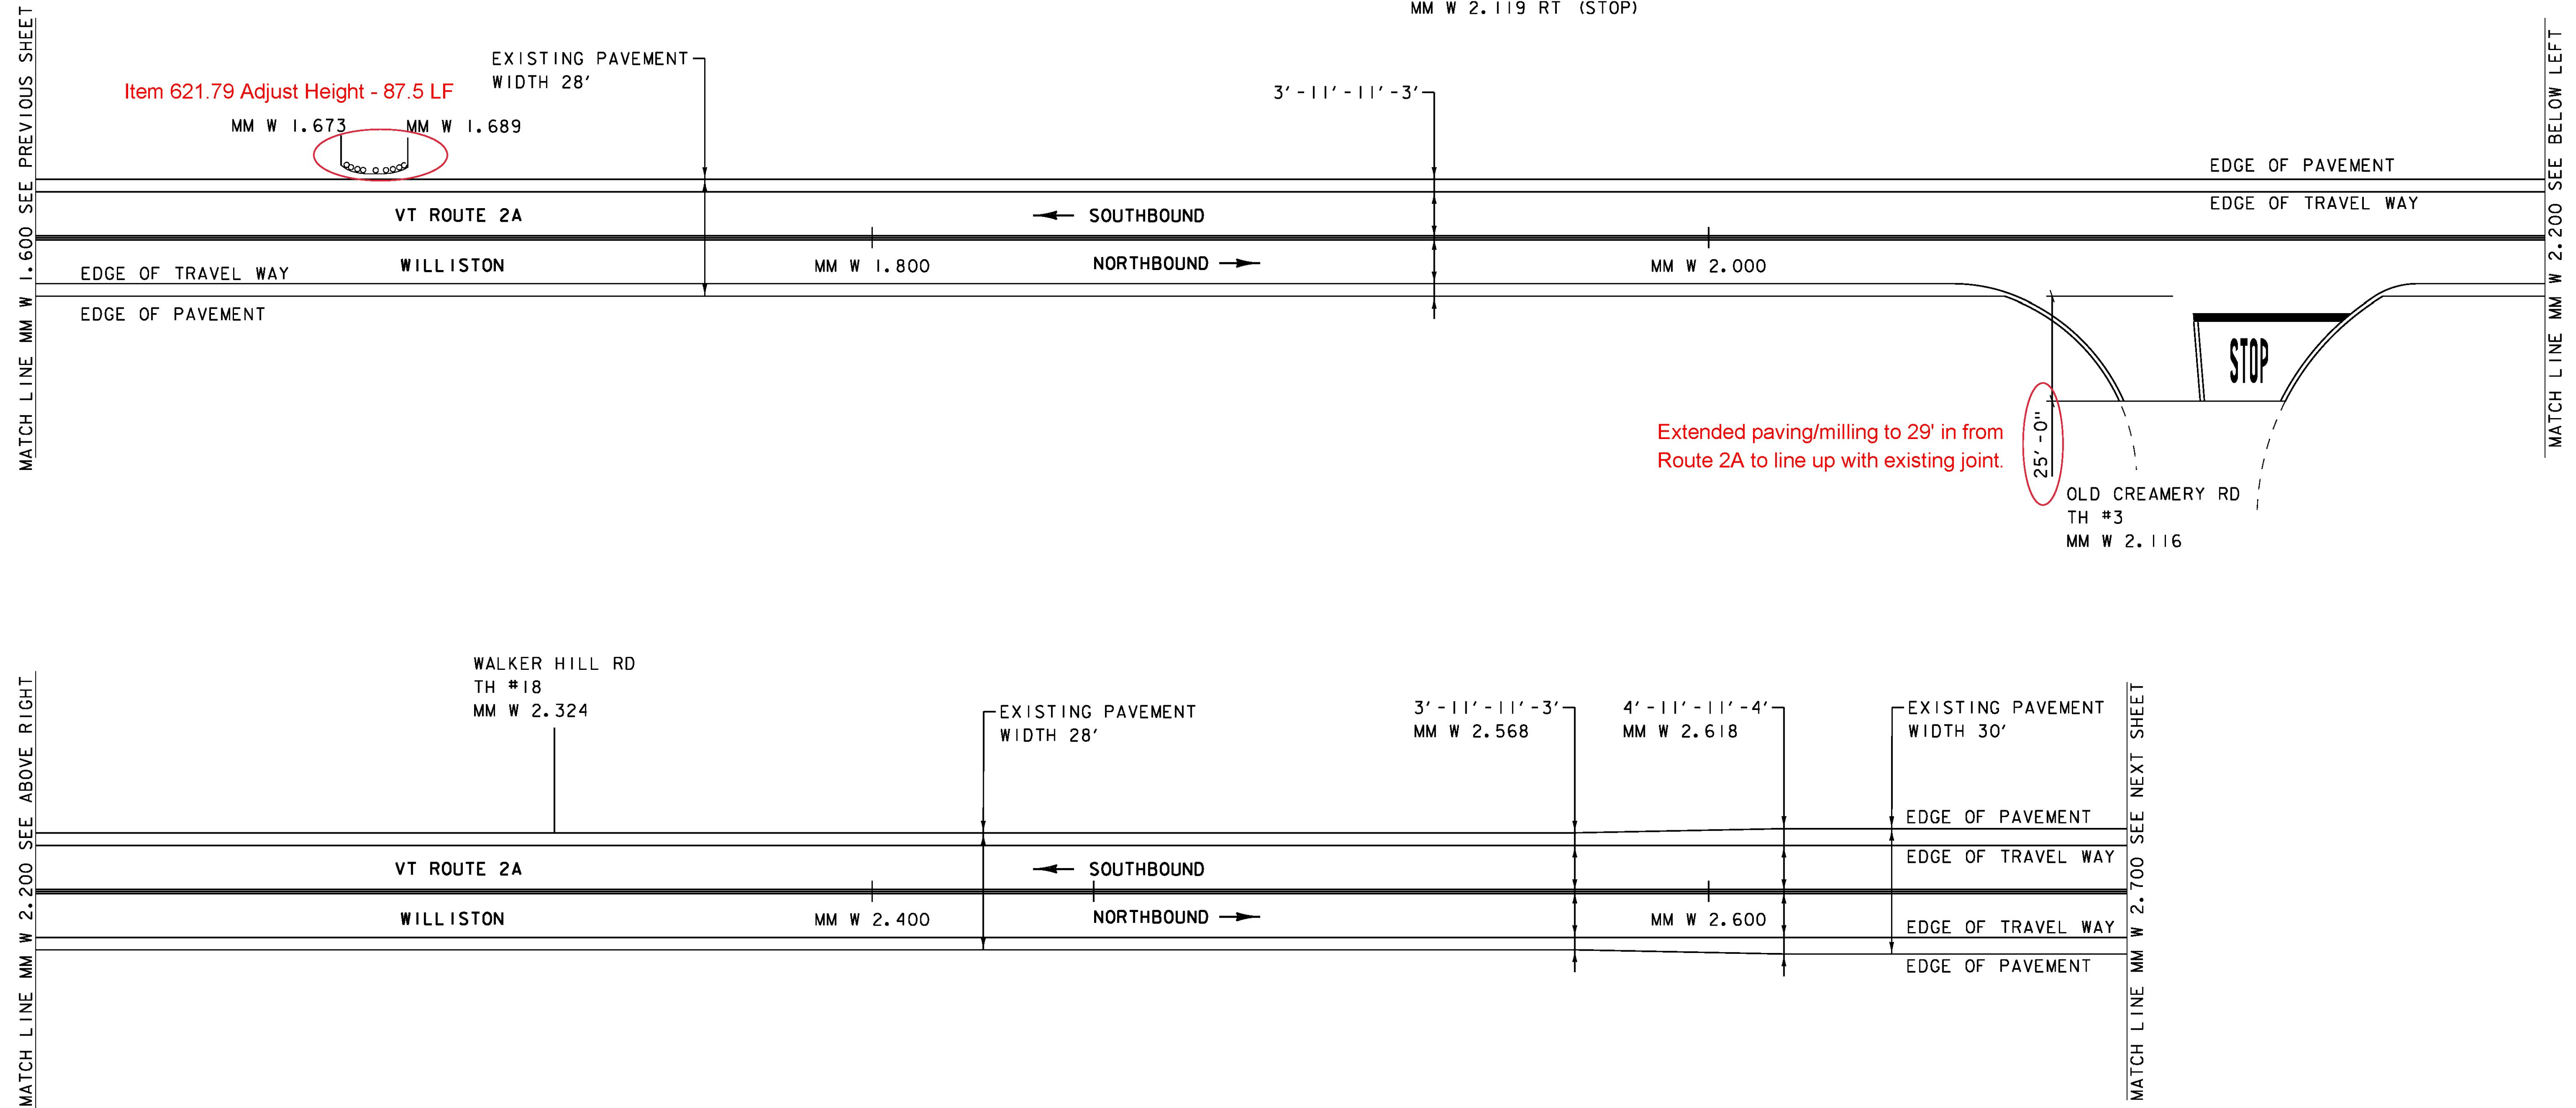

PROJECT NAME:	ST. GEORGE-WILLISTON
PROJECT NUMBER:	STP FPAV(4)
FILE NAME: z16v025bdr.dgn	PLOT DATE: 05/16/2016
PROJECT LEADER: C. LATHROP	DRAWN BY: J. GOODALL
DESIGNED BY: J. GOODALL	CHECKED BY: C. LATHROP
PLAN SHEET 4	SHEET 13 OF 18

NOT TO SCALE