



STEEL BEAM GUARDRAIL GALVANIZED
 MM 3.226 - MM 3.233 RT
 MM 3.283 - MM 3.290 RT
 MM 3.821 - MM 3.828 RT
 MM 3.907 - MM 3.914 RT
 MM 4.176 - MM 4.183 RT
 MM 4.224 - MM 4.231 RT

ANCHOR FOR STEEL BEAM RAIL
 MM 3.226 RT
 MM 3.290 RT
 MM 3.821 RT
 MM 3.914 RT
 MM 4.176 RT
 MM 4.231 RT

REMOVAL AND DISPOSAL OF GUARDRAIL
 MM 3.226 - MM 3.233 RT
 MM 3.283 - MM 3.290 RT
 MM 3.821 - MM 3.828 RT
 MM 3.907 - MM 3.914 RT
 MM 4.176 - MM 4.183 RT
 MM 4.224 - MM 4.231 RT

4 INCH WHITE LINE, WATERBORNE PAINT &
 TEMPORARY 4 INCH WHITE LINE, PAINT
 (ALL LINES WILL INCLUDE EDGE LINE BREAKS
 AND RADII AT TOWN HIGHWAYS)
 MM 3.200 - MM 4.400 (SOLID LT & RT EDGE LINE)

4 INCH YELLOW LINE, WATERBORNE PAINT &
 TEMPORARY 4 INCH YELLOW LINE, PAINT
 (ALL LINES WILL INCLUDE CENTERLINE BREAKS
 AT TOWN HIGHWAYS)
 MM 3.200 - MM 3.970 (SOLID LT & RT)
 MM 3.970 - MM 4.120 (SOLID LT & DASHED RT)
 MM 4.120 - MM 4.150 (DASHED CTR)
 MM 4.150 - MM 4.257 (DASHED LT & SOLID RT)
 MM 4.257 - MM 4.400 (SOLID LT & RT)

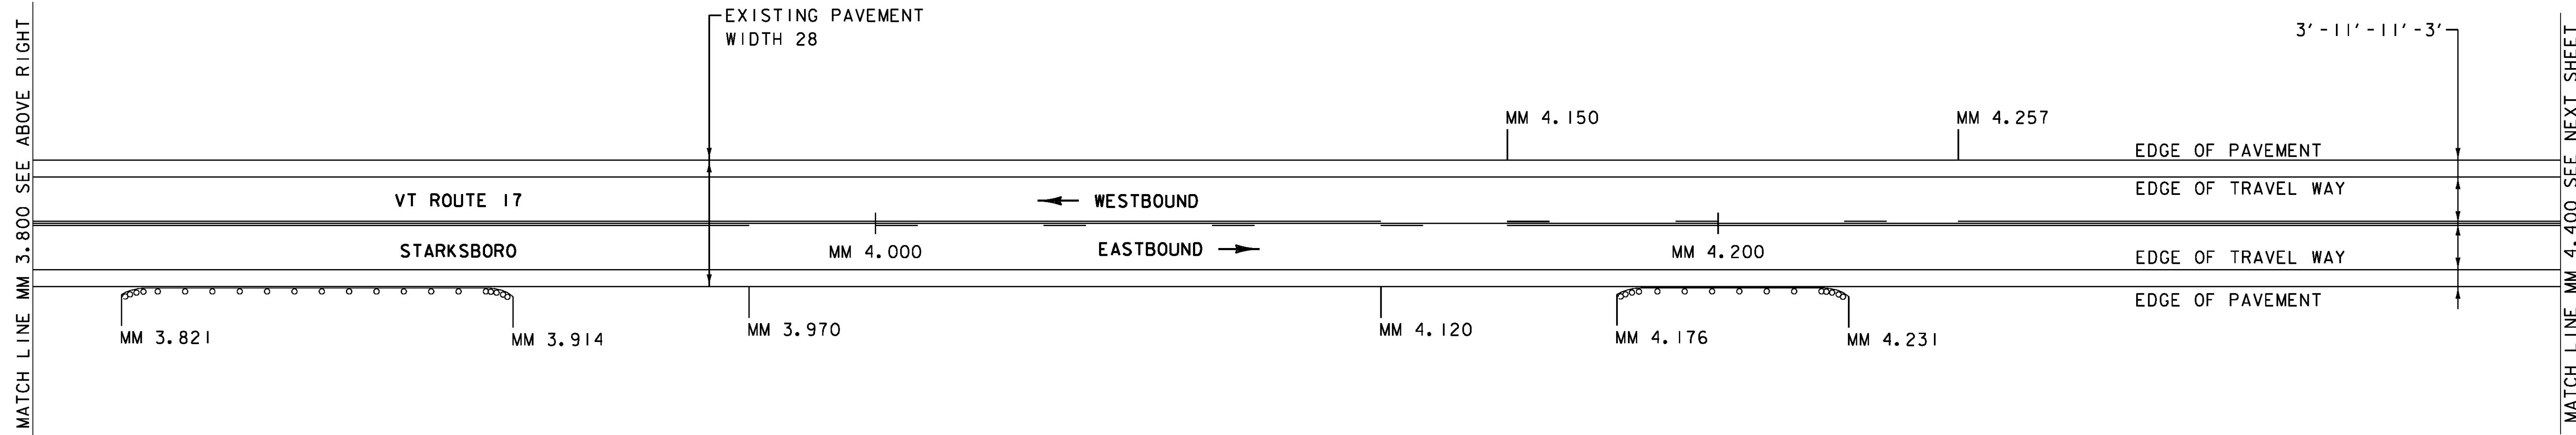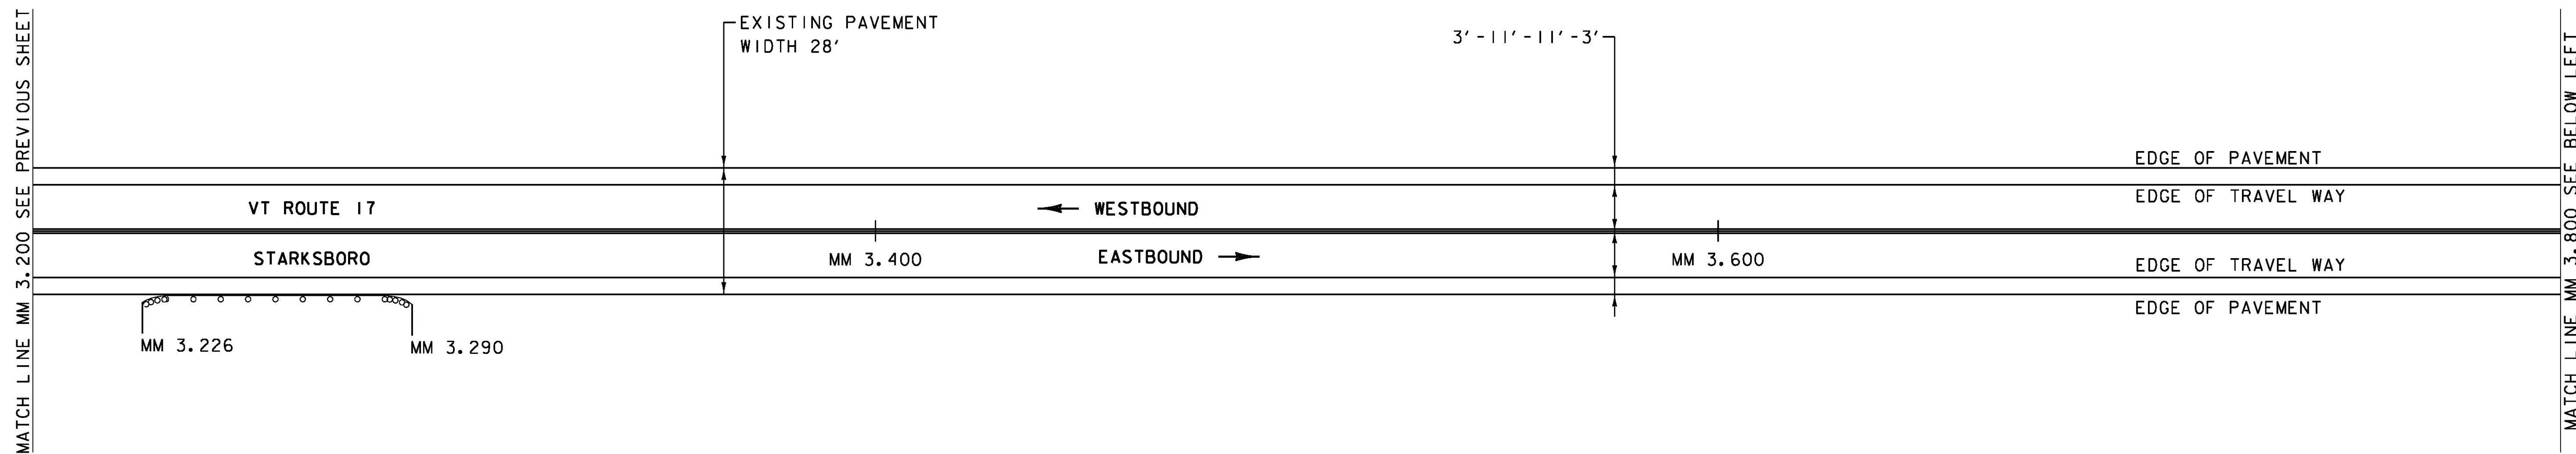

PROJECT NAME: STARKSBORO-BUELS GORE	
PROJECT NUMBER: STP FPAV(5)	
FILE NAME: z16v026bdr.dgn	PLOT DATE: 5/31/2016
PROJECT LEADER: C. LATHROP	DRAWN BY: J. GOODALL
DESIGNED BY: J. GOODALL	CHECKED BY: C. LATHROP
PLAN SHEET 2	SHEET 12 OF 22

NOT TO SCALE