

STEEL BEAM GUARDRAIL, GALVANIZED

MM BG 0.217 LT
MM BG 0.552 LT
MM BG 0.767 - MM BG 0.774 RT
MM BG 0.805 - MM BG 0.812 RT
MM BG 1.252 - MM BG 1.259 RT

ANCHOR FOR STEEL BEAM RAIL

MM BG 0.767 RT
MM BG 0.812 RT
MM BG 1.252 RT

ADJUST HEIGHT OF GUARDRAIL

MM BG 0.217 - MM BG 0.552 LT
MM BG 0.577 - MM BG 0.680 LT
MM BG 0.757 - MM BG 0.803 LT
MM BG 0.774 - MM BG 0.805 RT

REMOVAL AND DISPOSAL OF GUARDRAIL

MM BG 0.217 LT
MM BG 0.552 LT
MM BG 0.767 - MM BG 0.774 RT
MM BG 0.805 - MM BG 0.812 RT
MM BG 1.252 - MM BG 1.259 RT

ANCHOR FOR STEEL BEAM RAIL

MM BG 0.217 LT
MM BG 0.552 LT
MM BG 0.577 LT
MM BG 0.680 LT
MM BG 0.757 LT

4 INCH WHITE LINE, WATERBORNE PAINT &

TEMPORARY 4 INCH WHITE LINE, PAINT
(ALL LINES WILL INCLUDE EDGE LINE BREAKS
AND RADII AT TOWN HIGHWAYS)
MM BG 0.200 - MM BG 1.400 (SOLID LT & RT EDGE LINE)

4 INCH YELLOW LINE, WATERBORNE PAINT &


TEMPORARY 4 INCH YELLOW LINE, PAINT
(ALL LINES WILL INCLUDE CENTERLINE BREAKS
AT TOWN HIGHWAYS)
MM BG 0.200 - MM BG 1.400 (SOLID LT & RT)

MATCH LINE MM BG 0.200 SEE PREVIOUS SHEET

MATCH LINE MM BG 0.800 SEE ABOVE RIGHT

MATCH LINE MM BG 0.800 SEE BELOW LEFT

MATCH LINE MM BG 1.400 SEE NEXT SHEET

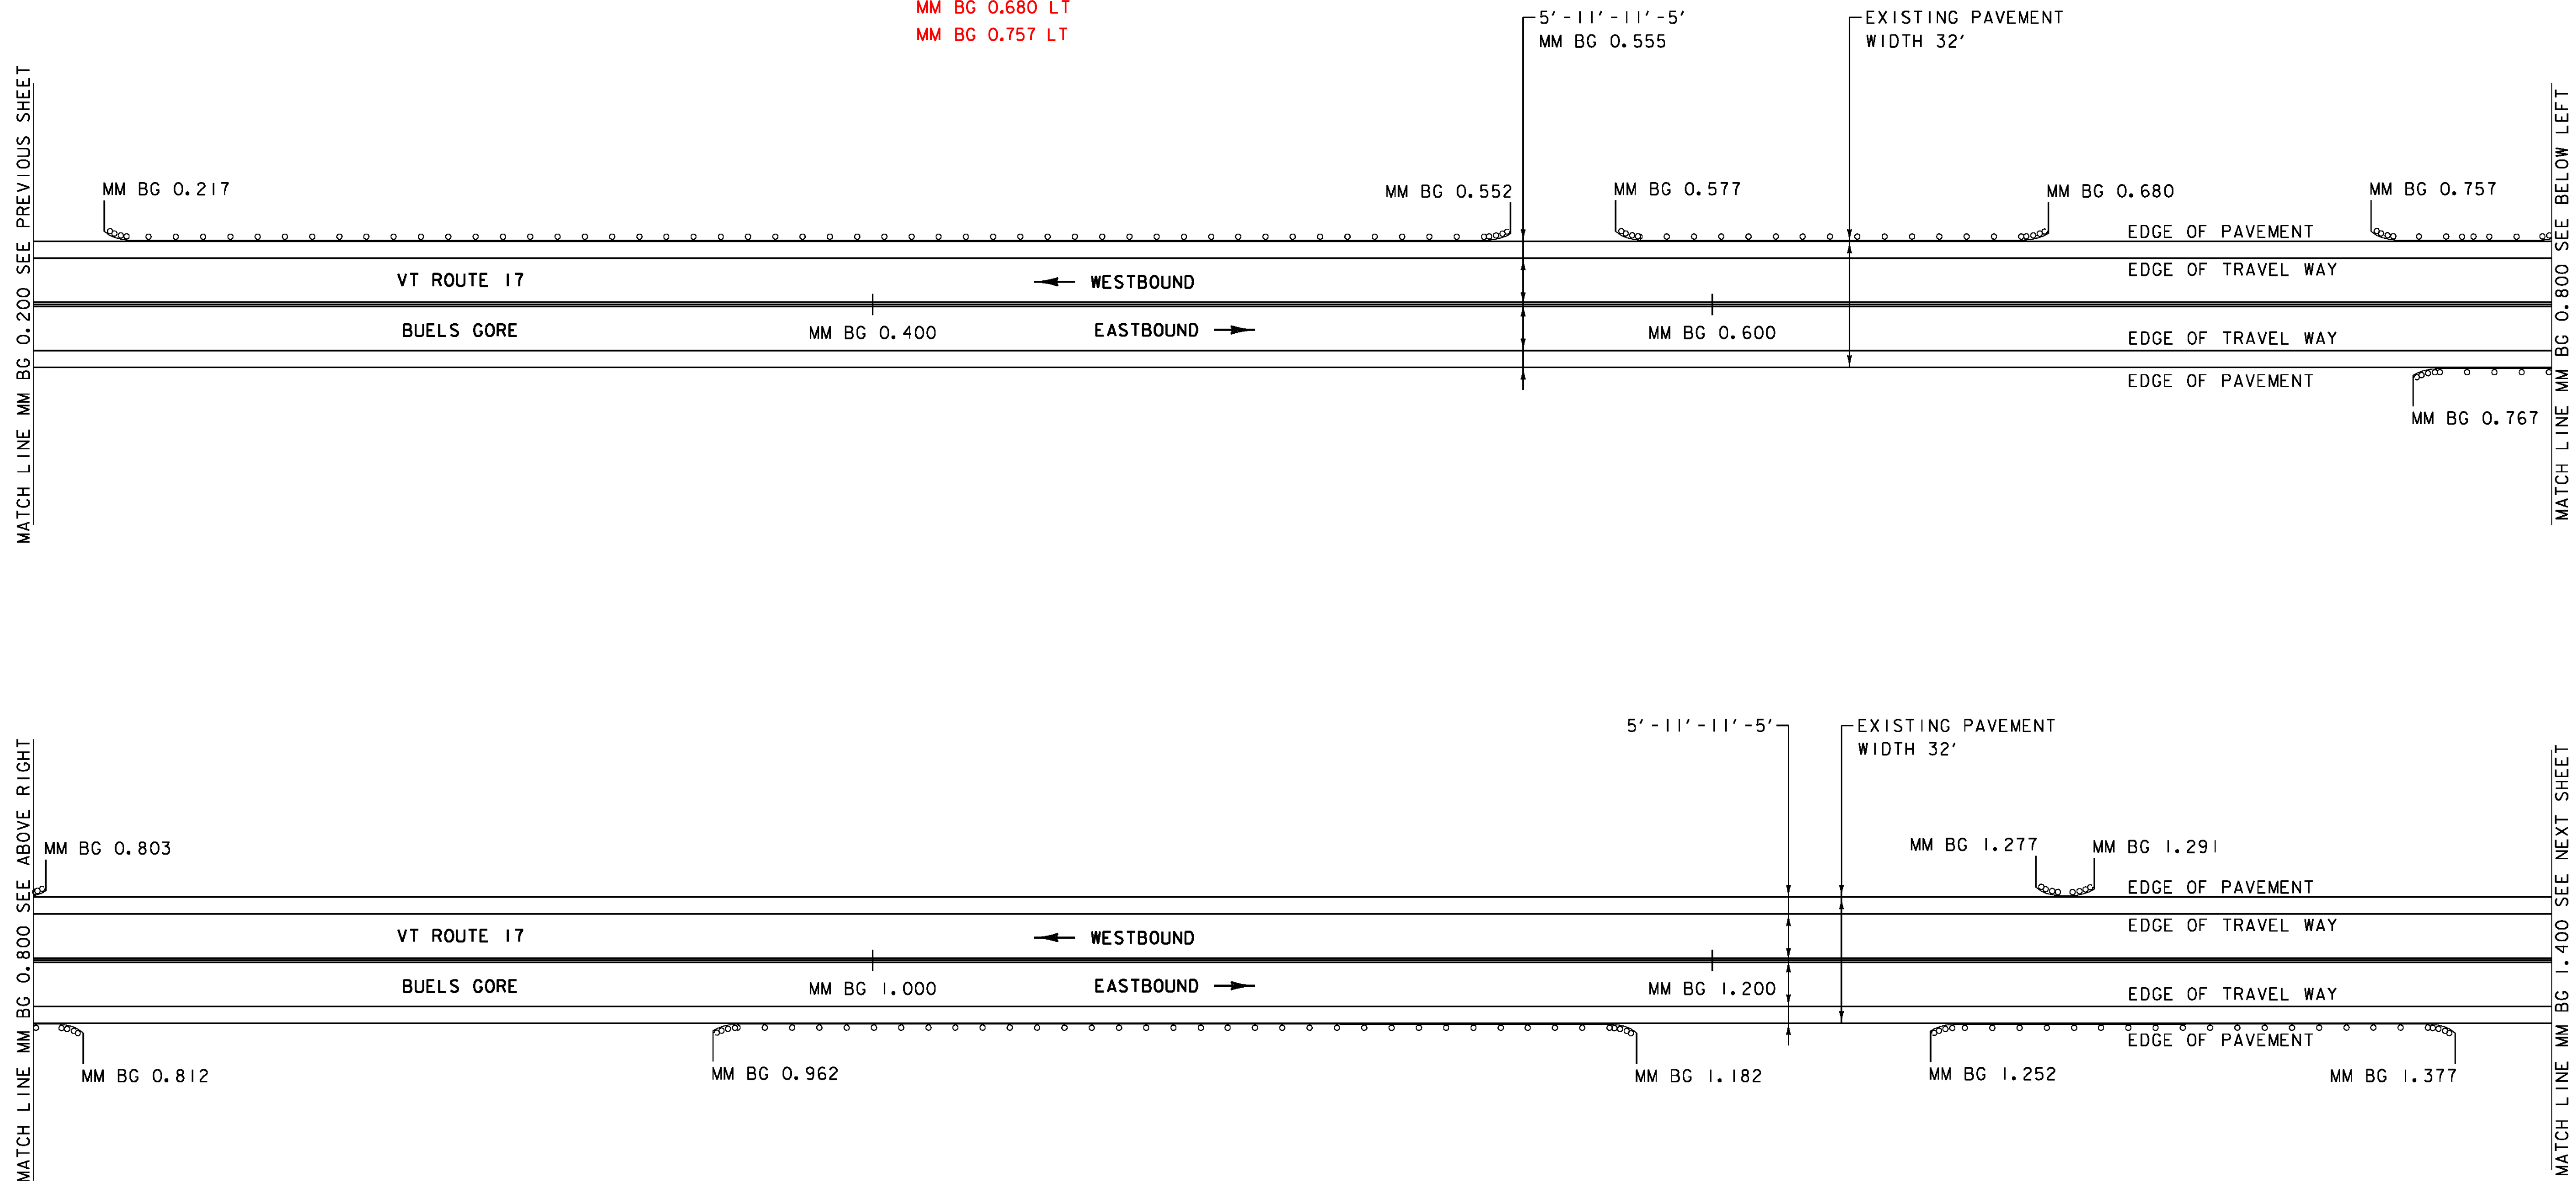

NOT TO SCALE

PROJECT NAME:	STARKSBORO-BUELS GORE
PROJECT NUMBER:	STP FPAV(5)
FILE NAME:	z16v026bdr.dgn
PROJECT LEADER:	C. LATHROP
DESIGNED BY:	J. GOODALL
PLAN SHEET 4	
PLOT DATE:	5/31/2016
DRAWN BY:	J. GOODALL
CHECKED BY:	C. LATHROP
SHEET	14 OF 22