

STEEL BEAM GUARDRAIL, GALVANIZED  
MM BG 1.557 - MM BG 1.564 LT

ANCHOR FOR STEEL BEAM RAIL  
MM BG 1.557 LT


REMOVAL AND DISPOSAL OF GUARDRAIL  
MM BG 1.557 - MM BG 1.564 LT

4 INCH WHITE LINE, WATERBORNE PAINT &  
TEMPORARY 4 INCH WHITE LINE, PAINT  
(ALL LINES WILL INCLUDE EDGE LINE BREAKS  
AND RADII AT TOWN HIGHWAYS)  
MM BG 1.400 - MM BG 2.600 (SOLID LT & RT EDGE LINE)

4 INCH YELLOW LINE, WATERBORNE PAINT &  
TEMPORARY 4 INCH YELLOW LINE, PAINT  
(ALL LINES WILL INCLUDE CENTERLINE BREAKS  
AT TOWN HIGHWAYS)  
MM BG 1.400 - MM BG 2.600 (SOLID LT & RT)

ADJUST HEIGHT OF GUARDRAIL  
MM BG 1.477 - MM BG 1.587 RT  
MM BG 1.623 - MM BG 1.712 RT  
MM BG 1.754 - MM BG 1.927 LT  
MM BG 1.917 - MM BG 1.937 RT  
MM BG 1.979 - MM BG 1.998 LT  
MM BG 1.982 - MM BG 2.004 RT  
MM BG 2.057 - MM BG 2.142 RT  
MM BG 2.102 - MM BG 2.128 LT  
MM BG 2.237 - MM BG 2.517 LT

ANCHOR FOR STEEL BEAM RAIL  
MM BG 1.82 RT  
MM BG 1.627 LT  
MM BG 1.712 RT  
MM BG 2.142 RT  
MM BG 1.754 LT  
MM BG 1.979 LT

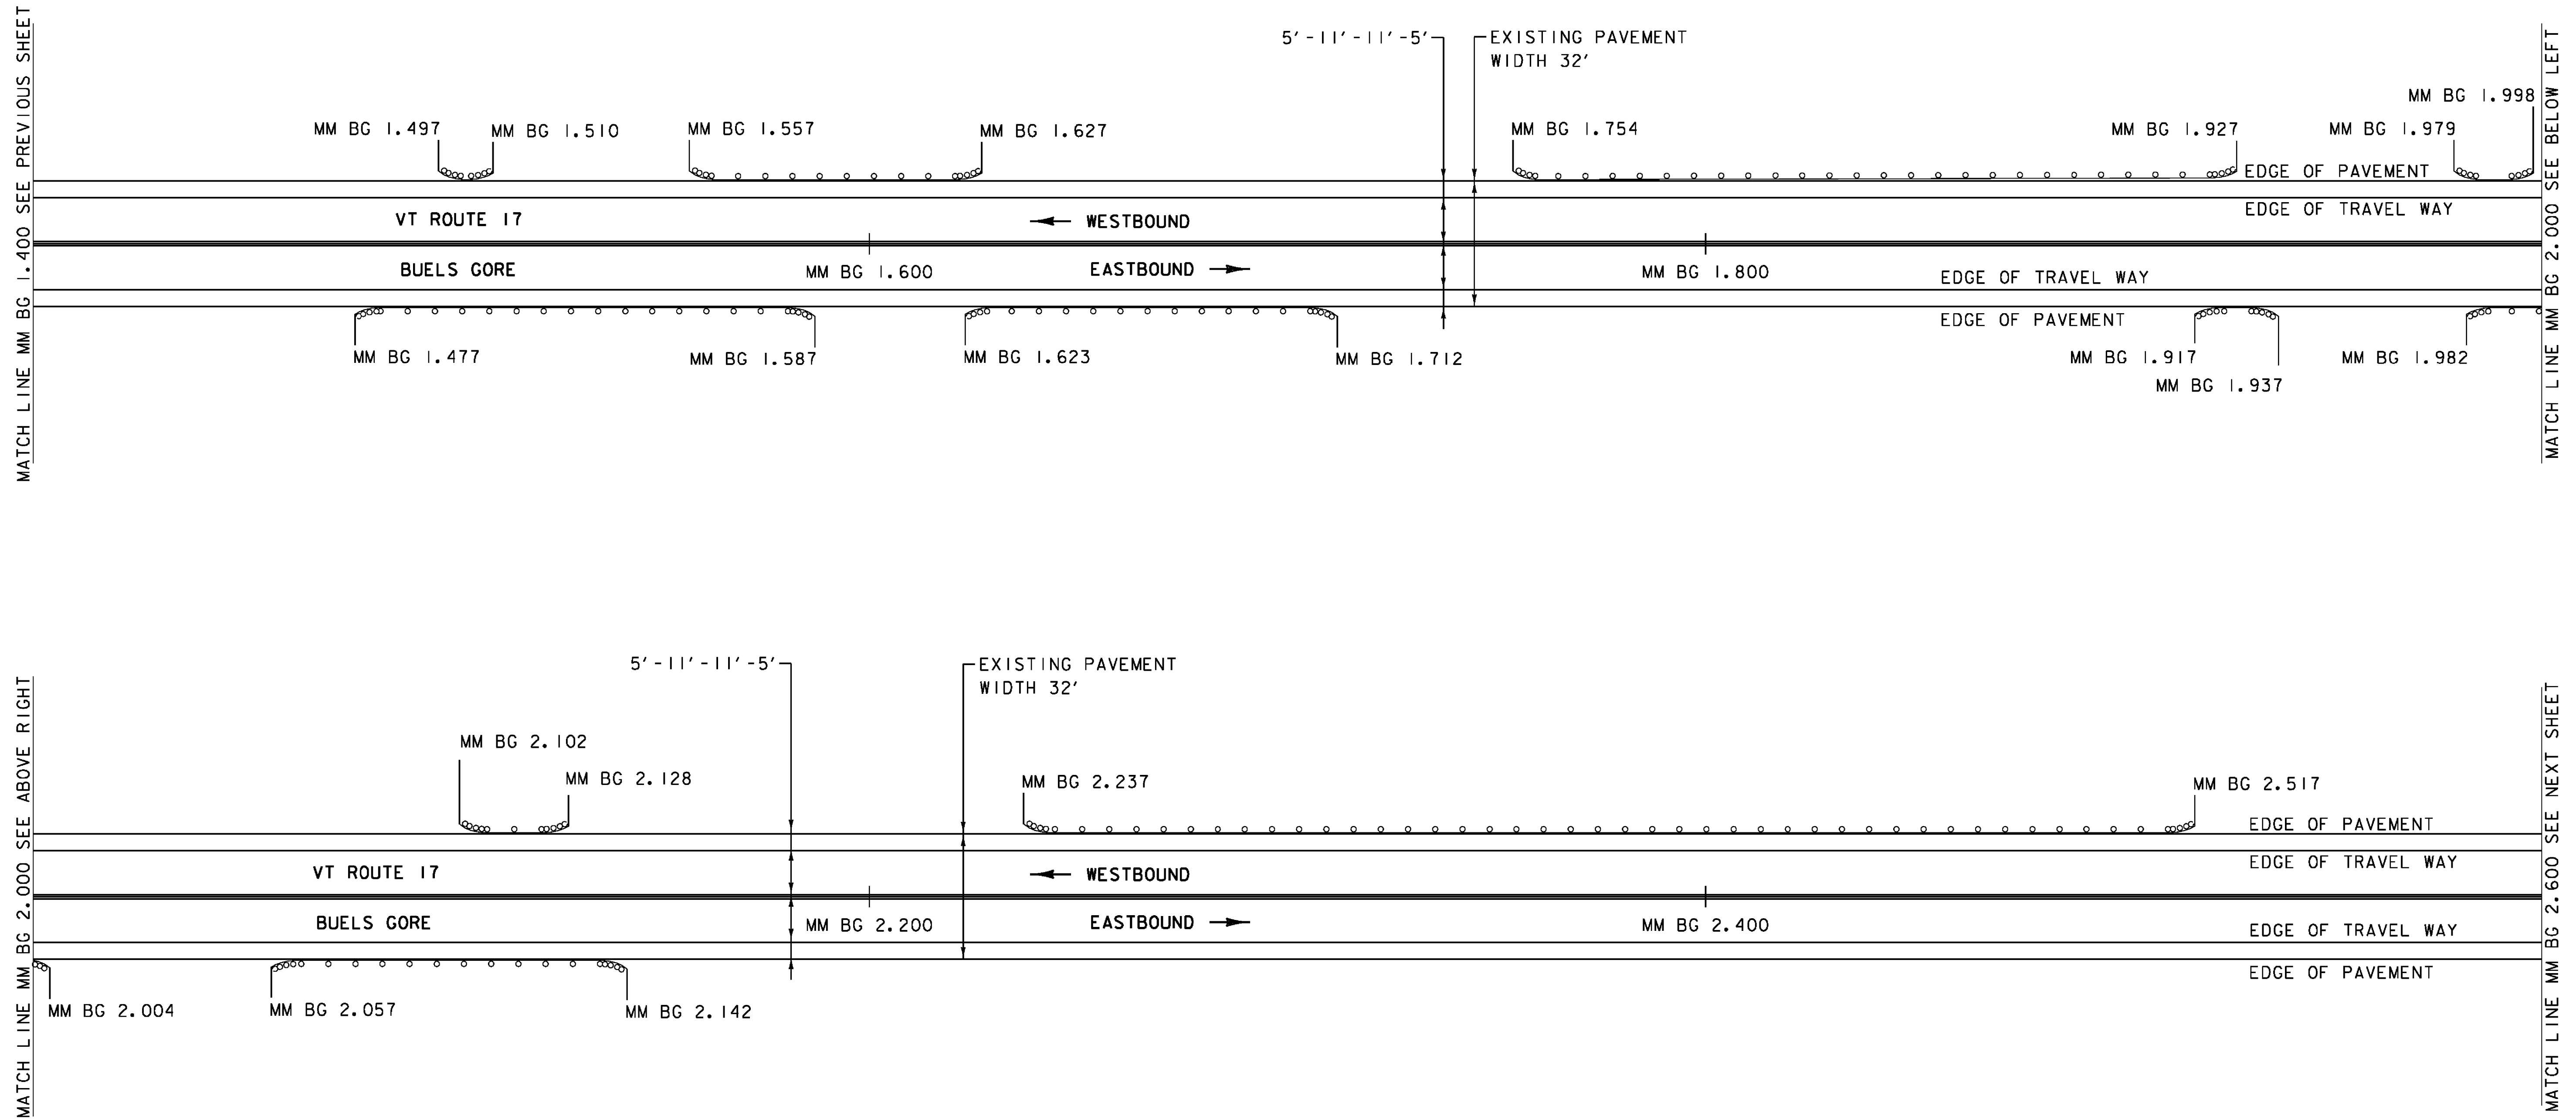

PROJECT NAME:	STARKSBORO-BUELS GORE
PROJECT NUMBER:	STP FPAV(5)
FILE NAME:	z16v026bdr.dgn
PROJECT LEADER:	C. LATHROP
DESIGNED BY:	J. GOODALL
PLAN SHEET 5	
PLOT DATE:	5/31/2016
DRAWN BY:	J. GOODALL
CHECKED BY:	C. LATHROP
SHEET	15 OF 22

NOT TO SCALE