



# ALTERNATES ZA1 & ZA2

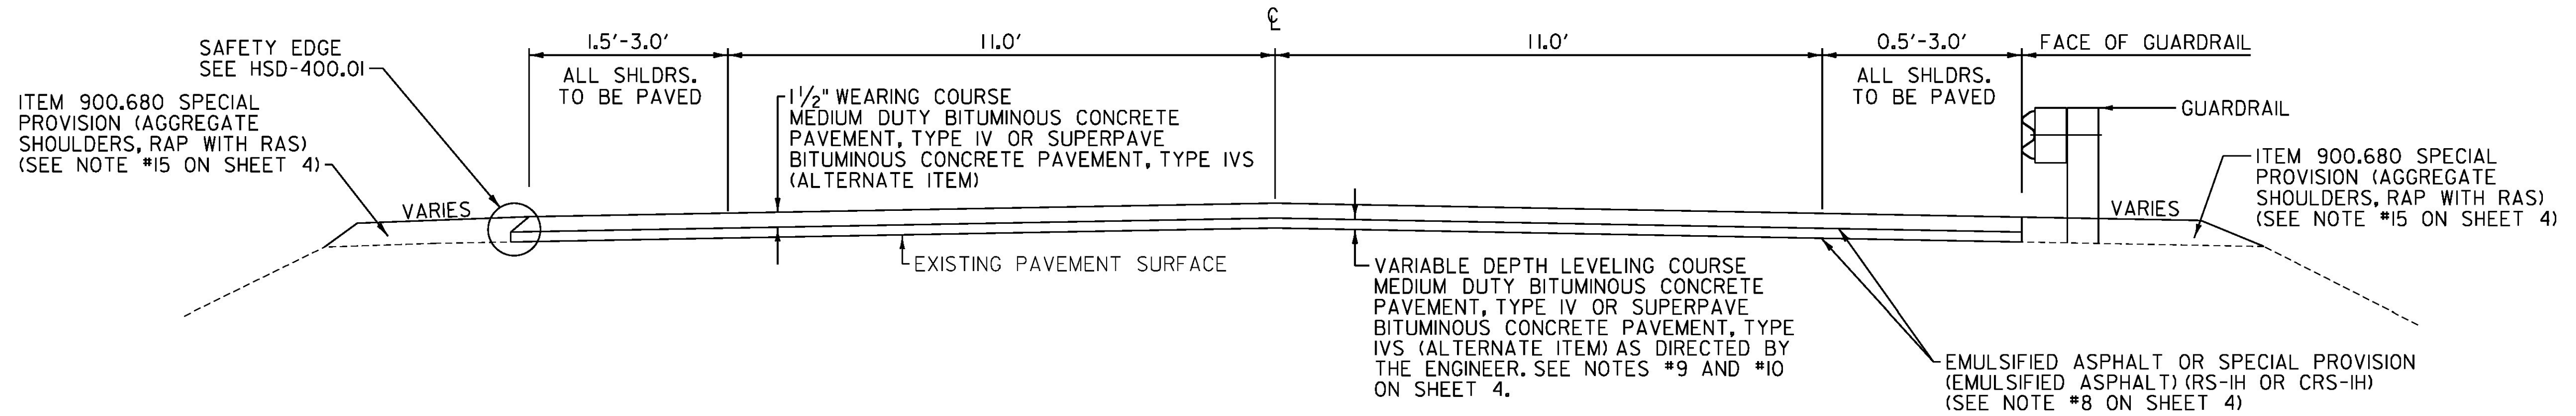

## TYPICAL SECTION

ROXBURY		NORTHFIELD
21+59 TO 50+00 (2 FEET SHOULDERS)	N 0+00 TO N 1+21 (2 FEET SHOULDERS)	N 1+21 TO N 14+86 (2.5 FEET SHOULDERS)
50+00 TO 60+00 (2.5 FEET SHOULDERS)	N 1+21 TO N 14+86 (2.5 FEET SHOULDERS)	N 14+86 TO N 21+00 (2 FEET SHOULDERS)
60+00 TO 62+25 (2 FEET SHOULDERS)	N 21+00 TO N 32+60 RT (2.5 FEET SHOULDER)	N 21+00 TO N 41+45 LT (2.5 FEET SHOULDER)
62+25 TO 76+50 (2.5 FEET SHOULDERS)	N 21+00 TO N 41+45 LT (2.5 FEET SHOULDER)	N 32+60 TO N 33+30 RT (0.5 FEET SHOULDER)
76+50 TO 78+09 (2 FEET SHOULDERS)	N 33+30 TO N 41+45 RT (2.5 FEET SHOULDER)	N 33+30 TO N 41+45 RT (2.5 FEET SHOULDER)
	N 41+45 TO N 47+00 (1.5 FEET SHOULDERS)	N 41+45 TO N 47+00 (1.5 FEET SHOULDERS)
	N 47+00 TO N 58+33 (2 FEET SHOULDERS)	N 47+00 TO N 58+33 (2 FEET SHOULDERS)
	N 58+33 TO N 63+85 (2.5 FEET SHOULDERS)	N 58+33 TO N 63+85 (2.5 FEET SHOULDERS)
	N 63+85 TO N 76+39 (3 FEET SHOULDERS)	N 63+85 TO N 76+39 (3 FEET SHOULDERS)
	N 76+39 TO N 76+53 (2 FEET SHOULDERS)	N 76+39 TO N 76+53 (2 FEET SHOULDERS)
	N 77+87 TO N 78+41 (2 FEET SHOULDERS)	N 77+87 TO N 78+41 (2 FEET SHOULDERS)
	N 78+41 TO N 87+47 (3 FEET SHOULDERS)	N 78+41 TO N 87+47 (3 FEET SHOULDERS)
	N 87+47 TO N 101+00 (2.5 FEET SHOULDERS)	N 87+47 TO N 101+00 (2.5 FEET SHOULDERS)
	N 101+00 TO N 102+93 (3 FEET SHOULDERS)	N 101+00 TO N 102+93 (3 FEET SHOULDERS)

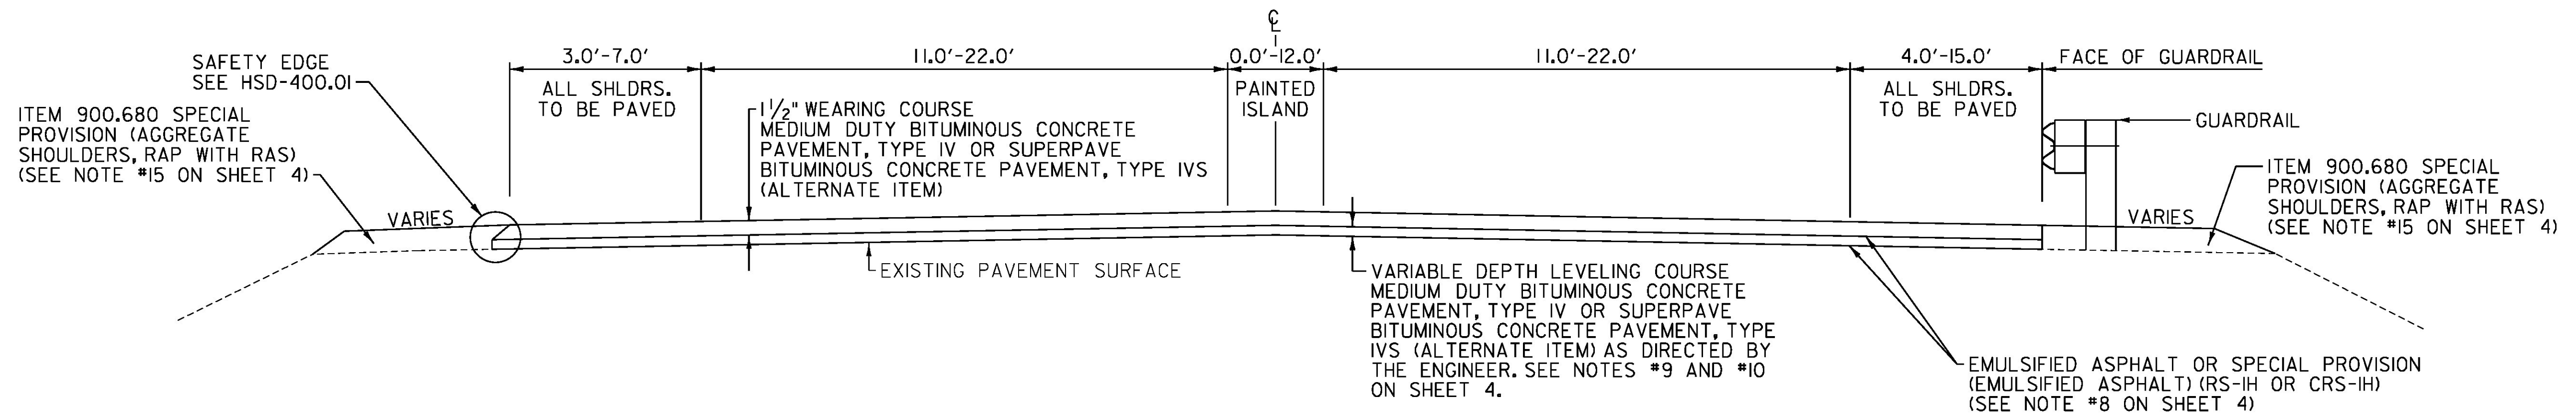

## TYPICAL SECTION

NORTHFIELD

N 102+93 TO N 103+50 (7 FEET SHOULDERS)
N 103+50 TO N 104+60 LT (5 FEET SHOULDER)
N 103+50 TO N 106+85 RT (9 FEET SHOULDER)
N 104+60 TO N 106+85 LT (3 FEET SHOULDER)
N 106+85 TO N 107+50 RT (4 FEET SHOULDER)
N 106+85 TO N 112+48 LT (4 FEET SHOULDER)
N 107+50 TO N 108+02 RT (15 FEET SHOULDER)
N 108+02 TO N 111+10 RT (8 FEET SHOULDER)
N 111+10 TO N 112+48 RT (6 FEET SHOULDER)

NOT TO SCALE

PROJECT NAME: ROXBURY-NORTHFIELD

PROJECT NUMBER: STP FPAV(6)

FILE NAME: z16v027frm.dgn

PLOT DATE: 2/8/2017

PROJECT LEADER: P. SHEDD

DRAWN BY: S. GOODWIN

DESIGNED BY: N. LEMAY

CHECKED BY: P. SHEDD

TYPICAL SECTION SHEET 1

SHEET 5 OF 21