
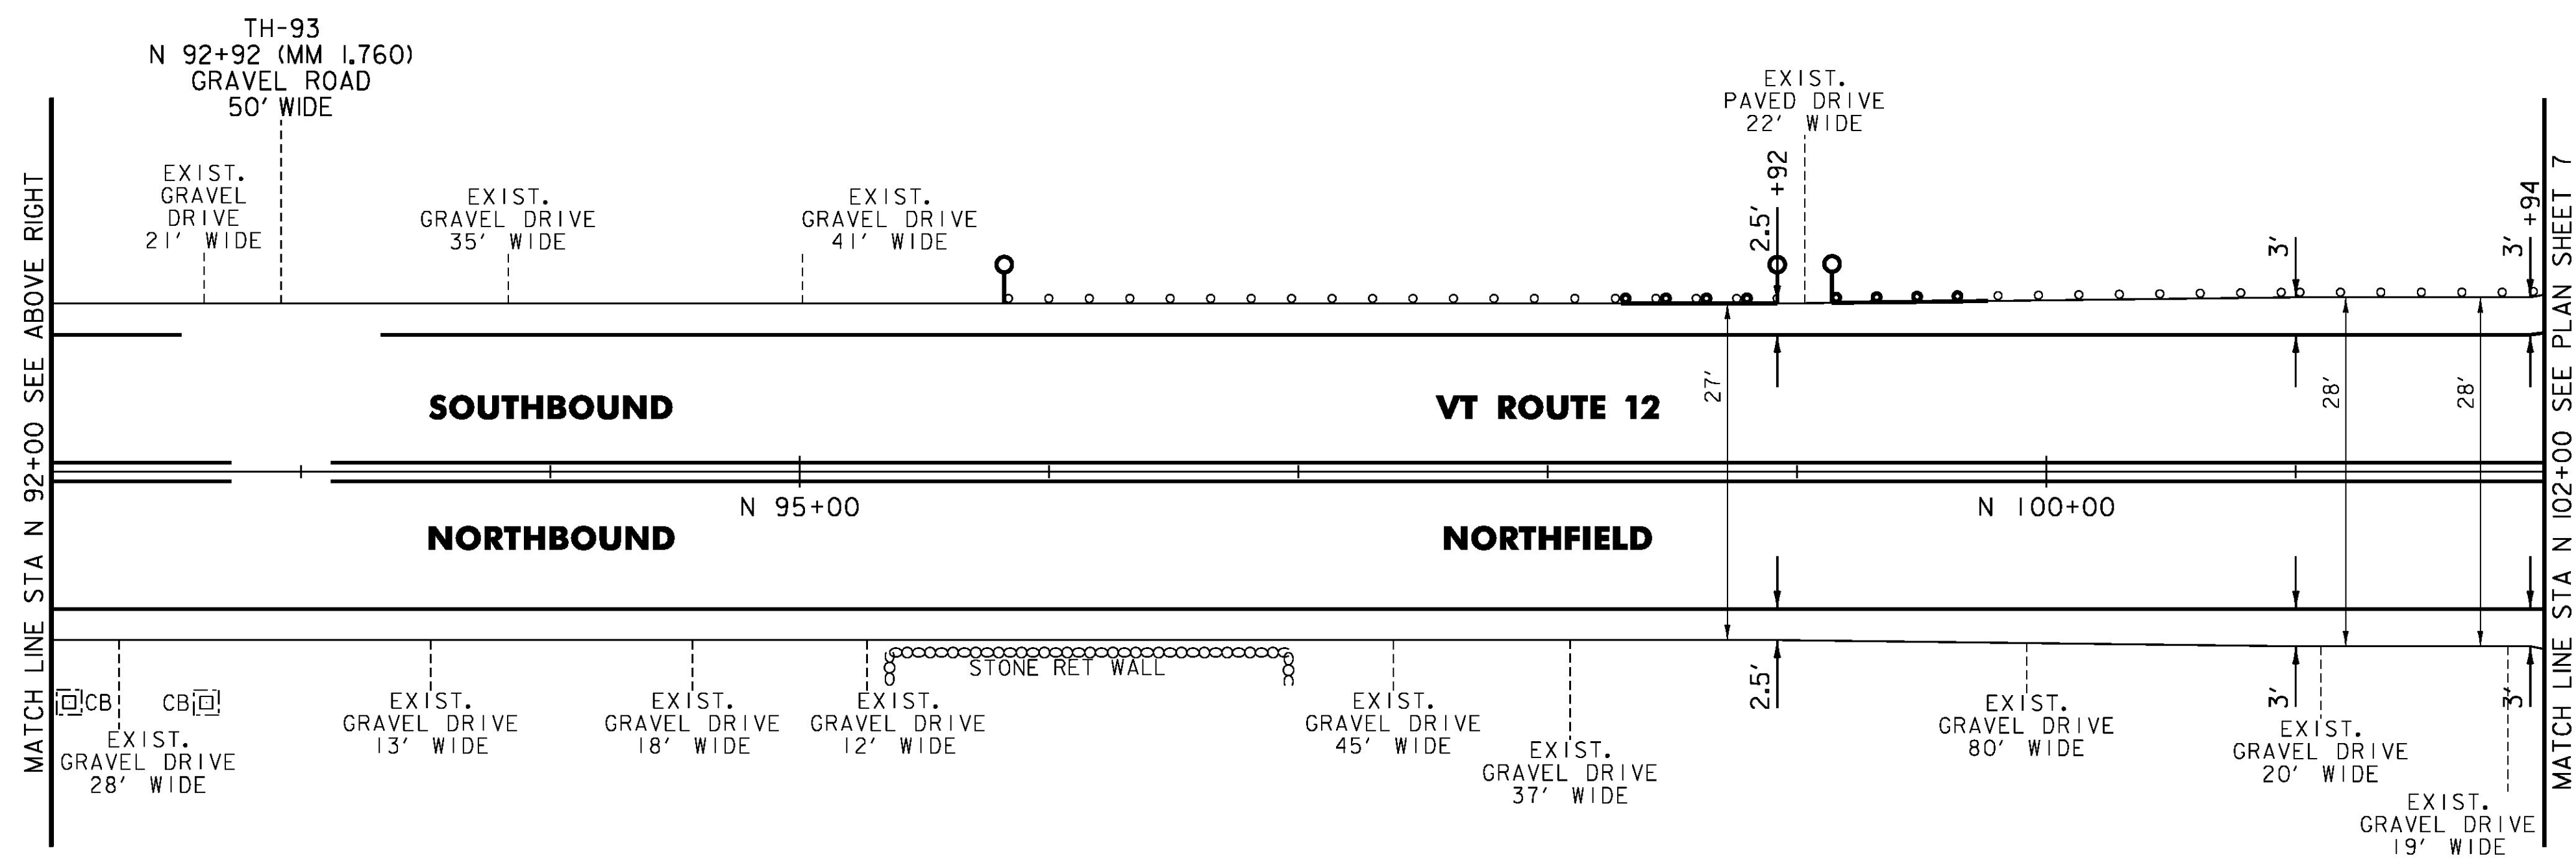


TEMPORARY 4 INCH WHITE LINE, PAINT
 4 INCH WHITE LINE, WATERBORNE PAINT
 (ALL LINES WILL INCLUDE EDGE LINE
 BREAKS AND RADII FOR SIDE ROADS)
 N 81+00 TO TO N 102+00 LT & RT (SOLID)

TEMPORARY 4 INCH YELLOW LINE, PAINT
 4 INCH YELLOW LINE, WATERBORNE PAINT
 (ALL LINES WILL INCLUDE $\frac{1}{2}$
 BREAKS FOR SIDE ROADS)
 N 81+00 TO N 102+00 LT & RT (SOLID)

REMOVE AND RESET GUARDRAIL
 N 81+00 TO N 82+33.5 LT
 N 86+22 TO N 87+47 LT
 N 98+29.5 TO N 98+92 LT
 N 99+14 TO N 99+76.5 LT

DELINEATOR WITH STEEL POST
 N 87+47 LT
 N 95+82 LT
 N 98+92 LT
 N 99+14 LT

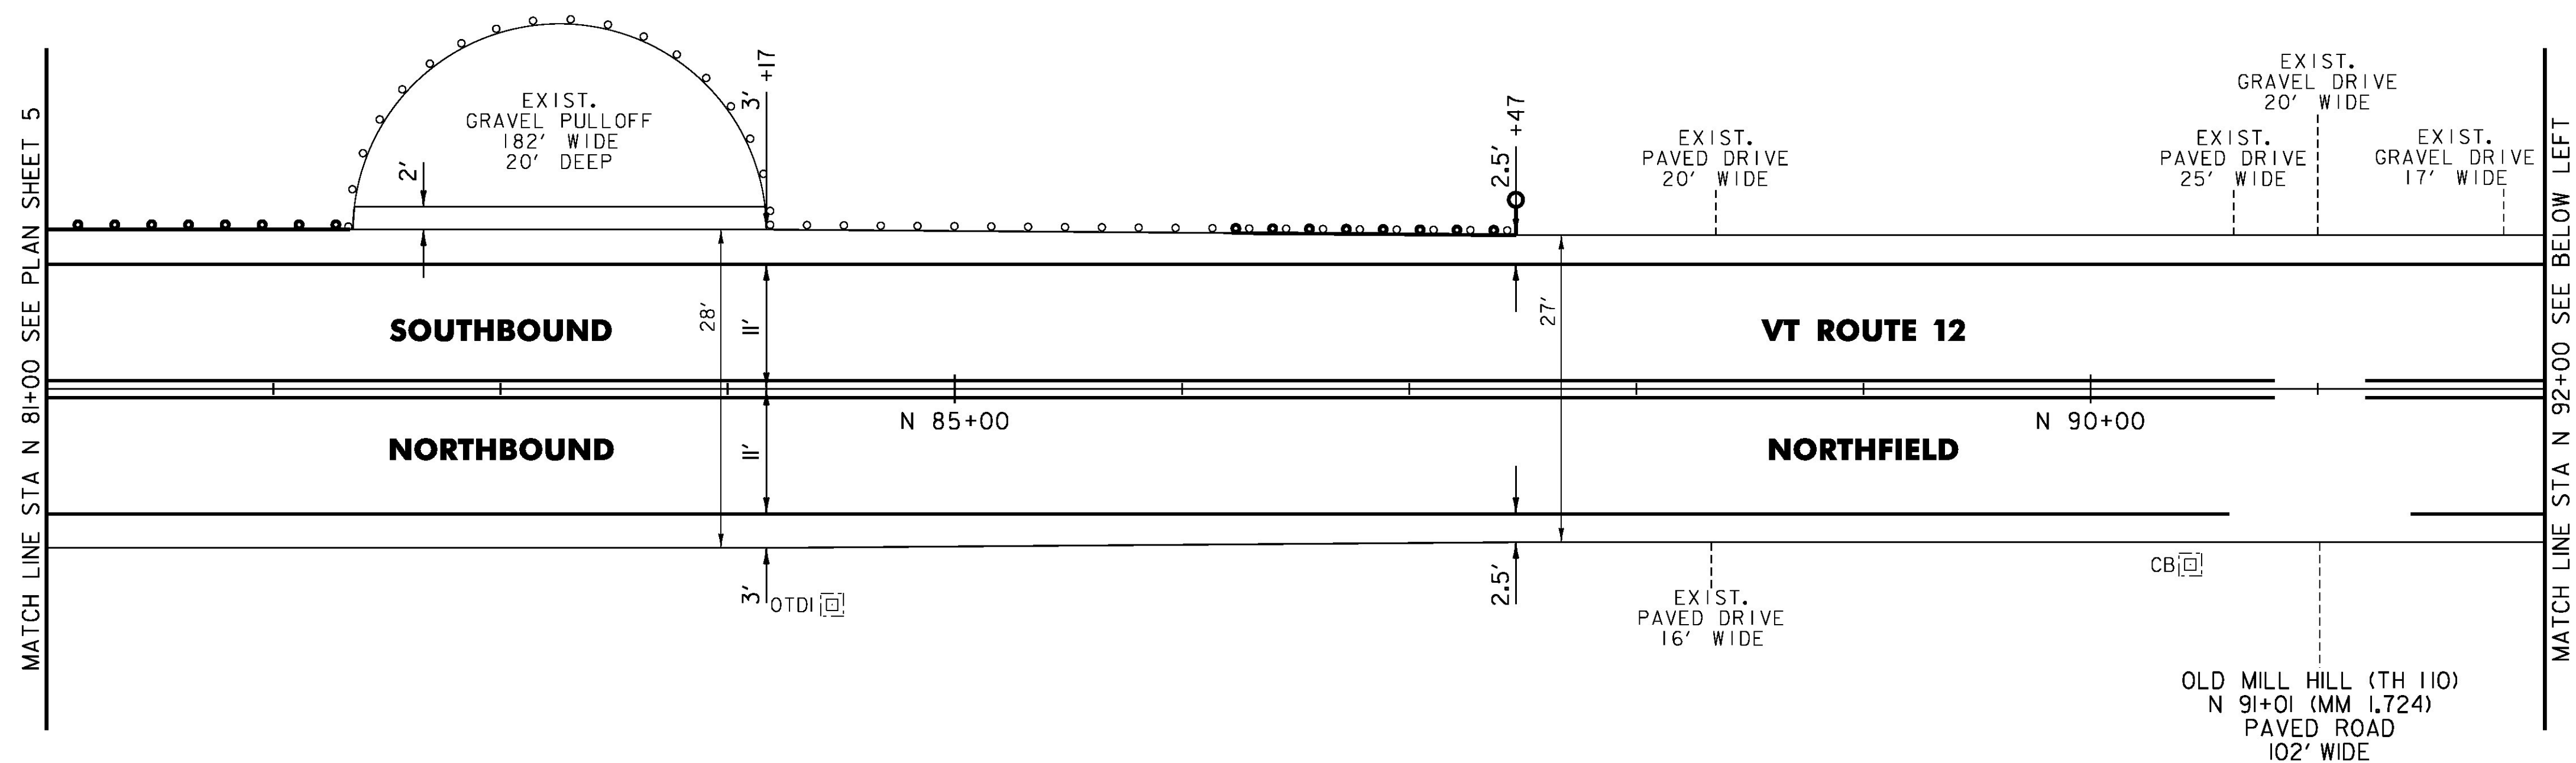

NOT TO SCALE

PROJECT NAME: ROXBURY-NORTHFIELD
 PROJECT NUMBER: STP FPAV(6)

FILE NAME: z16v027bdr.dgn
 PROJECT LEADER: P. SHEDD
 DESIGNED BY: N. LEMAY
 PLAN SHEET 6

PLOT DATE: 2/8/2017
 DRAWN BY: S. GOODWIN
 CHECKED BY: P. SHEDD
 SHEET 19 OF 21