


TEMPORARY 4 INCH WHITE LINE, PAINT  
 4 INCH WHITE LINE, WATERBORNE PAINT  
 (ALL LINES WILL INCLUDE EDGE LINE  
 BREAKS AND RADII FOR SIDE ROADS)  
 188+00 TO 216+00 LT & RT (SOLID)

TEMPORARY 4 INCH YELLOW LINE, PAINT  
 4 INCH YELLOW LINE, WATERBORNE PAINT  
 (ALL LINES WILL INCLUDE  $\phi$   
 BREAKS FOR SIDE ROADS)  
 188+00 TO 194+05 LT (DASHED), RT (SOLID)  
 194+05 TO 216+00 LT & RT (SOLID)

STEEL BEAM GUARDRAIL, GALVANIZED  
 203+32.5 TO 203+70 LT  
 206+10 TO 206+72.5 LT  
 210+46.5 TO 210+84 LT  
 ANCHOR FOR STEEL BEAM RAIL  
 3 (SEE STANDARD G-1d)

REMOVAL AND DISPOSAL OF GUARDRAIL  
 203+32.5 TO 203+70 LT  
 206+10 TO 206+72.5 LT  
 210+46.5 TO 210+84 LT  
 DELINEATOR WITH STEEL POST  
 201+27 LT  
 203+70 LT  
 206+10 LT  
 210+84 LT

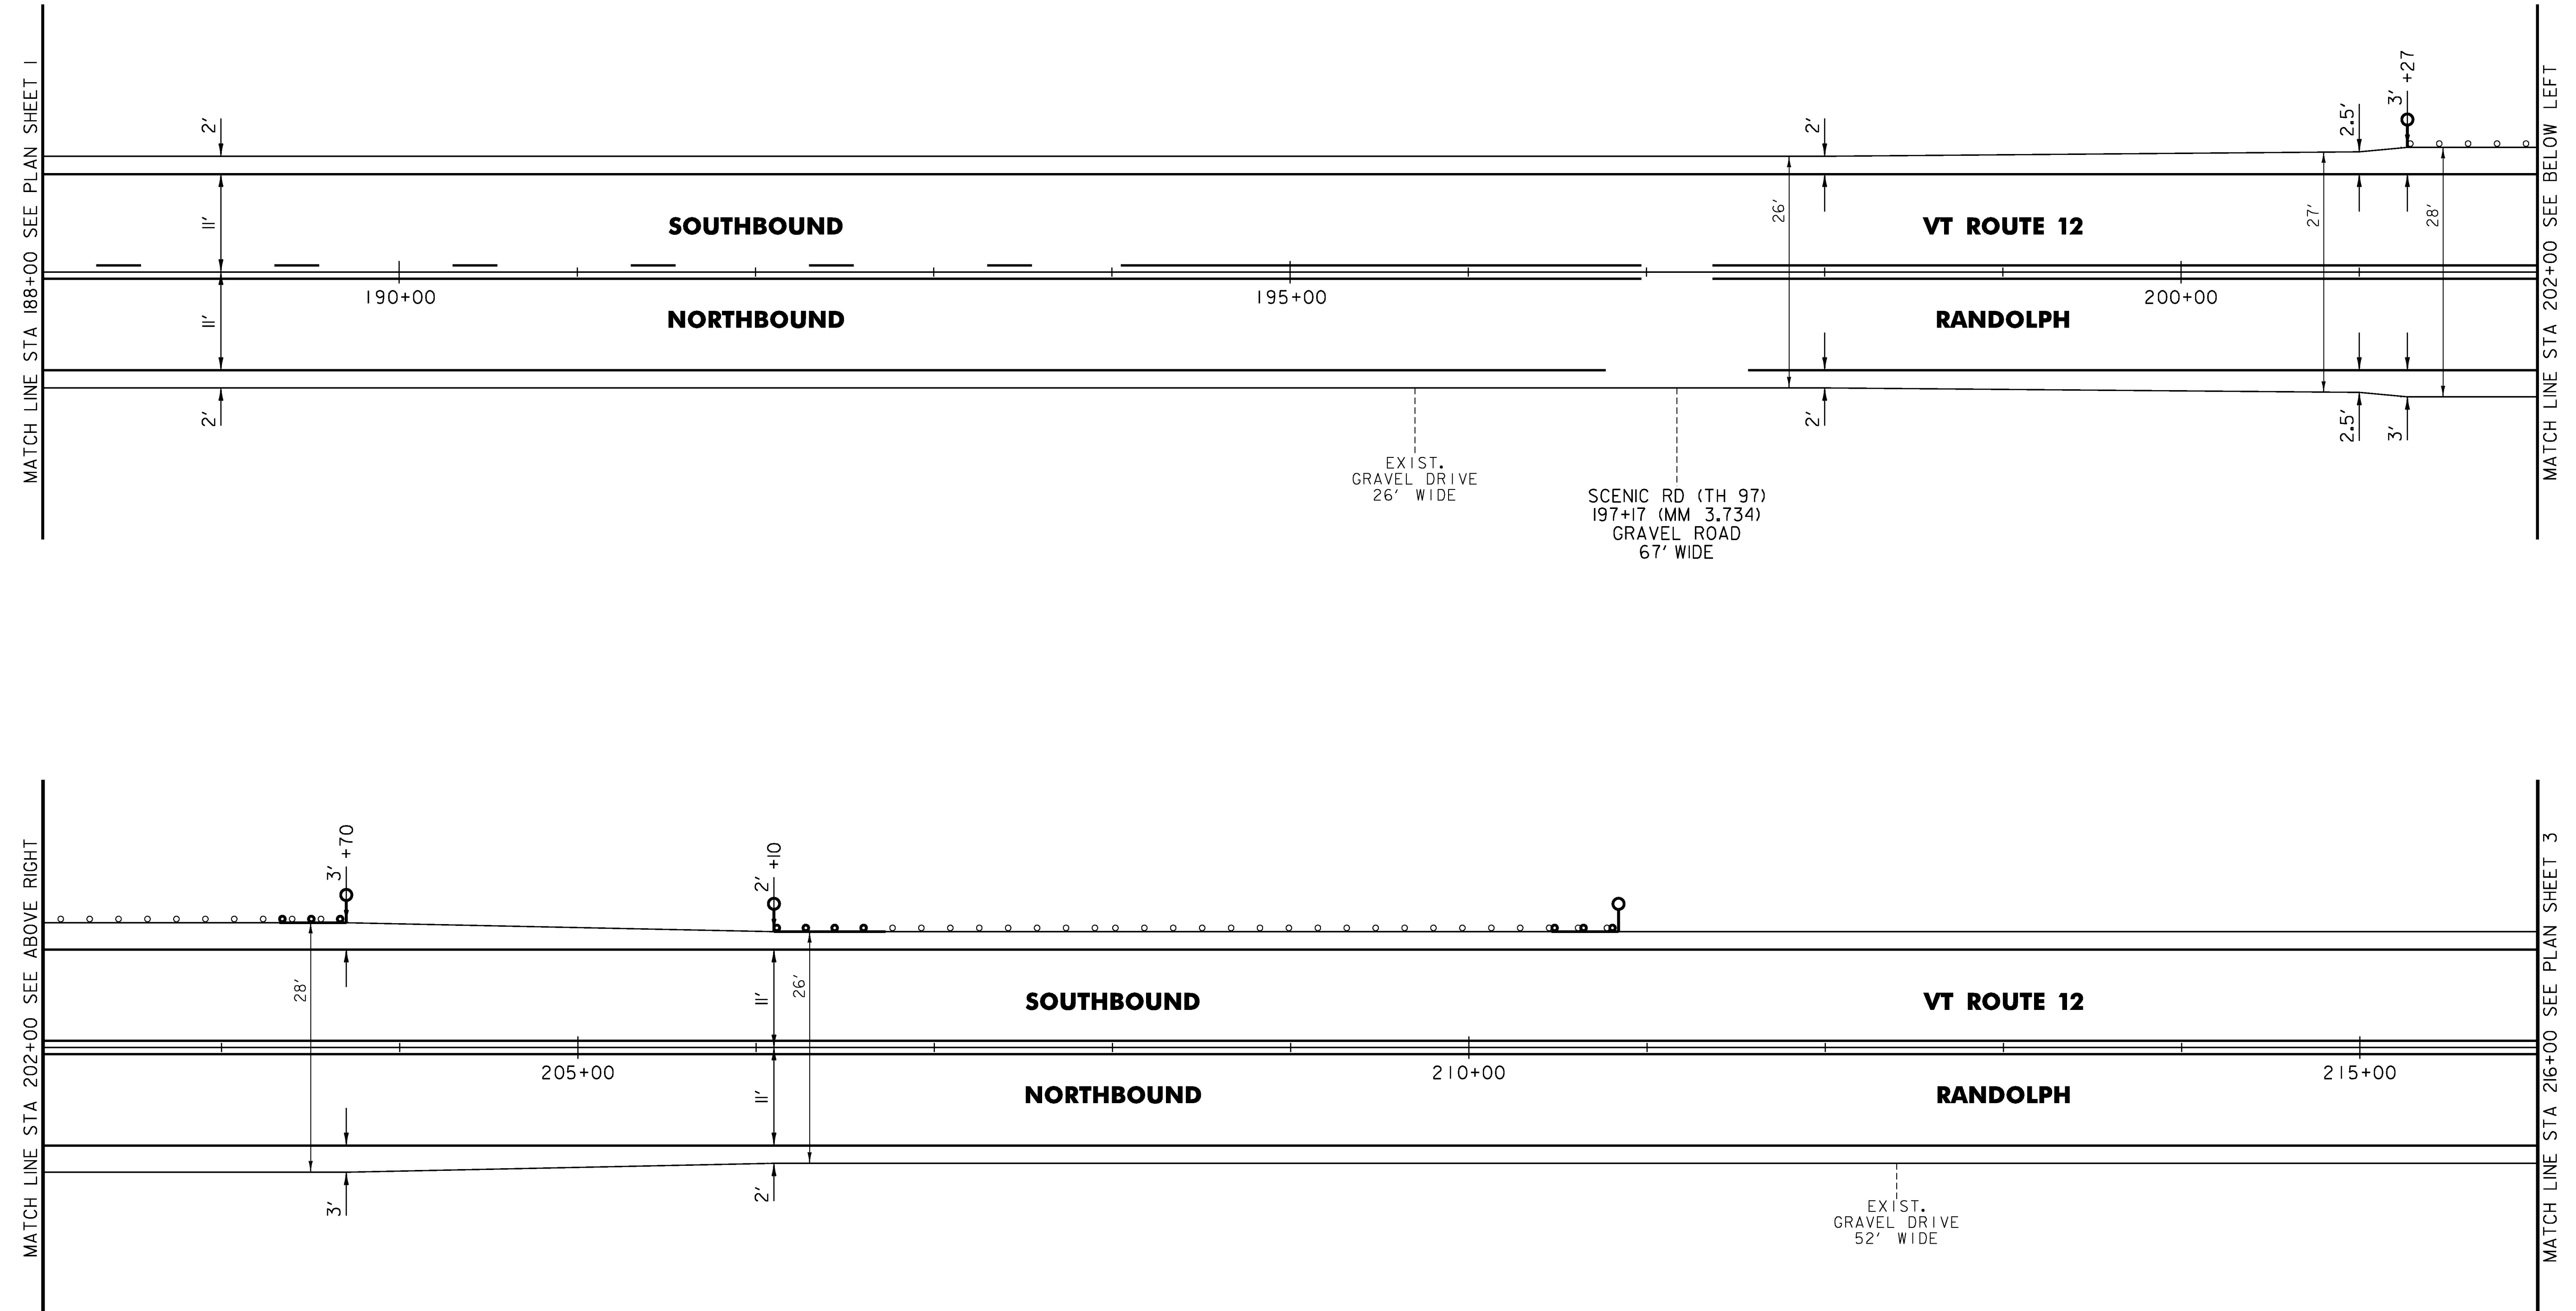

NOT TO SCALE

PROJECT NAME:	RANDOLPH-BRAINTREE
PROJECT NUMBER:	STP FPAV(7)
FILE NAME: z16v028bdr.dgn	PLOT DATE: 2/8/2017
PROJECT LEADER: P. SHEDD	DRAWN BY: S. GOODWIN
DESIGNED BY: N. LEMAY	CHECKED BY: P. SHEDD
PLAN SHEET 2	SHEET 15 OF 24