

TEMPORARY 4 INCH WHITE LINE, PAINT
 4 INCH WHITE LINE, WATERBORNE PAINT
 (ALL LINES WILL INCLUDE EDGE LINE
 BREAKS AND RADII FOR SIDE ROADS)
 216+00 TO 244+00 LT & RT (SOLID)


TEMPORARY 4 INCH YELLOW LINE, PAINT
 4 INCH YELLOW LINE, WATERBORNE PAINT
 (ALL LINES WILL INCLUDE CL
 BREAKS FOR SIDE ROADS)
 216+00 TO 231+00 LT & RT (SOLID)
 231+00 TO 237+05 LT (SOLID), RT (DASHED)
 237+05 TO 244+00 CL (DASHED)

STEEL BEAM GUARDRAIL, GALVANIZED
 227+68 TO 228+05.5 LT
 230+05.5 TO 230+43 LT

 ANCHOR FOR STEEL BEAM RAIL
 2 (SEE STANDARD G-1d)

REMOVAL AND DISPOSAL OF GUARDRAIL
 227+68 TO 228+05.5 LT
 230+05.5 TO 230+43 LT

 DELINEATOR WITH STEEL POST
 227+68 LT
 230+43 LT

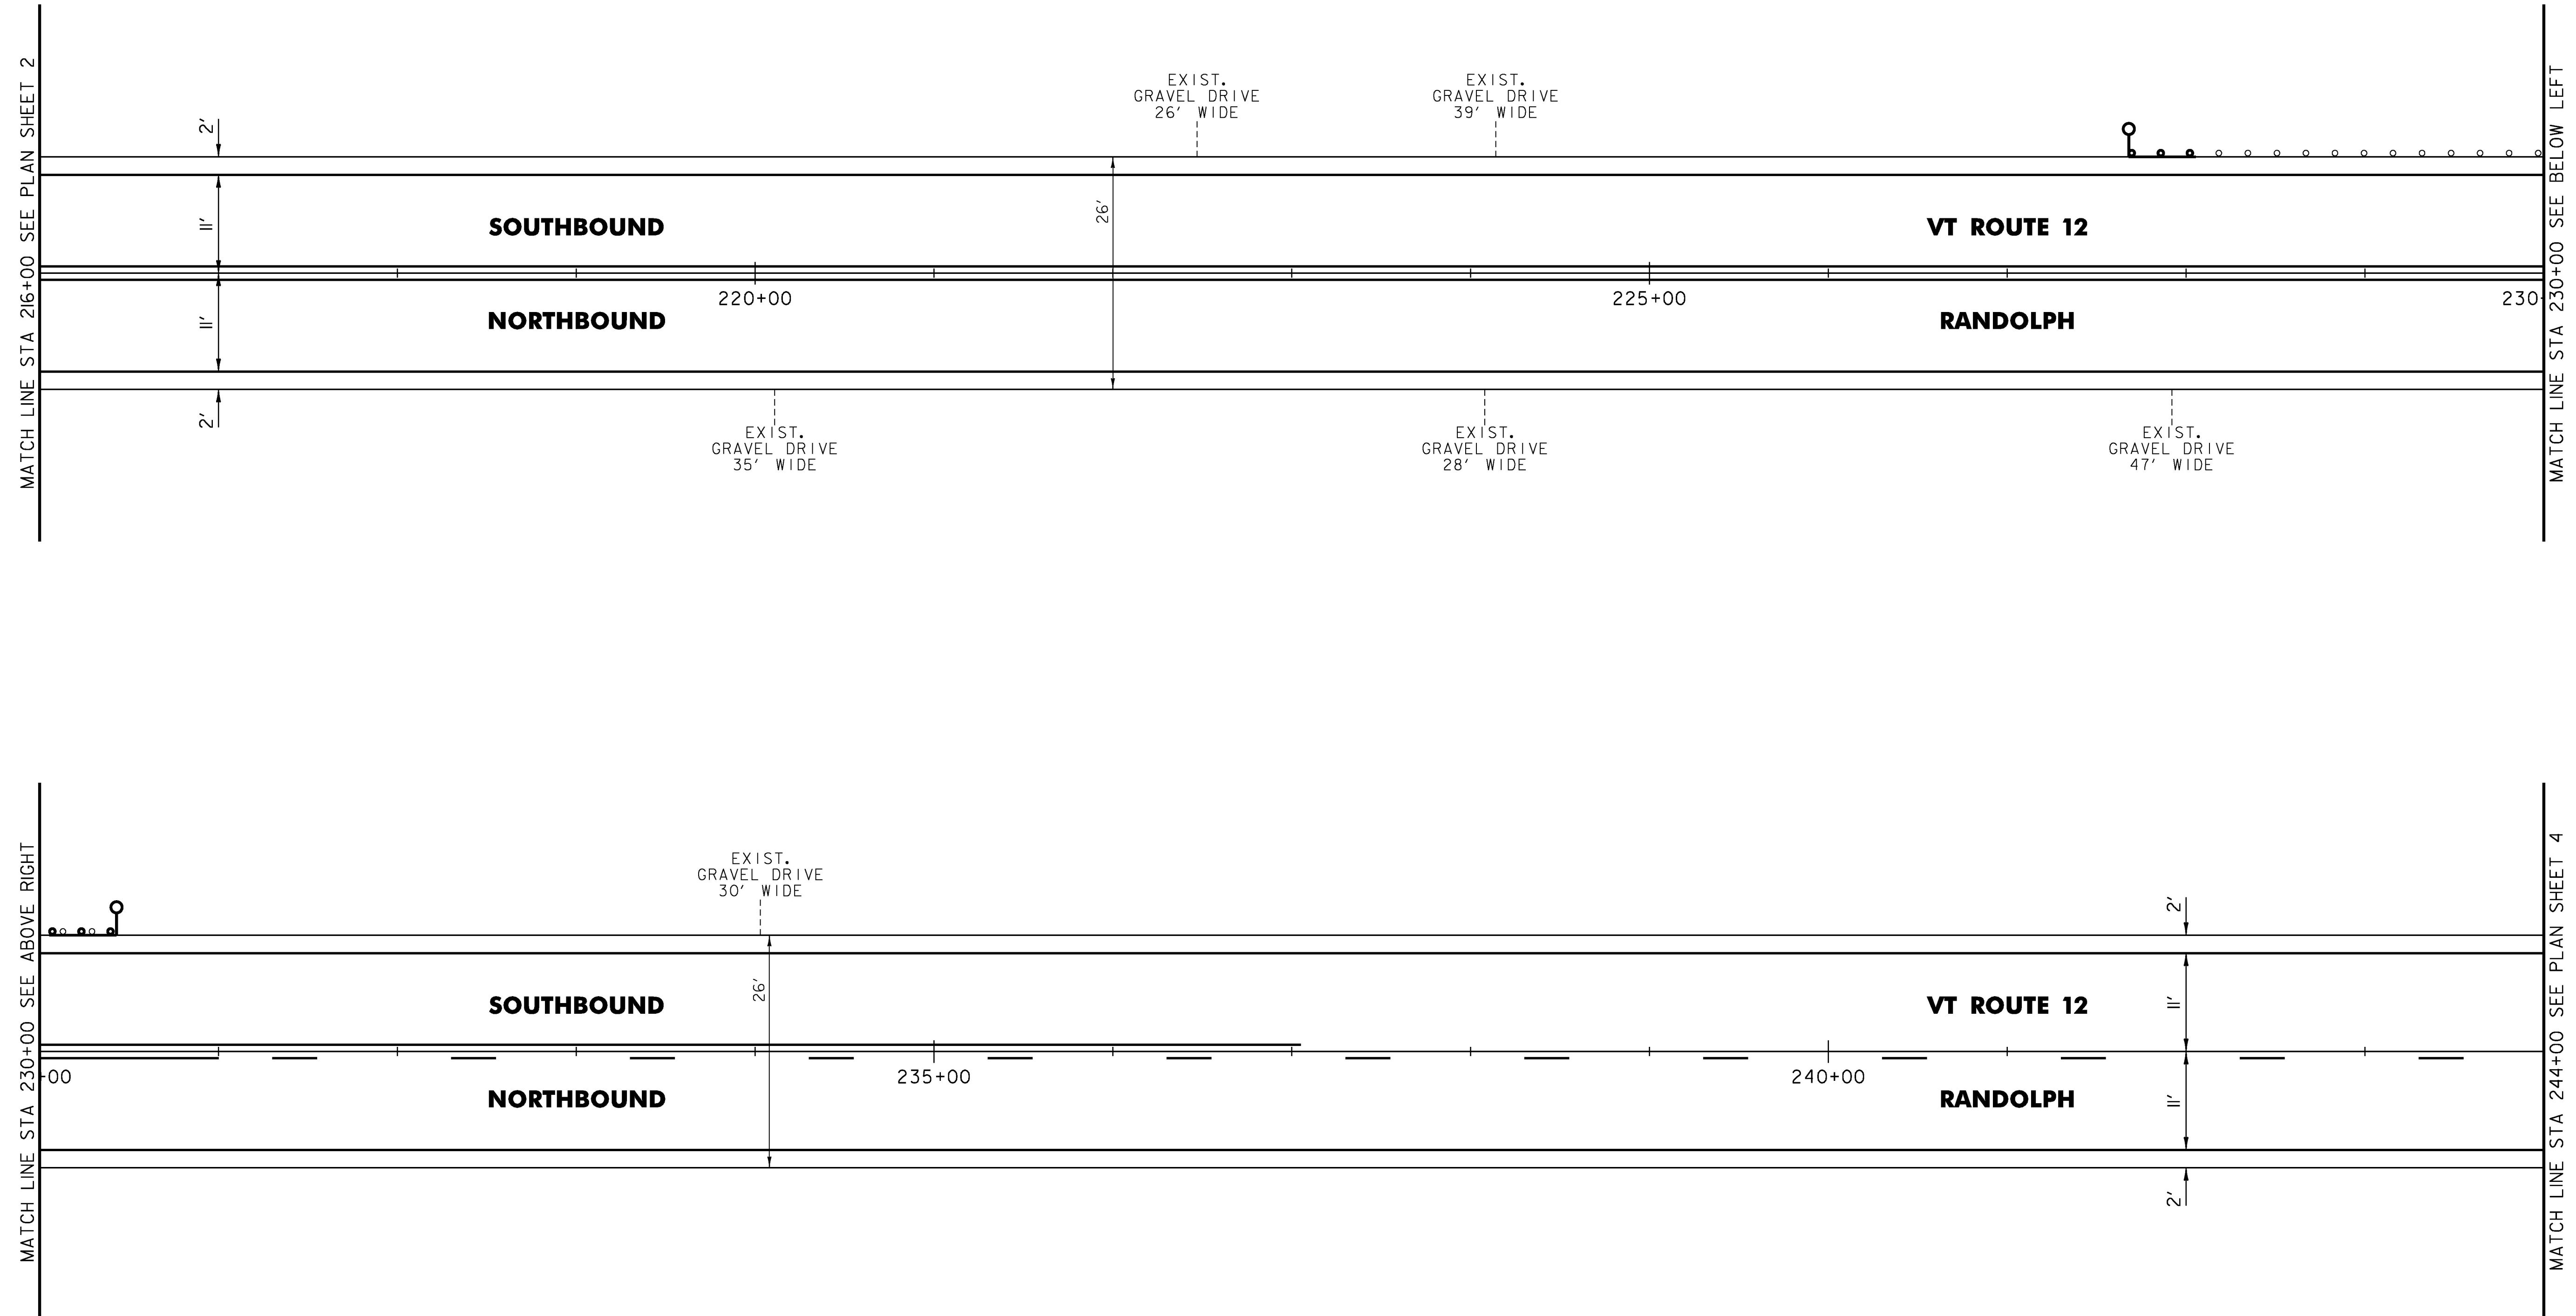

NOT TO SCALE

PROJECT NAME:	RANDOLPH-BRAINTREE
PROJECT NUMBER:	STP FPAV(7)
FILE NAME:	z16v028bdr.dgn
PROJECT LEADER:	P. SHEDD
DESIGNED BY:	N. LEMAY
PLAN SHEET 3	
PLOT DATE:	2/8/2017
DRAWN BY:	S. GOODWIN
CHECKED BY:	P. SHEDD
SHEET	16 OF 24