

TEMPORARY 4 INCH WHITE LINE, PAINT
 4 INCH WHITE LINE, WATERBORNE PAINT
 (ALL LINES WILL INCLUDE EDGE LINE
 BREAKS AND RADII FOR SIDE ROADS)
 300+00 TO 328+00 LT & RT (SOLID)



TEMPORARY 4 INCH YELLOW LINE, PAINT
 4 INCH YELLOW LINE, WATERBORNE PAINT
 (ALL LINES WILL INCLUDE $\frac{1}{2}$
 BREAKS FOR SIDE ROADS)
 300+00 TO 302+30 LT (DASHED), RT (SOLID)
 302+30 TO 304+15 LT & RT (SOLID)
 304+15 TO 311+35 LT (SOLID), RT (DASHED)
 311+35 TO 311+60 CL (DASHED)
 311+60 TO 320+25 LT (DASHED), RT (SOLID)
 320+25 TO 328+00 LT & RT (SOLID)

STEEL BEAM GUARDRAIL, GALVANIZED
 320+72 TO 321+09.5 LT

ANCHOR FOR STEEL BEAM RAIL
 1' (SEE STANDARD G-1d)

REMOVAL AND DISPOSAL OF GUARDRAIL
 320+72 TO 321+09.5 LT

DELINEATOR WITH STEEL POST
 320+72 LT

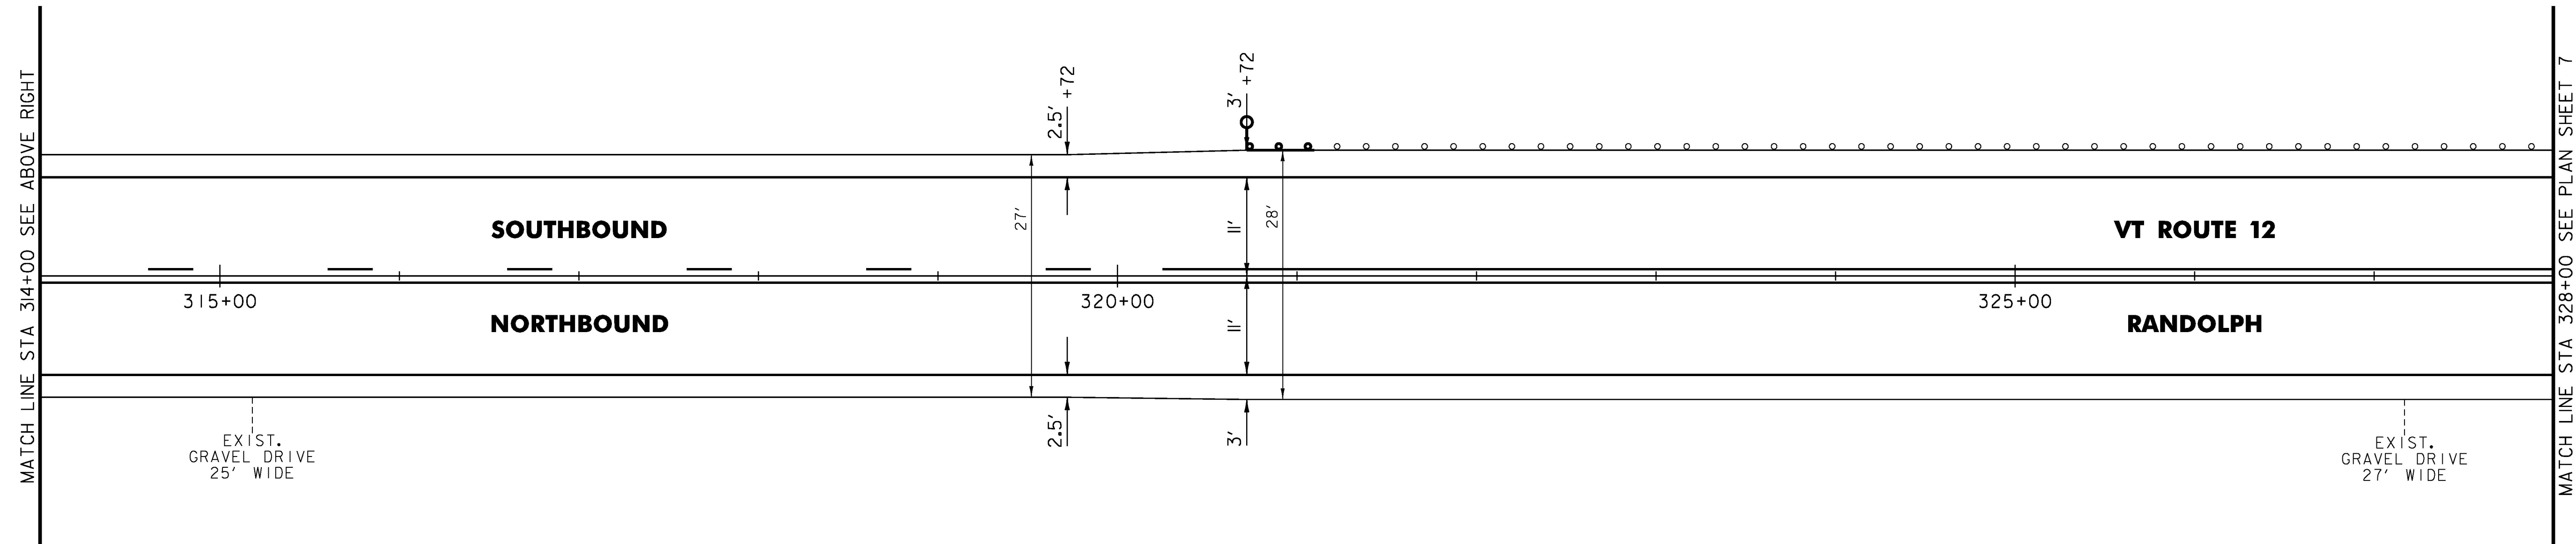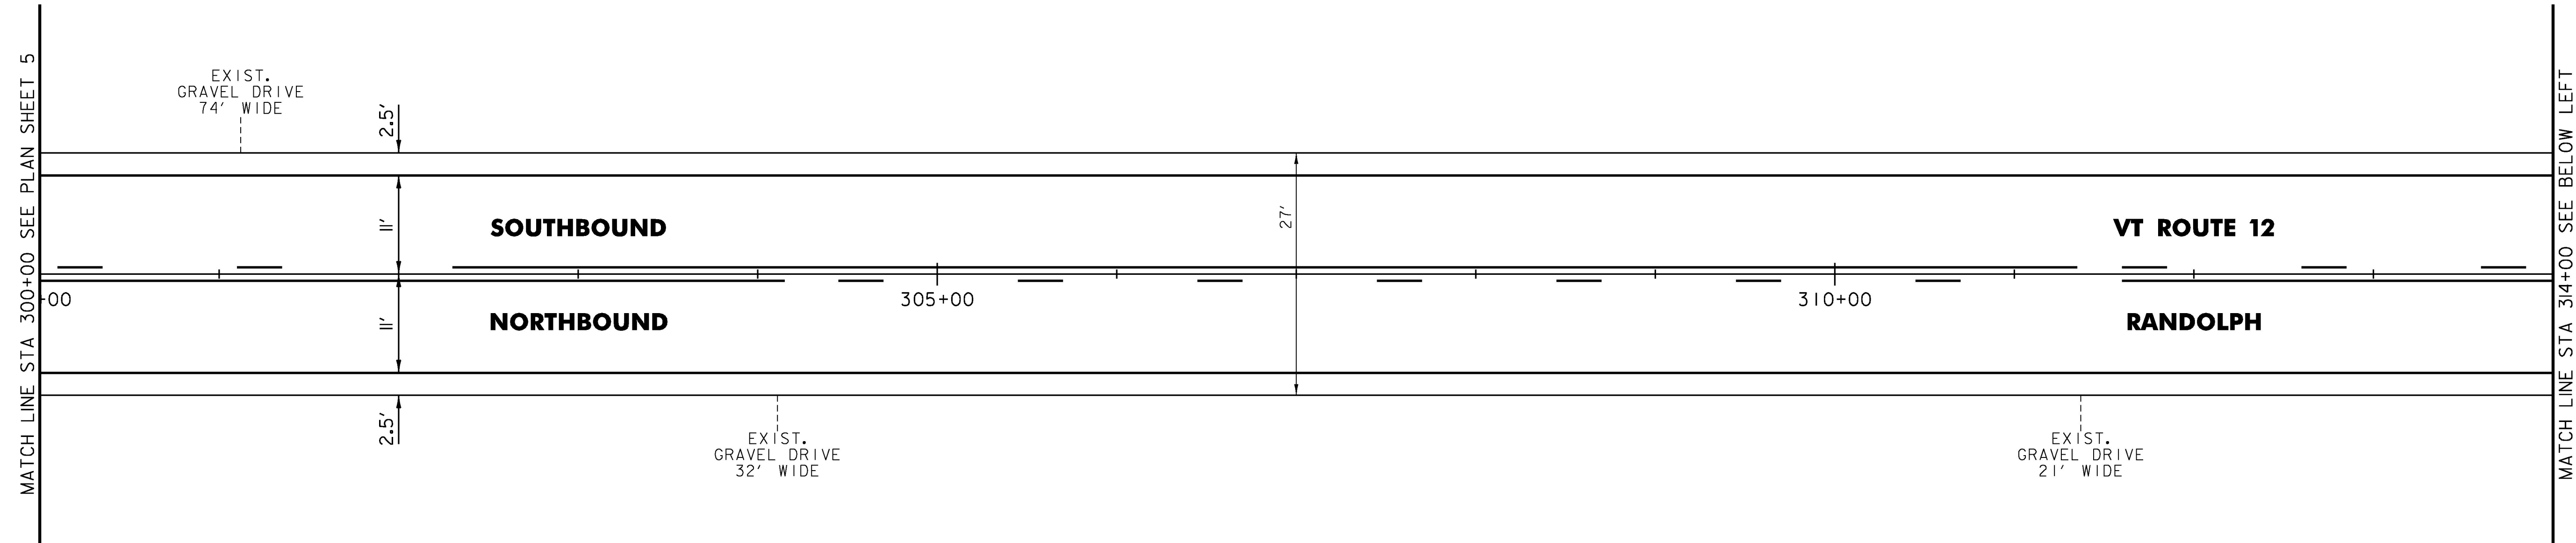

NOT TO SCALE

| | |
|-----------------|--------------------|
| PROJECT NAME: | RANDOLPH-BRAINTREE |
| PROJECT NUMBER: | STP FPAV(7) |
| FILE NAME: | z16v028bdr.dgn |
| PROJECT LEADER: | P. SHEDD |
| DESIGNED BY: | N. LEMAY |
| PLAN SHEET | 6 |
| PLOT DATE: | 2/8/2017 |
| DRAWN BY: | S. GOODWIN |
| CHECKED BY: | P. SHEDD |
| SHEET | 19 OF 24 |