


**MICRO-MILLING DETAIL - NORMAL SECTION**

I-89 NB MONTPELIER MM 52.467 - WATERBURY MM 63.200  
 I-89 SB MONTPELIER MM 52.500 - WATERBURY MM 63.200

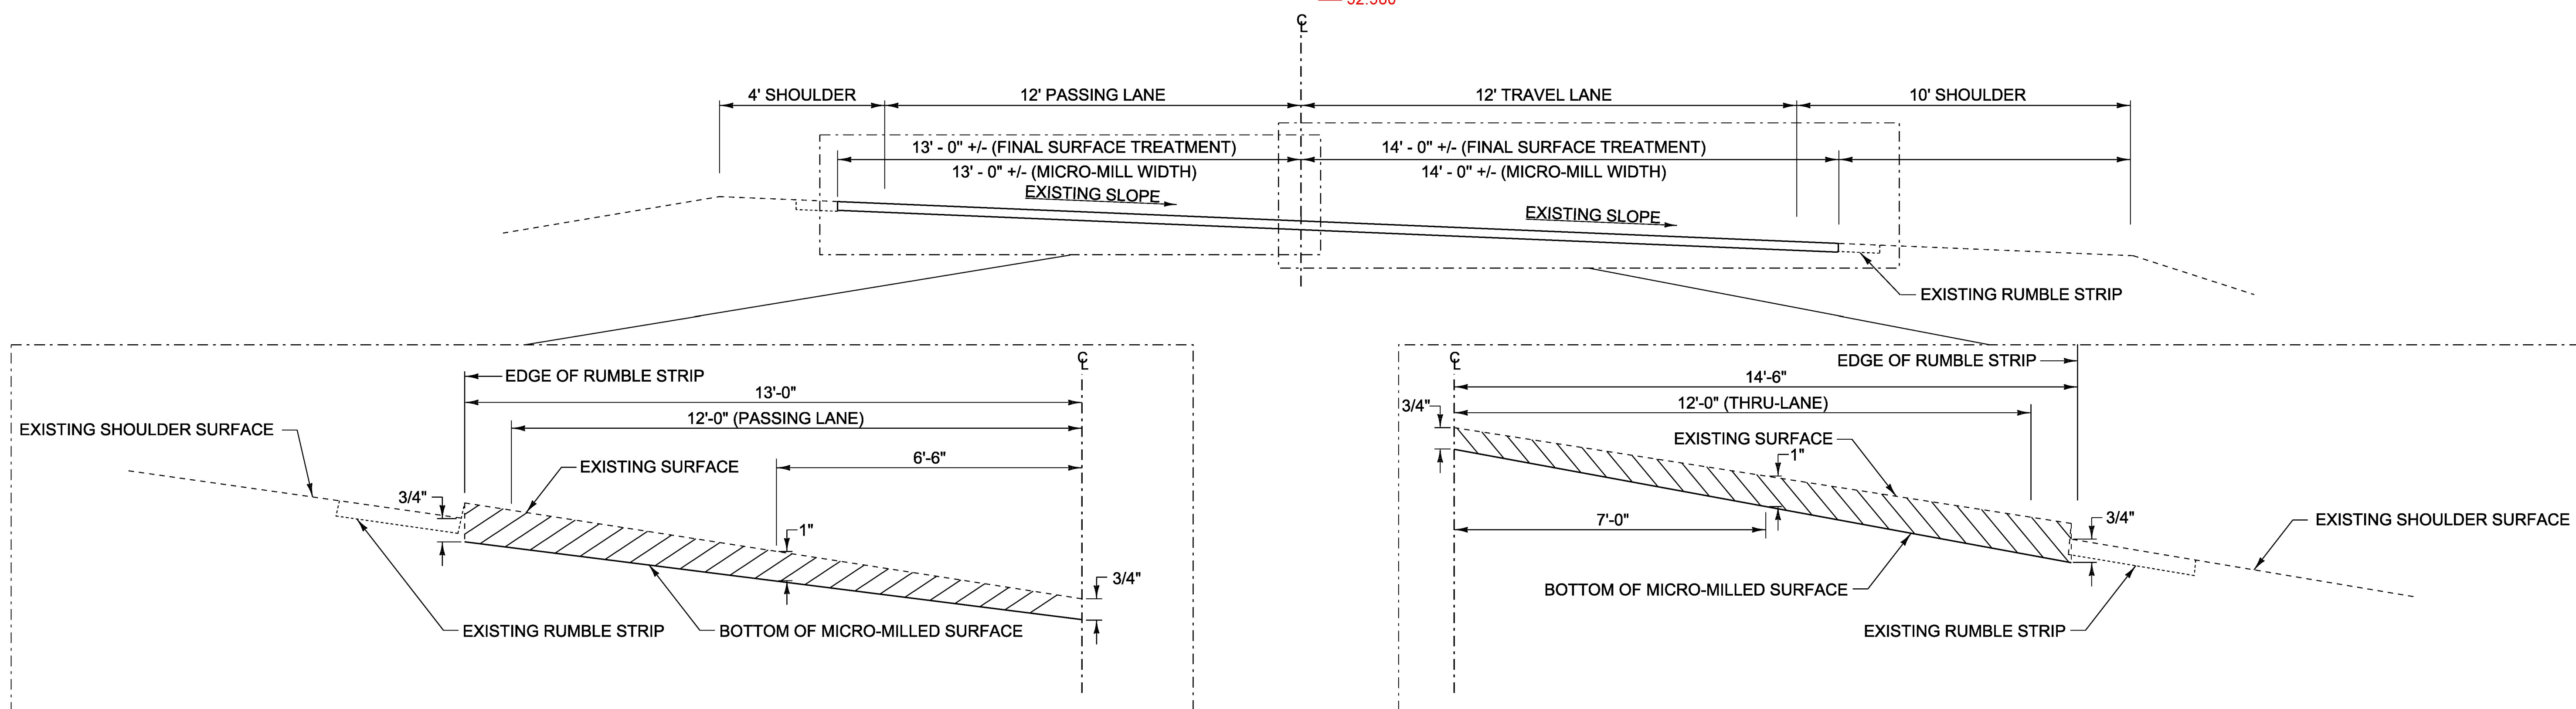

**MICRO-MILLING DETAIL - BANKED SECTION**

I-89 NB MONTPELIER MM 52.467 - WATERBURY MM 63.200  
 I-89 SB MONTPELIER MM 52.500 - WATERBURY MM 63.200

**NOT TO SCALE**

PROJECT NAME:	MONTPELIER-WATERBURY
PROJECT NUMBER:	IM SURF(59)
FILE NAME: pl6v098 Montpelier-Water.dgn	PLOT DATE: 20-MAR-2018
PROJECT LEADER: M. BOGACZYK	DRAWN BY: N. PAPPAS
DESIGNED BY: N. PAPPAS	CHECKED BY: M. BOGACZYK
MICRO-MILLING DETAIL SHEET	SHEET 4 OF 34