


IN-LAY DETAIL - NORMAL SECTION
 I-89 NB MONTPELIER MM 52.467 - WATERBURY MM 63.200
 I-89 SB MONTPELIER MM 52.500 - WATERBURY MM 63.200

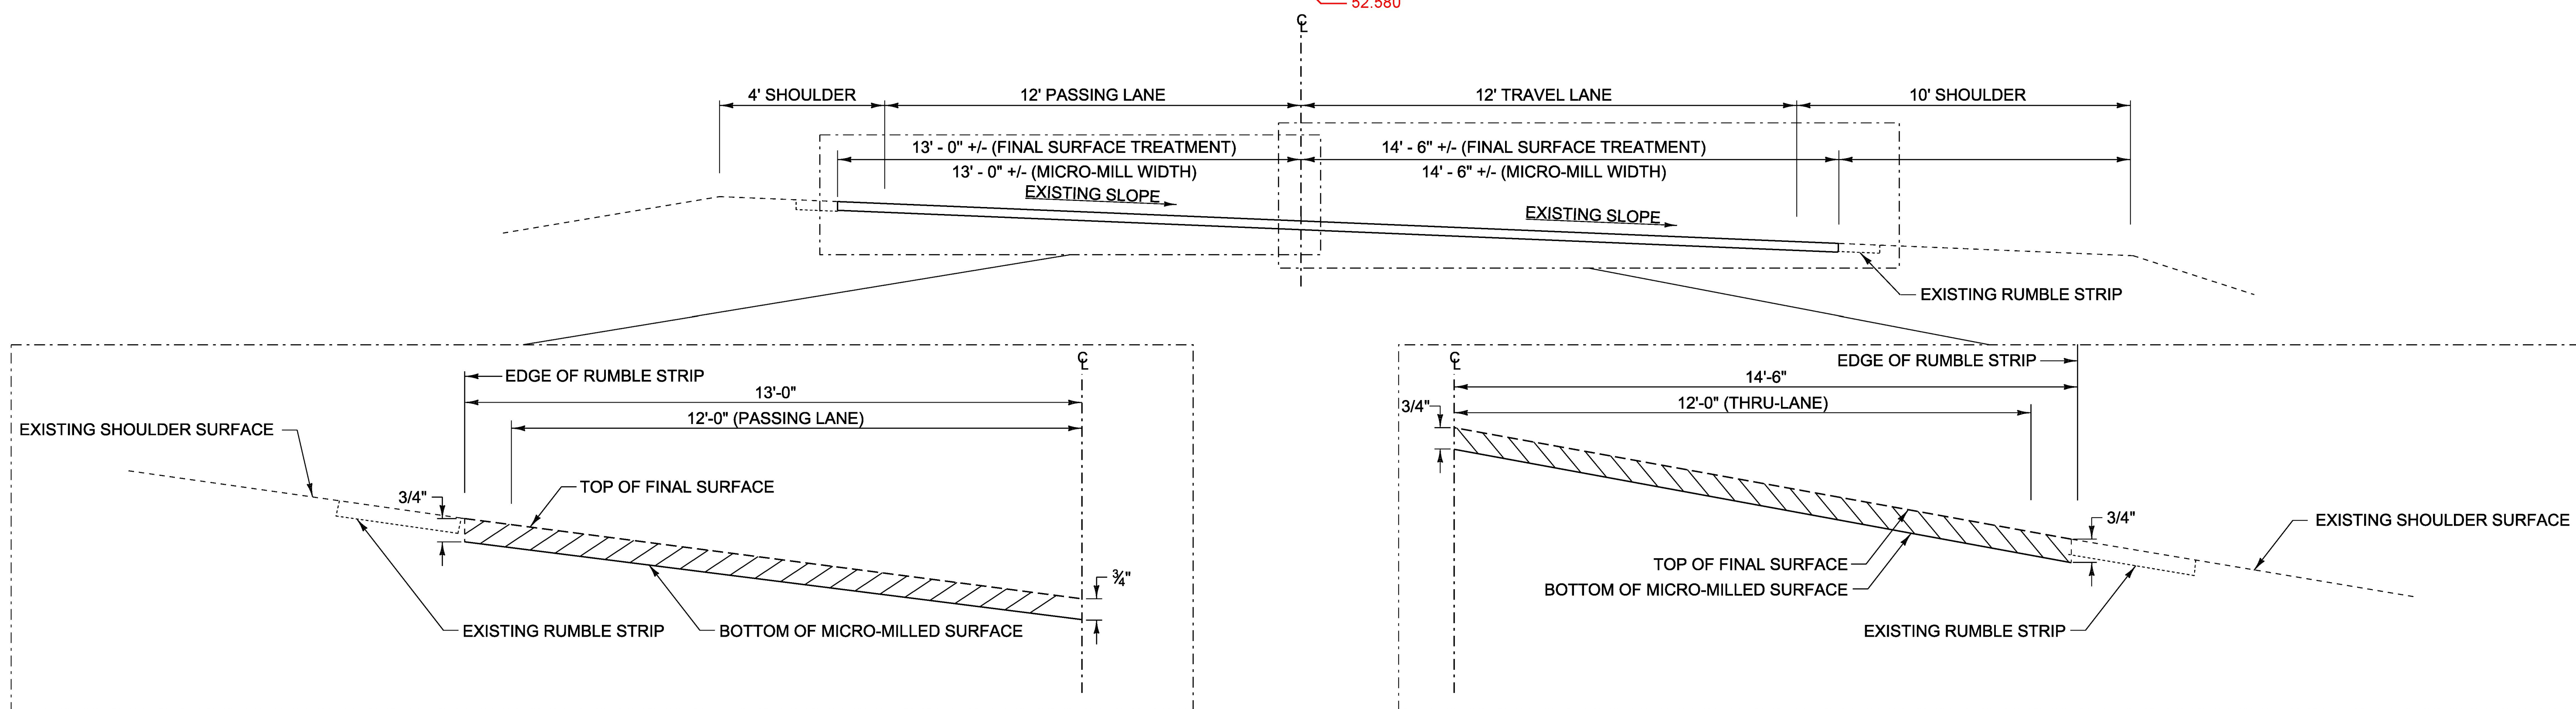

IN-LAY DETAIL - BANKED SECTION
 I-89 NB MONTPELIER MM 52.467 - WATERBURY MM 63.200
 I-89 SB MONTPELIER MM 52.500 - WATERBURY MM 63.200

NOT TO SCALE

PROJECT NAME:	MONTPELIER-WATERBURY
PROJECT NUMBER:	IM SURF(59)
FILE NAME: pl6v098 Montpelier-Water.dgn	PLOT DATE: 20-MAR-2018
PROJECT LEADER: M. BOGACZYK	DRAWN BY: N. PAPPAS
DESIGNED BY: N. PAPPAS	CHECKED BY: M. BOGACZYK
INLAY DETAIL SHEET	SHEET 5 OF 34