
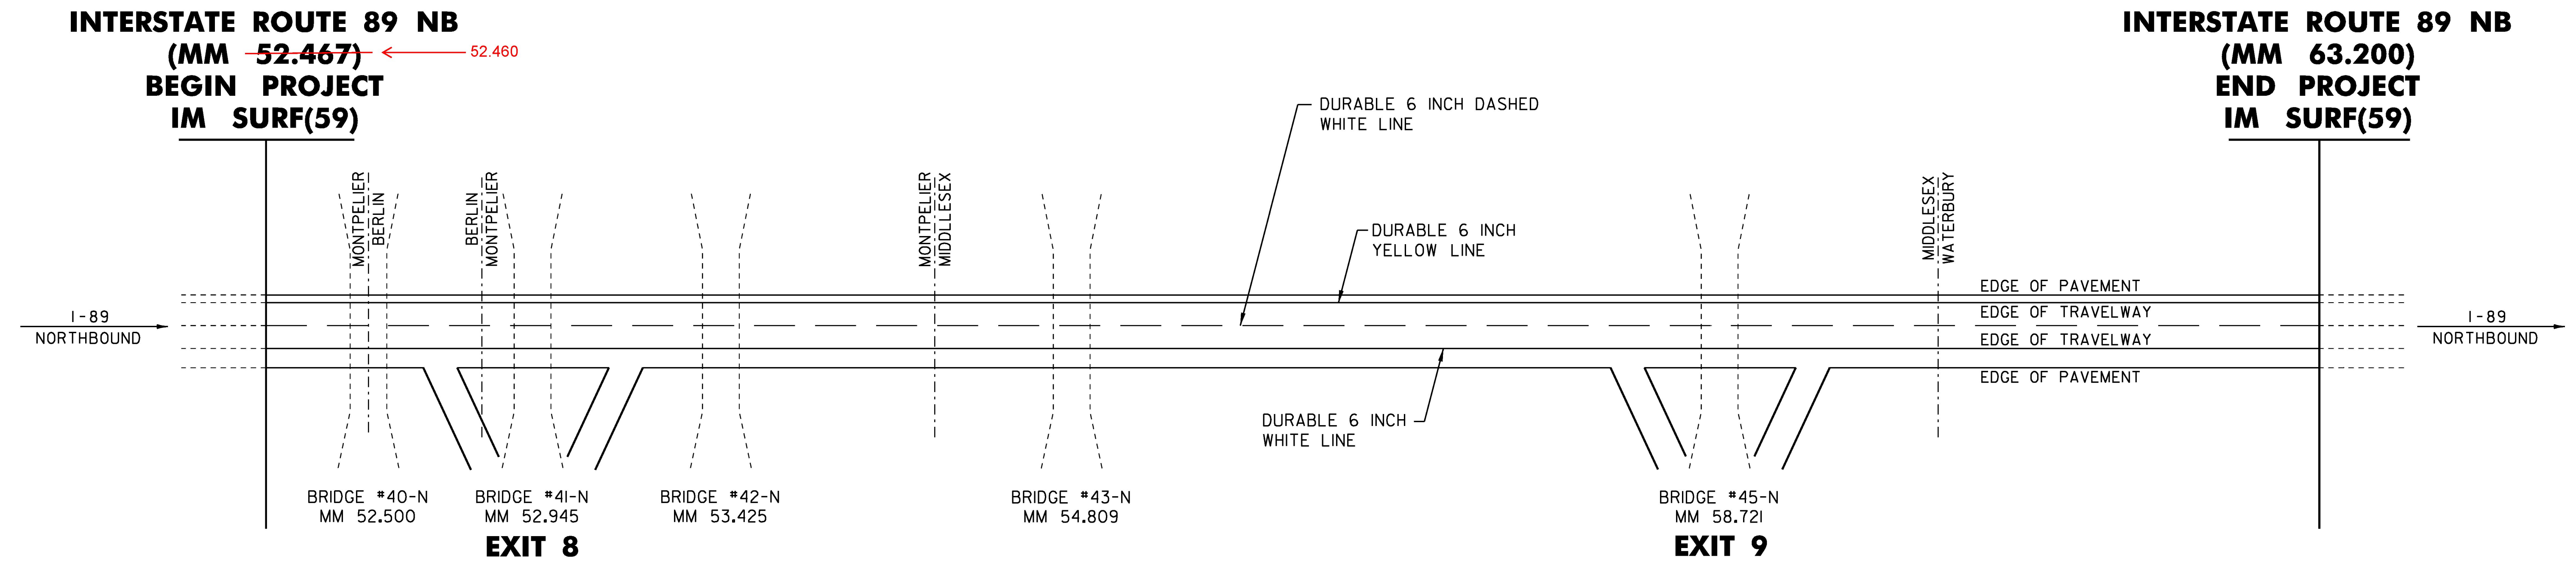


TEMPORARY 6" WHITE LINE &
 DURABLE 6 INCH WHITE LINE, (SEE OPTION ITEM)
 NB MM 52.467 - MM 63.200 (SOLID RT)
 NB MM 52.467 - MM 63.200 (DASHED)
 SB MM 52.500 - MM 63.200 (SOLID LT)
 SB MM 52.500 - MM 63.200 (DASHED)

TEMPORARY 6" YELLOW LINE &
 DURABLE 6 INCH YELLOW LINE, (SEE OPTION ITEM)
 NB MM 52.467 - MM 63.200 (SOLID LT)
 SB MM 52.500 - MM 63.200 (SOLID RT)

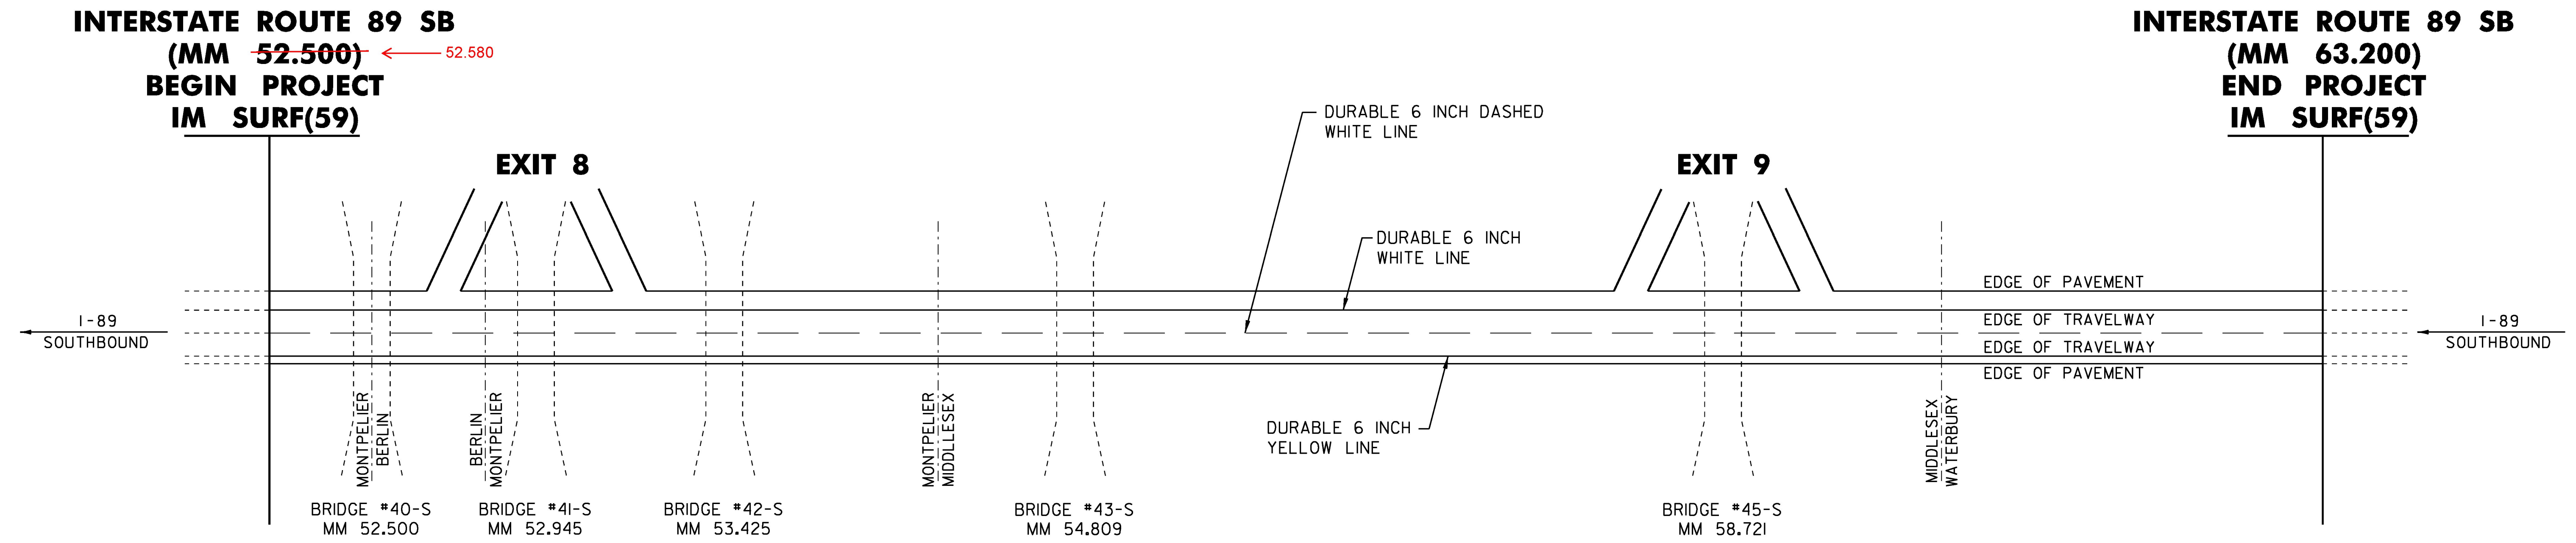

NOT TO SCALE

PROJECT NAME:	MONTPELIER-WATERBURY
PROJECT NUMBER:	IM SURF(59)
FILE NAME: pl6v098 Montpelier-Water.dgn	PLOT DATE: 20-MAR-2018
PROJECT LEADER: M. BOGACZYK	DRAWN BY: N. PAPPAS
DESIGNED BY: N. PAPPAS	CHECKED BY: M. BOGACZYK
PAVEMENT MARKING DETAIL SHEET 1	SHEET 15 OF 34