


**EXPANSION JOINT - ASPHALTIC APPROACH MATERIAL DETAIL
PLAN VIEW
(VERMONT JOINT)**

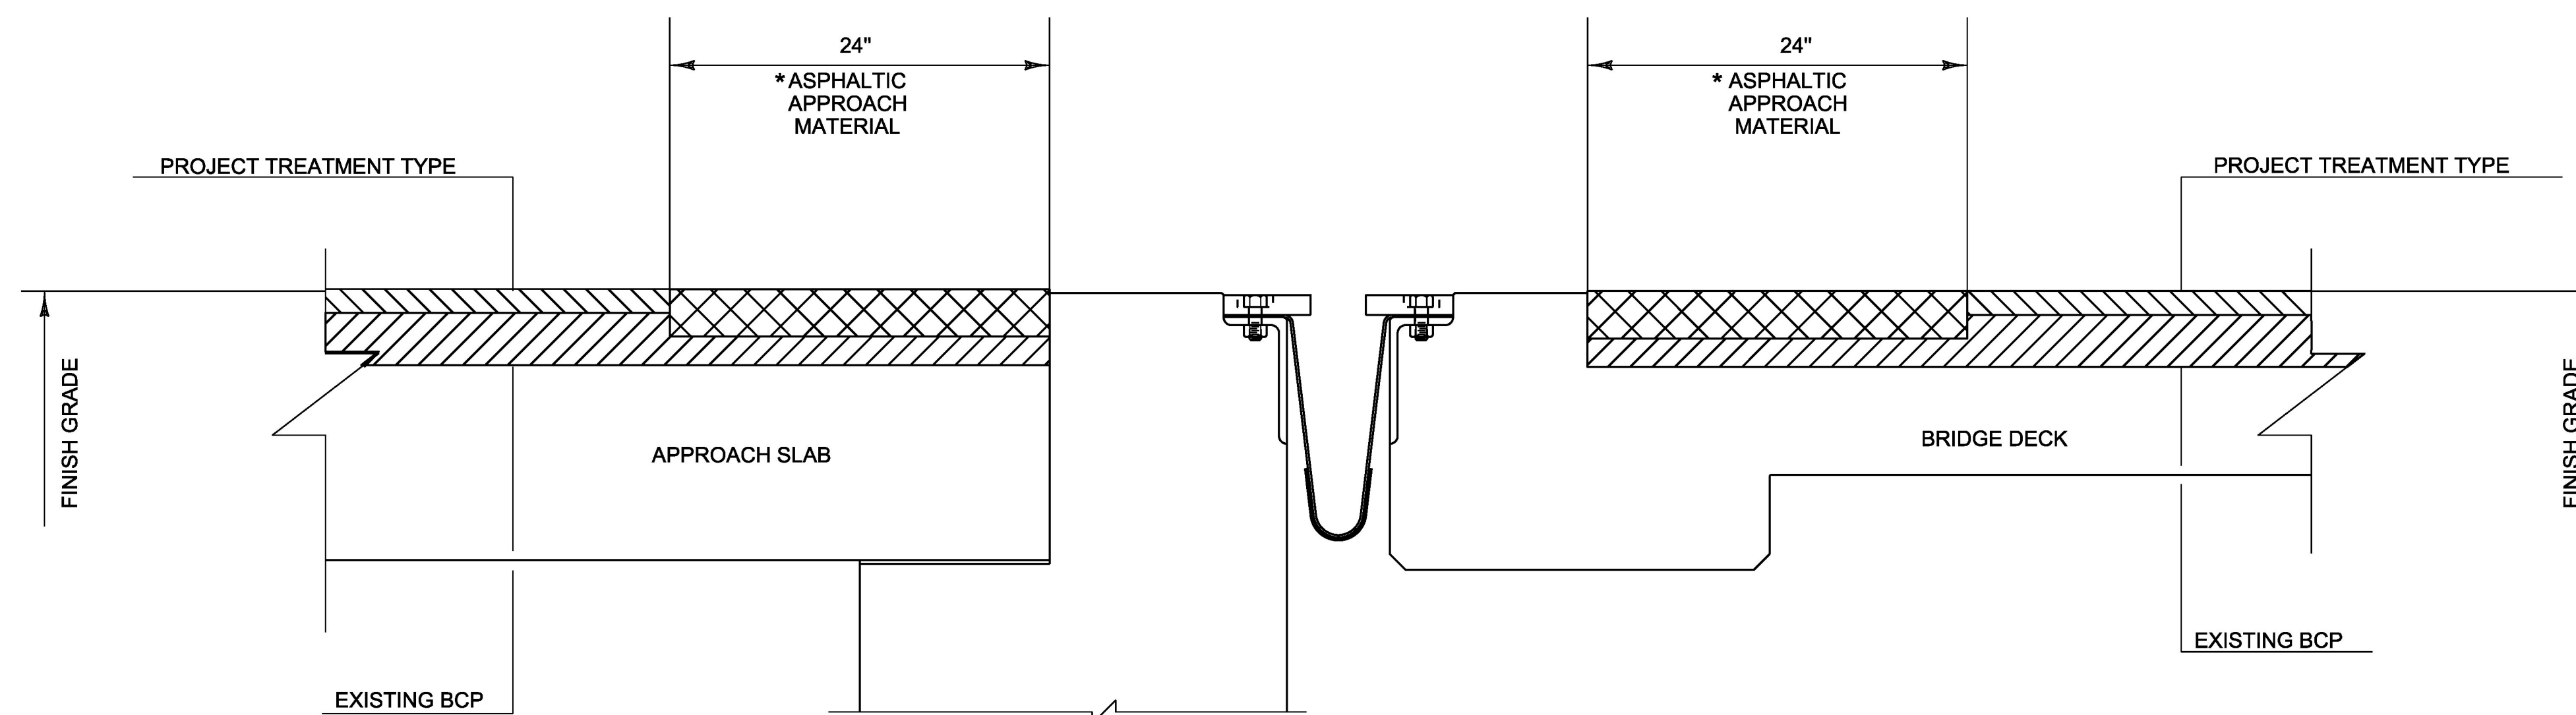

**ASPHALTIC APPROACH MATERIAL
TYPICAL CROSS SECTION
(VERMONT JOINT)
NOT TO SCALE**

* 2" MINIMUM THICKNESS UNLESS OTHERWISE DIRECTED BY THE ENGINEER

PROJECT NAME: MONTPELIER-WATERBURY	
PROJECT NUMBER: IM SURF(59)	
FILE NAME: pl6v098 Montpelier-Water.dgn	PLOT DATE: 20-MAR-2018
PROJECT LEADER: M. BOGACZYK	DRAWN BY: N. PAPPAS
DESIGNED BY: N. PAPPAS	CHECKED BY: M. BOGACZYK
BRIDGE DETAIL SHEET 5	SHEET 23 OF 34