

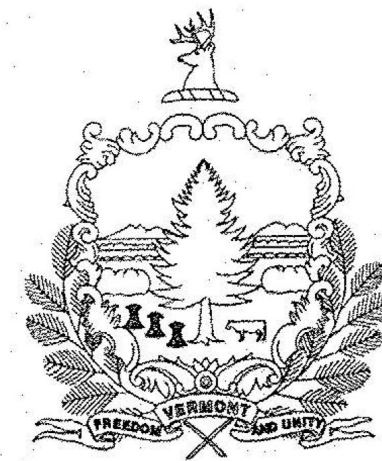


Record Plans

STATE OF VERMONT
AGENCY OF TRANSPORTATION

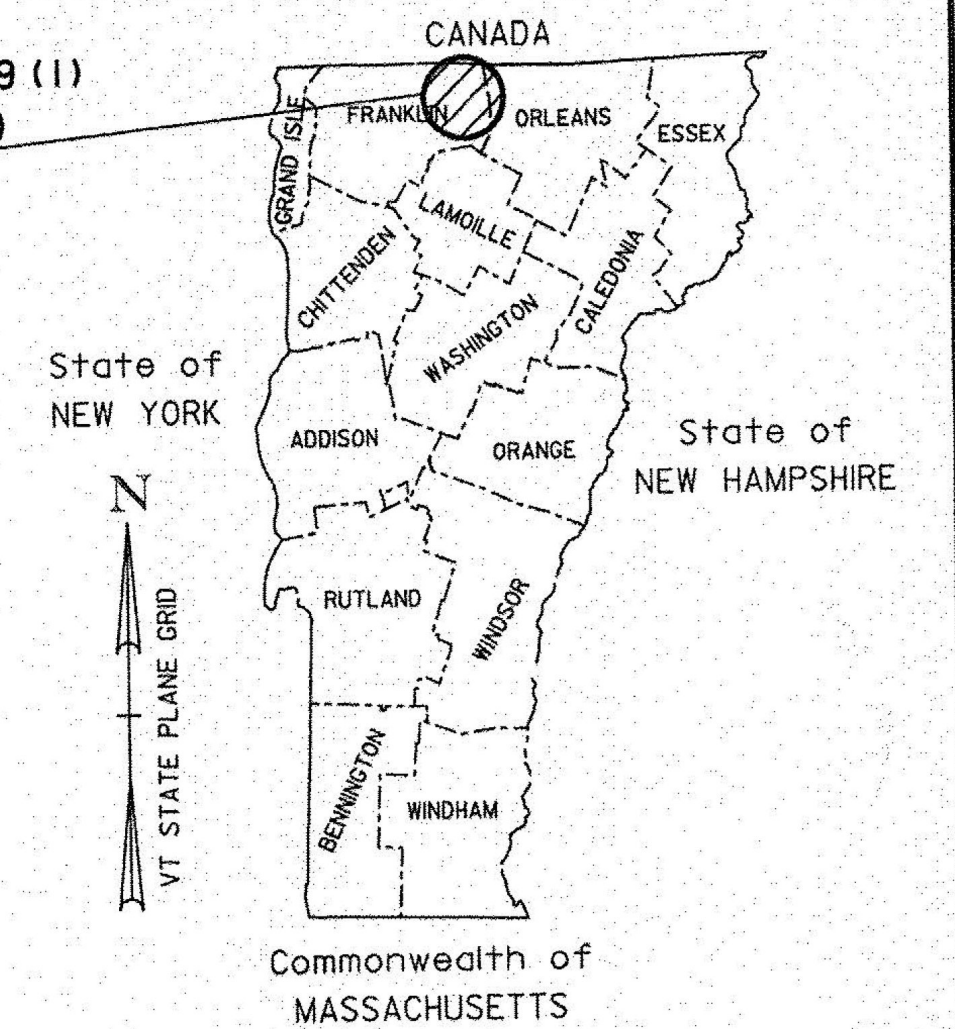

PROPOSED IMPROVEMENT
TOWNS OF ENOSBURGH, BERKSHIRE AND RICHFORD
COUNTY OF FRANKLIN
VT ROUTE 105 (MINOR ARTERIAL) AND
VT ROUTE 105A (MINOR COLLECTOR)

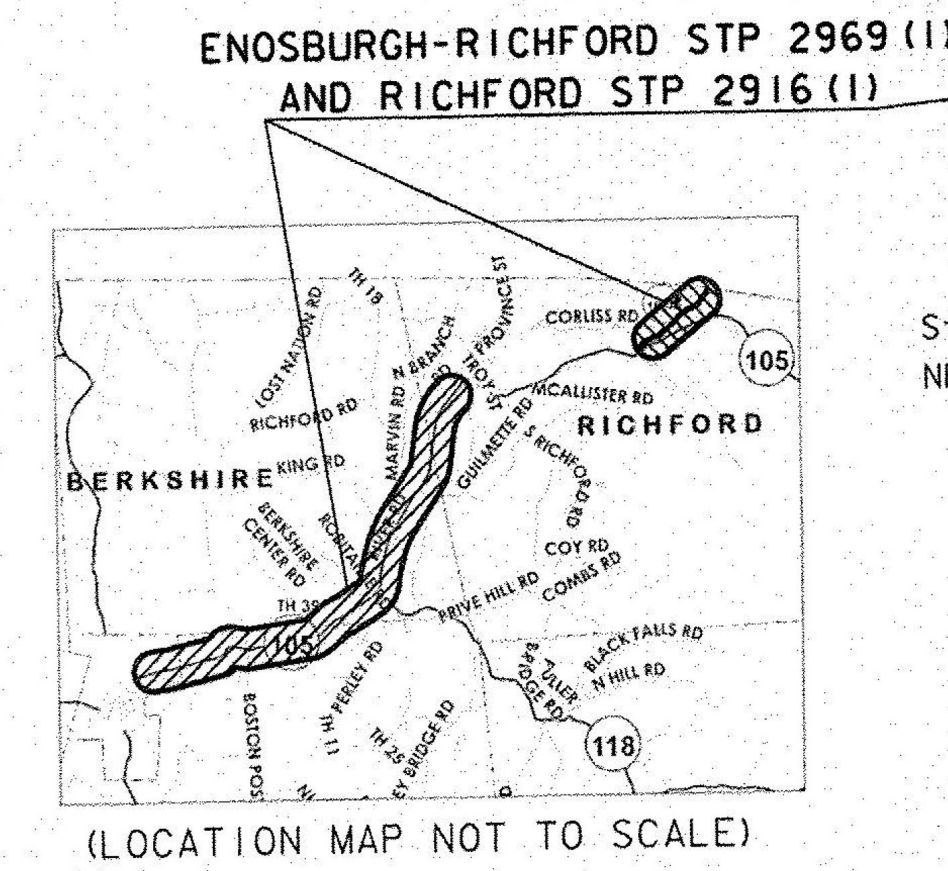

Record Plans
Contractor: PIKE INDUSTRIES, INC.
Resident Engineer: MATT BIRCHARD
Construction Began: JULY 2, 2018
Construction Complete: AUGUST 19, 2019
Record Plans By: MATT BIRCHARD

I hereby certify that all construction required by this set of drawings has been accomplished as indicated herein.


E-SIGNED by Matthew Birchard
on 2020-02-12 14:15:11 GMT Resident Engineer

Date: February 12, 2020

NOTE: Any further information concerning final quantities, amounts or other details relative to this project may be found at Central Files in the electronic archives.

ENOSBURGH-RICHFORD
STP 2969 (1)
VT ROUTE 105
SEE SHEET 4


RICHFORD
STP 2916 (1)
VT ROUTE 105A
SEE SHEET 154

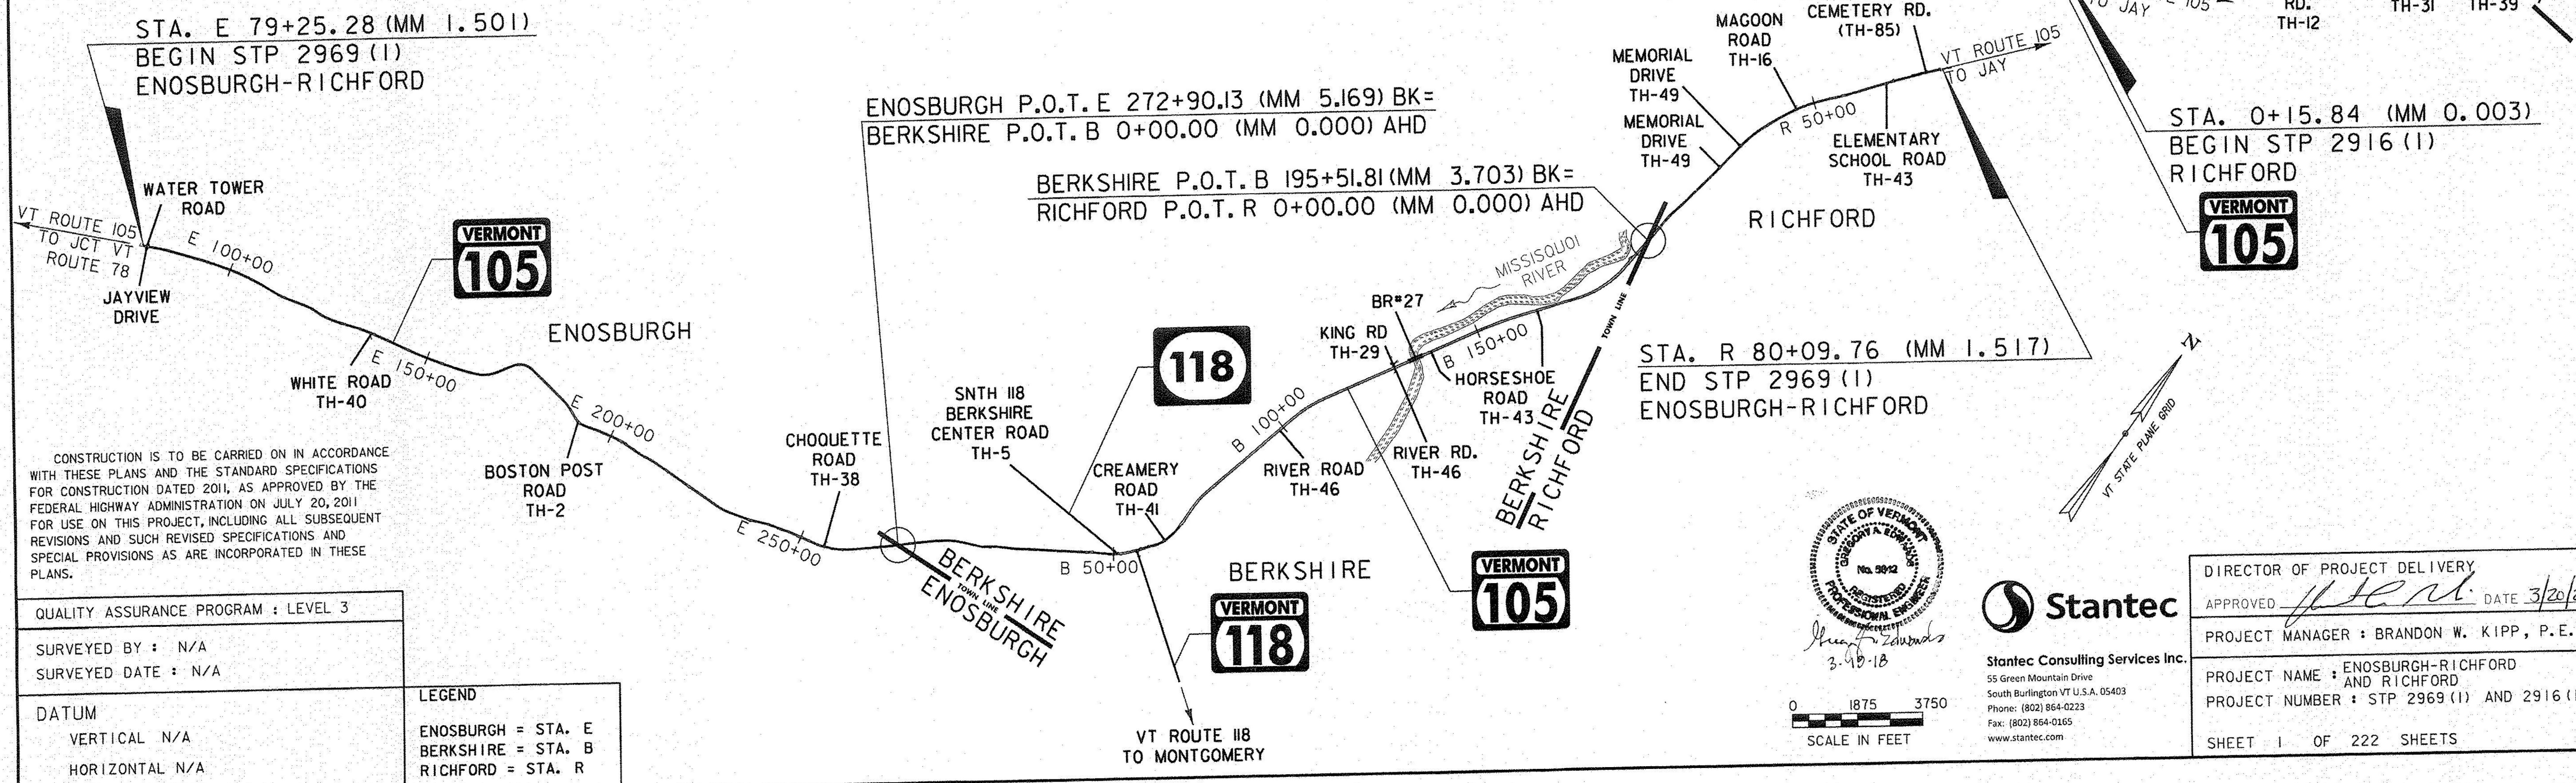

CONSTRUCTION IS TO BE CARRIED ON IN ACCORDANCE WITH THESE PLANS AND THE STANDARD SPECIFICATIONS FOR CONSTRUCTION DATED 2011, AS APPROVED BY THE FEDERAL HIGHWAY ADMINISTRATION ON JULY 20, 2011 FOR USE ON THIS PROJECT, INCLUDING ALL SUBSEQUENT REVISIONS AND SUCH REVISED SPECIFICATIONS AND SPECIAL PROVISIONS AS ARE INCORPORATED IN THESE PLANS.

QUALITY ASSURANCE PROGRAM : LEVEL 3
SURVEYED BY : N/A
SURVEYED DATE : N/A
DATUM
VERTICAL N/A
HORIZONTAL N/A

LEGEND
ENOSBURGH = STA. E
BERKSHIRE = STA. B
RICHFORD = STA. R

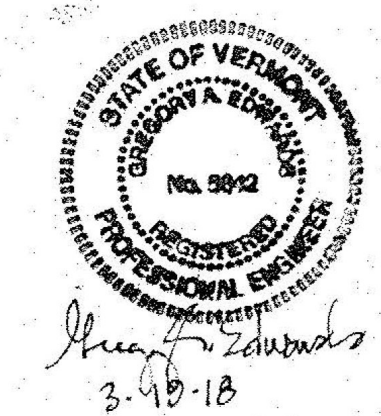

Stantec
Stantec Consulting Services Inc.
55 Green Mountain Drive
South Burlington VT U.S.A. 05403
Phone: (802) 864-0223
Fax: (802) 864-0165
www.stantec.com

DIRECTOR OF PROJECT DELIVERY	APPROVED: <i>[Signature]</i> DATE: 3/20/2018
PROJECT MANAGER : BRANDON W. KIPP, P.E.	
PROJECT NAME : ENOSBURGH-RICHFORD AND RICHFORD	
PROJECT NUMBER : STP 2969 (1) AND 2916 (1)	
SHEET 1 OF 222 SHEETS	

