



COLD PLANE TYPICAL SECTION
 (SEE SHEET 8 FOR TRANSITION)
 ENOSBURGH STA. E 79+25.28 TO E 80+72

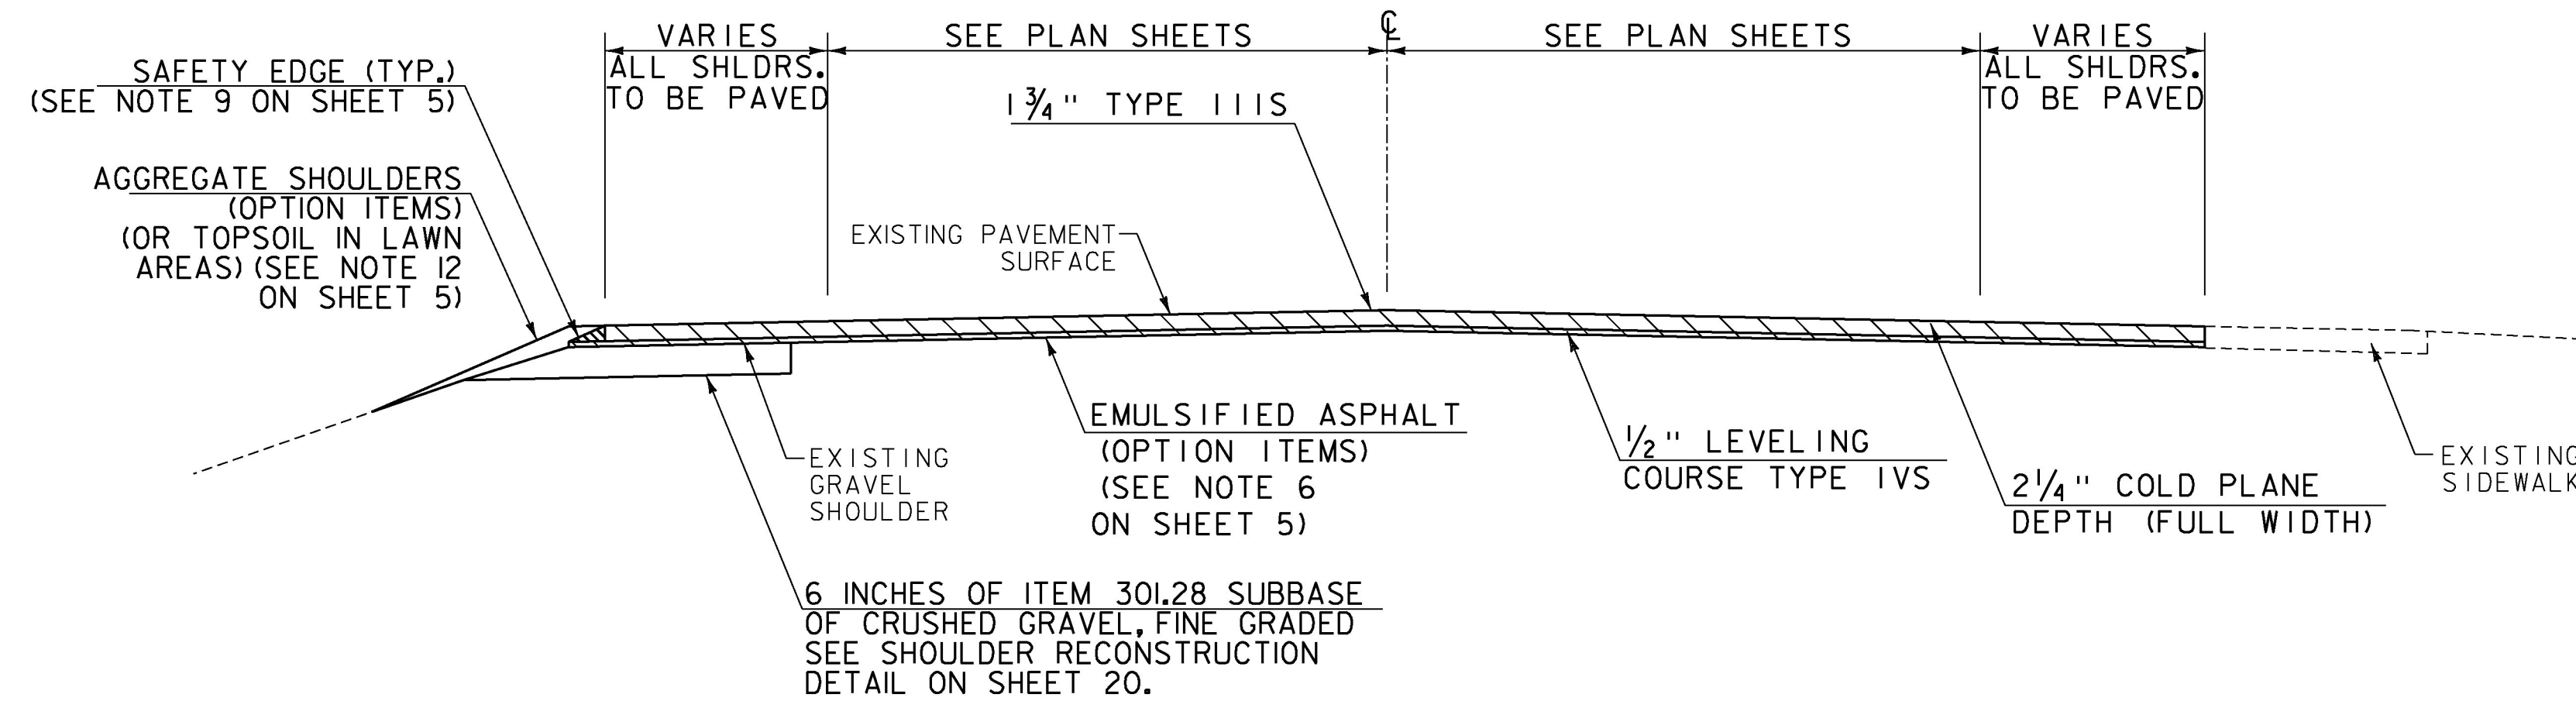

COLD PLANE TYPICAL SECTION
 (SEE SHEET 8 FOR TRANSITION)
 BERKSHIRE STA. B 47+25 TO B 63+57

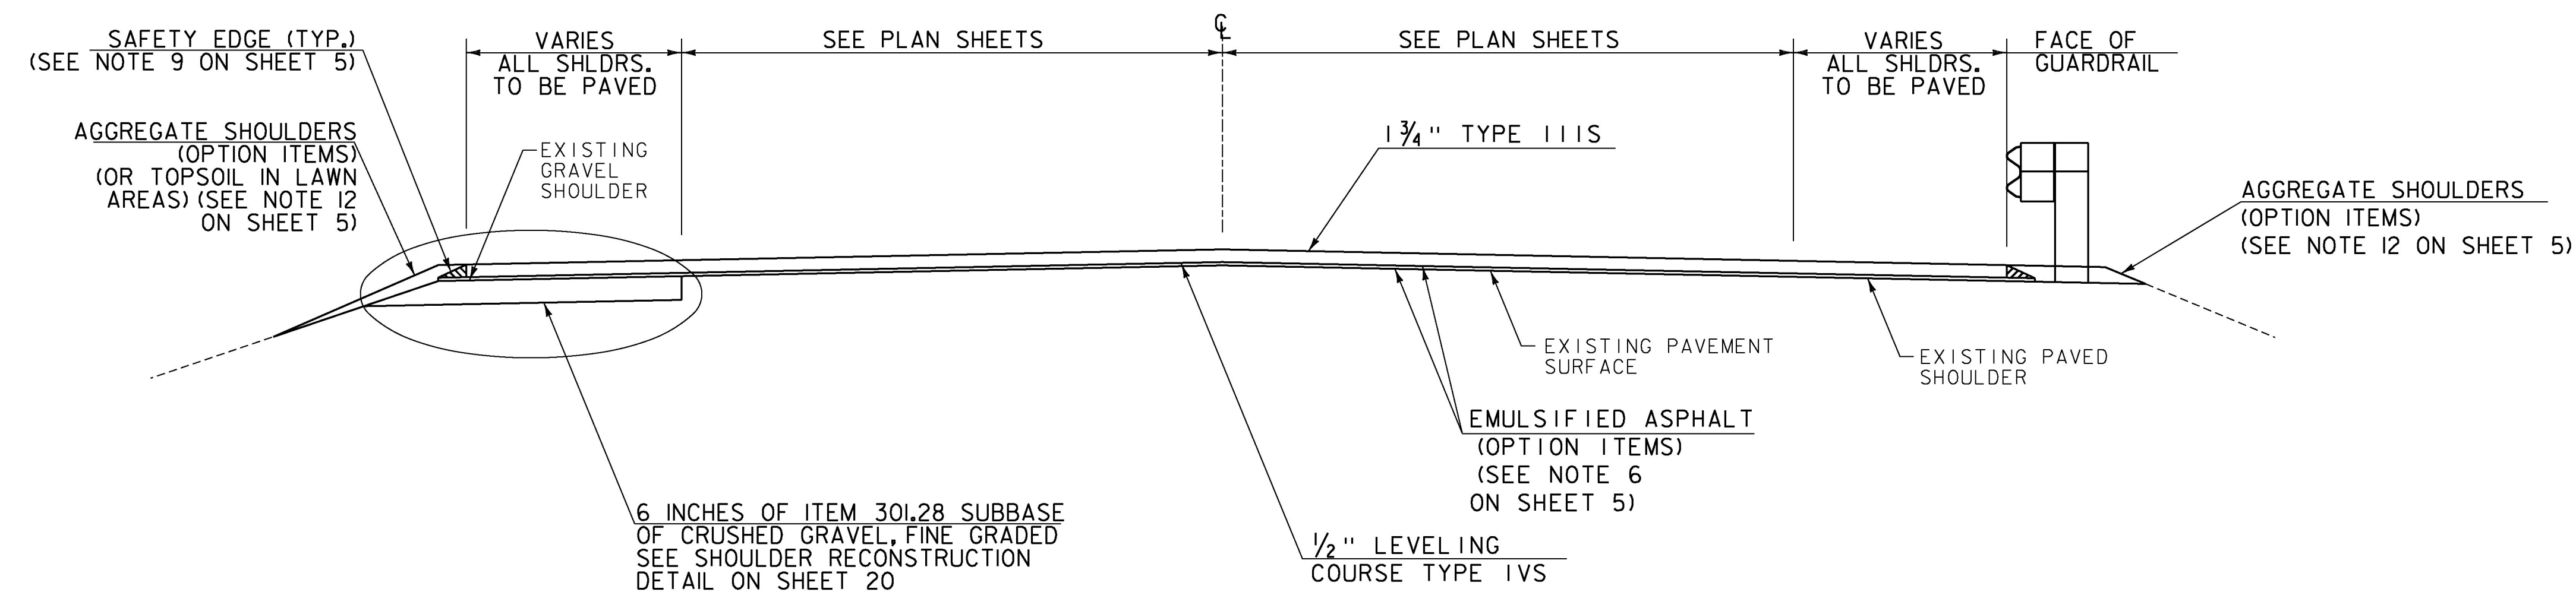

OVERLAY TYPICAL SECTION - NON-CURBED
 (SEE SHEET 8 FOR TRANSITION)
 ENOSBURGH STA. E 80+72 TO BERKSHIRE STA. B 47+25
 BERKSHIRE STA. B 63+57 TO BERKSHIRE STA. B 134+06
 BERKSHIRE STA. B 135+55 TO RICHFORD STA. R 50+26
 BERKSHIRE STA. R 50+41 TO RICHFORD STA. R 80+09.76

NOT TO SCALE

PROJECT NAME: ENOSBURGH-RICHFORD
 PROJECT NUMBER: STP 2969(I)

FILE NAME: z16vi04typ.dgn
 PROJECT LEADER: G. EDWARDS
 DESIGNED BY: G. MERKLE
 TYPICAL SECTION SHEET 1

PLOT DATE: 4/2/2018
 DRAWN BY: G. MERKLE
 CHECKED BY: J. LITTLE
 SHEET 6 OF 222

