


DURABLE 4 INCH WHITE LINE, (OPTION CC BID ITEMS)
 TEMPORARY 4 INCH WHITE LINE, PAINT
 (ALL LINES WILL INCLUDE EDGE LINE BREAKS
 AND RADII FOR SIDE ROADS)
 STA. E 99+00 TO E 104+00, SOLID LT & RT

DURABLE 4 INCH YELLOW LINE, (OPTION DD BID ITEMS)
 TEMPORARY 4 INCH YELLOW LINE, PAINT
 (ALL LINES WILL INCLUDE ϕ BREAKS FOR SIDE ROADS)
 STA. E 99+00 TO E 104+00, SOLID LT & RT

REMOVING SIGNS
 (NO FEDERAL PARTICIPATION)
 AS SHOWN - 3

ERECTING SALVAGED SIGNS
 (NO FEDERAL PARTICIPATION)
 AS SHOWN - 3

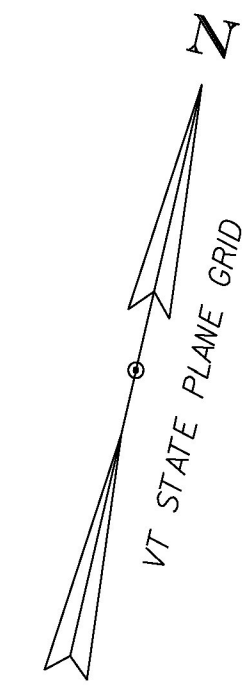

STA. E 99+51, LT


R&S	Berkson Farm B&B rt. on 108	↑	1
R&S	St. Matthew's 105 to church st.	↑	1
R&S	Champlain Chevy left on missisquoi st.	←	1

STA. E 99+51, LT

S	Berkson Farm B&B rt. on 108	↑	1
S	St. Matthew's 105 to church st.	↑	1
S	Champlain Chevy left on missisquoi st.	←	1

STA. E 101+30, LT

RET	PVT CAMP RD		
RET	PVT CAMP RD		

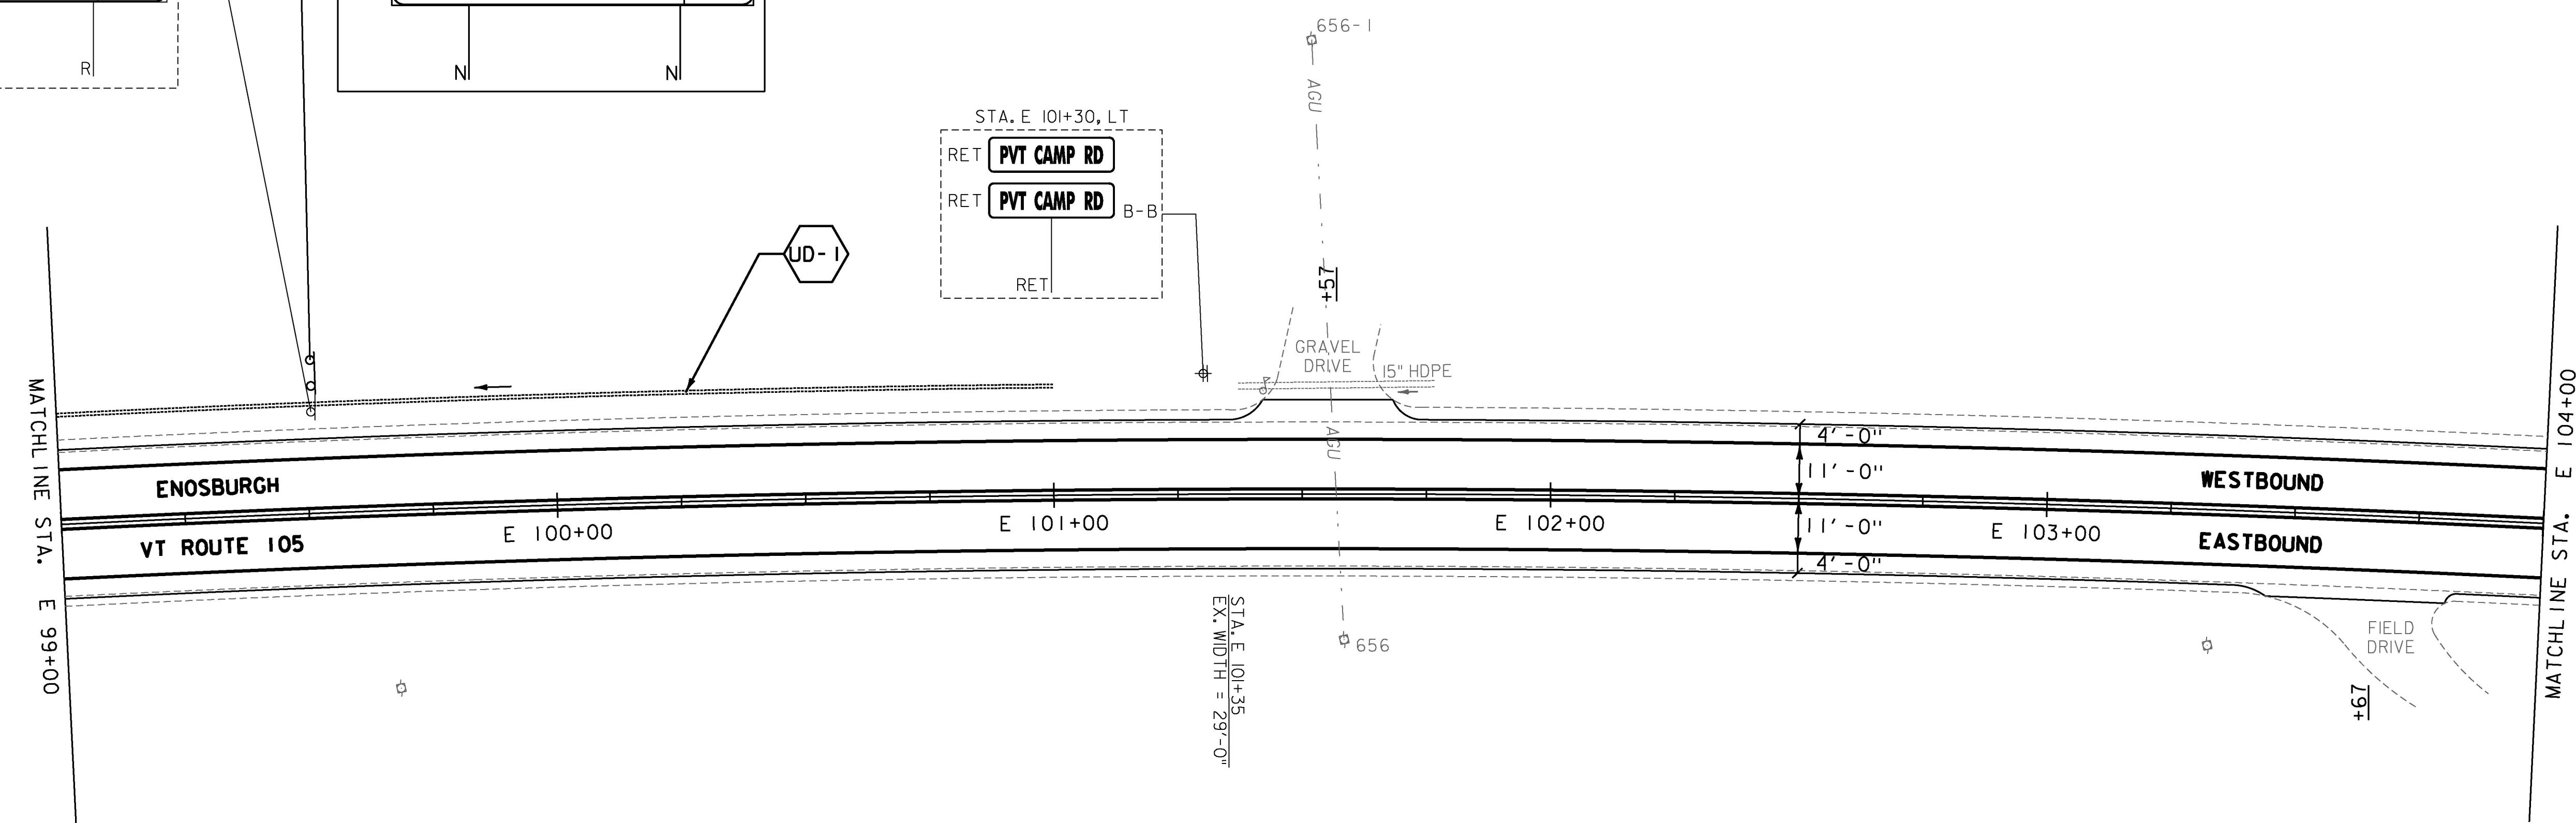

98+10 to 101+34
 STA. E ~~97+32~~ TO E 101+00, LT
 CONSTRUCT 6 INCH UNDERDRAIN PIPE,
 SEE SHEET 30 FOR DETAILS AND
 ASSOCIATED QUANTITIES

- NOTES:**
- FOR LEGENDS, SEE SHEETS 3 & 3I.
 - ALL EXISTING SIGNS NOT SHOWN ON THE PLANS SHALL BE RETAINED.
 - ALL UTILITY LOCATIONS SHOWN ARE APPROXIMATE AND SHOULD BE VERIFIED PRIOR TO ANY WORK COMMENCING.



PROJECT NAME:	ENOSBURGH-RICHFORD	PLOT DATE:	4/2/2018
PROJECT NUMBER:	STP 2969(I)	DRAWN BY:	G. BURGMEIER
FILE NAME:	z16vi04bdr.dgn	DESIGNED BY:	G. BURGMEIER
PROJECT LEADER:	G. EDWARDS	CHECKED BY:	J. LITTLE
PLAN SHEET 5		SHEET	35 OF 222