

MILLED RUMBLE STRIPS (CENTERLINE)
STA. B 20+00 TO B 25+00, CL

STONE FILL, TYPE J
SLOPE EROSION PREVENTION WITH GUARDRAIL:
STA. B 22+43 TO B 23+31, RT
(SEE SHEET 19)

STEEL BEAM GUARDRAIL, GALVANIZED
STA. B 21+07.5 TO B 21+20.0, RT
STA. B 22+40.0 TO B 22+52.5, LT
STA. B 22+43.0 TO B 22+55.5, RT
STA. B 23+18.0 TO B 23+30.5, RT
STA. B 23+65.0 TO B 23+77.5, LT

ANCHOR FOR STEEL BEAM RAIL
STA. B 21+20.0 RT
STA. B 22+40.0, LT
STA. B 22+43.0, RT
STA. B 23+30.5, RT
STA. B 23+77.5, LT

REMOVAL AND DISPOSAL OF GUARDRAIL
STA. B 20+00.0 TO B 21+00.0, RT
STA. B 22+40.0 TO B 23+77.5, LT
STA. B 22+43.0 TO B 23+30.5, RT

ALTERNATES ZAI & ZA2 BID ITEMS
S.P. (GREGORY MINI SPACER G.R.)(GMS)
S.P. (NON-BLOCKED MIDWEST G.R. SYSTEM)(MGS)
STA. B 22+52.5 TO B 22+77.5, LT
STA. B 22+55.5 TO B 23+18.0, RT
STA. B 23+40.0 TO B 23+65.0, LT

ALTERNATES ZAI & ZA2 BID ITEMS
S.P. (GREGORY MINI SPACER G.R.)(GMS) W/8 FEET POSTS
S.P. (NON-BLOCKED MIDWEST G.R. SYSTEM)(MGS) W/8 FEET POSTS
STA. B 20+00.0 TO B 21+07.5, RT

ALTERNATES ZAI & ZA2 BID ITEMS
S.P. (REMOVE & RESET G.R.)(GREGORY MINI SPACER G.R.)
S.P. (REMOVE & RESET G.R.)(NON-BLOCKED MIDWEST G.R. SYSTEM)
STA. B 22+77.5 TO B 23+40.0, LT

DURABLE 4 INCH WHITE LINE, (OPTION CC BID ITEMS)
(ALL LINES WILL INCLUDE EDGE LINE BREAKS
AND RADII FOR SIDE ROADS)
STA. B 20+00 TO B 25+00, SOLID LT & RT
STA. B 21+28 TO B 21+64, RT (BUFFER & DIAGONALS)

DURABLE 4 INCH YELLOW LINE, (OPTION DD BID ITEMS)
(ALL LINES WILL INCLUDE C BREAKS FOR SIDE ROADS)
STA. B 20+00 TO B 25+00, SOLID LT & RT
STA. B 21+22 TO B 21+25, LT (RAIL TRAIL CENTERLINE)
STA. B 21+25 TO B 21+30, RT (RAIL TRAIL CENTERLINE)



DURABLE 12 INCH WHITE LINE, (OPTION EE BID ITEMS)
STA. B 21+22 TO B 21+25, LT (RAIL TRAIL STOP BAR)
STA. B 21+25 TO B 21+28, RT (RAIL TRAIL STOP BAR)

TEMPORARY 4 INCH WHITE LINE, PAINT
(ALL LINES WILL INCLUDE EDGE LINE BREAKS
AND RADII FOR SIDE ROADS)
STA. B 20+00 TO B 25+00, SOLID LT & RT

TEMPORARY 4 INCH YELLOW LINE, PAINT
(ALL LINES WILL INCLUDE C BREAKS FOR SIDE ROADS)
STA. B 20+00 TO B 25+00, SOLID LT & RT

REMOVING SIGNS
AS SHOWN - 3

ERECTING SALVAGED SIGNS
AS SHOWN - 2

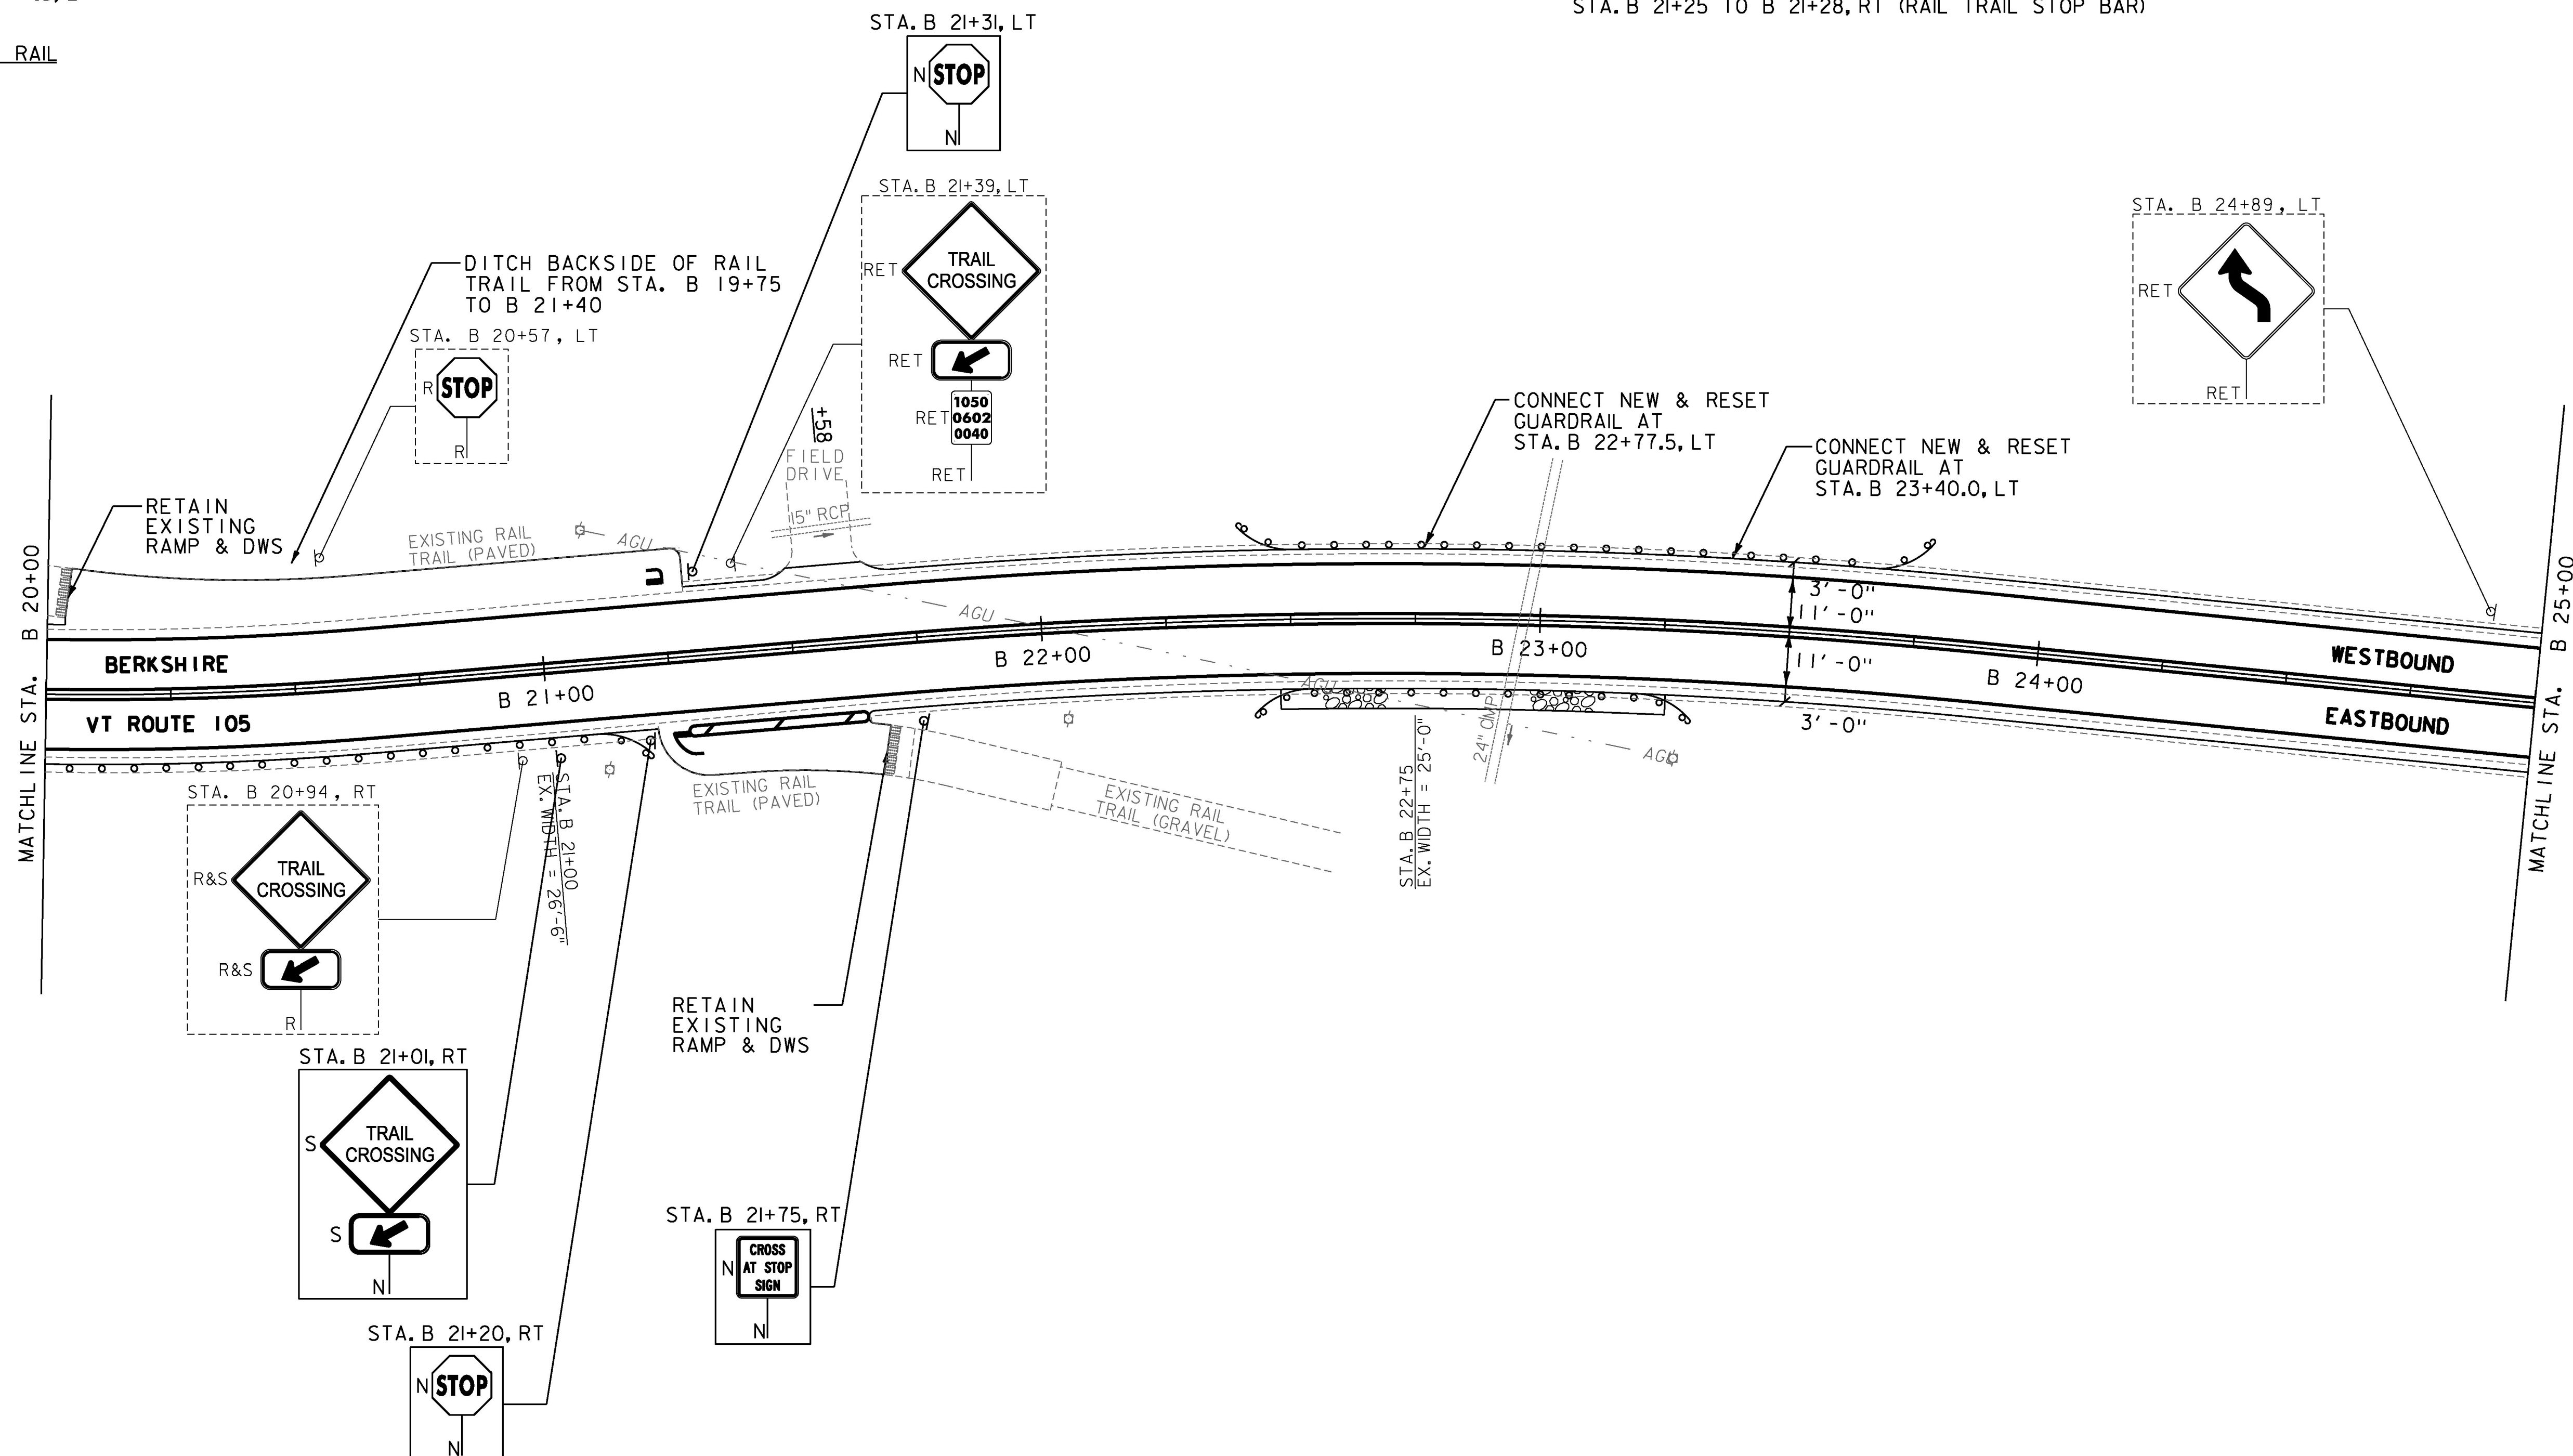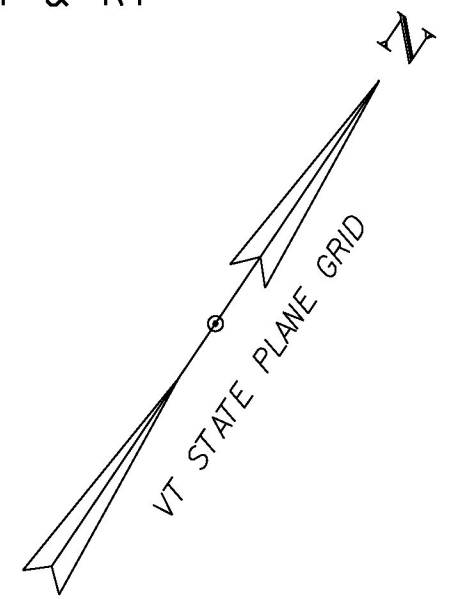

- NOTES:
- FOR LEGENDS, SEE SHEETS 3 & 3I.
 - ALL EXISTING SIGNS NOT SHOWN ON THE PLANS SHALL BE RETAINED.
 - ALL UTILITY LOCATIONS SHOWN ARE APPROXIMATE AND SHOULD BE VERIFIED PRIOR TO ANY WORK COMMENCING.
 - SEE SHEETS 11 & 21 FOR RAIL TRAIL PAVEMENT MARKING & PAVEMENT HANDWORK DETAILS.



PROJECT NAME:	ENOSBURGH-RICHFORD
PROJECT NUMBER:	STP 2969(1)
FILE NAME:	z16vi04bdr.dgn
PROJECT LEADER:	G. EDWARDS
DESIGNED BY:	G. BURGMEIER
PLAN SHEET 44	
PLOT DATE:	4/2/2018
DRAWN BY:	G. BURGMEIER
CHECKED BY:	J. LITTLE
SHEET 74 OF 222	

