
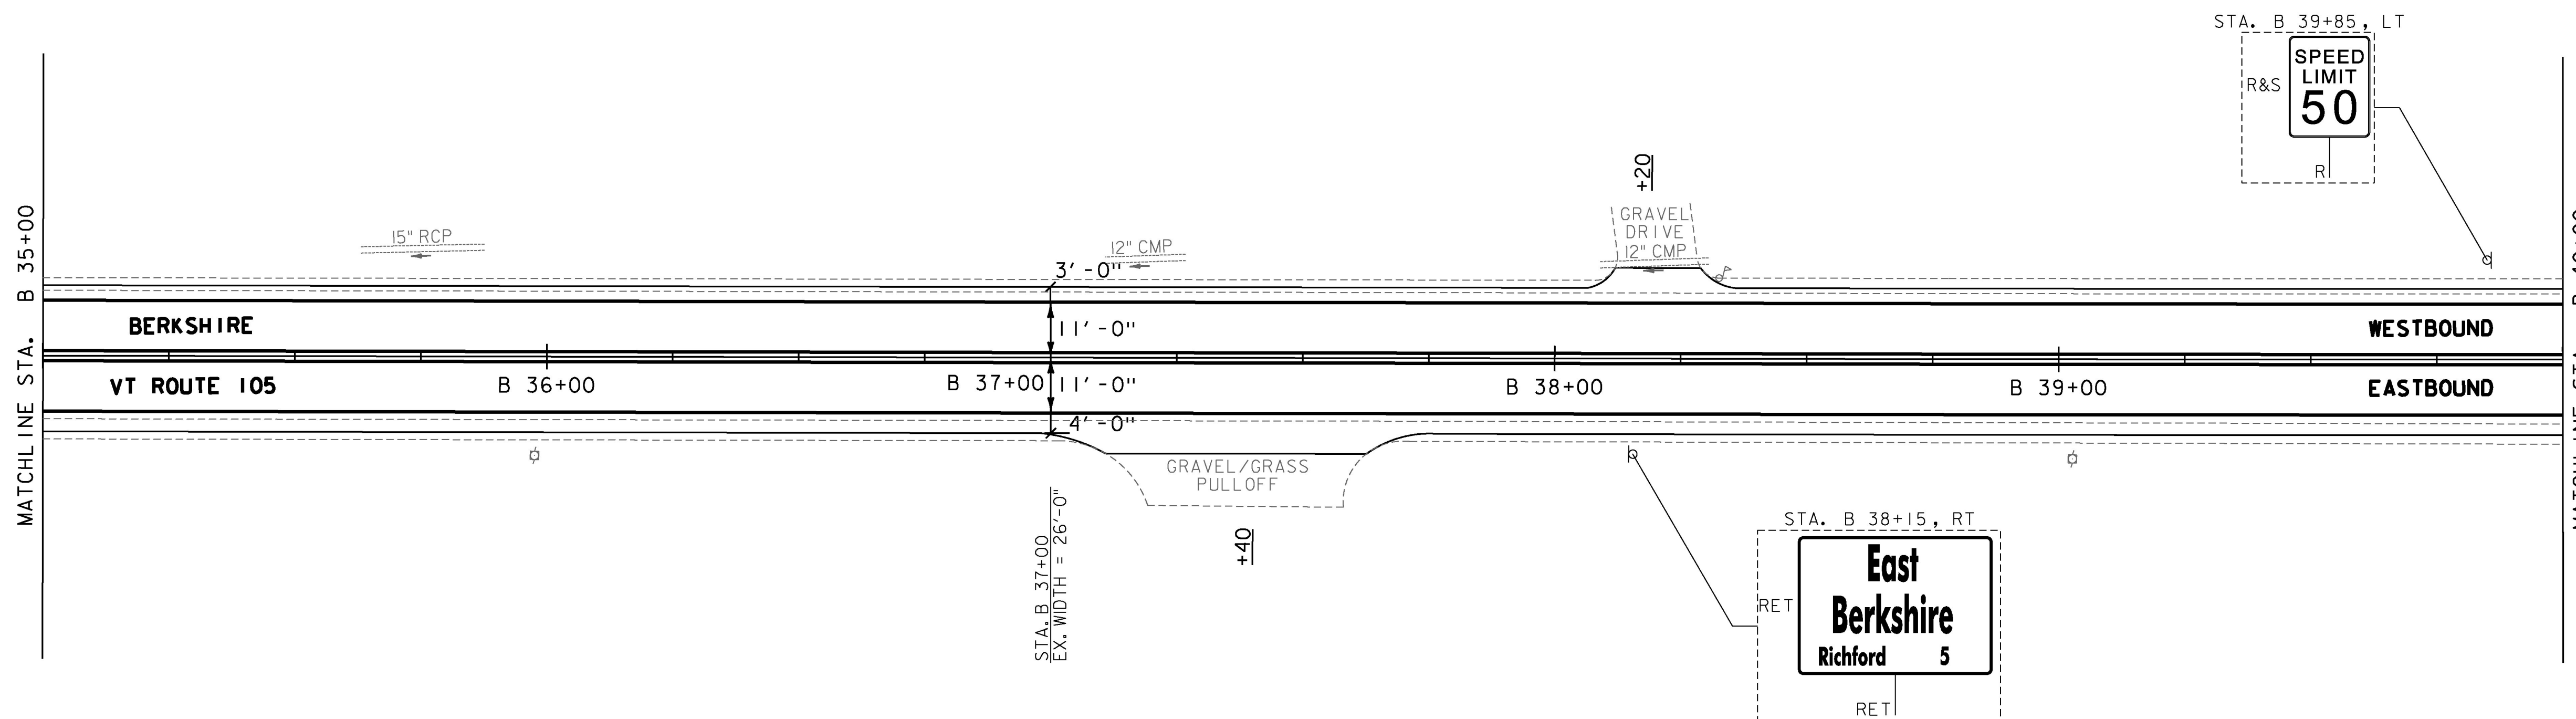


DURABLE 4 INCH WHITE LINE, (OPTION CC BID ITEMS)
 TEMPORARY 4 INCH WHITE LINE, PAINT
 (ALL LINES WILL INCLUDE EDGE LINE BREAKS
 AND RADII FOR SIDE ROADS)
 STA. B 35+00 TO B 40+00, SOLID LT & RT

DURABLE 4 INCH YELLOW LINE, (OPTION DD BID ITEMS)
 TEMPORARY 4 INCH YELLOW LINE, PAINT
 (ALL LINES WILL INCLUDE ϕ BREAKS FOR SIDE ROADS)
 STA. B 35+00 TO B 40+00, SOLID LT & RT

REMOVING SIGNS
 AS SHOWN - 1

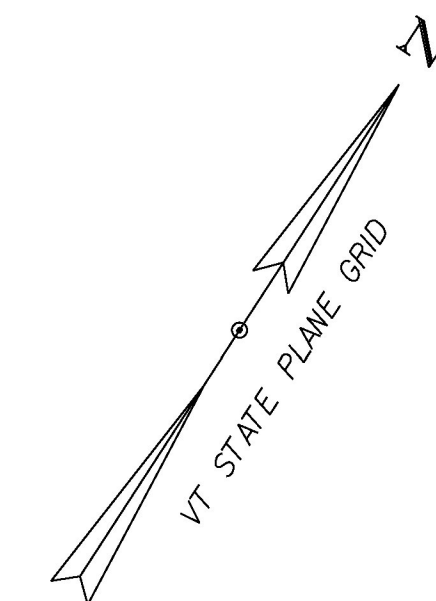

NOTES:

1. FOR LEGENDS, SEE SHEETS 3 & 3I.
2. ALL EXISTING SIGNS NOT SHOWN ON THE PLANS SHALL BE RETAINED.
3. ALL UTILITY LOCATIONS SHOWN ARE APPROXIMATE AND SHOULD BE VERIFIED PRIOR TO ANY WORK COMMENCING.



| | |
|-----------------|--------------------|
| PROJECT NAME: | ENOSBURGH-RICHFORD |
| PROJECT NUMBER: | STP 2969(I) |
| FILE NAME: | z16vi04bdr.dgn |
| PROJECT LEADER: | G. EDWARDS |
| DESIGNED BY: | G. BURGMEIER |
| PLAN SHEET 47 | |
| PLOT DATE: | 4/2/2018 |
| DRAWN BY: | G. BURGMEIER |
| CHECKED BY: | J. LITTLE |
| SHEET 77 OF 222 | |

