

STONE FILL, TYPE I
SLOPE EROSION PREVENTION WITH GUARDRAIL:
STA. B 44+15 TO B 45+00, RT
(SEE SHEET 19)

STEEL BEAM GUARDRAIL, GALVANIZED
STA. B 43+92.0 TO B 44+07.0, LT
STA. B 44+19.5 TO B 44+57.0, LT

ANCHOR FOR STEEL BEAM RAIL
STA. B 43+92.0, LT
STA. B 44+57.0, LT

REMOVE AND RESET GUARDRAIL
STA. B 44+15.0 TO B 45+00.0, RT

REMOVAL AND DISPOSAL OF GUARDRAIL
STA. B 43+92.0 TO B 44+07.0, LT
STA. B 44+19.5 TO B 44+57.0, LT

DURABLE 4 INCH WHITE LINE, (OPTION CC BID ITEMS)
(ALL LINES WILL INCLUDE EDGE LINE BREAKS
AND RADII FOR SIDE ROADS)
STA. B 40+00 TO B 45+00, SOLID LT & RT
STA. B 43+59 TO B 44+22, RT (RAIL TRAIL EDGE LINE)
STA. B 44+62 T B 45+00, LT (BUFFER & DIAGONALS)

DURABLE 4 INCH YELLOW LINE, (OPTION DD BID ITEMS)
(ALL LINES WILL INCLUDE ϕ BREAKS FOR SIDE ROADS)
STA. B 40+00 TO B 45+00, SOLID LT & RT
STA. B 44+15 TO B 44+25, RT (RAIL TRAIL CENTERLINE)
STA. B 44+59 TO B 44+65, LT (RAIL TRAIL CENTERLINE)



DURABLE 12 INCH WHITE LINE, (OPTION EE BID ITEMS)
STA. B 44+25 TO B 44+28, RT (RAIL TRAIL STOP BAR)
STA. B 44+55 TO B 44+59, LT (RAIL TRAIL STOP BAR)

TEMPORARY 4 INCH WHITE LINE, PAINT
(ALL LINES WILL INCLUDE EDGE LINE BREAKS
AND RADII FOR SIDE ROADS)
STA. B 40+00 TO B 45+00, SOLID LT & RT

TEMPORARY 4 INCH YELLOW LINE, PAINT
(ALL LINES WILL INCLUDE ϕ BREAKS FOR SIDE ROADS)
STA. B 40+00 TO B 45+00, SOLID LT & RT

REMOVING SIGNS
AS SHOWN - 4

ERECTING SALVAGED SIGNS
AS SHOWN - 1

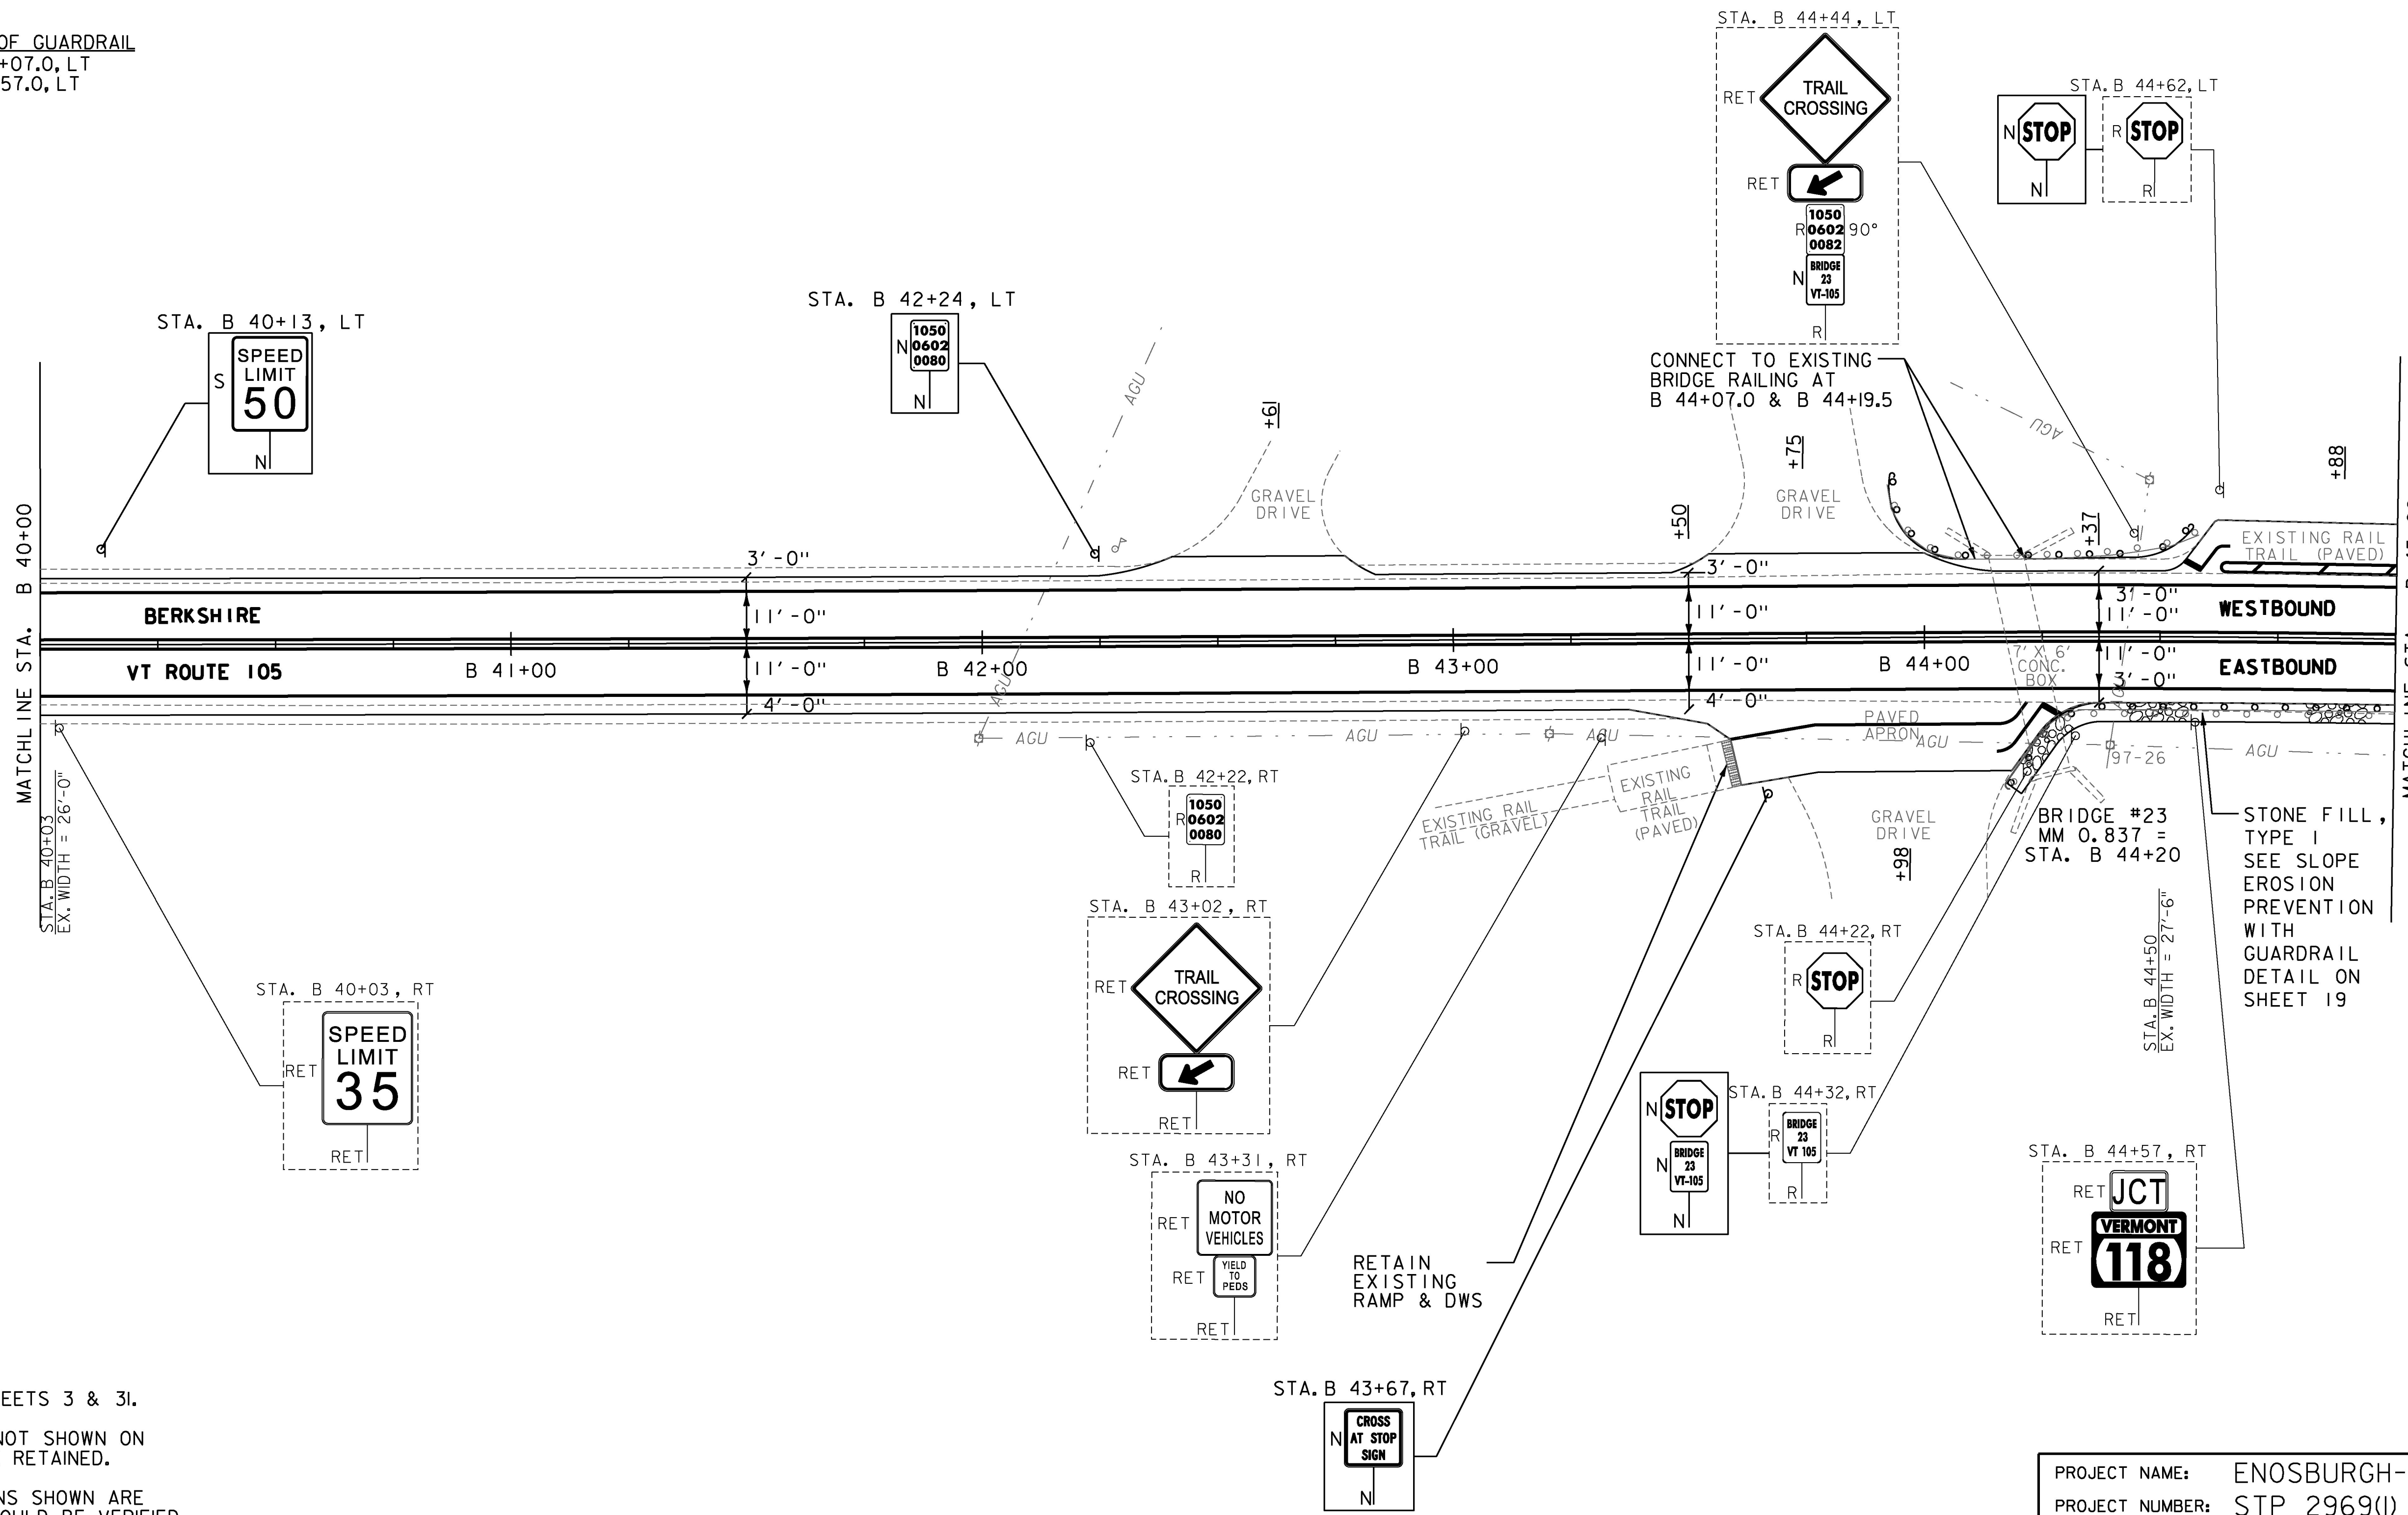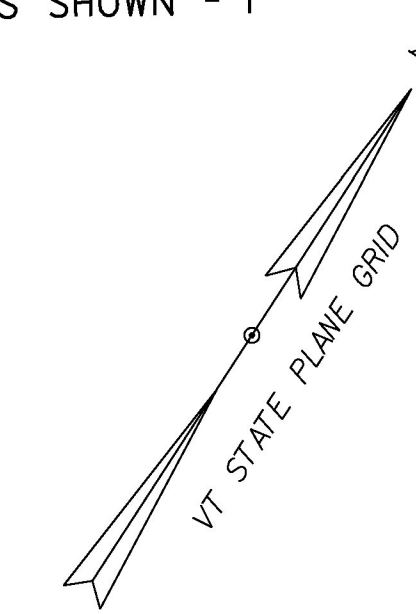

- NOTES:
- FOR LEGENDS, SEE SHEETS 3 & 31.
 - ALL EXISTING SIGNS NOT SHOWN ON THE PLANS SHALL BE RETAINED.
 - ALL UTILITY LOCATIONS SHOWN ARE APPROXIMATE AND SHOULD BE VERIFIED PRIOR TO ANY WORK COMMENCING.
 - SEE SHEETS 11 & 21 FOR RAIL TRAIL PAVEMENT MARKING & PAVEMENT HANDWORK DETAILS.



PROJECT NAME:	ENOSBURGH-RICHFORD
PROJECT NUMBER:	STP 2969(1)
FILE NAME:	z16vi04bdr.dgn
DESIGNED BY:	G. BURGMEIER
PROJECT LEADER:	G. EDWARDS
CHECKED BY:	J. LITTLE
PLAN SHEET 48	
PLOT DATE:	4/2/2018
DRAWN BY:	G. BURGMEIER
SHEET	78 OF 222

