
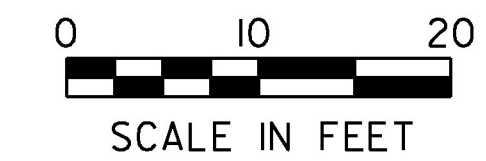
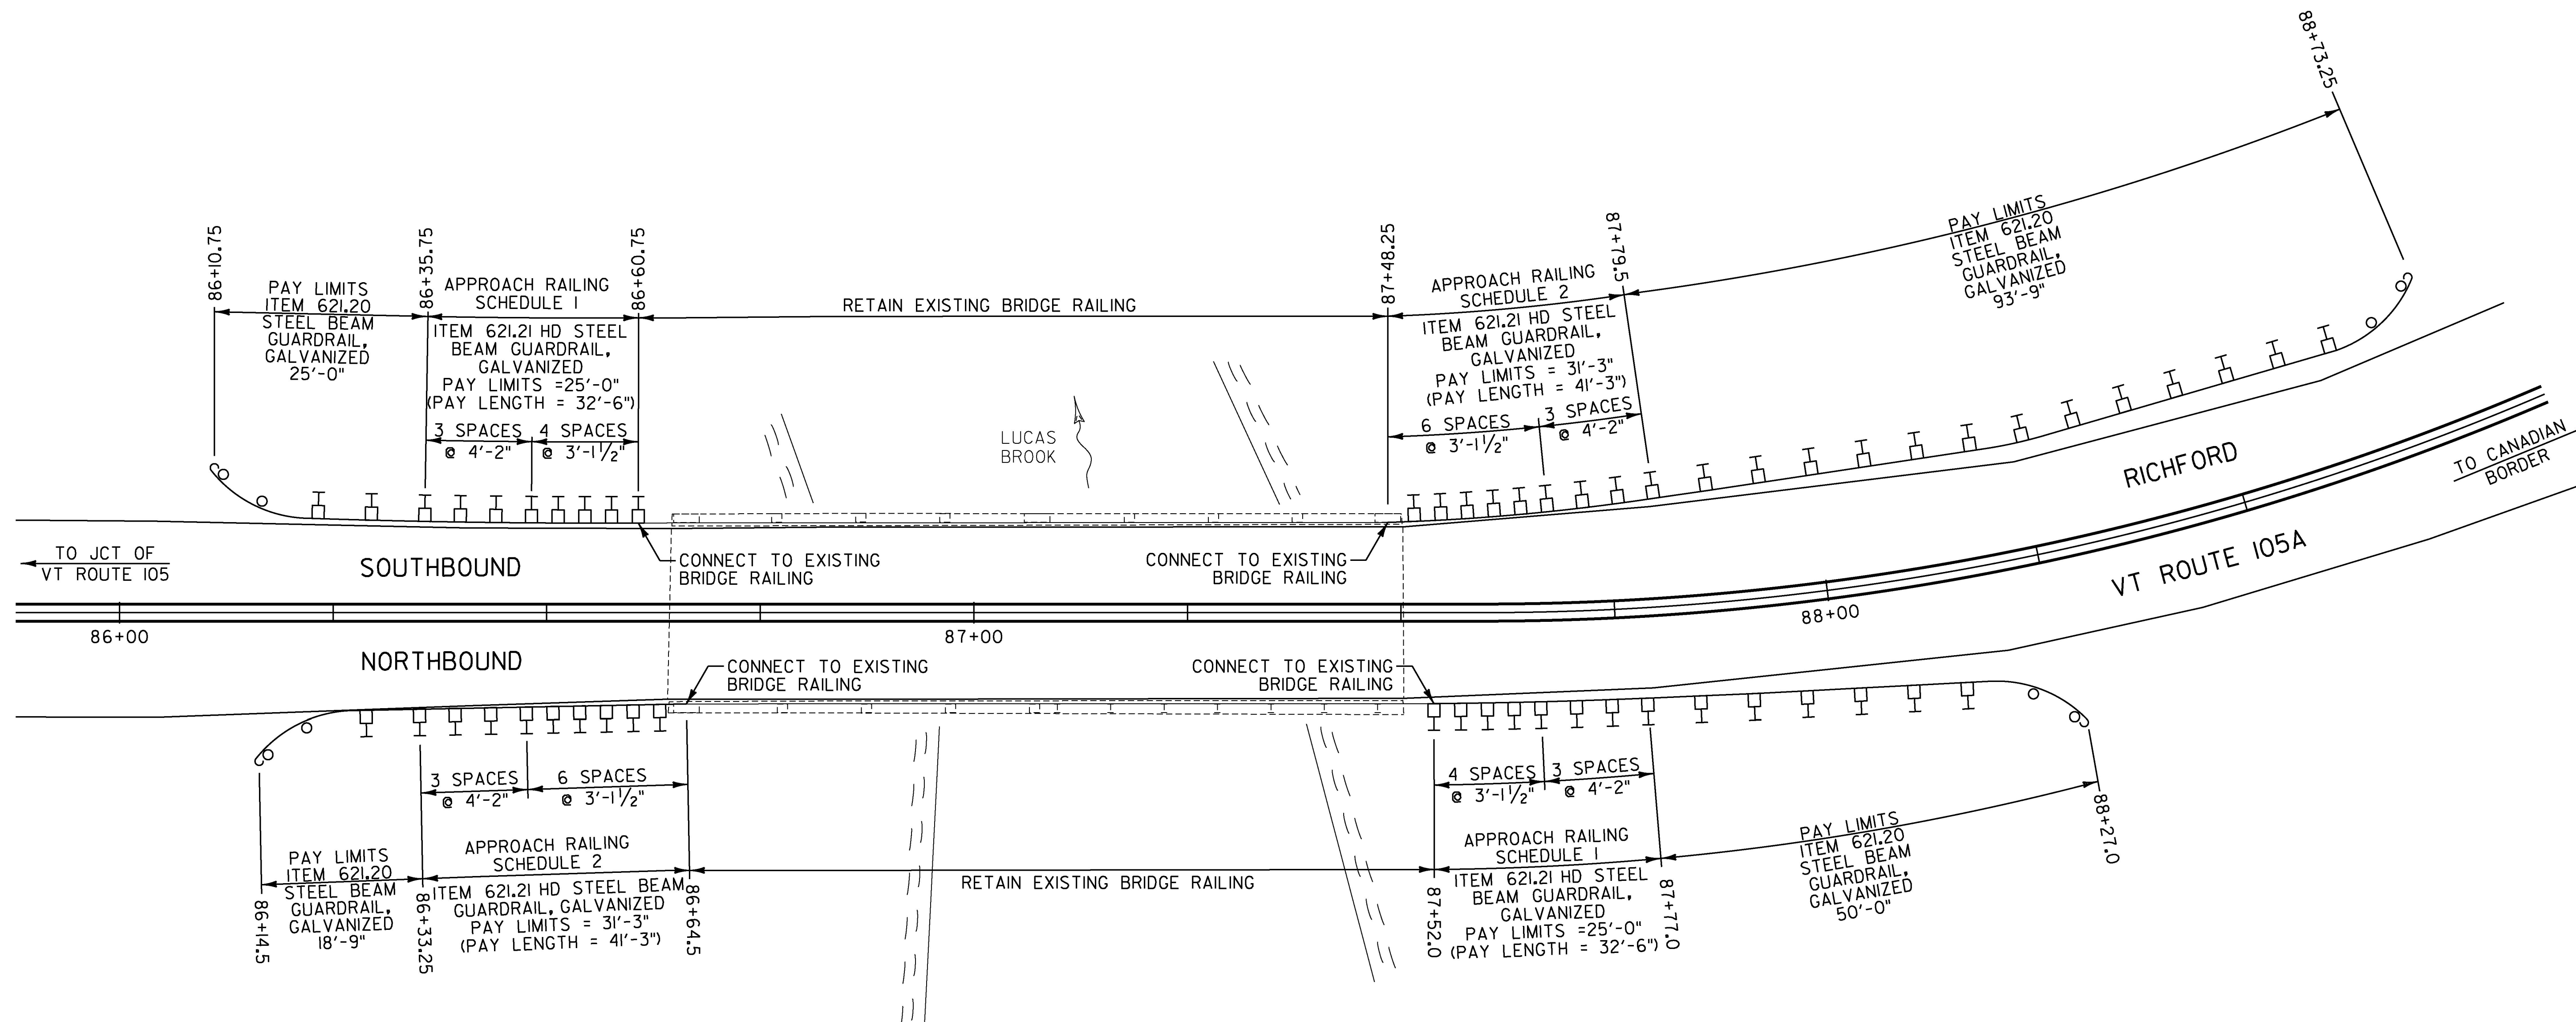


BRIDGE #2
MM 1.649 = STA. 87+07

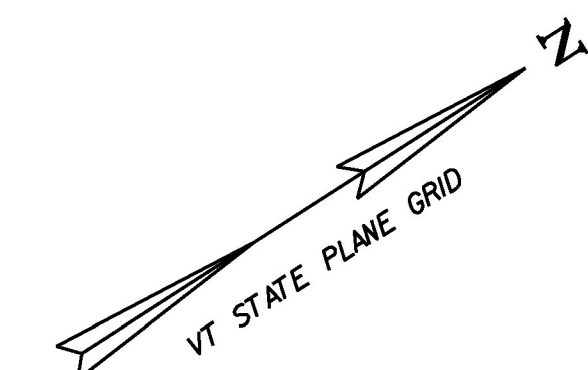

PROJECT NAME:	RICHFORD	PLOT DATE:	4/2/2018
PROJECT NUMBER:	STP 2916(I)	DRAWN BY:	G. BURGMEIER
FILE NAME:	z10c234de+all.dgn	CHECKED BY:	J. LITTLE
PROJECT LEADER:	G. EDWARDS	GUARDRAIL DETAIL SHEET 2	SHEET 162 OF 222