


24+06.5  
 PIPE #65137  
 SKEWED 9.2° AHEAD LEFT

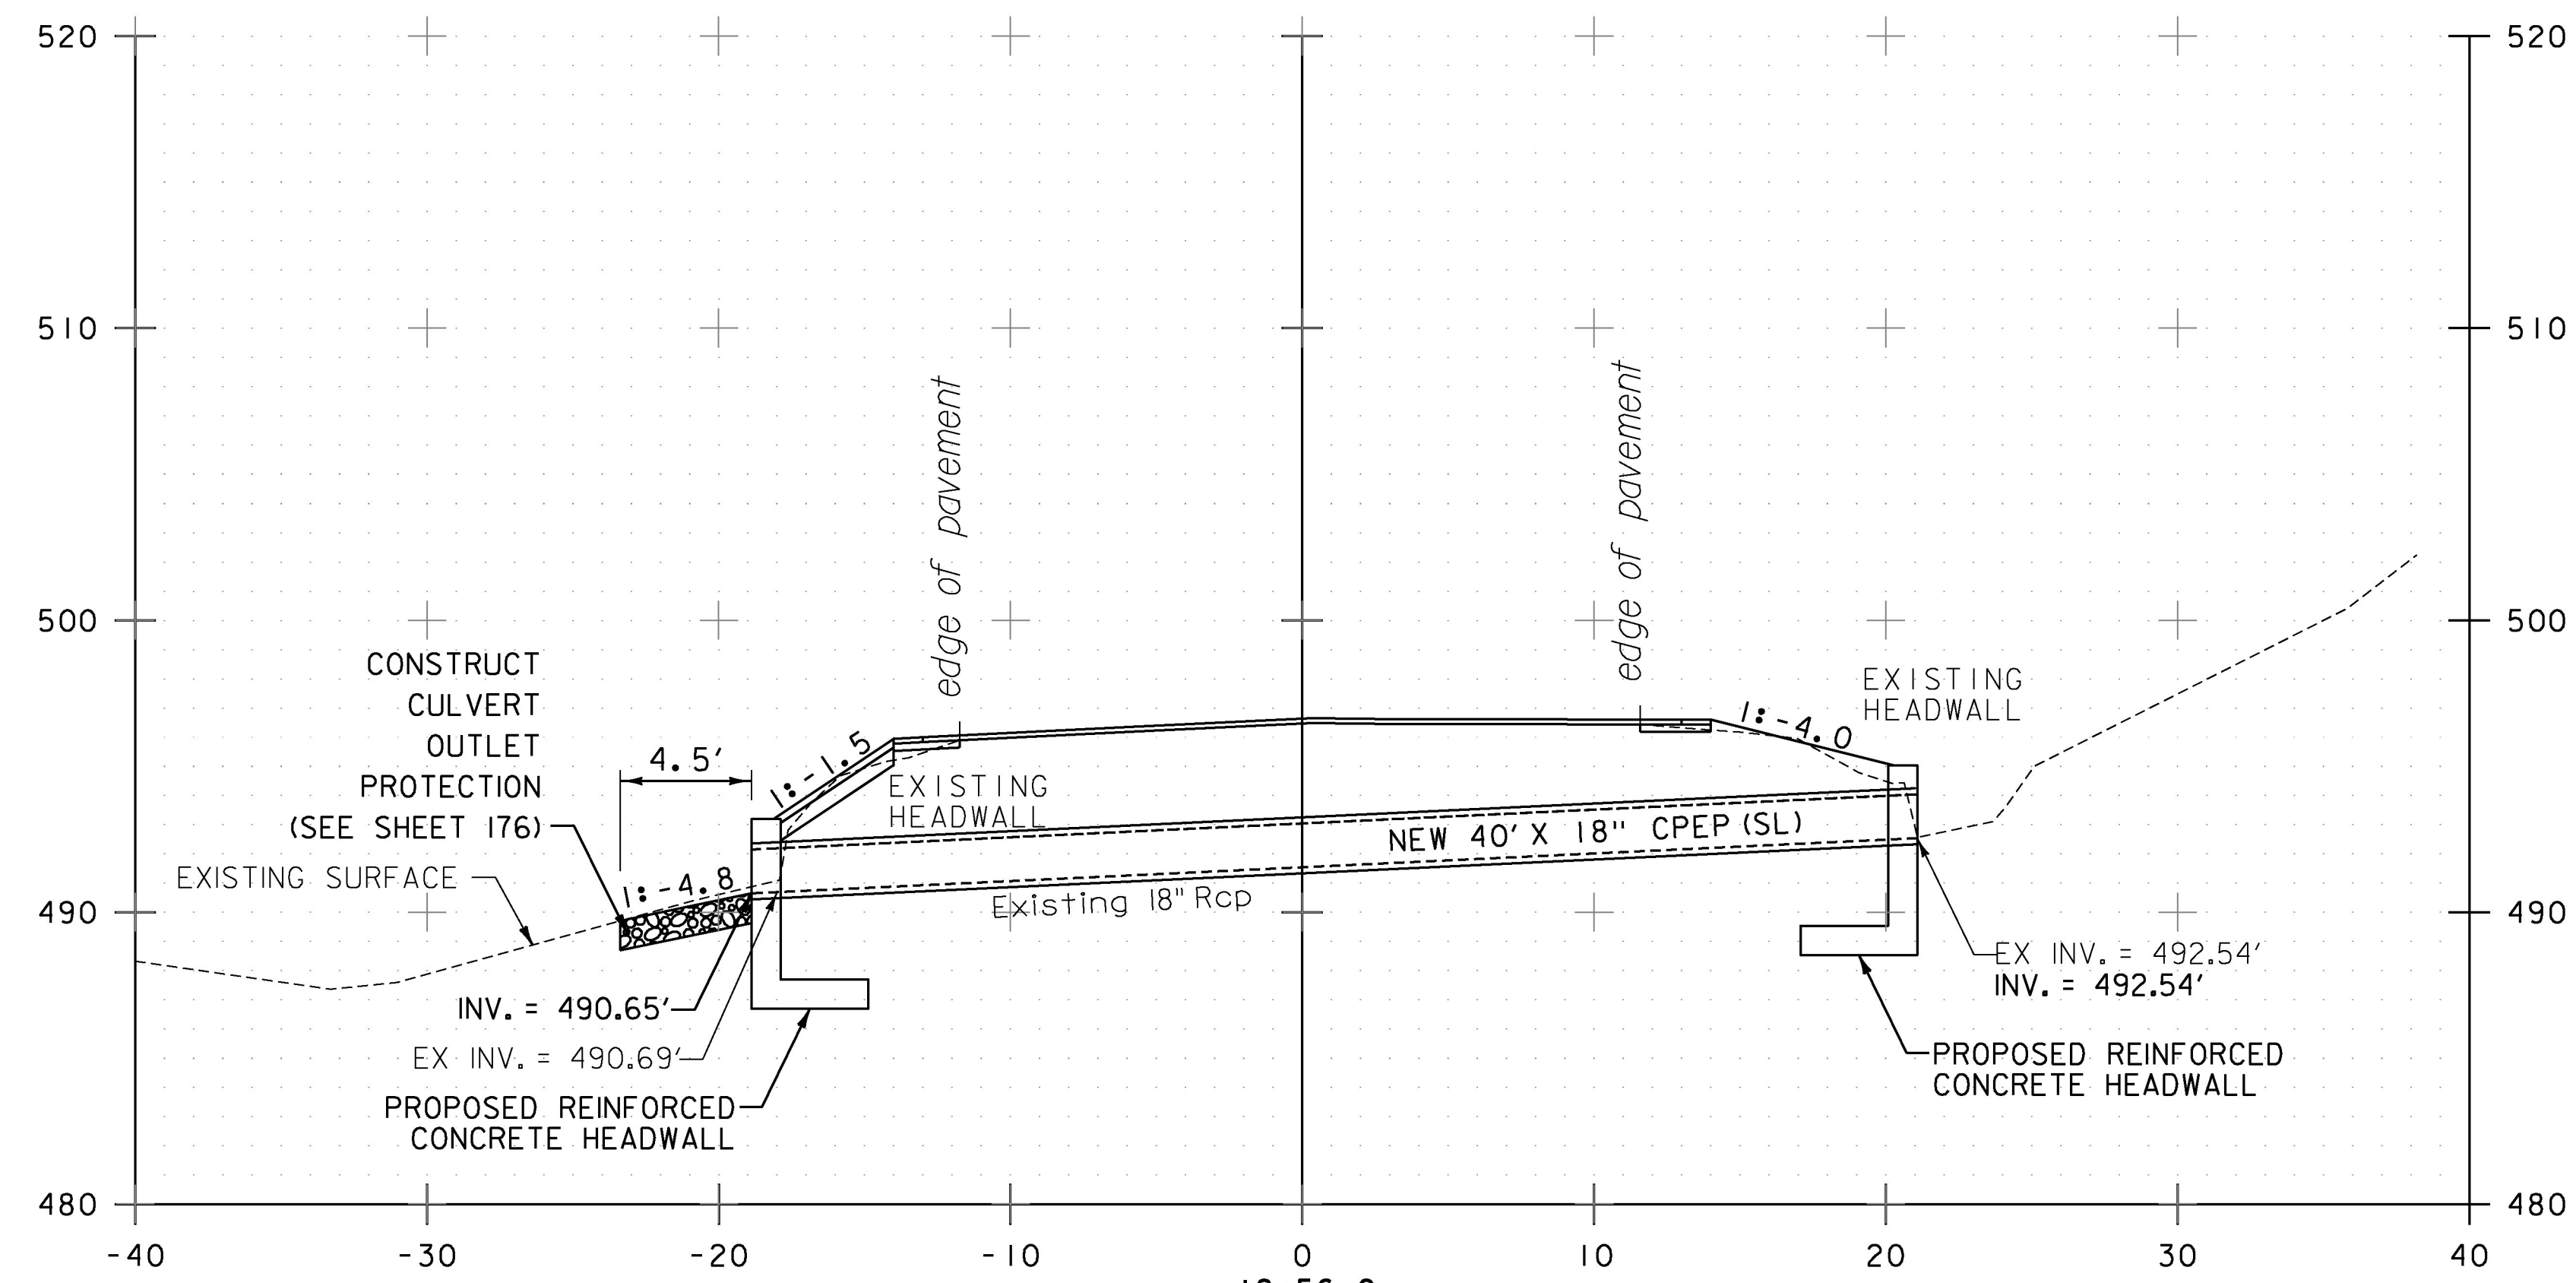

18+56.0  
 PIPE #65134  
 SKEWED 9.2° AHEAD RIGHT

NOTE: PIPE # REFERS TO PIPE IDENTIFICATION NUMBER (PID)

PROJECT NAME:	RICHFORD	PLOT DATE:	4/2/2018
PROJECT NUMBER:	STP 2916(I)	DRAWN BY:	G. BURGMEIER
FILE NAME:	z10c234xs_culv.dgn	CHECKED BY:	J. LITTLE
PROJECT LEADER:	G. EDWARDS	CULVERT CROSS SECTION SHEET 1	SHEET 196 OF 222

