




3+00

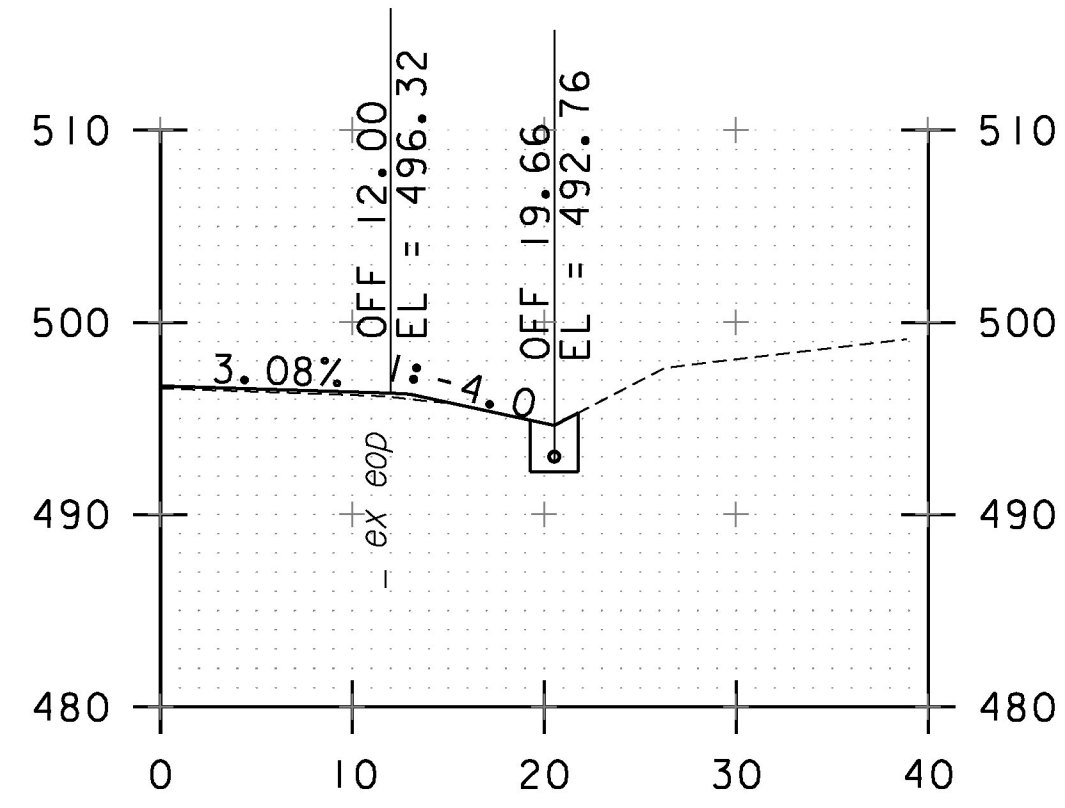


4+50

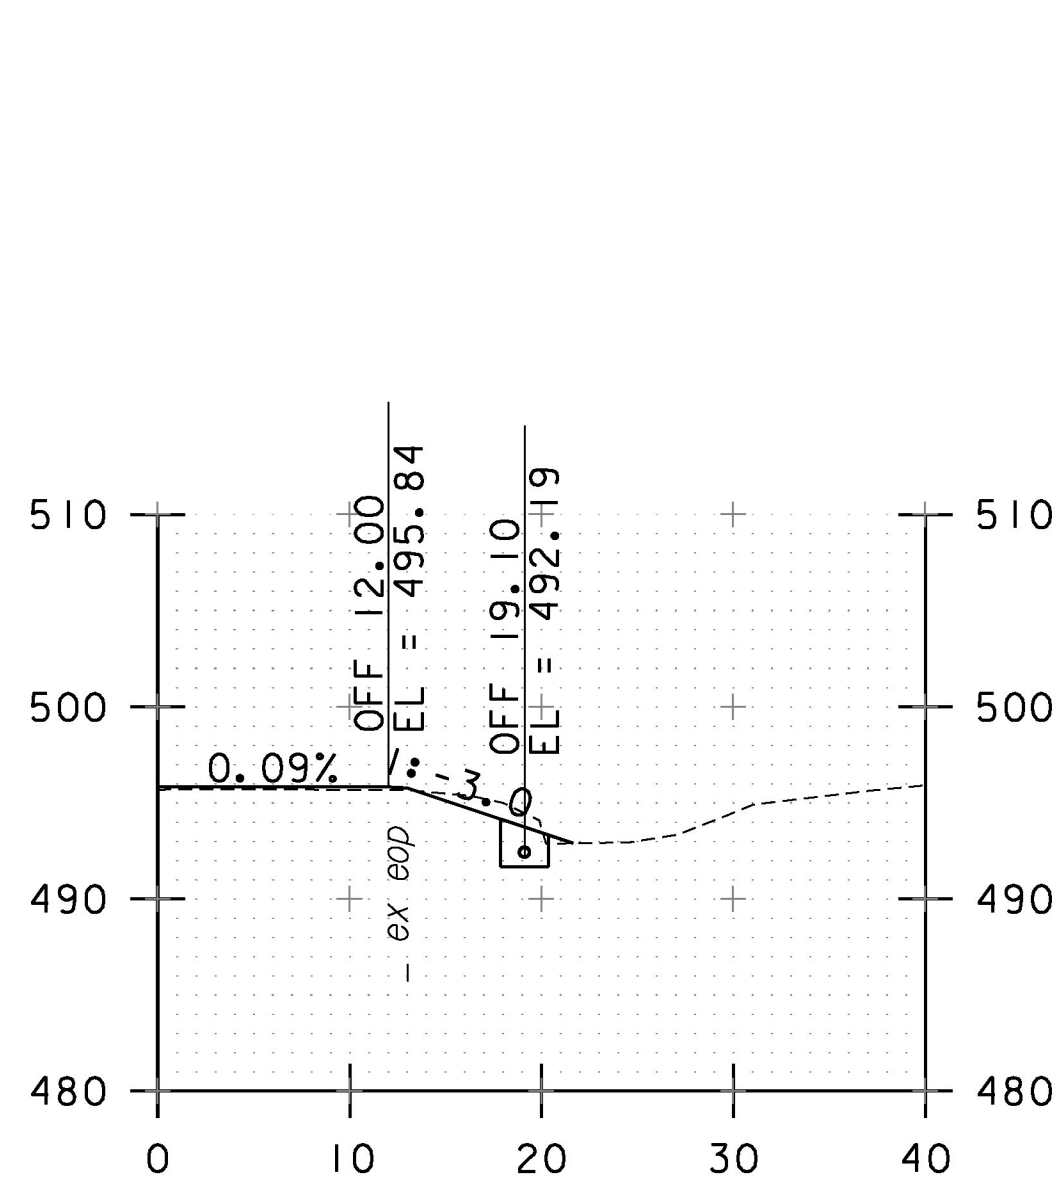


6+00

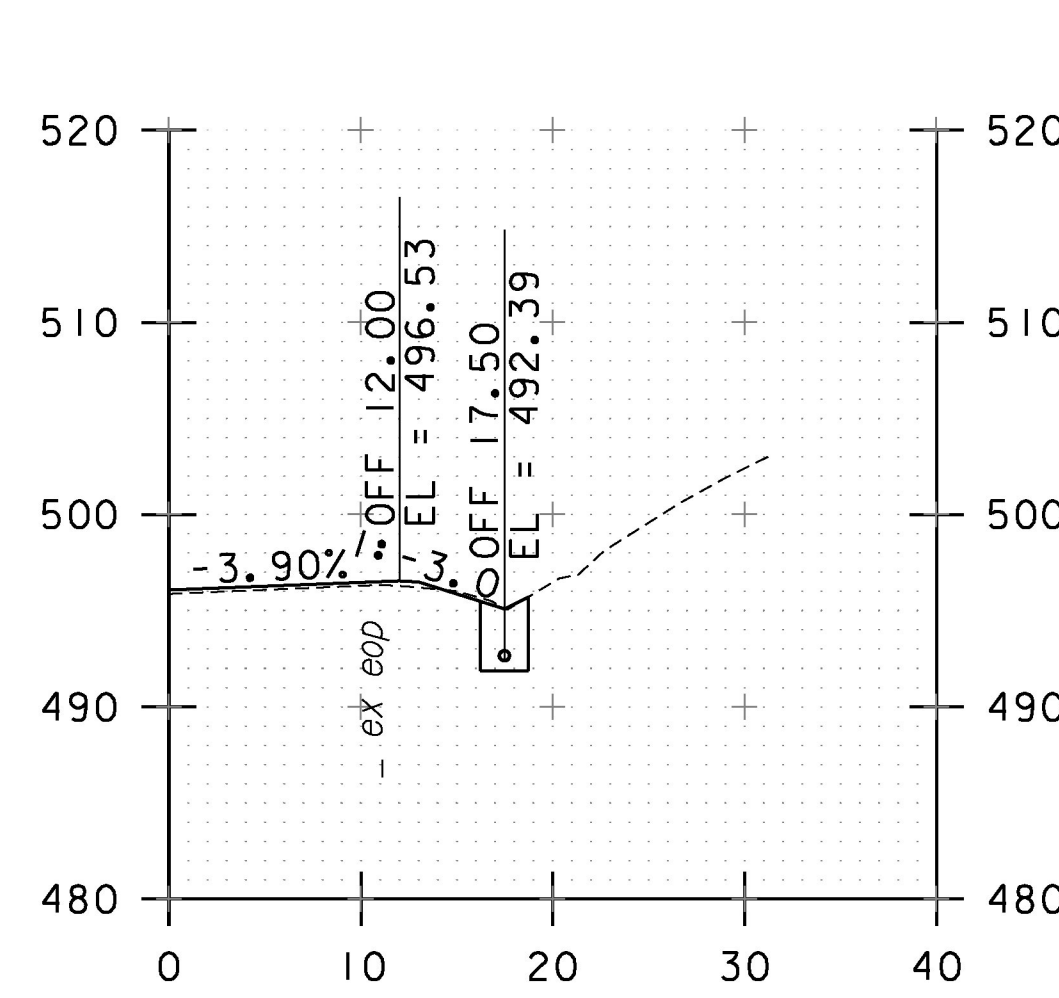


7+50

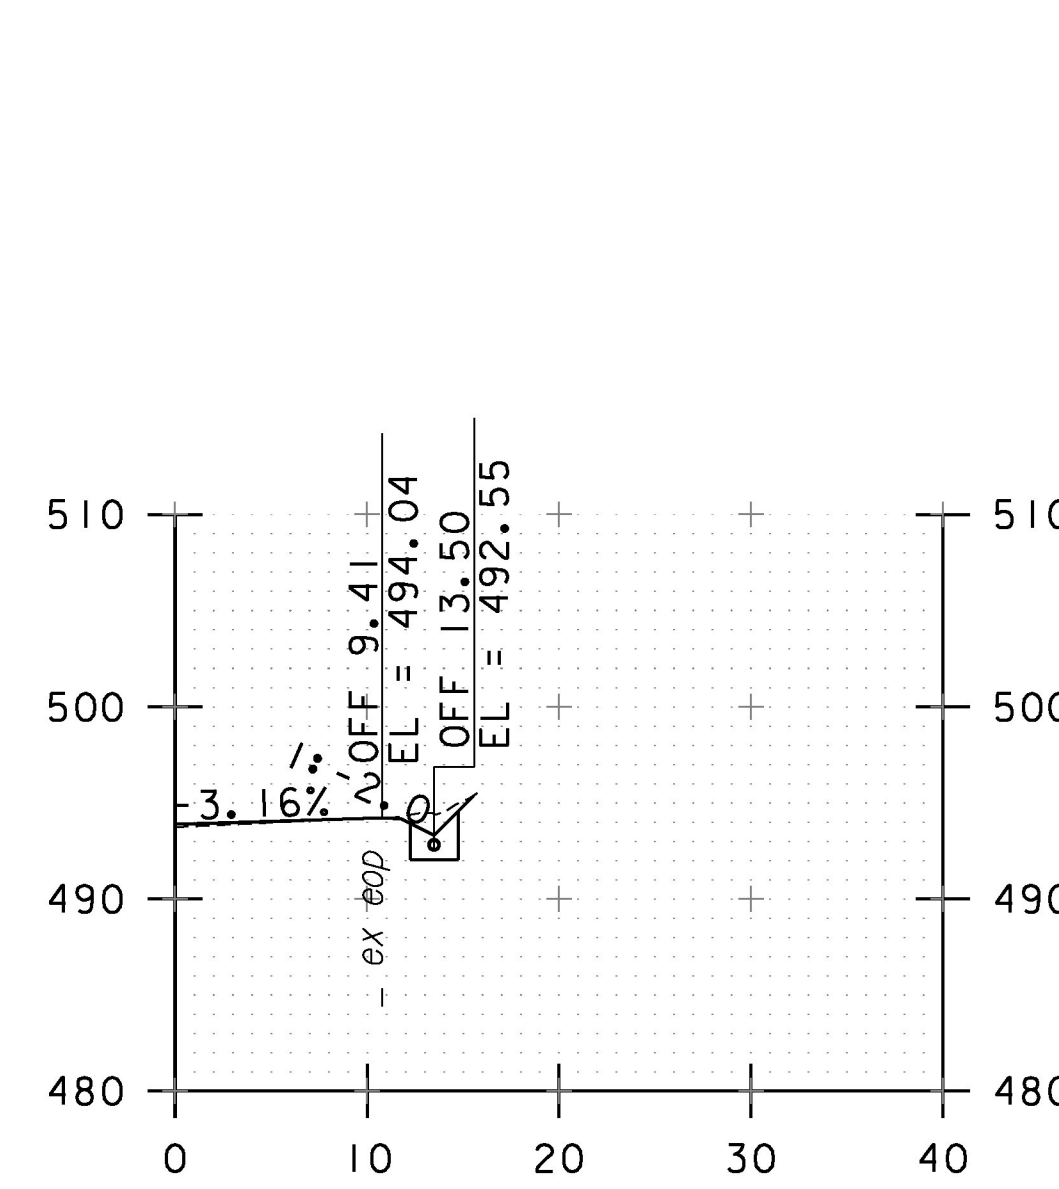


8+90

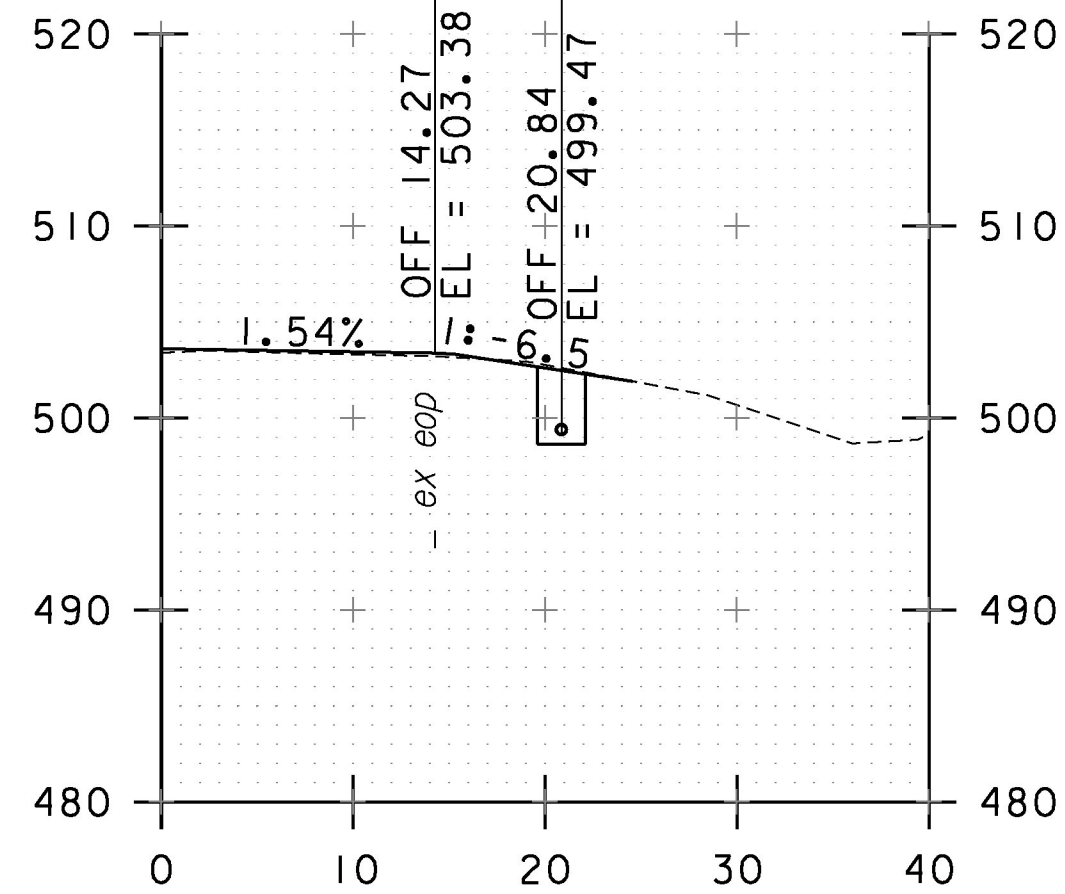


2+50

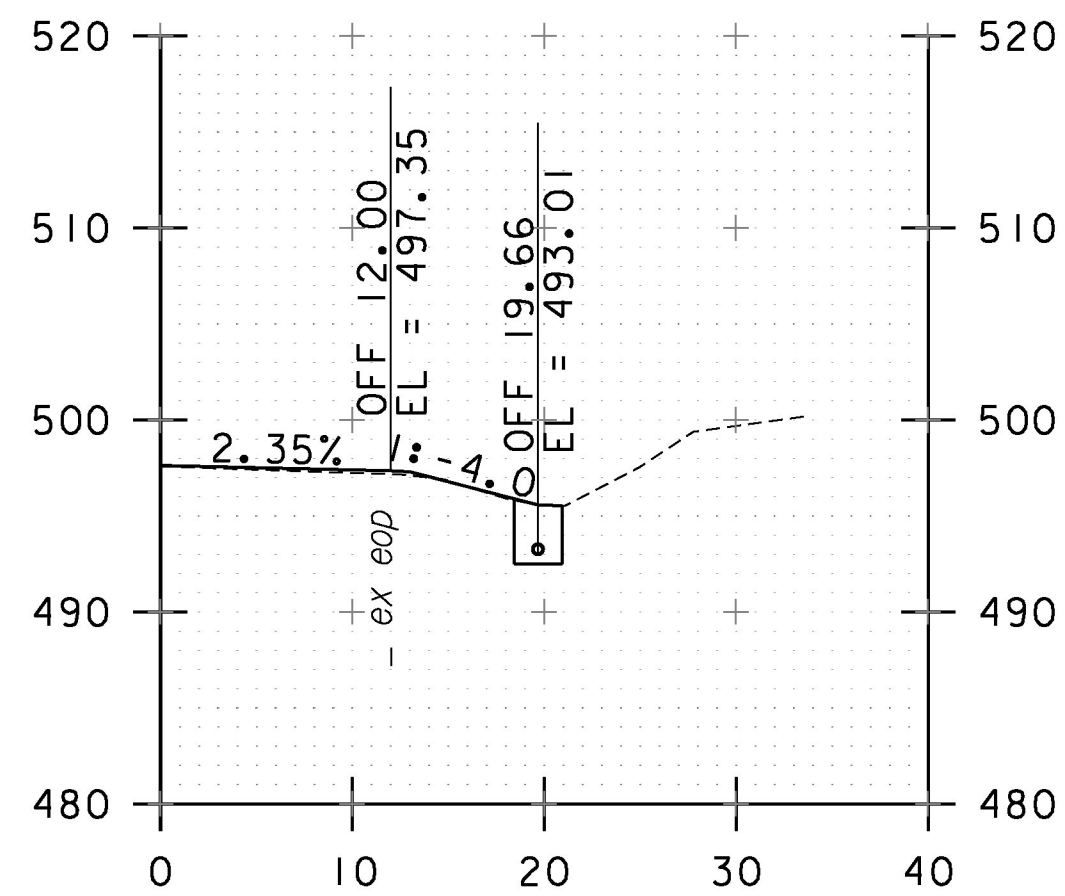


4+00

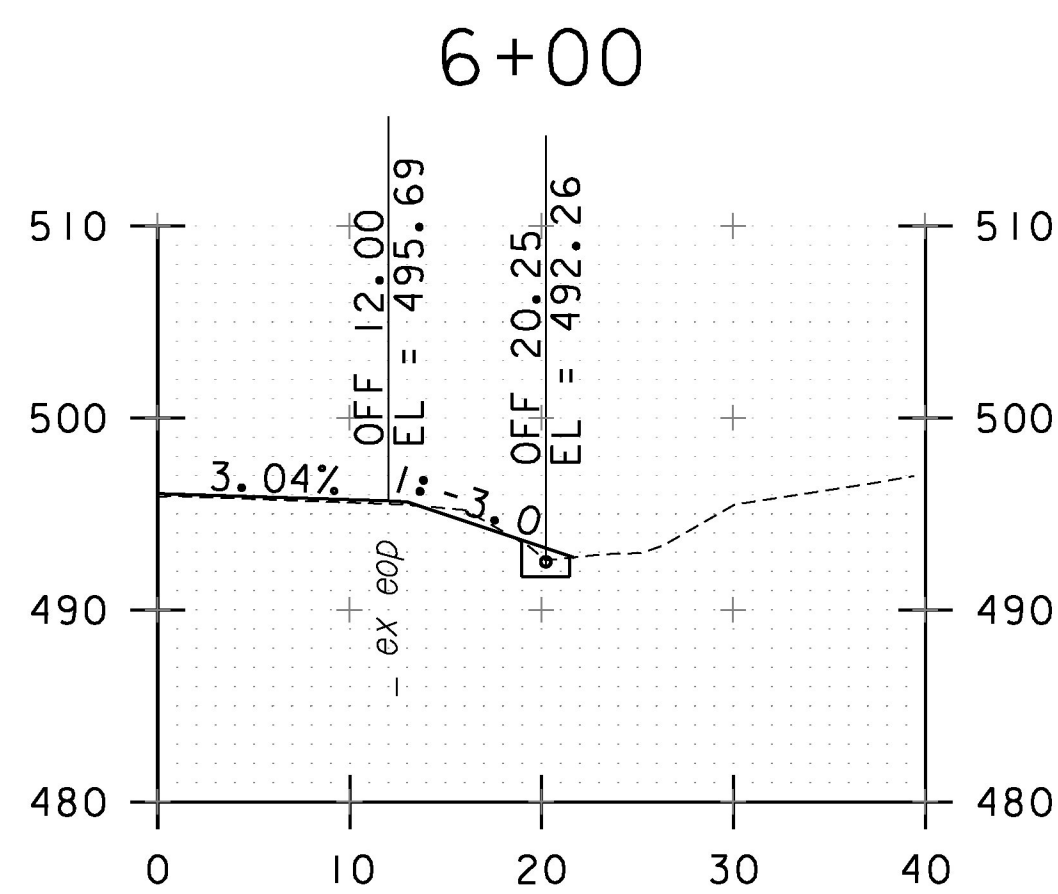


5+50

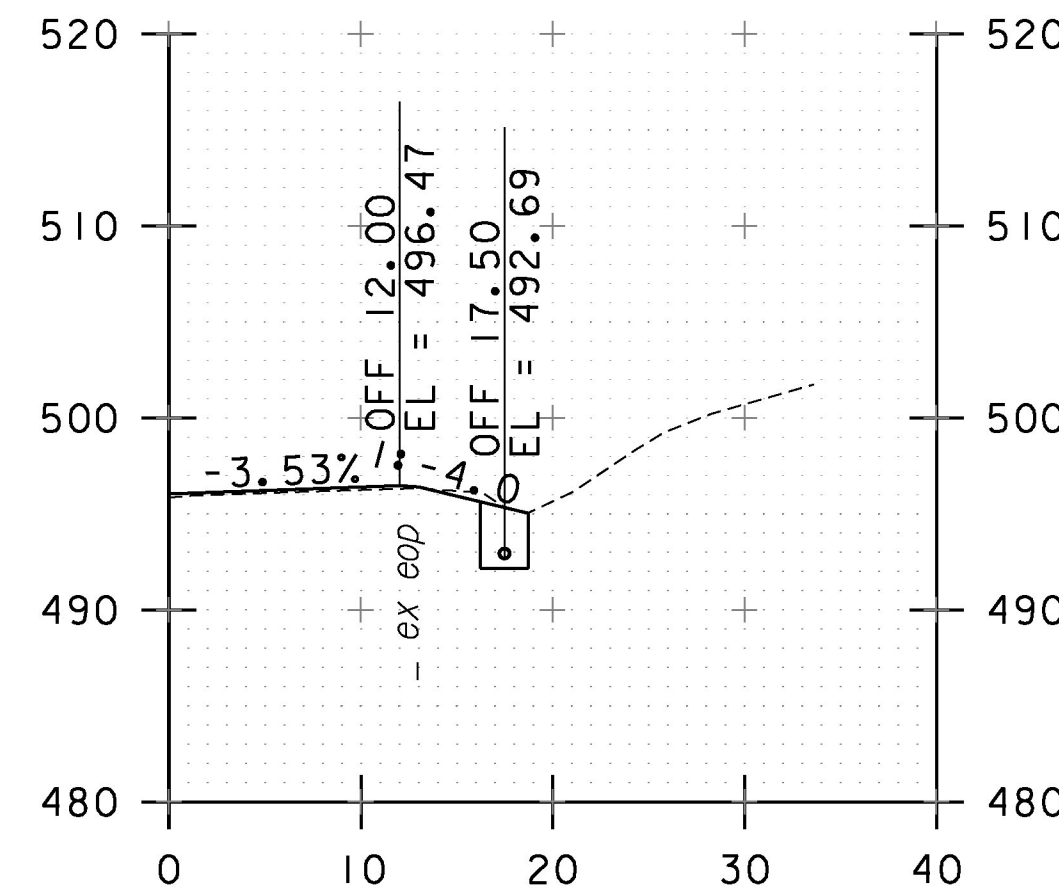


7+00

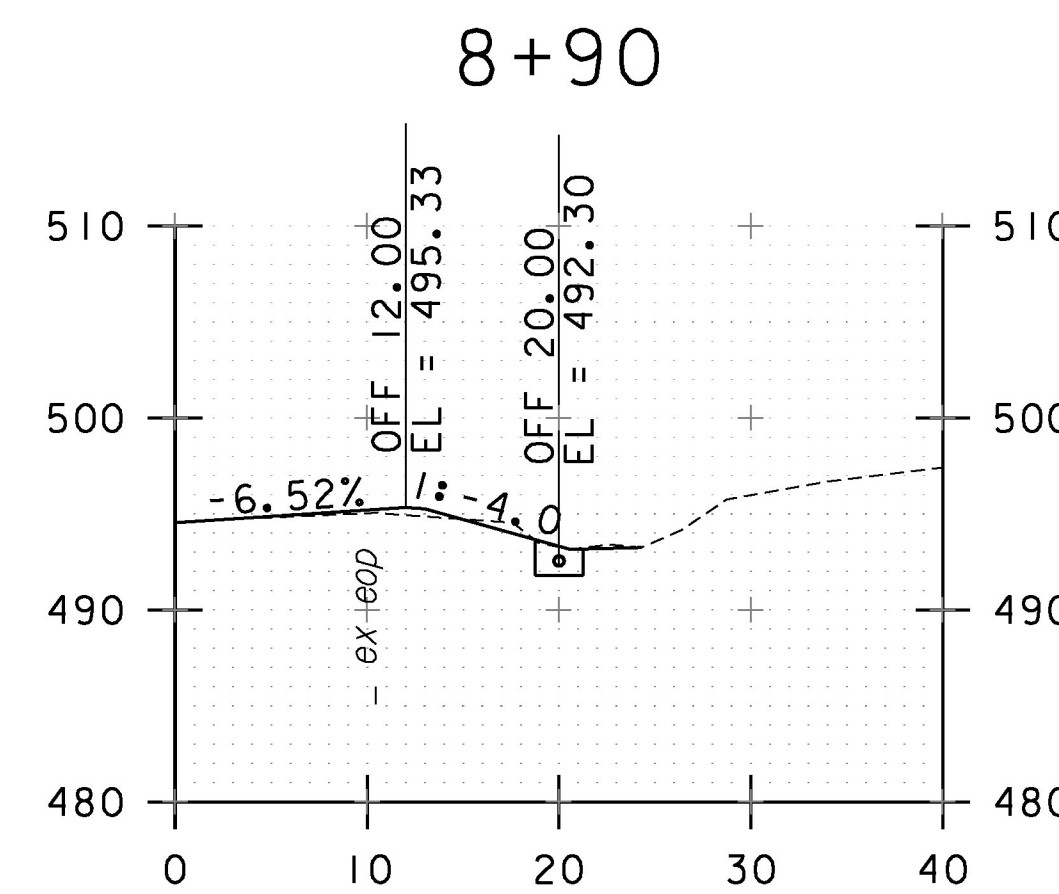


8+50

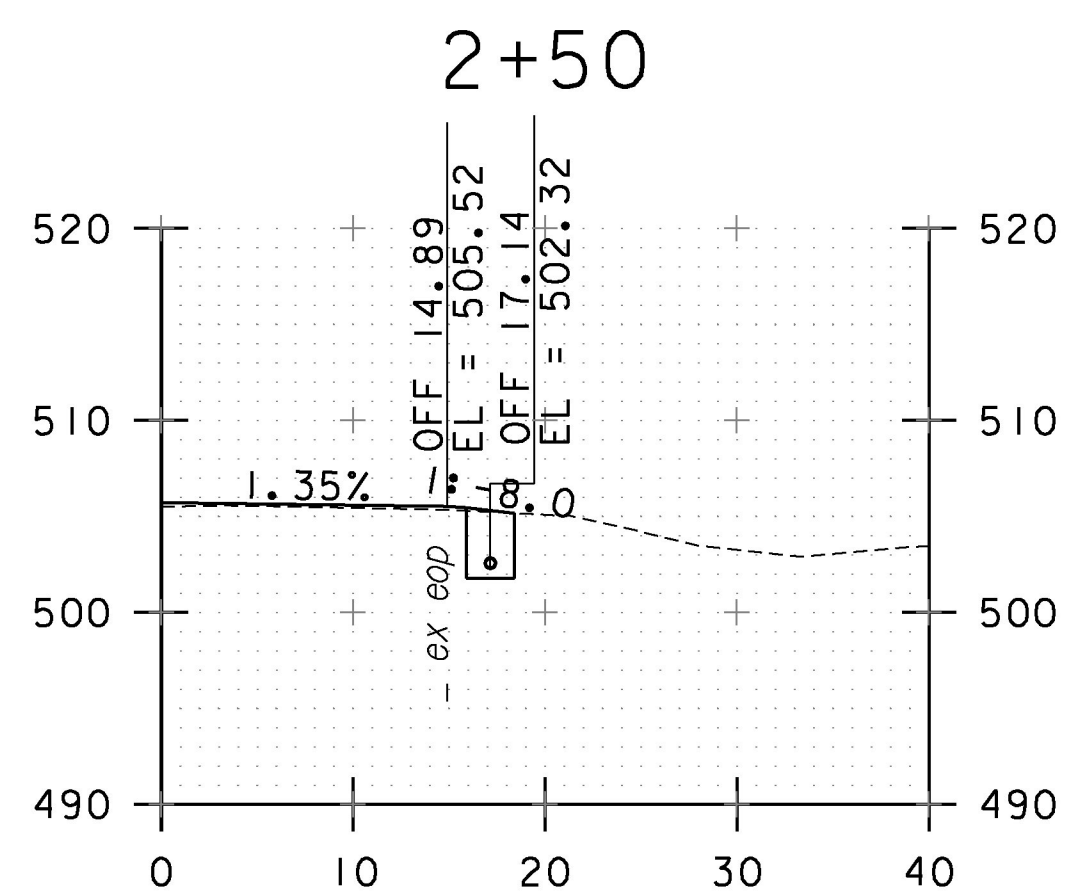


2+00

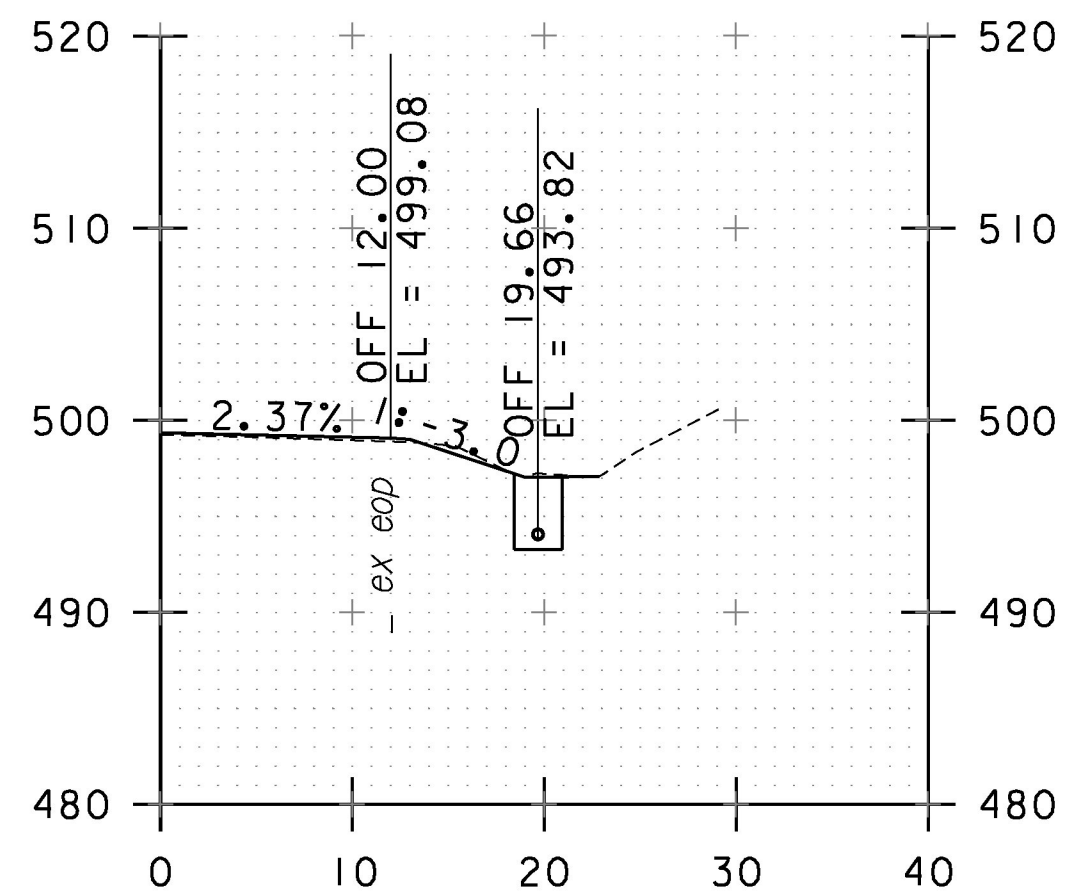


3+50

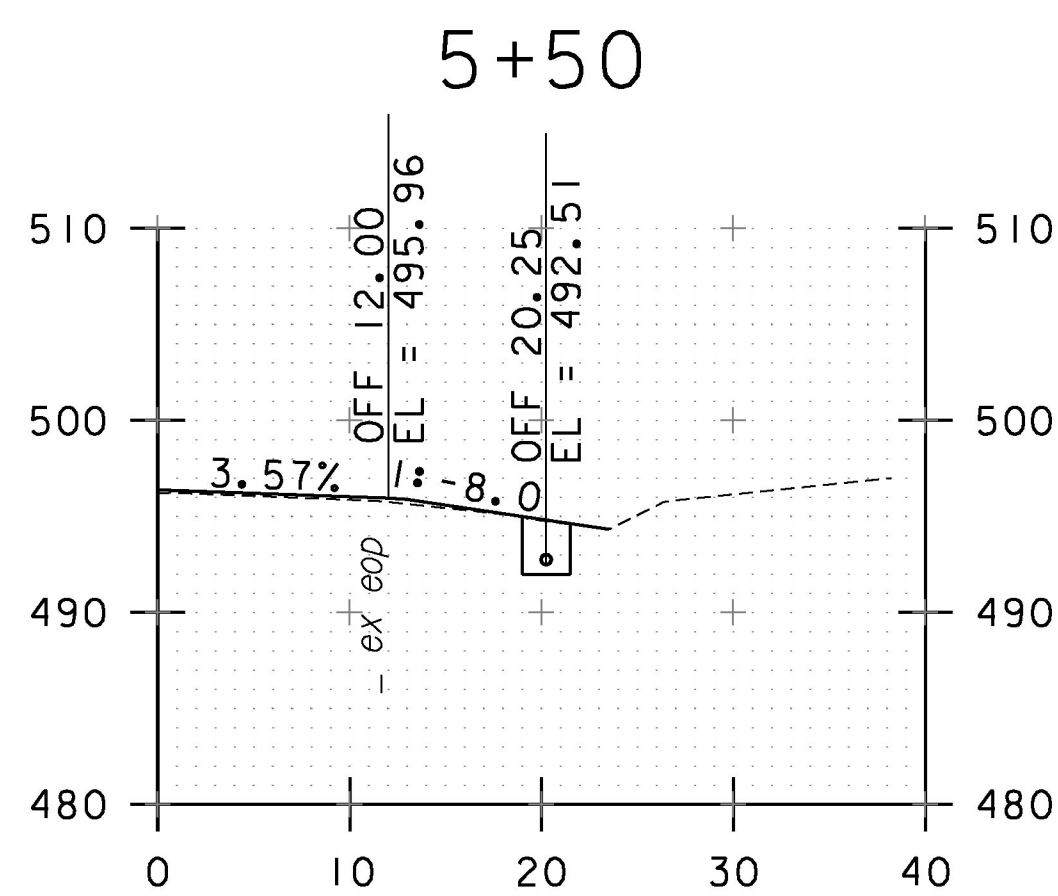

5+00

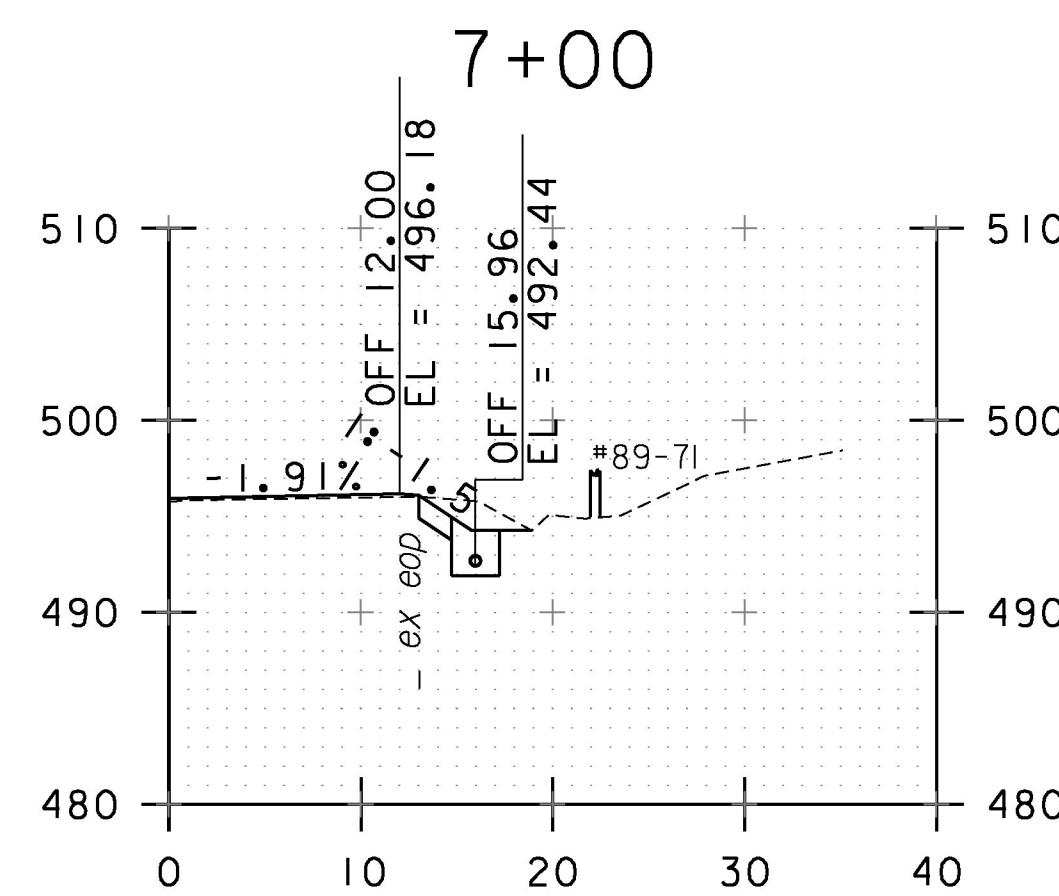

6+50

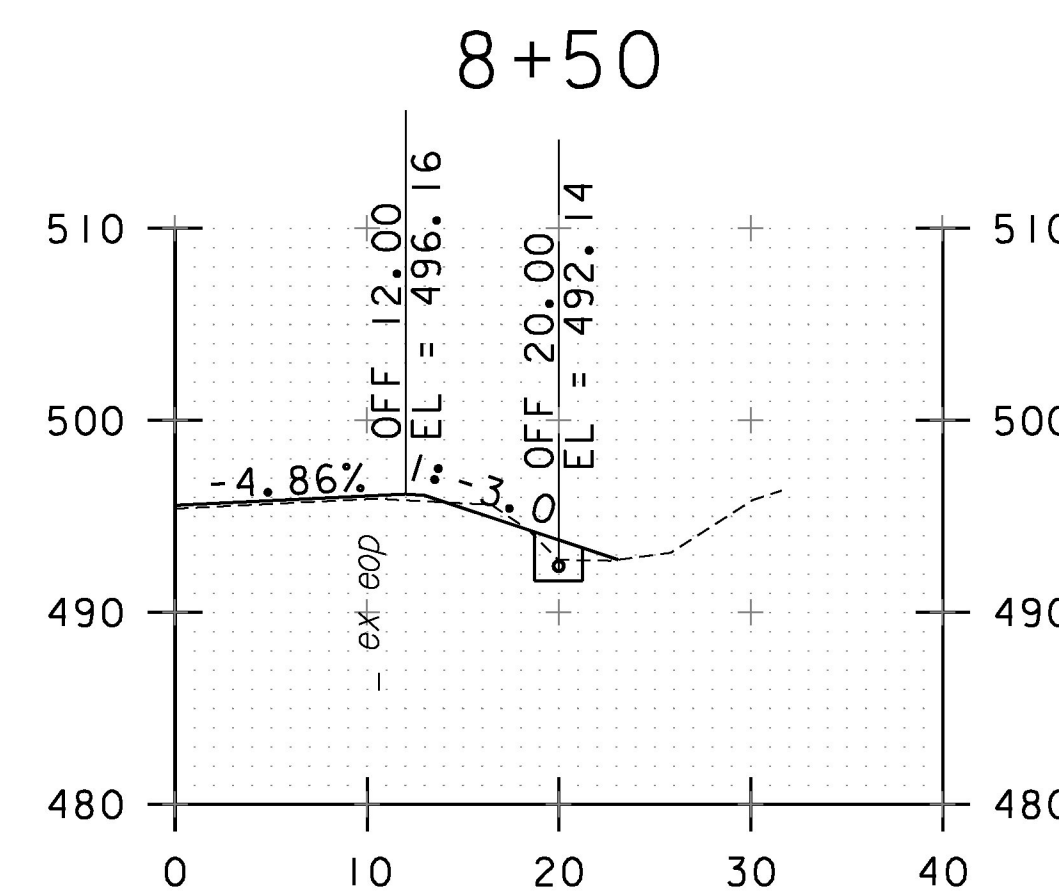

8+00

PROJECT NAME:	RICHFORD
PROJECT NUMBER:	STP 2916(I)
FILE NAME:	z10c234xs.dgn
PROJECT LEADER:	G. EDWARDS
DESIGNED BY:	G. BURGMEIER
UNDERDRAIN CROSS SECTION SHEET I	
PLOT DATE:	4/2/2018
DRAWN BY:	G. BURGMEIER
CHECKED BY:	J. LITTLE
SHEET	199 OF 222

