




10+50

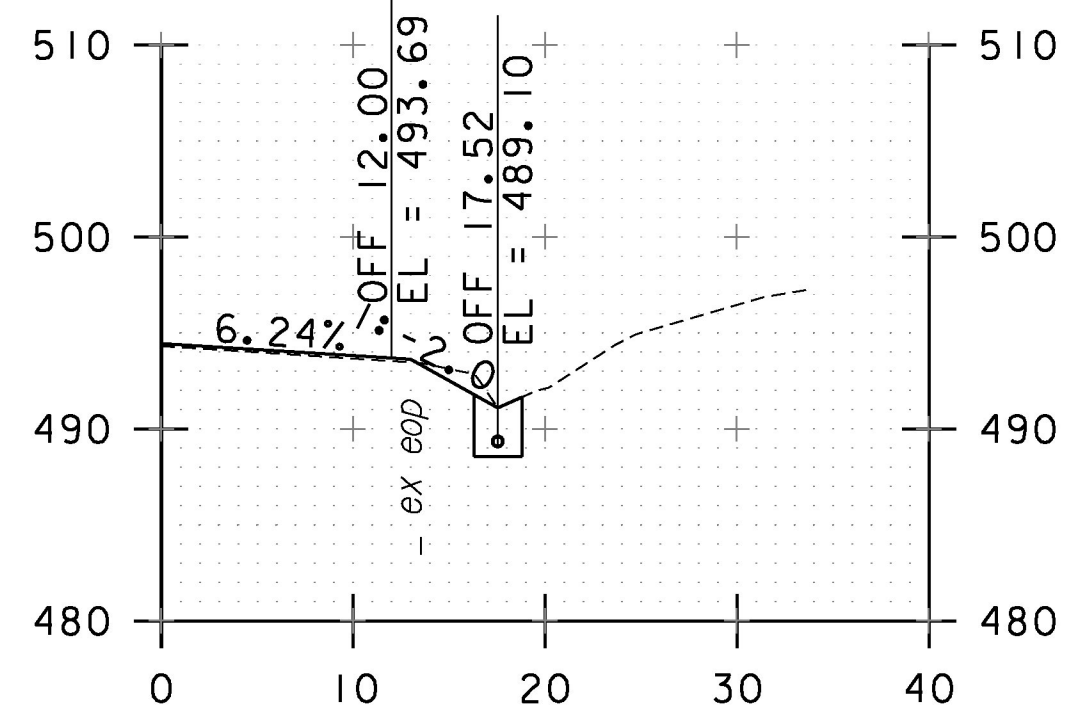


10+00

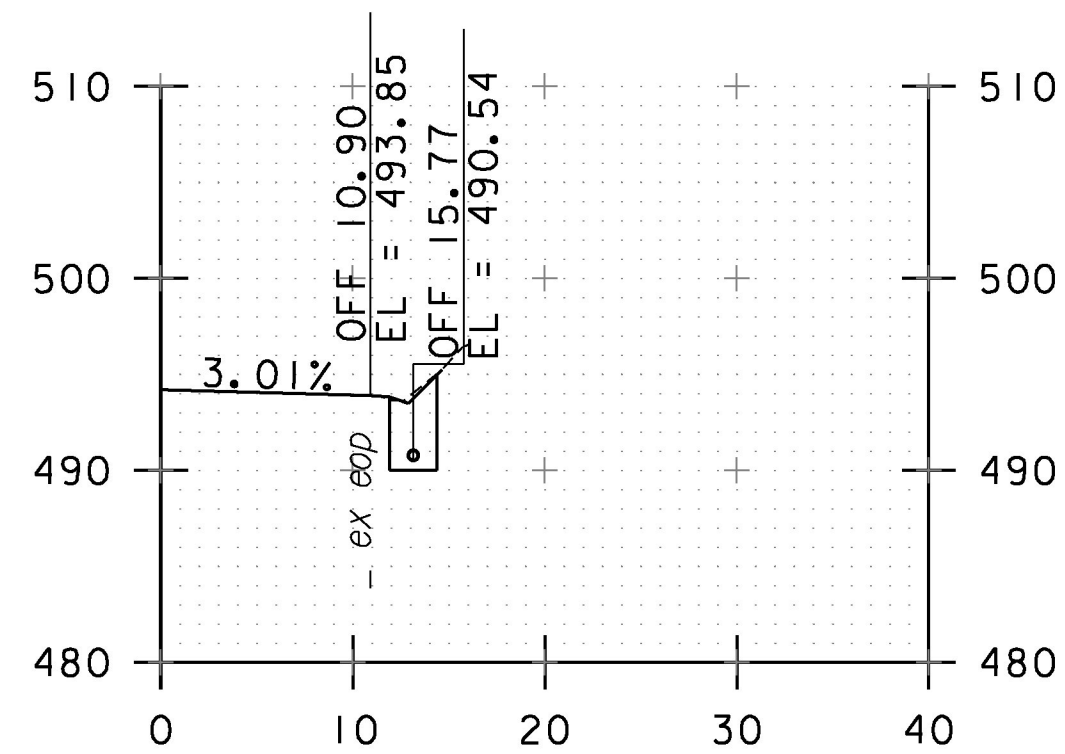


9+55

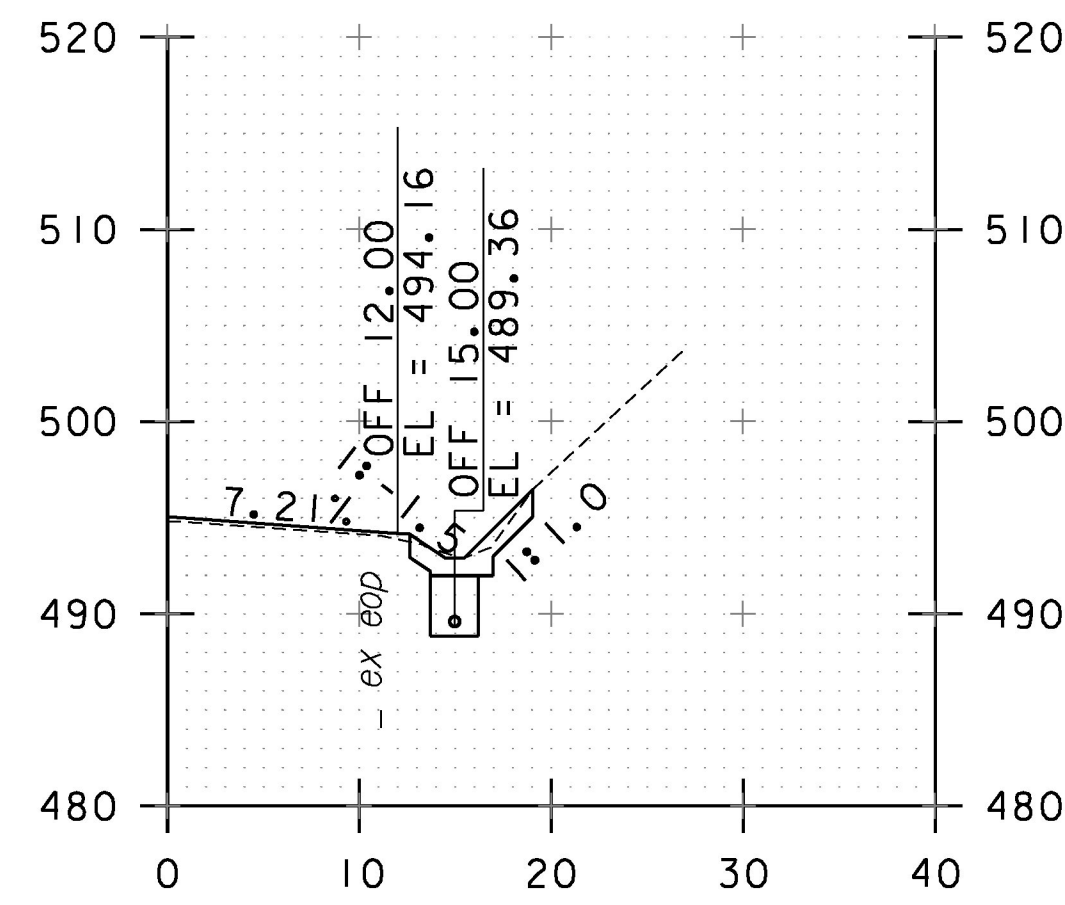


12+00

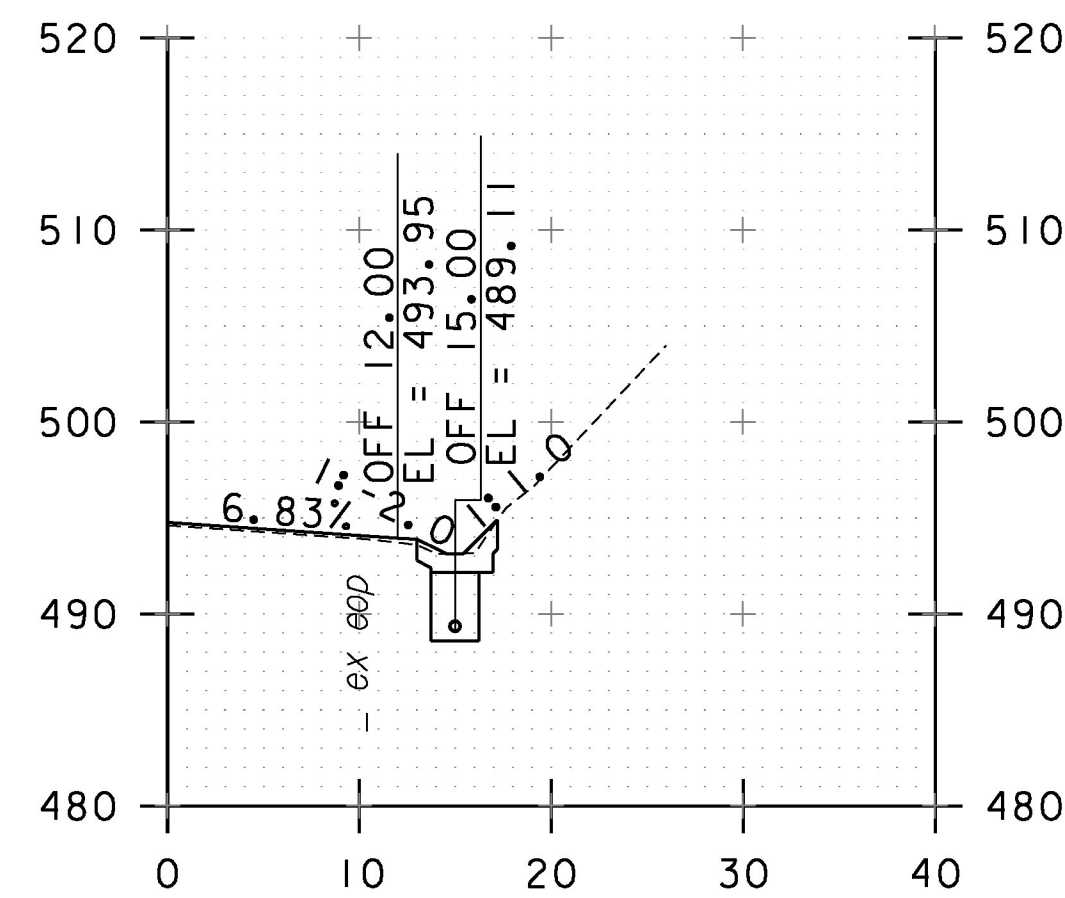


11+50

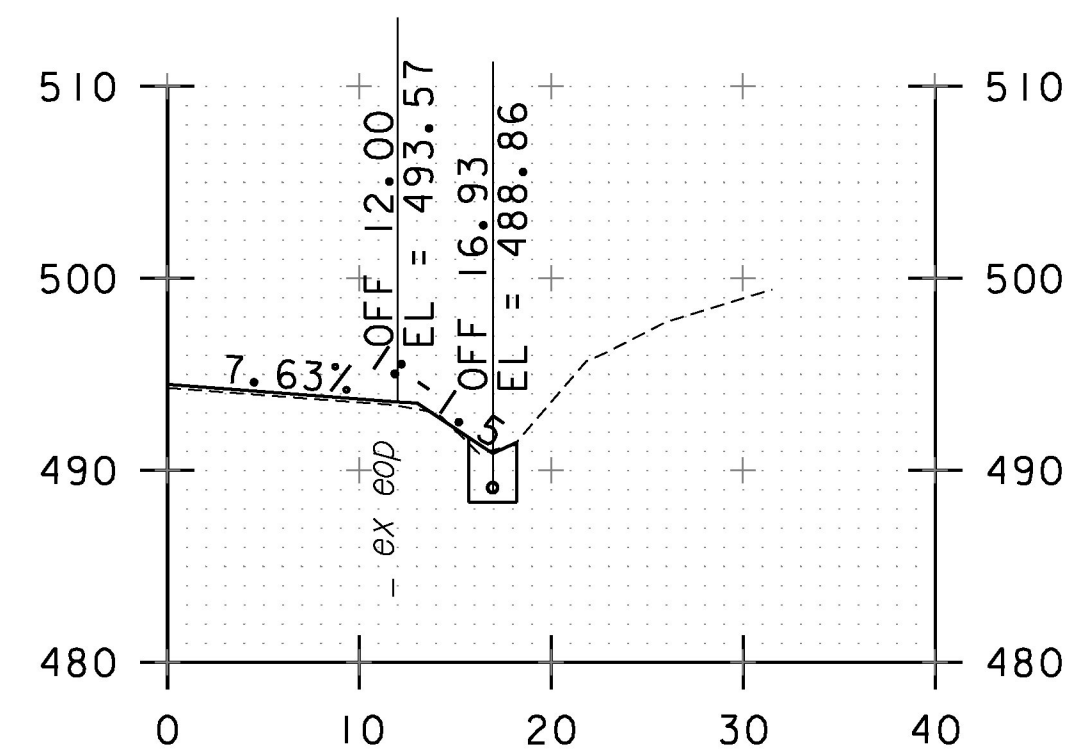


11+00

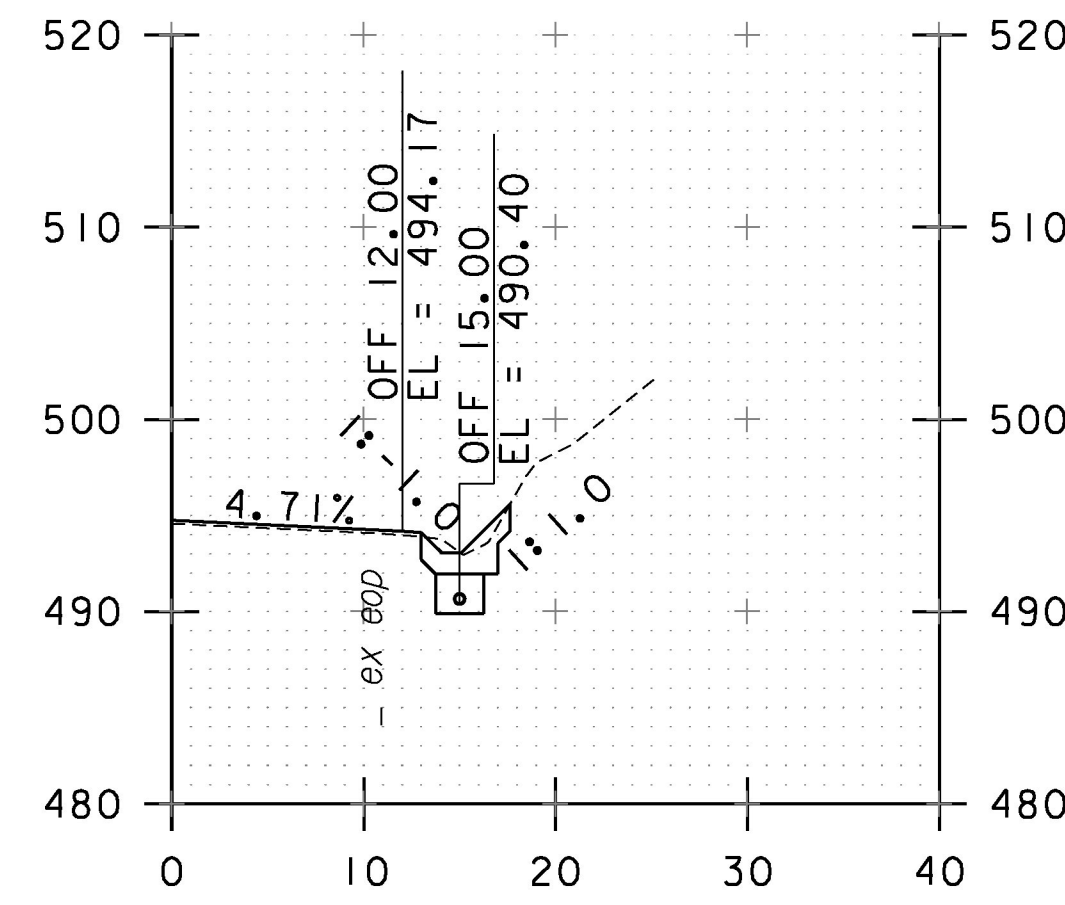


13+50

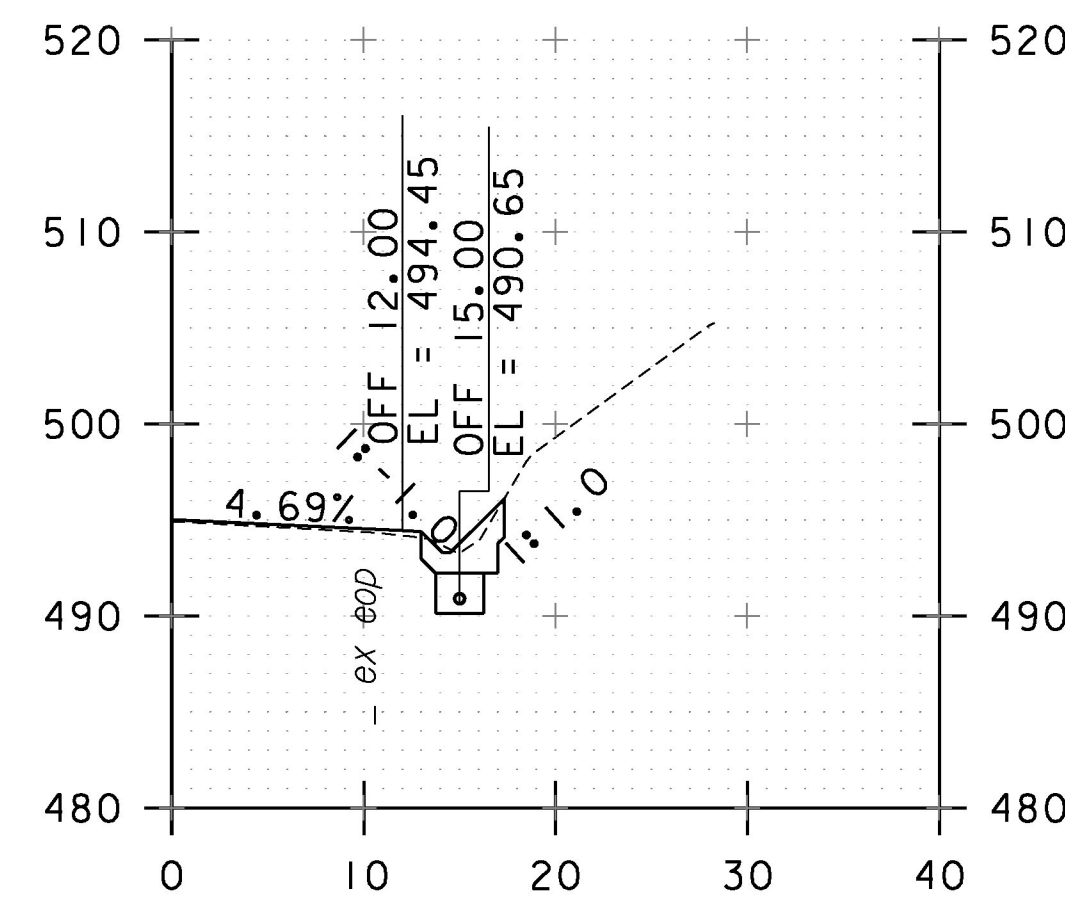


13+00

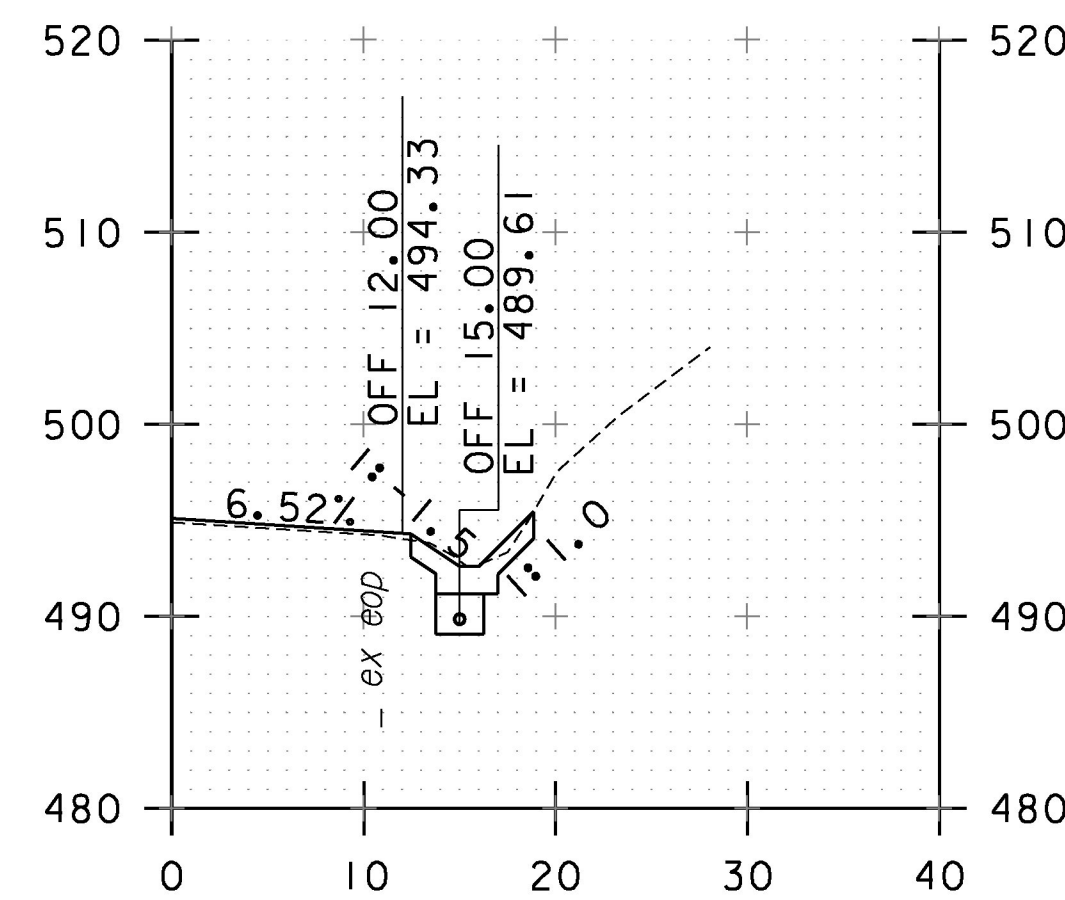


12+50

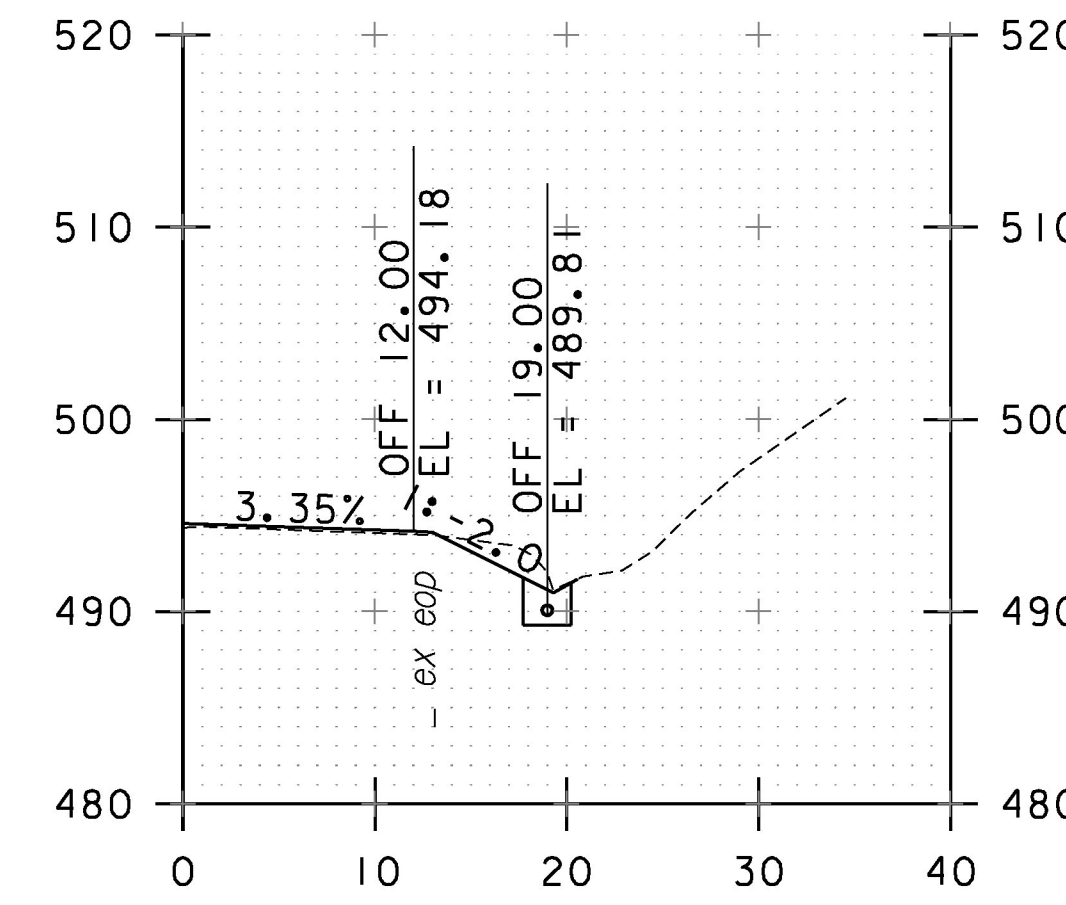


15+00

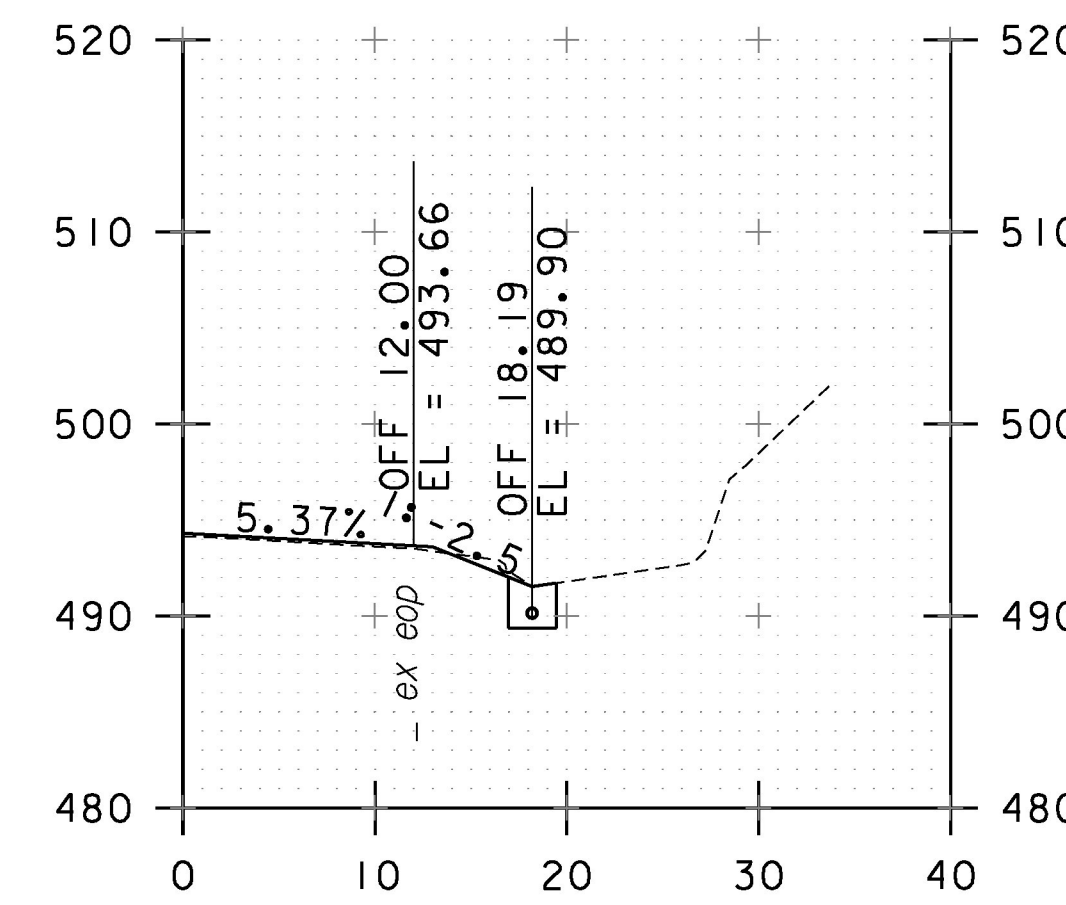


14+50

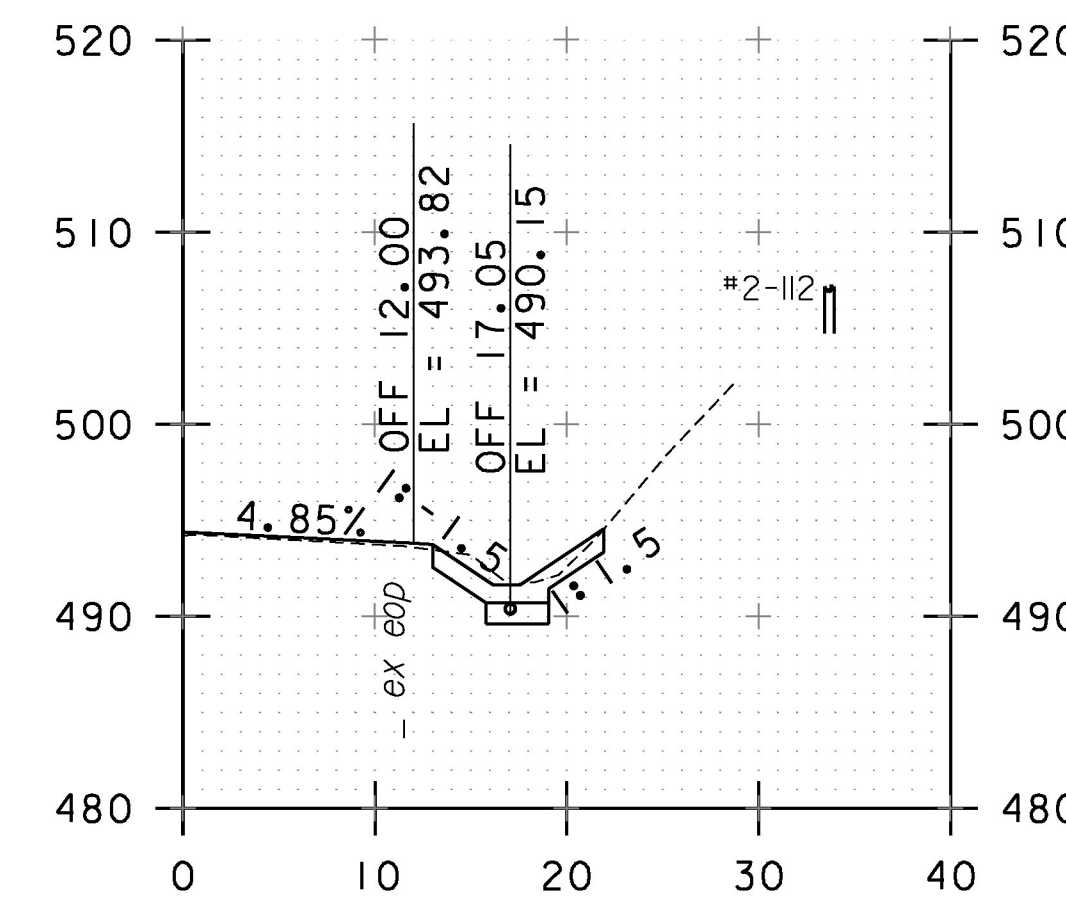


14+00

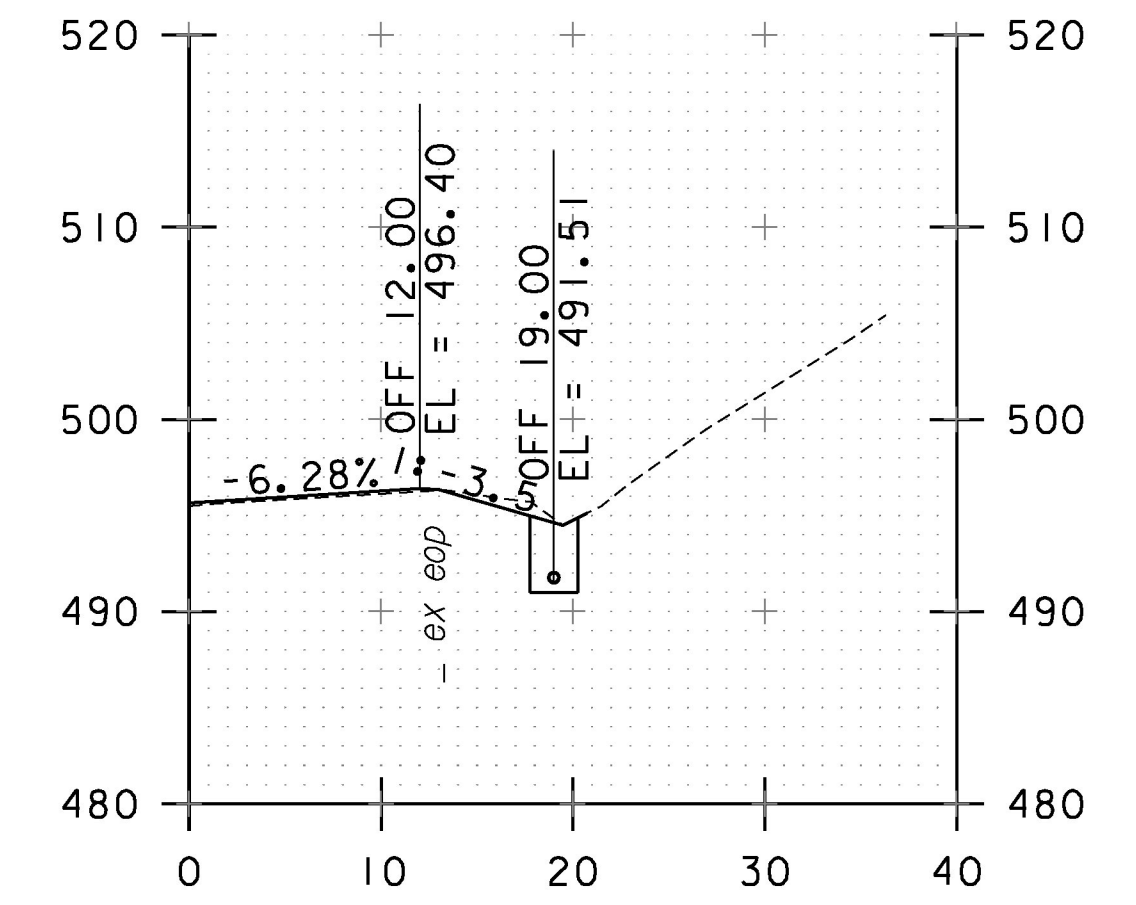

16+50

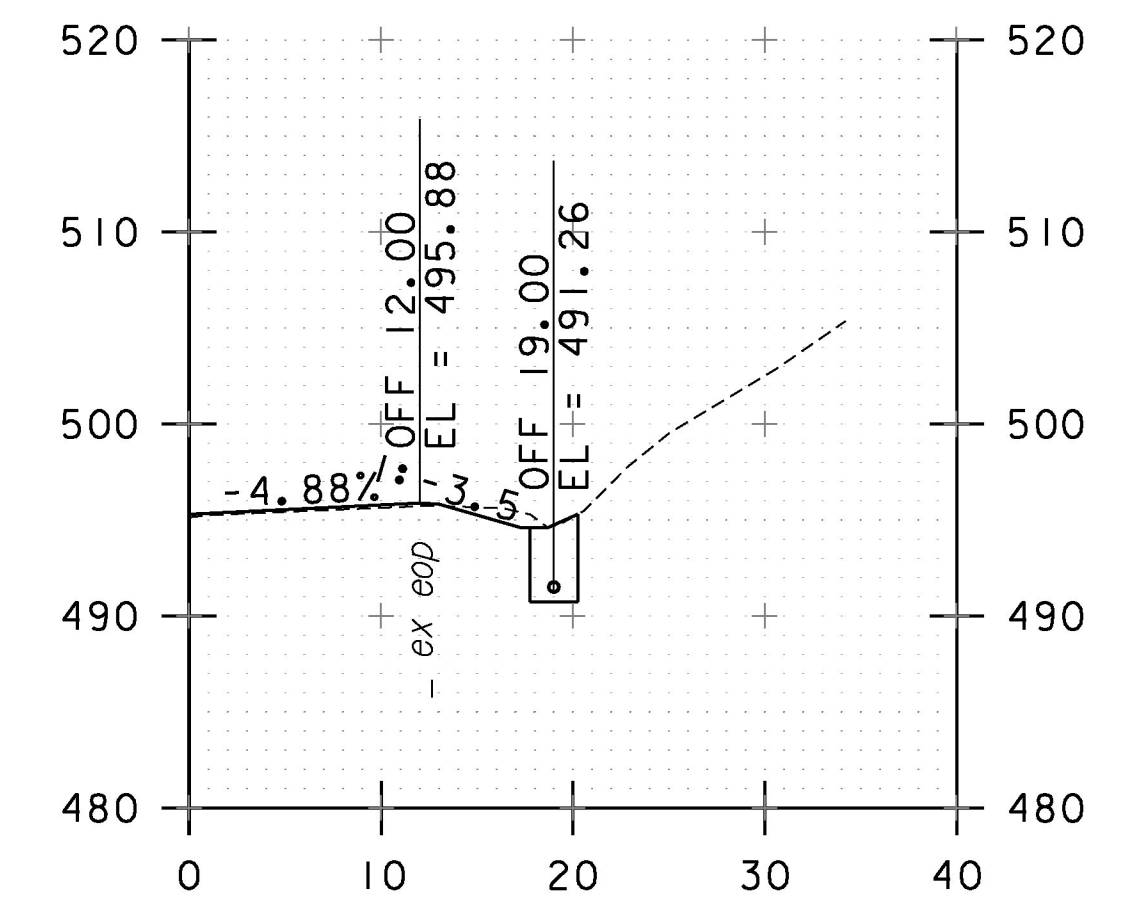

16+00

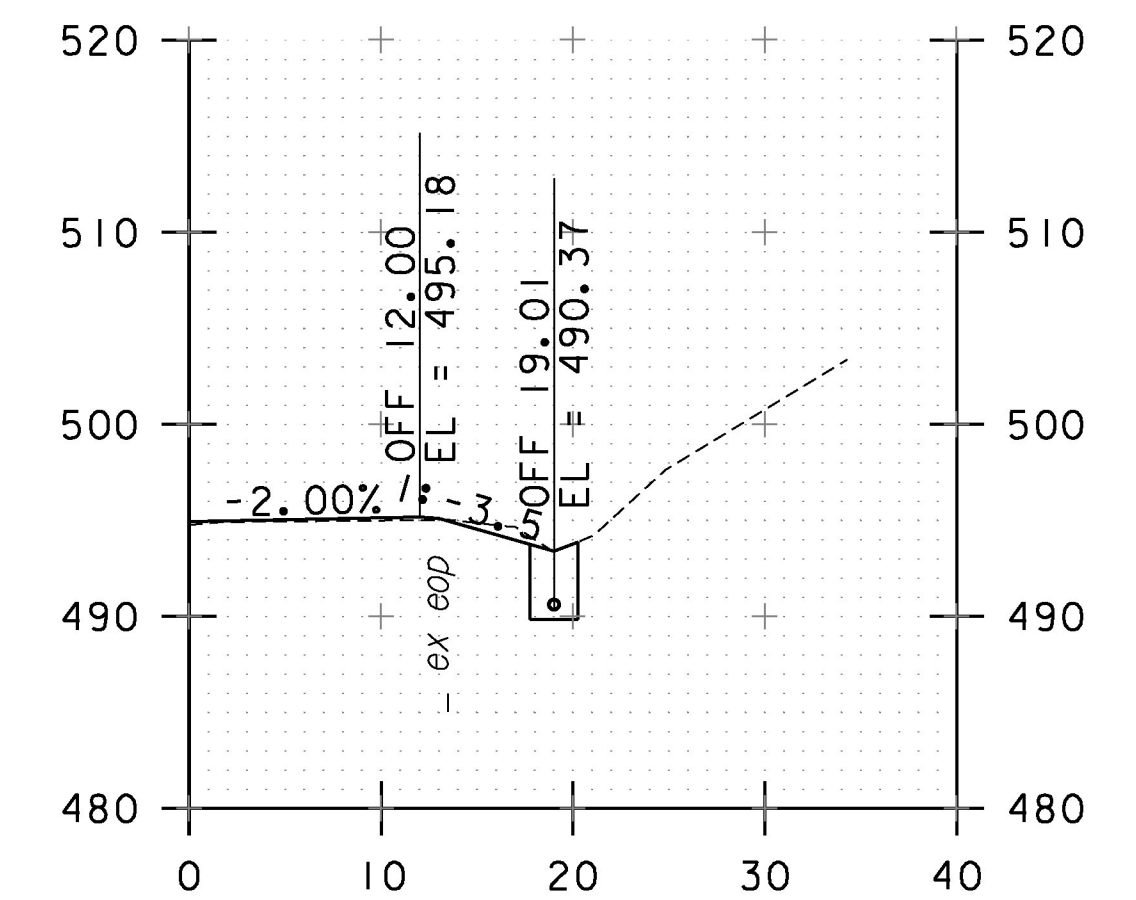

15+50

PROJECT NAME:	RICHFORD	PLOT DATE:	4/2/2018
PROJECT NUMBER:	STP 2916(I)	DRAWN BY:	G. BURGMEIER
FILE NAME:	z10c234xs.dgn	DESIGNED BY:	G. BURGMEIER
PROJECT LEADER:	G. EDWARDS	CHECKED BY:	J. LITTLE
UNDERDRAIN CROSS SECTION SHEET 2			SHEET 200 OF 222

