




17+50

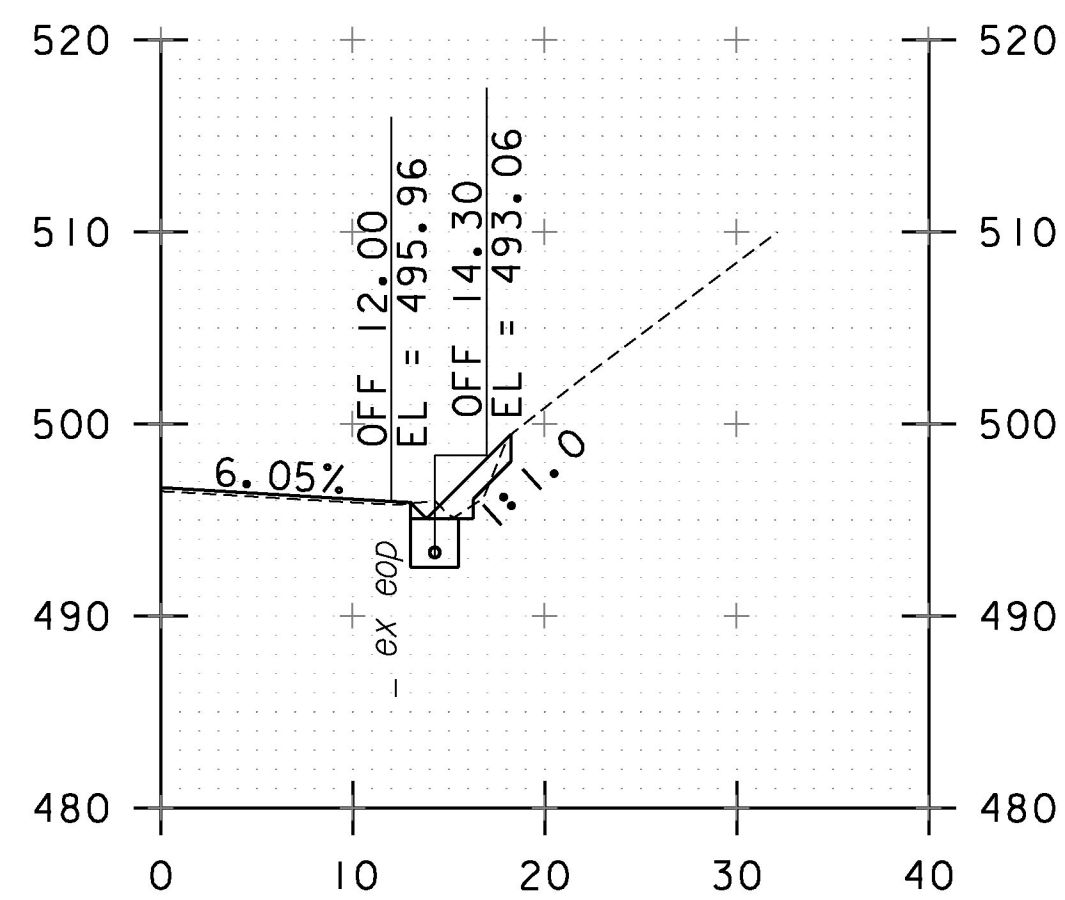


19+50

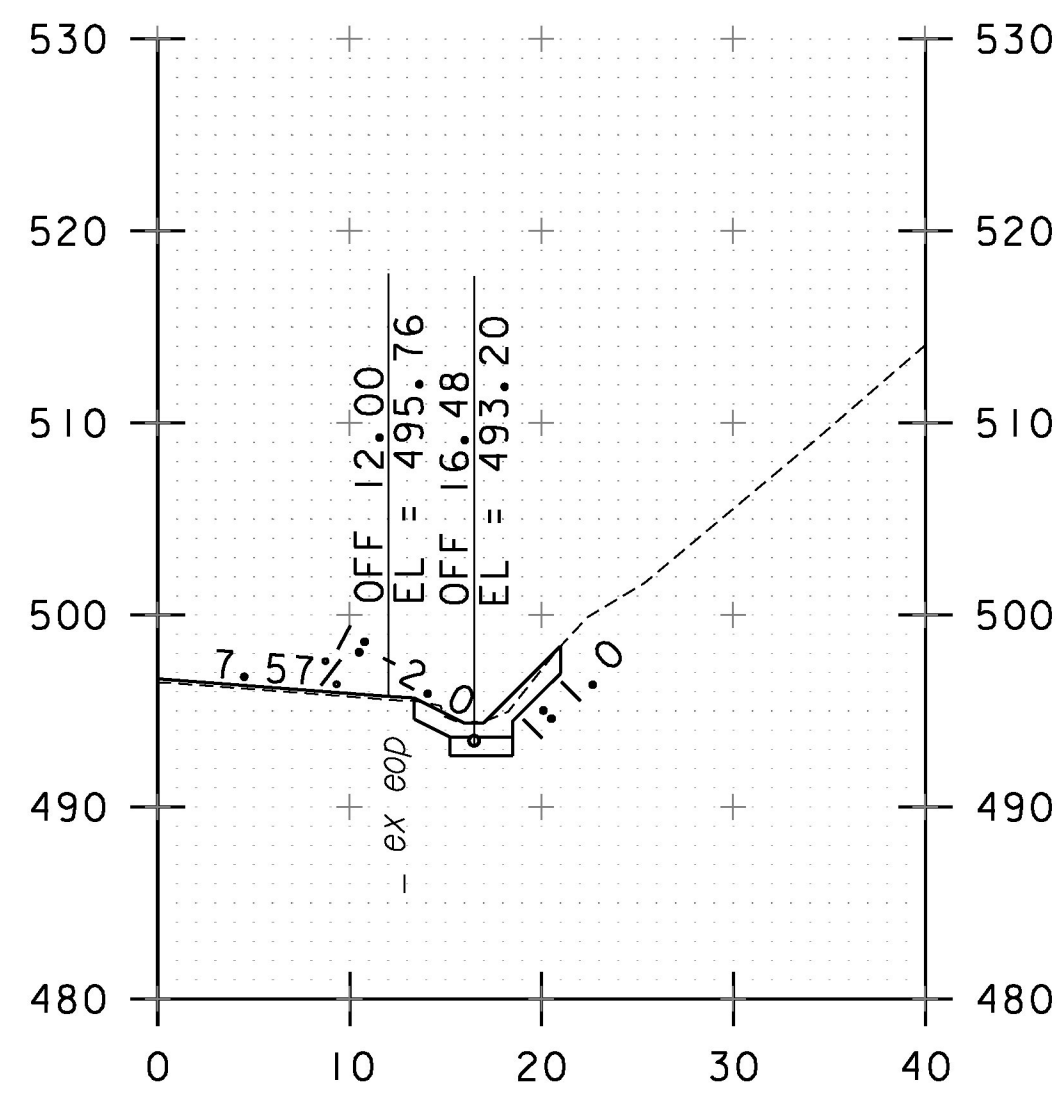


20+50

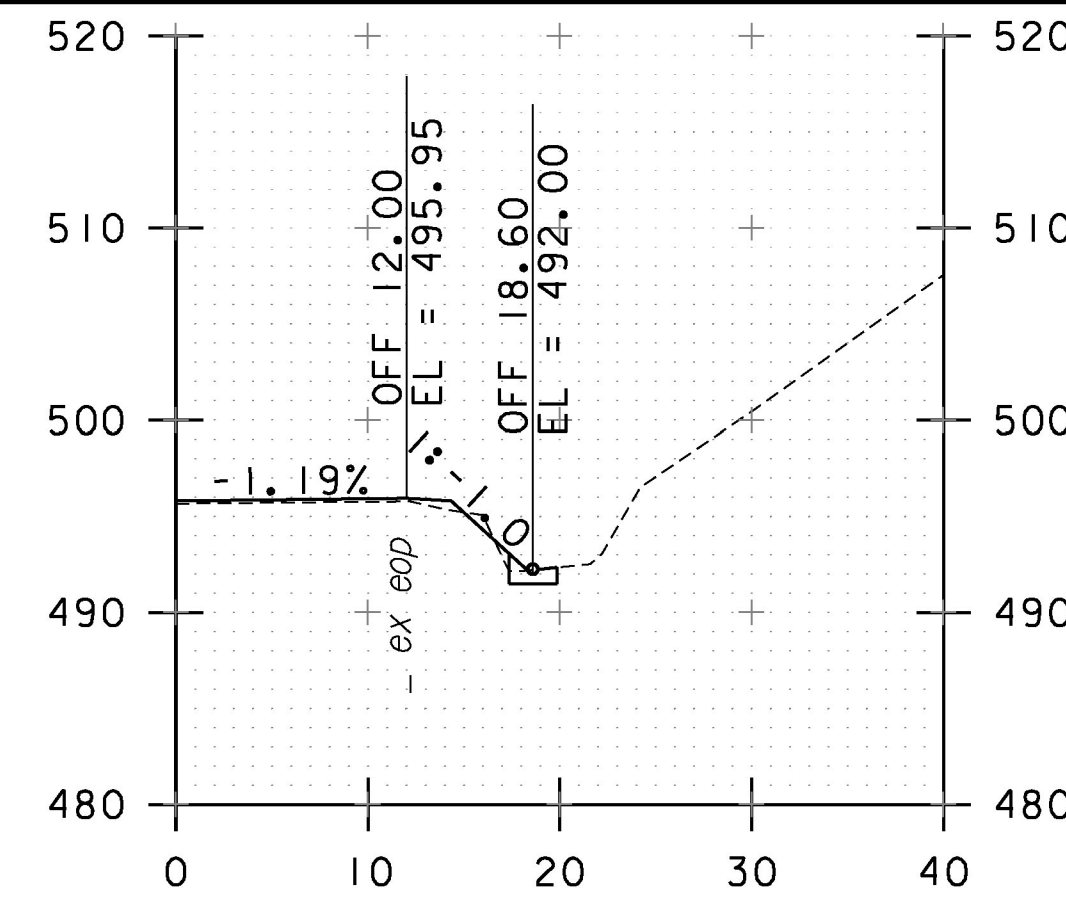


22+00

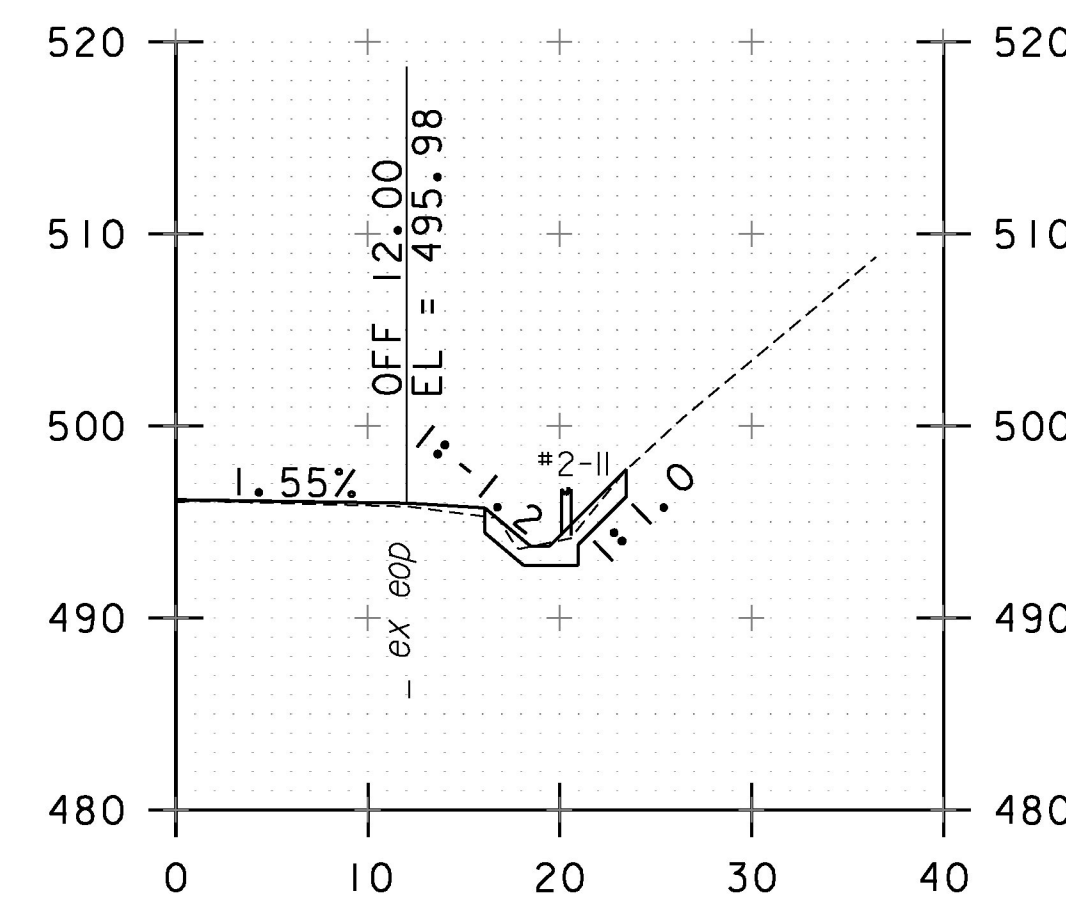


21+50

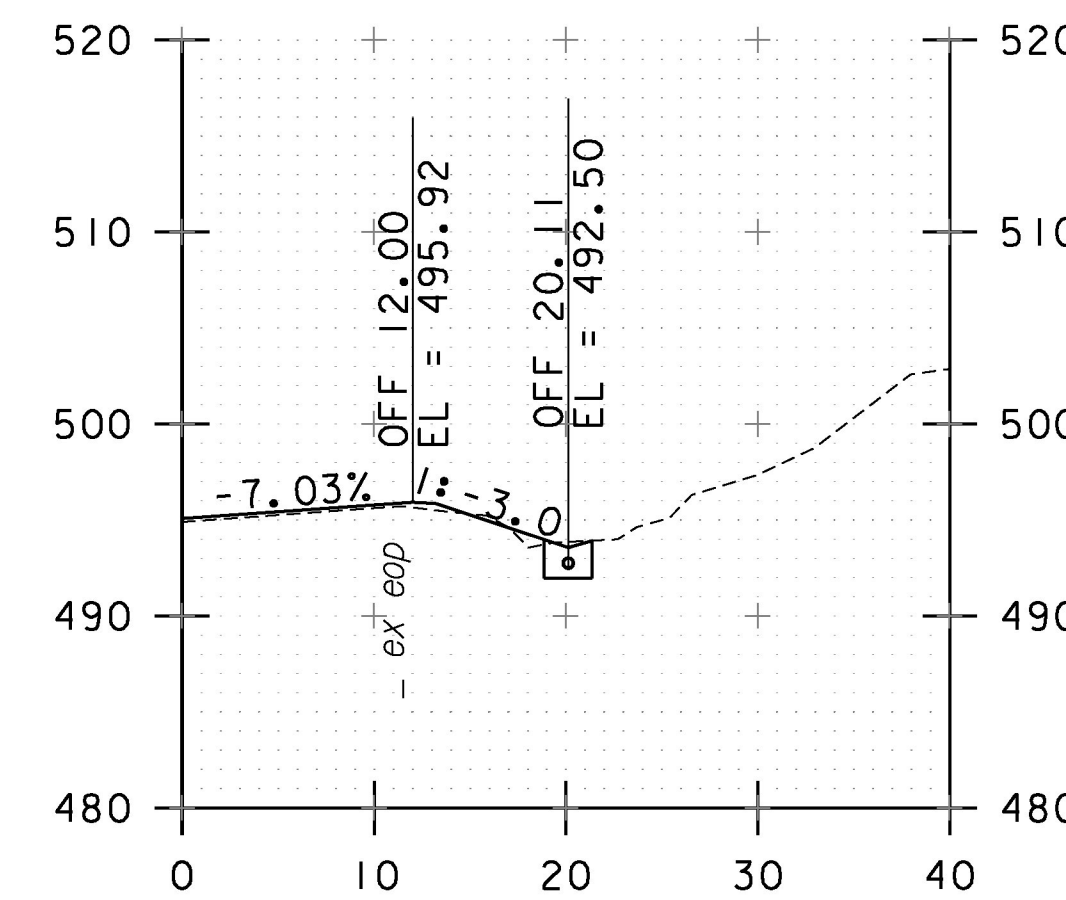


23+00

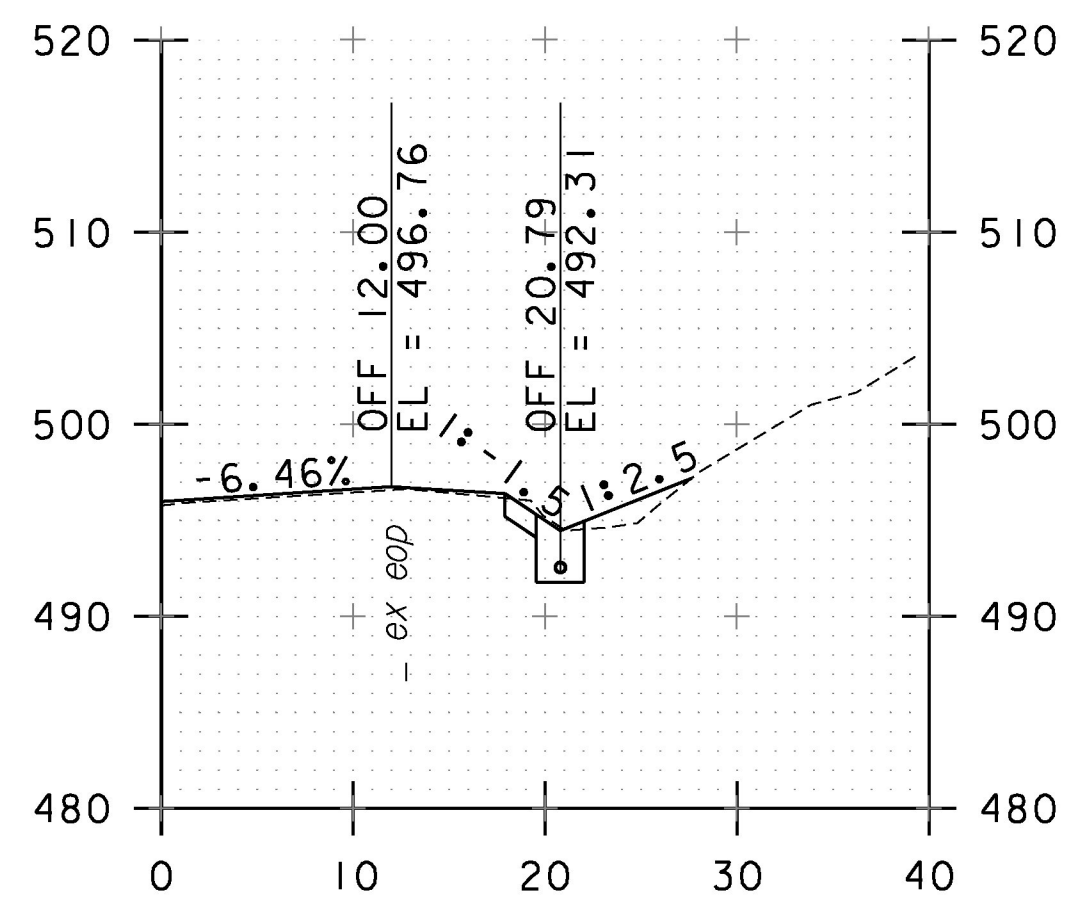


17+00

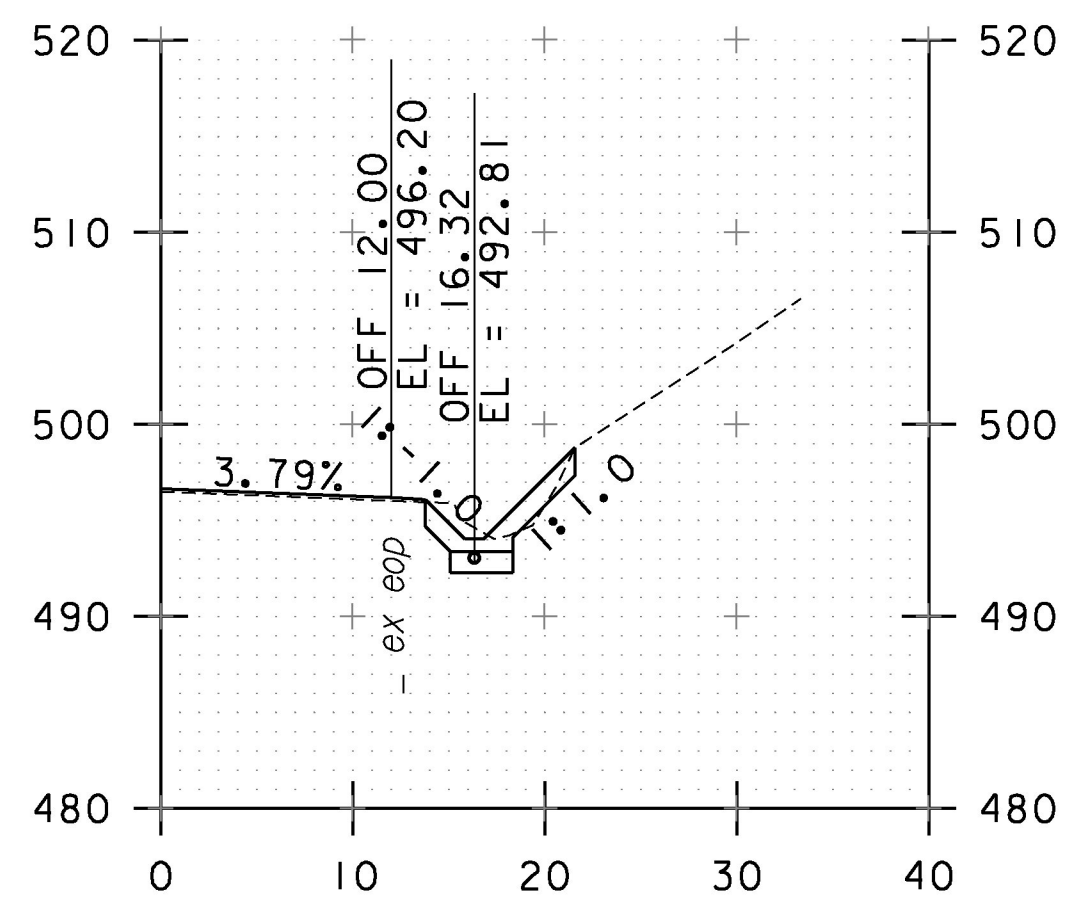


19+00

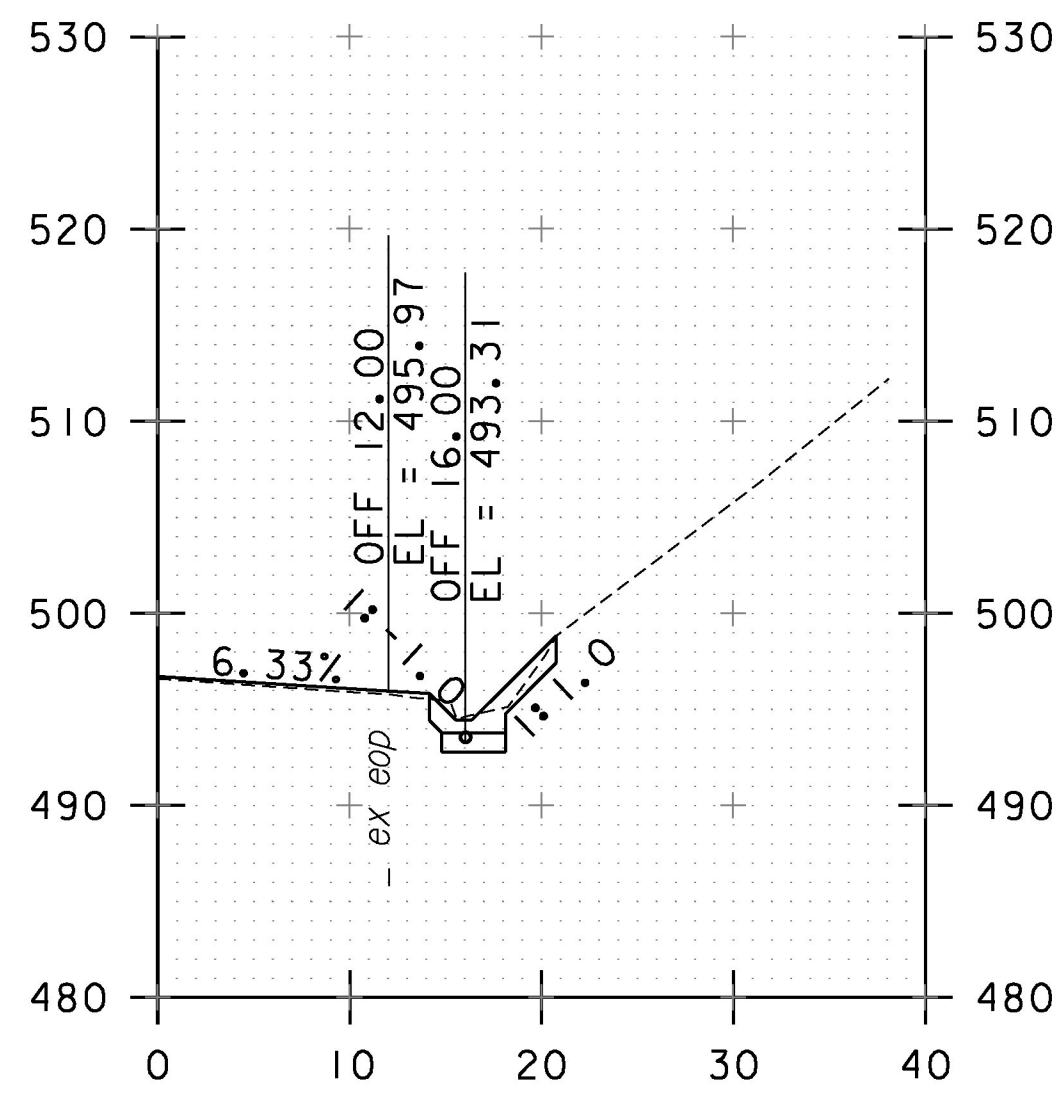

20+00

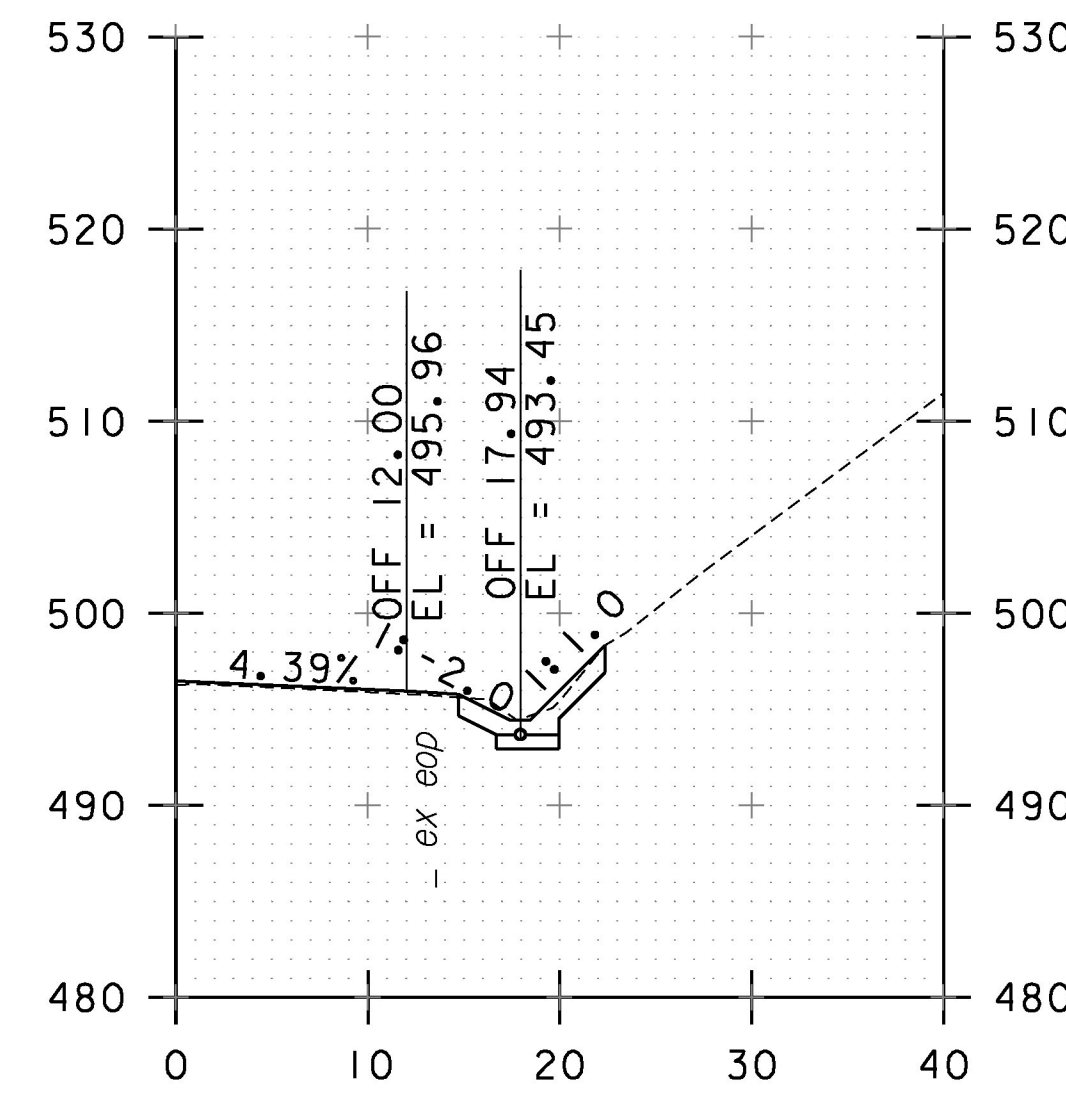

21+00

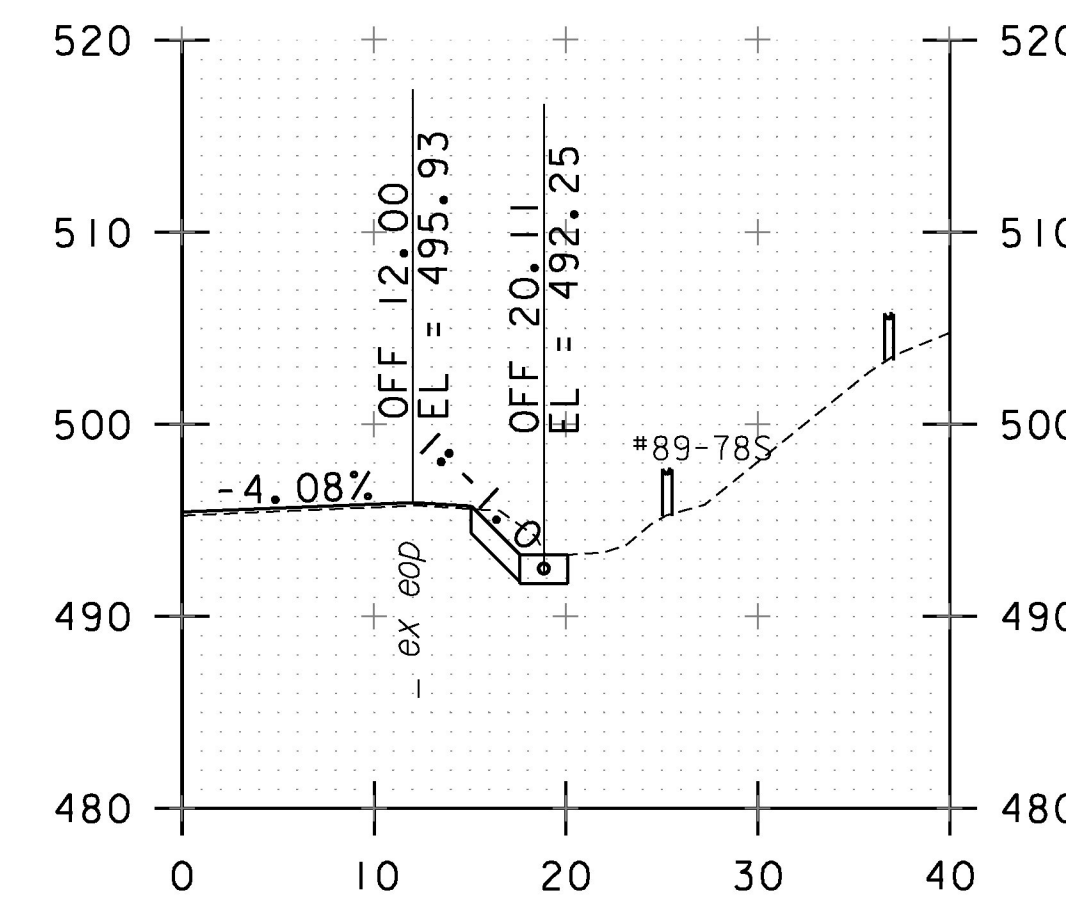

22+50

PROJECT NAME:	RICHFORD	PLOT DATE:	4/2/2018
PROJECT NUMBER:	STP 2916(I)	DRAWN BY:	G. BURGMEIER
FILE NAME:	z10c234xs.dgn	DESIGNED BY:	G. BURGMEIER
PROJECT LEADER:	G. EDWARDS	CHECKED BY:	J. LITTLE
UNDERDRAIN CROSS SECTION SHEET 3			SHEET 201 OF 222

