






44+50

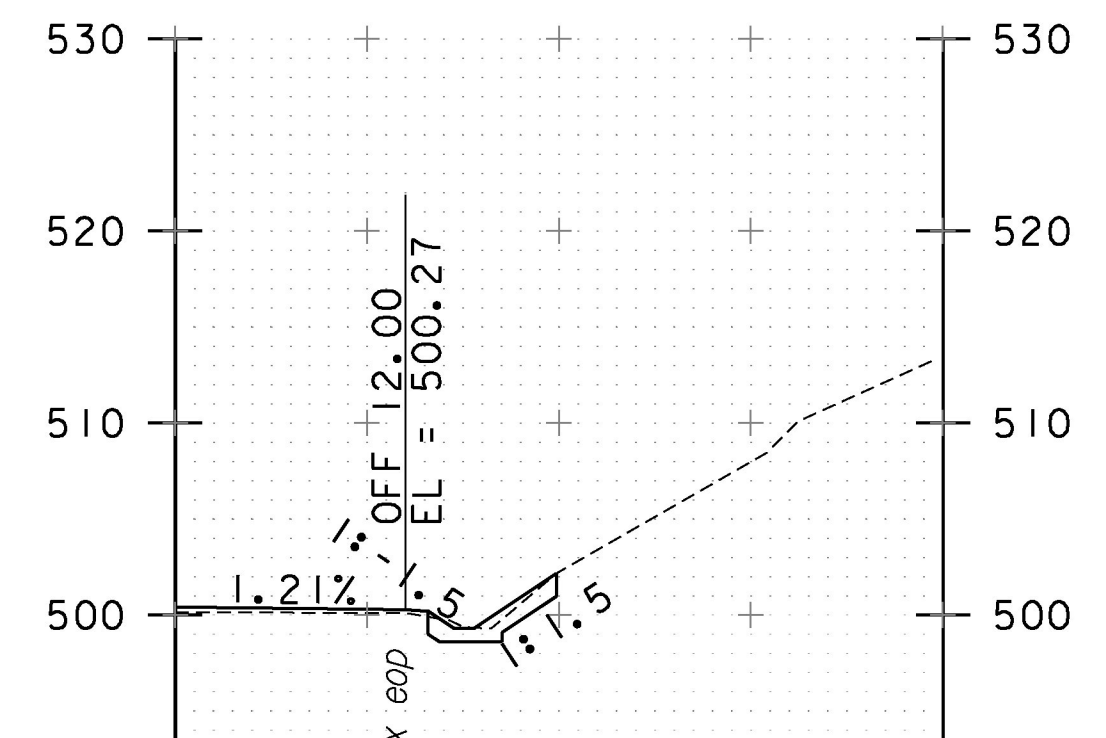


45+00

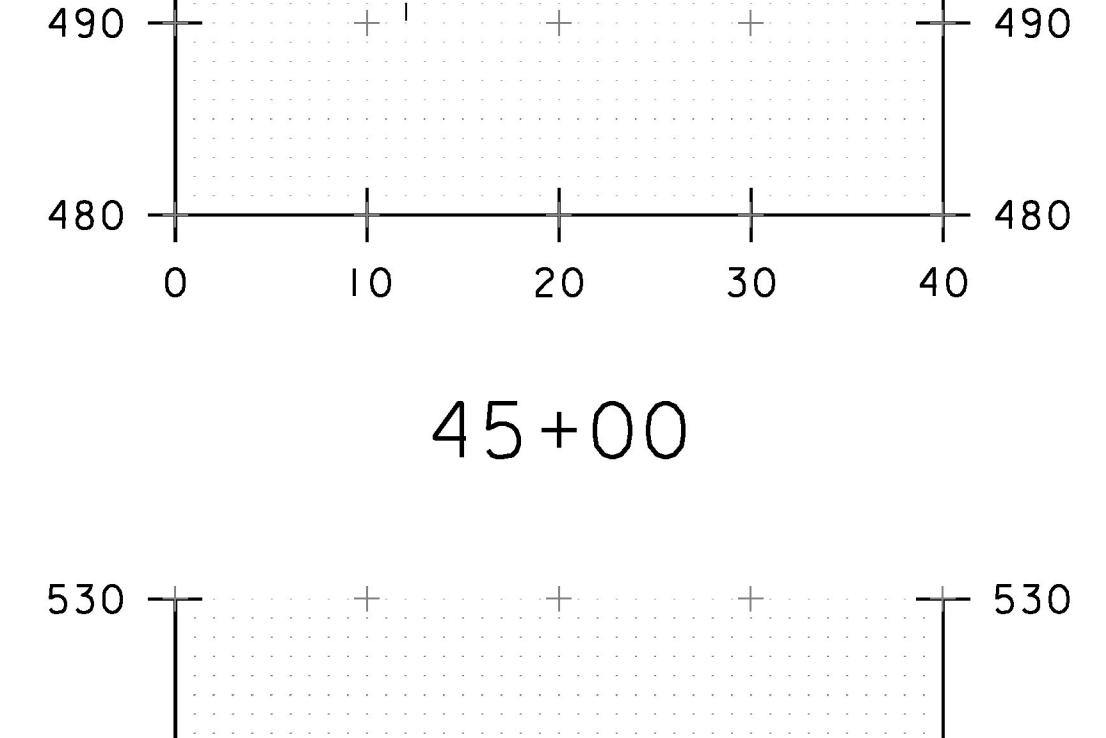


44+50

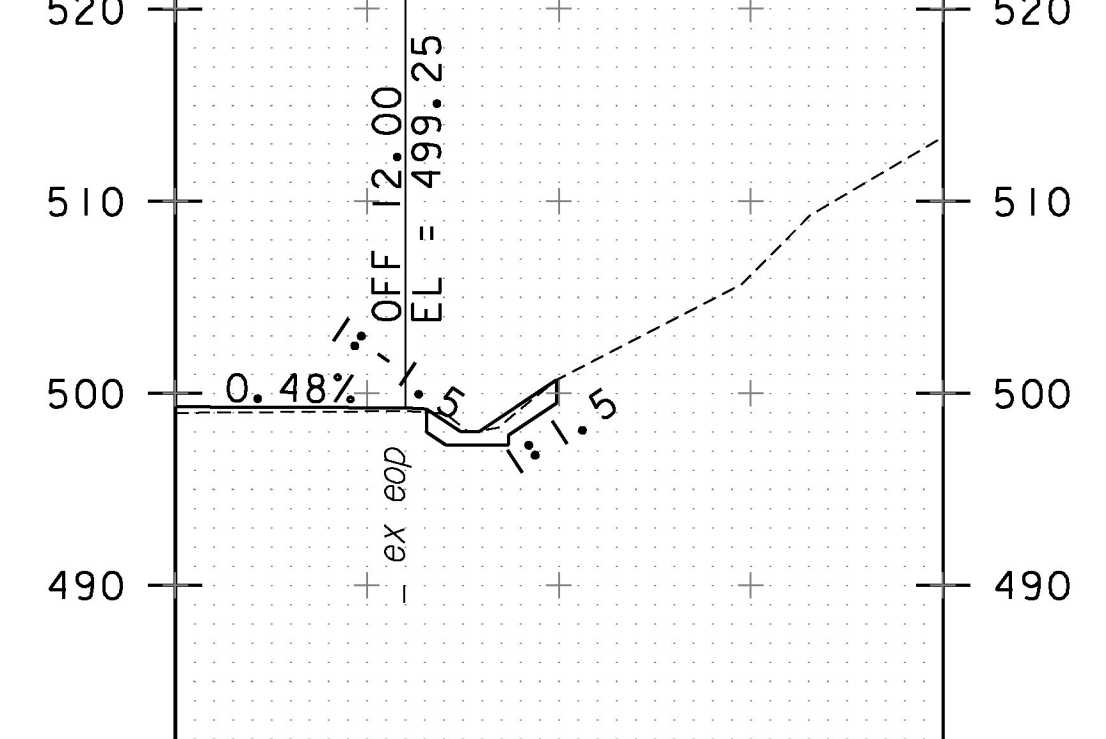


46+00

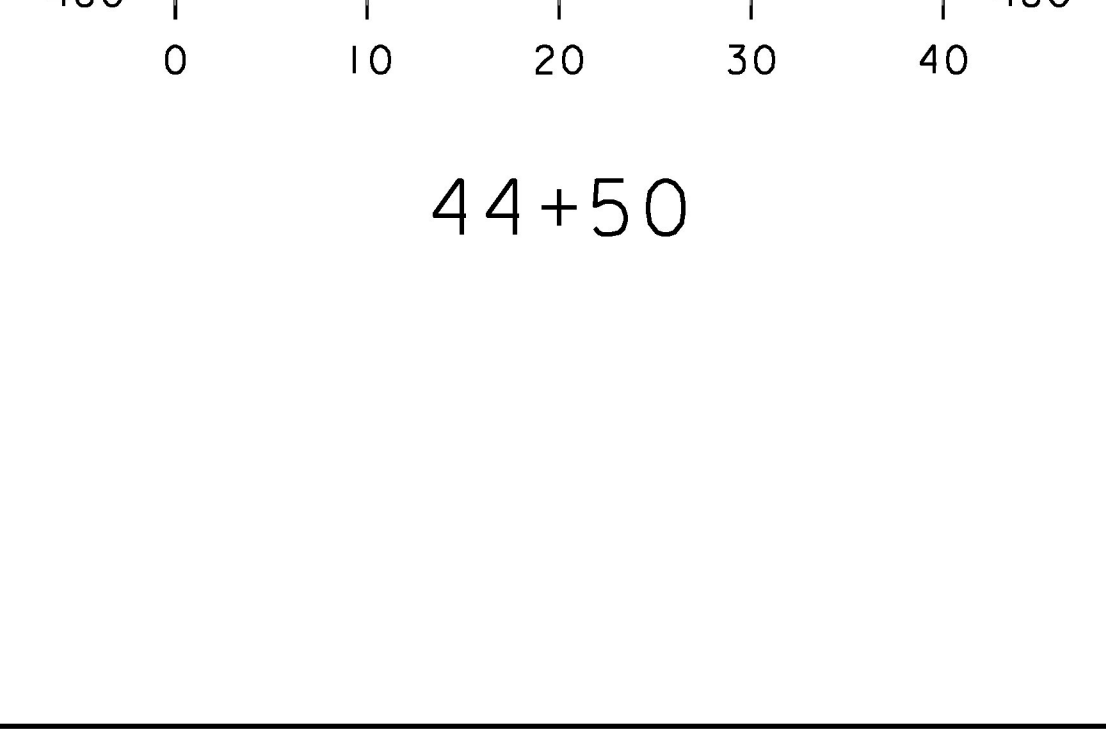


47+50

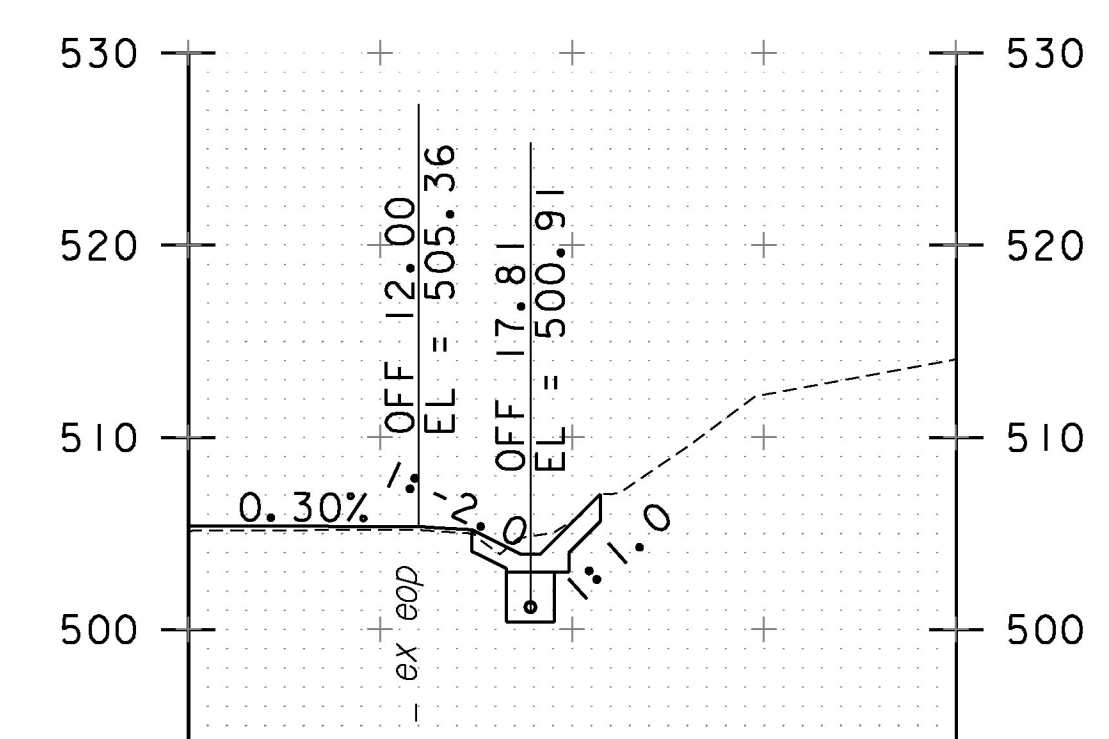


47+00

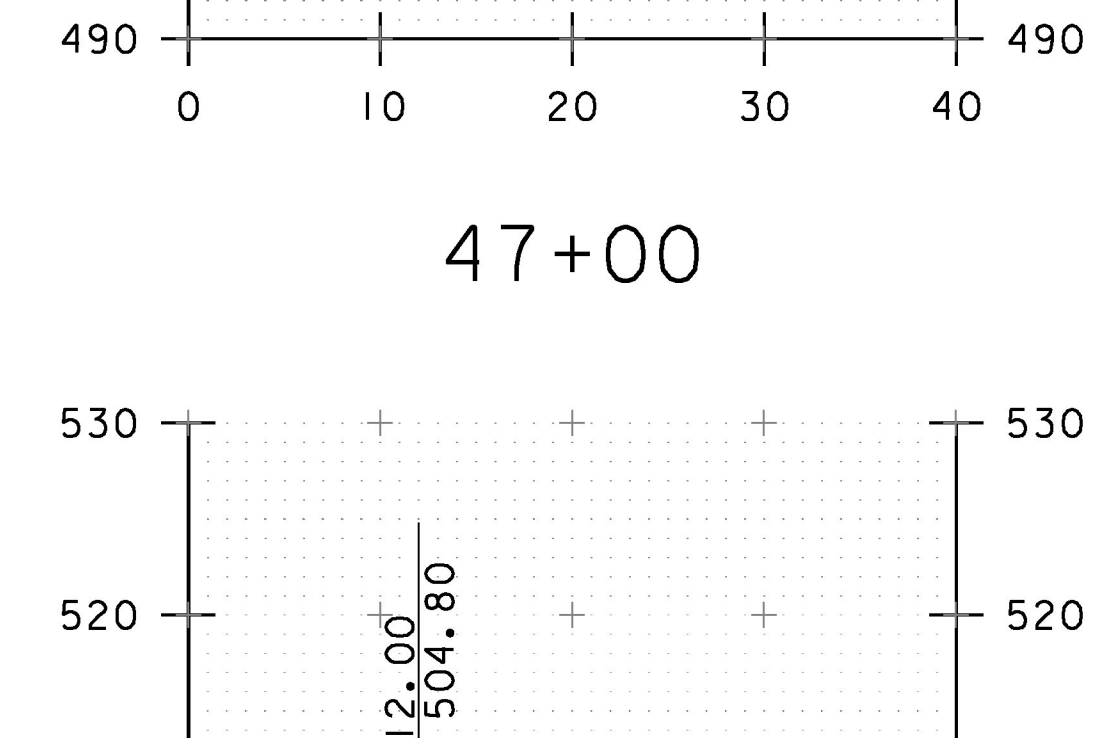


48+50

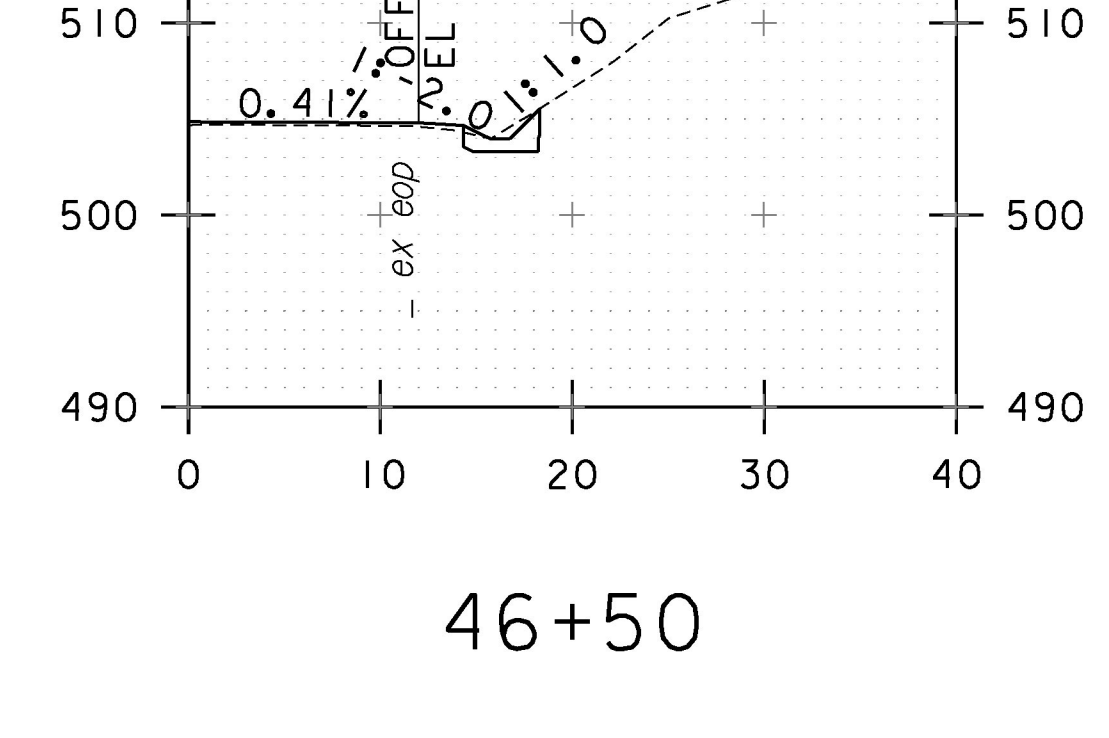


48+00

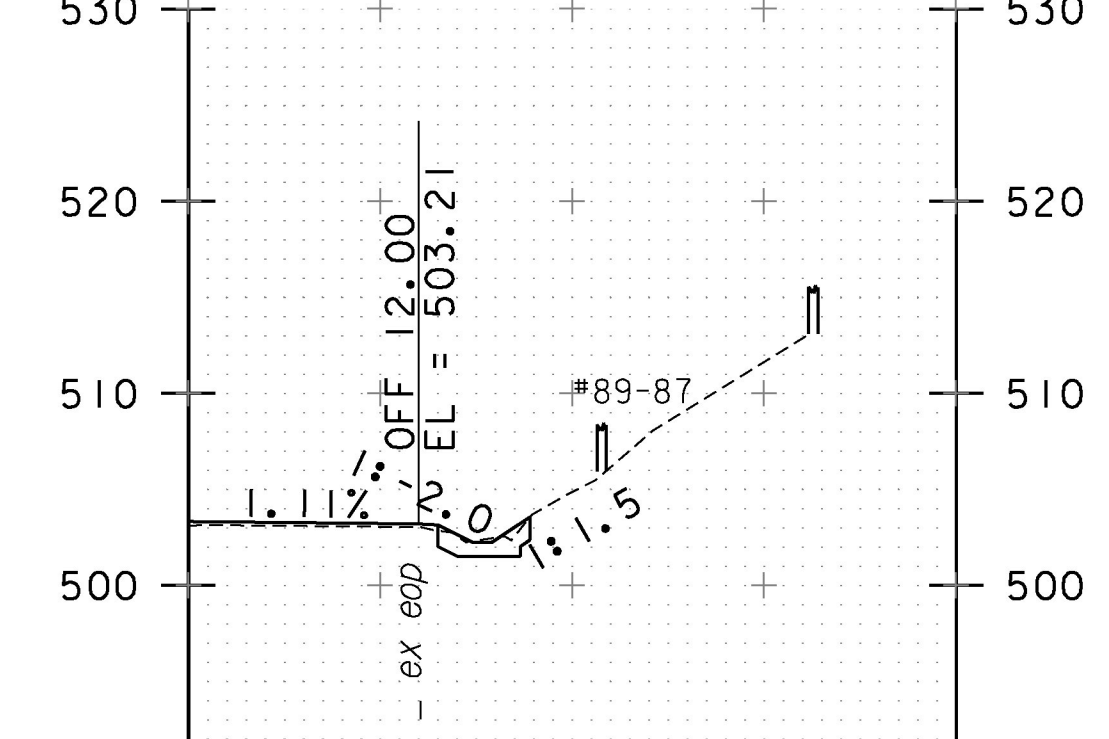


49+00

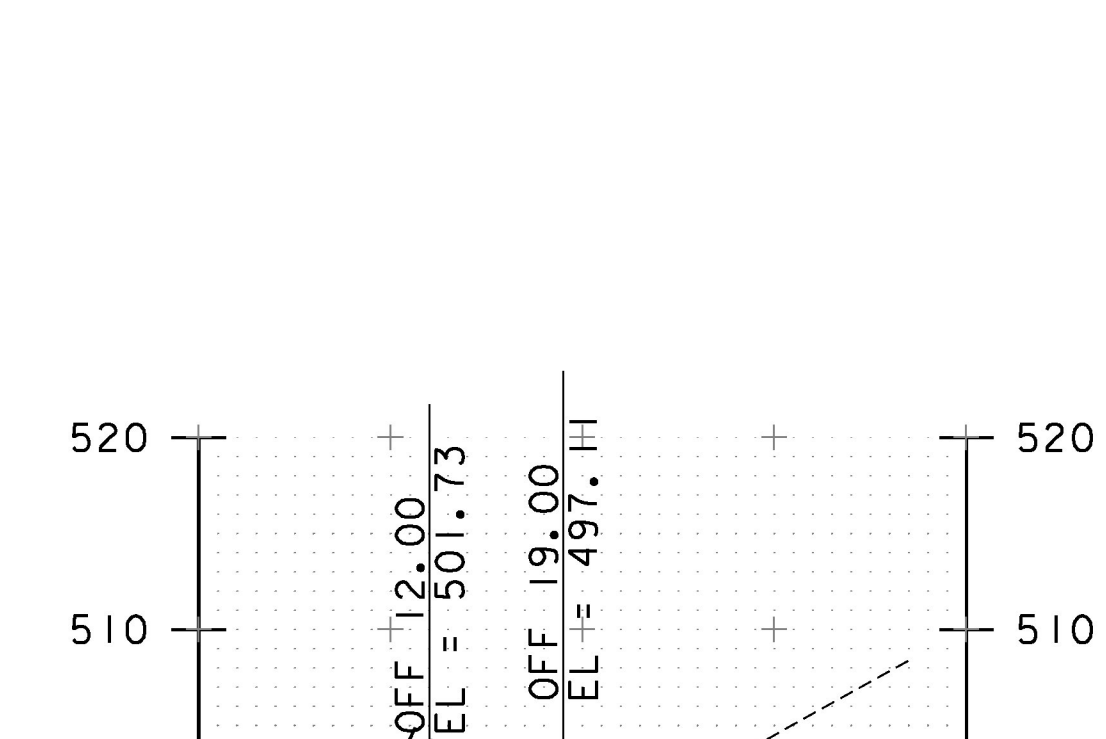


50+00

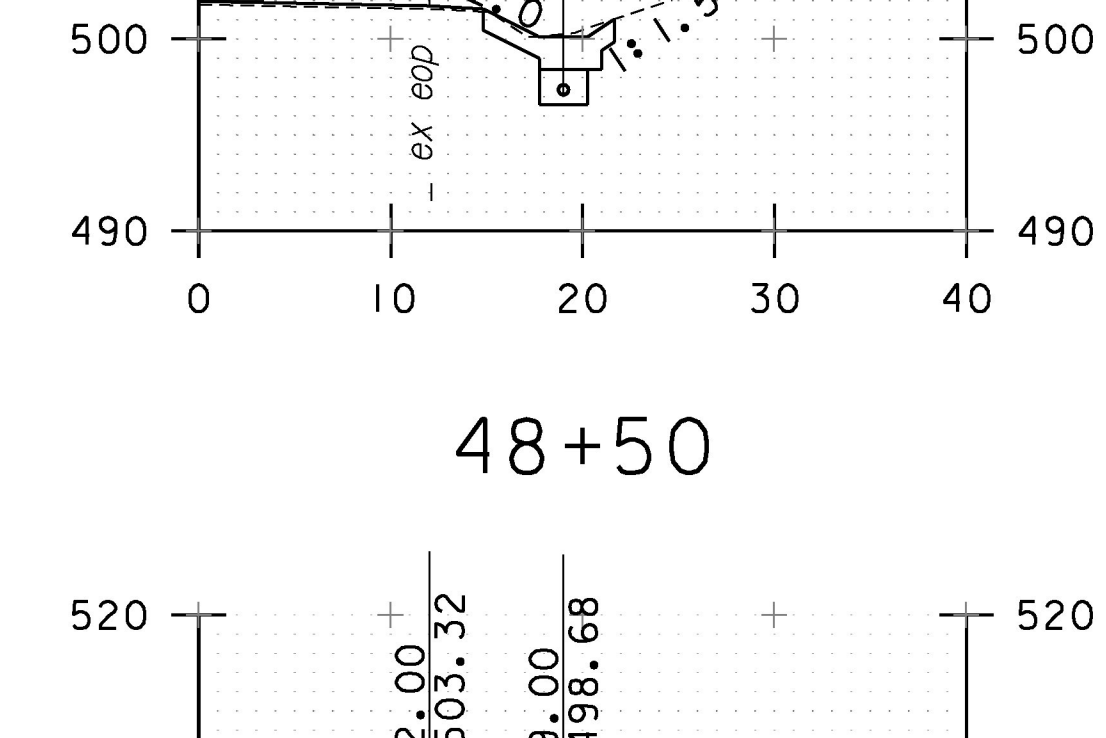

50+50

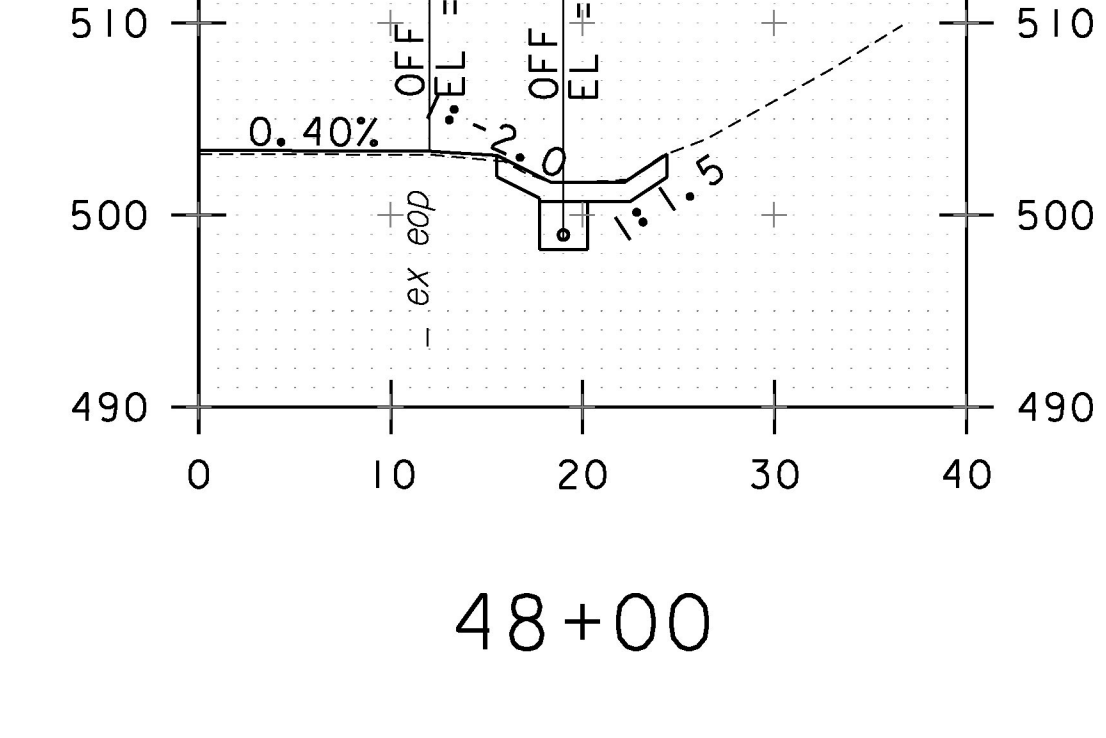

49+50

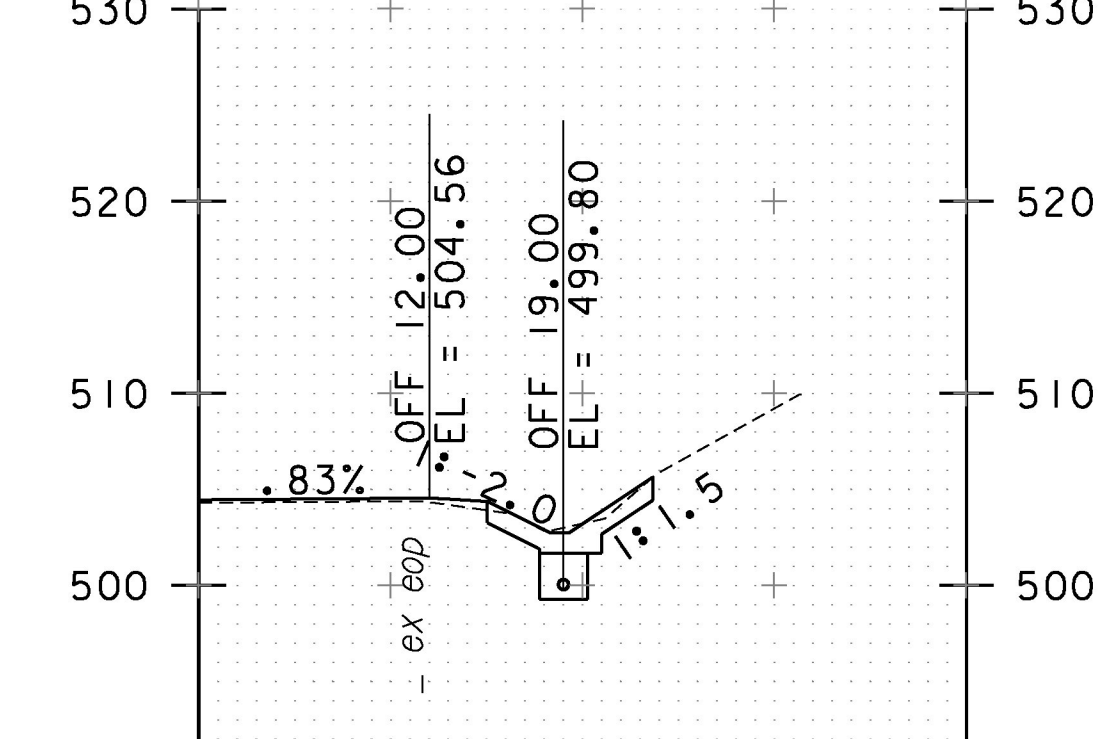

PROJECT NAME: RICHFORD	
PROJECT NUMBER: STP 2916(I)	
FILE NAME: z10c234xs.dgn	PLOT DATE: 4/2/2018
PROJECT LEADER: G. EDWARDS	DRAWN BY: G. BURGMEIER
DESIGNED BY: G. BURGMEIER	CHECKED BY: J. LITTLE
UNDERDRAIN CROSS SECTION SHEET 6	SHEET 204 OF 222

