




53+00

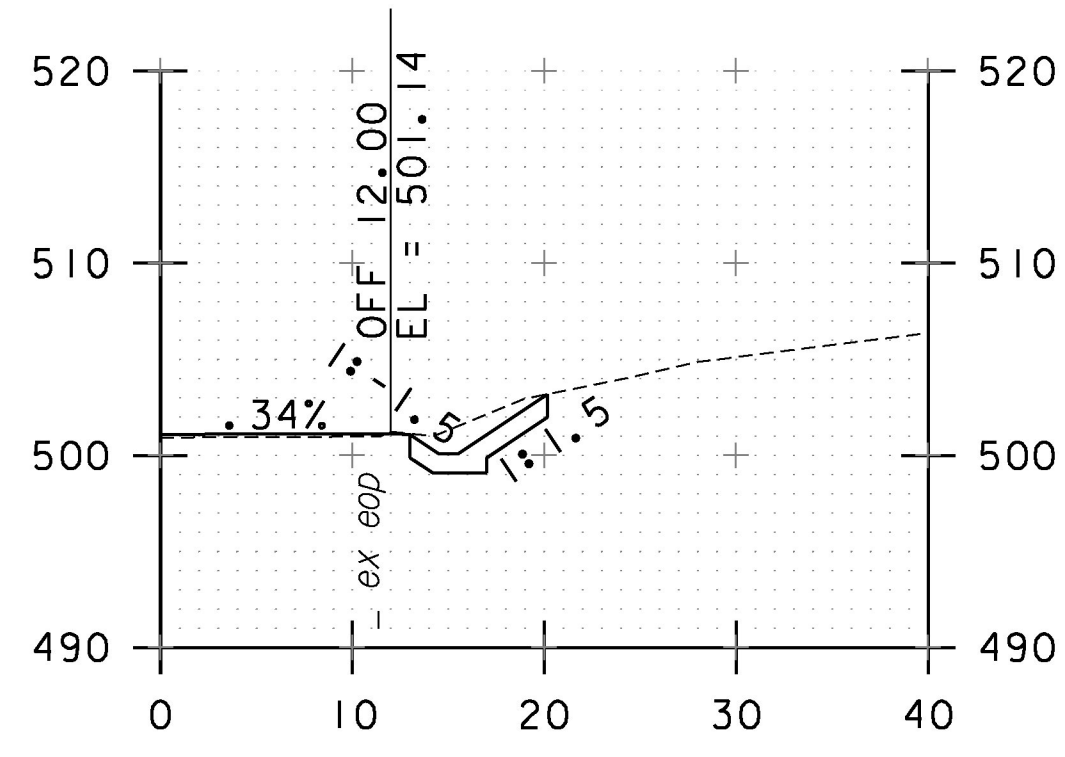


54+50

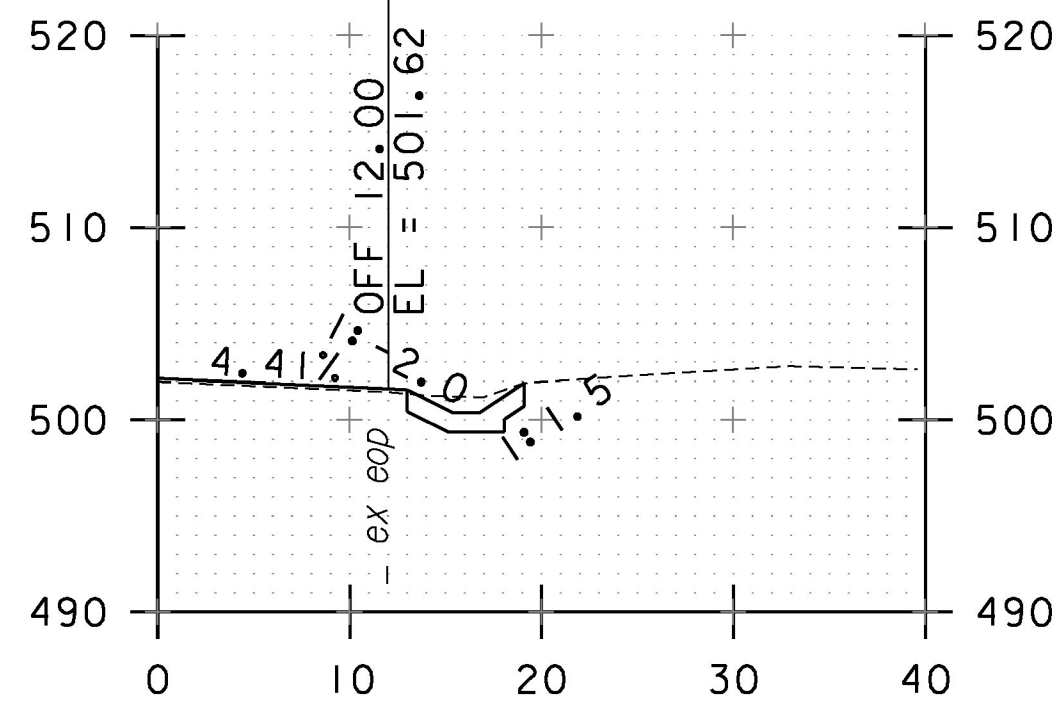


56+00

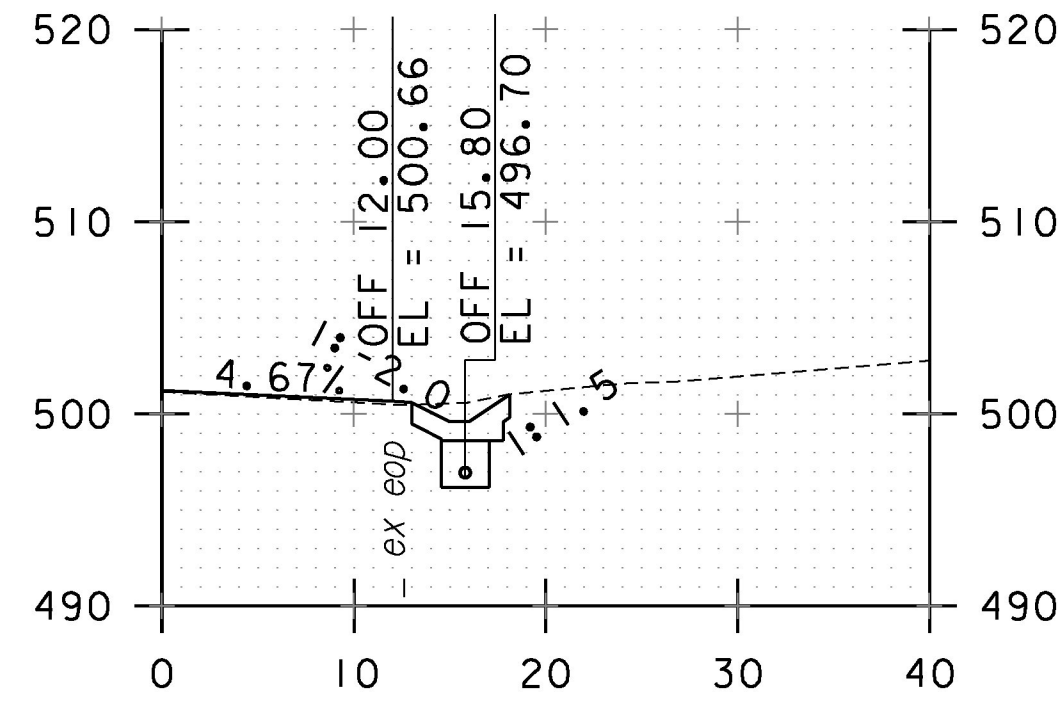


57+50

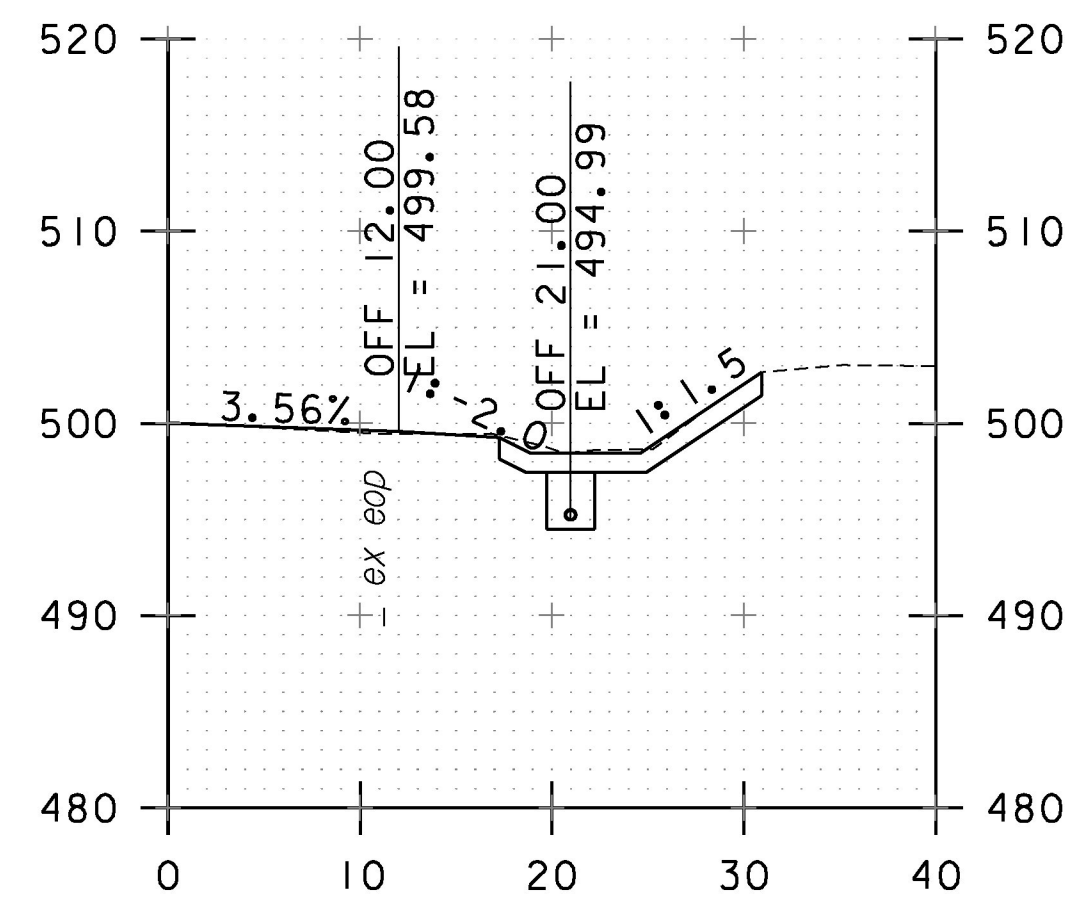


59+00

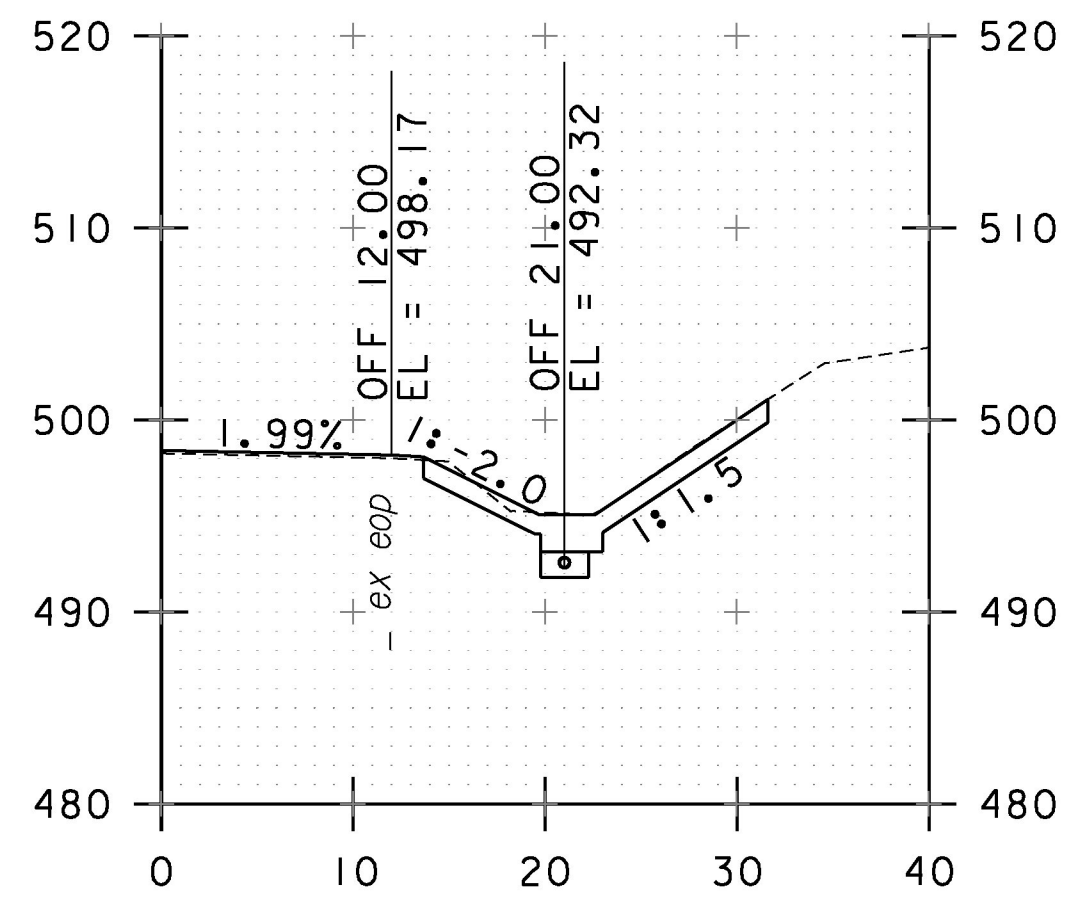


52+50

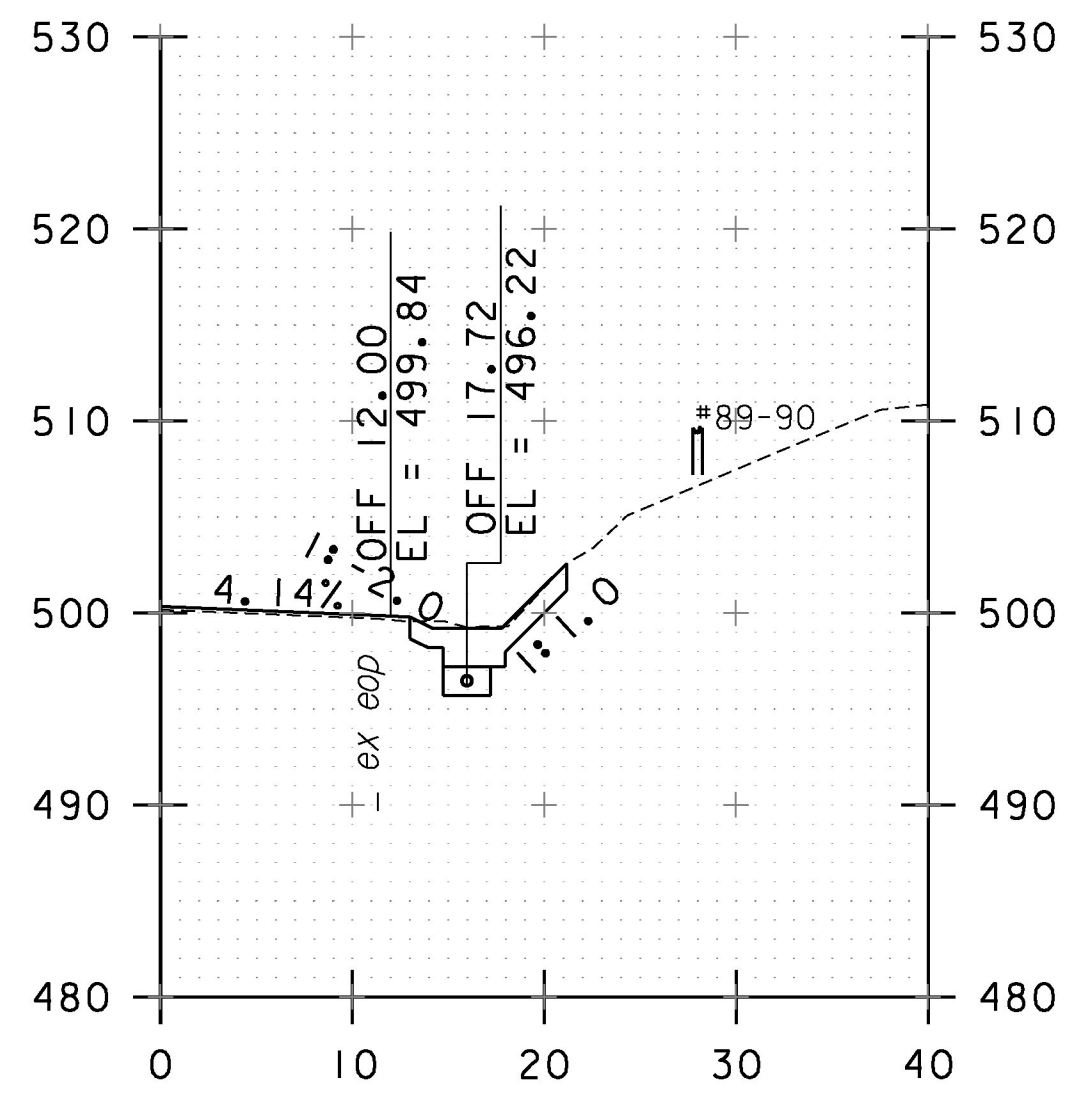


54+00

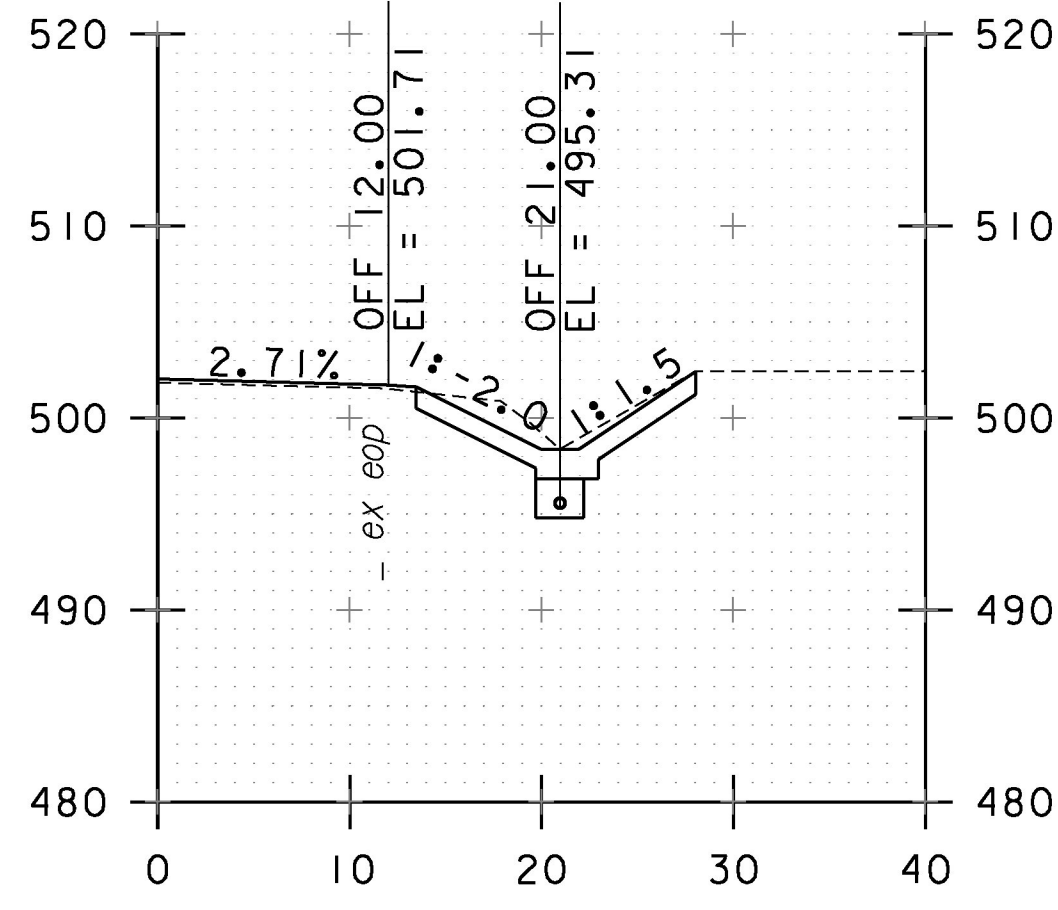


55+50

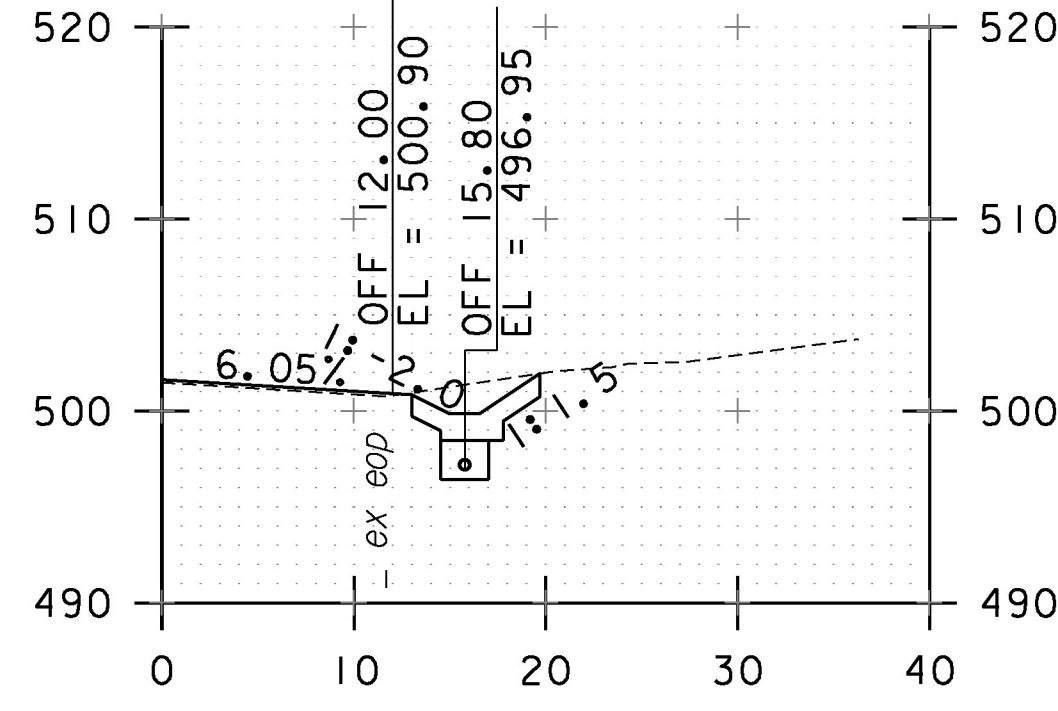


57+00

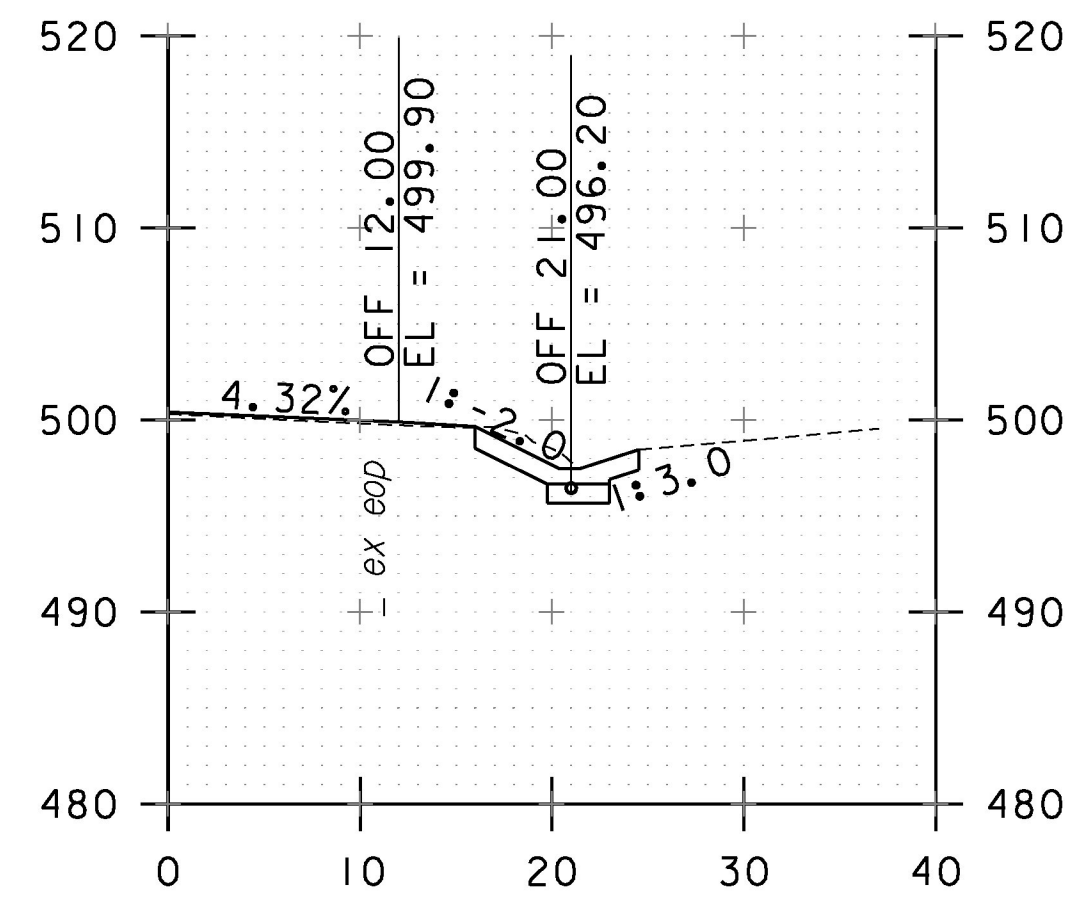


58+50

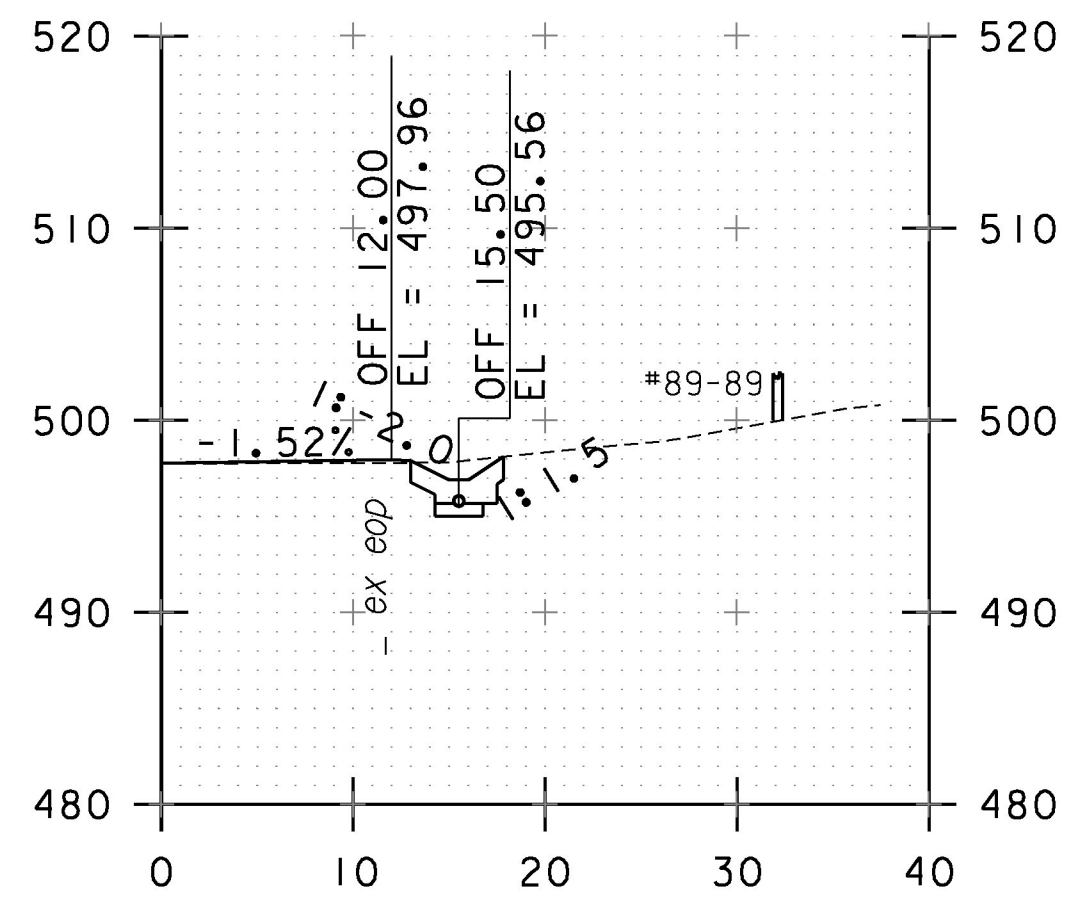


52+00

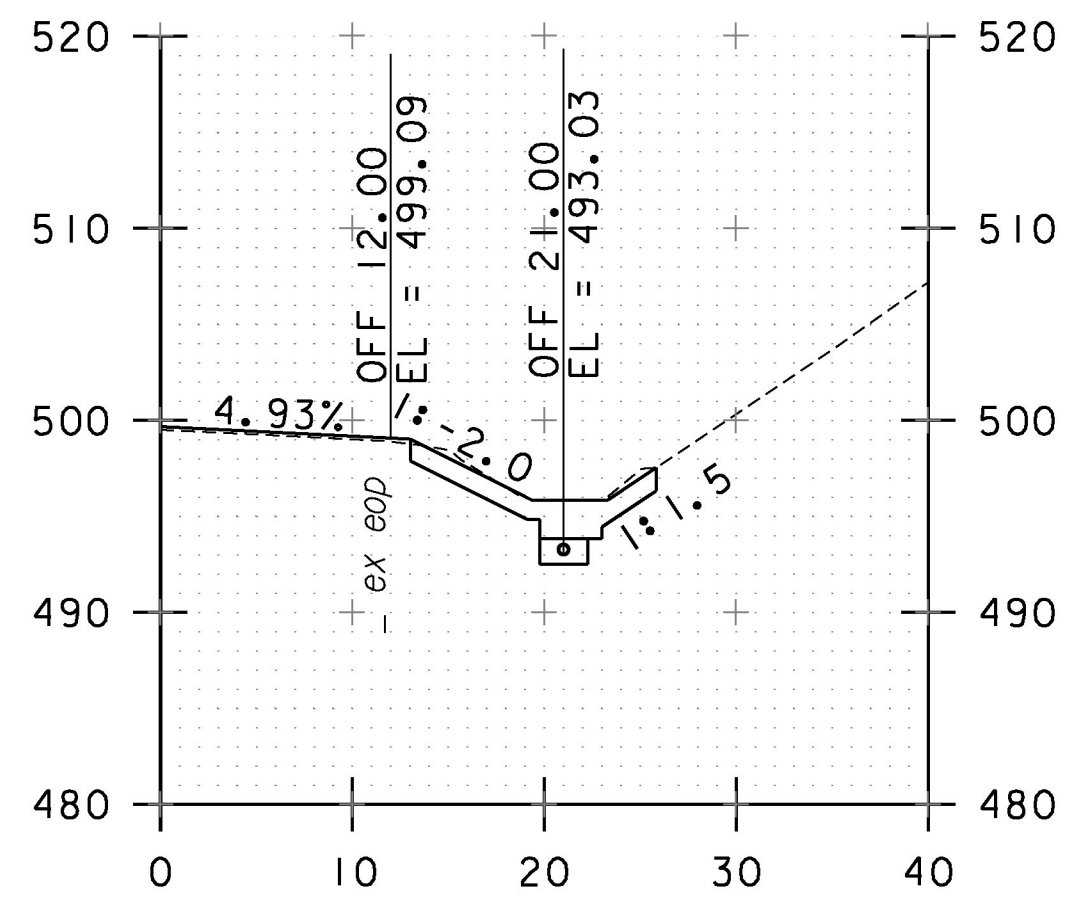


53+50

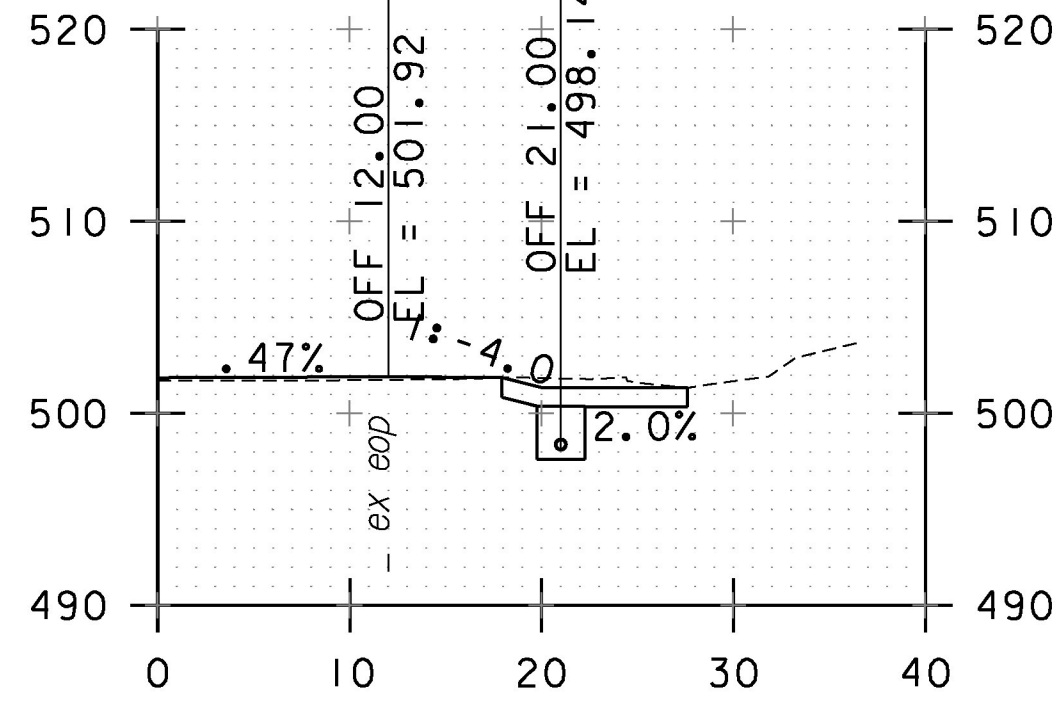

55+00

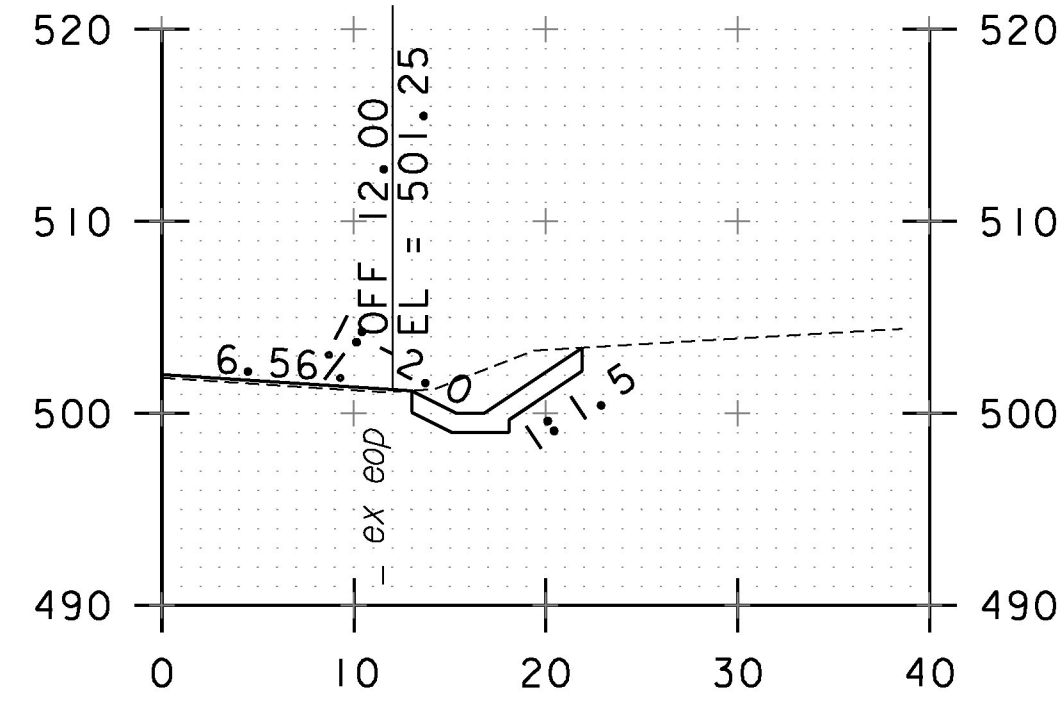

56+50

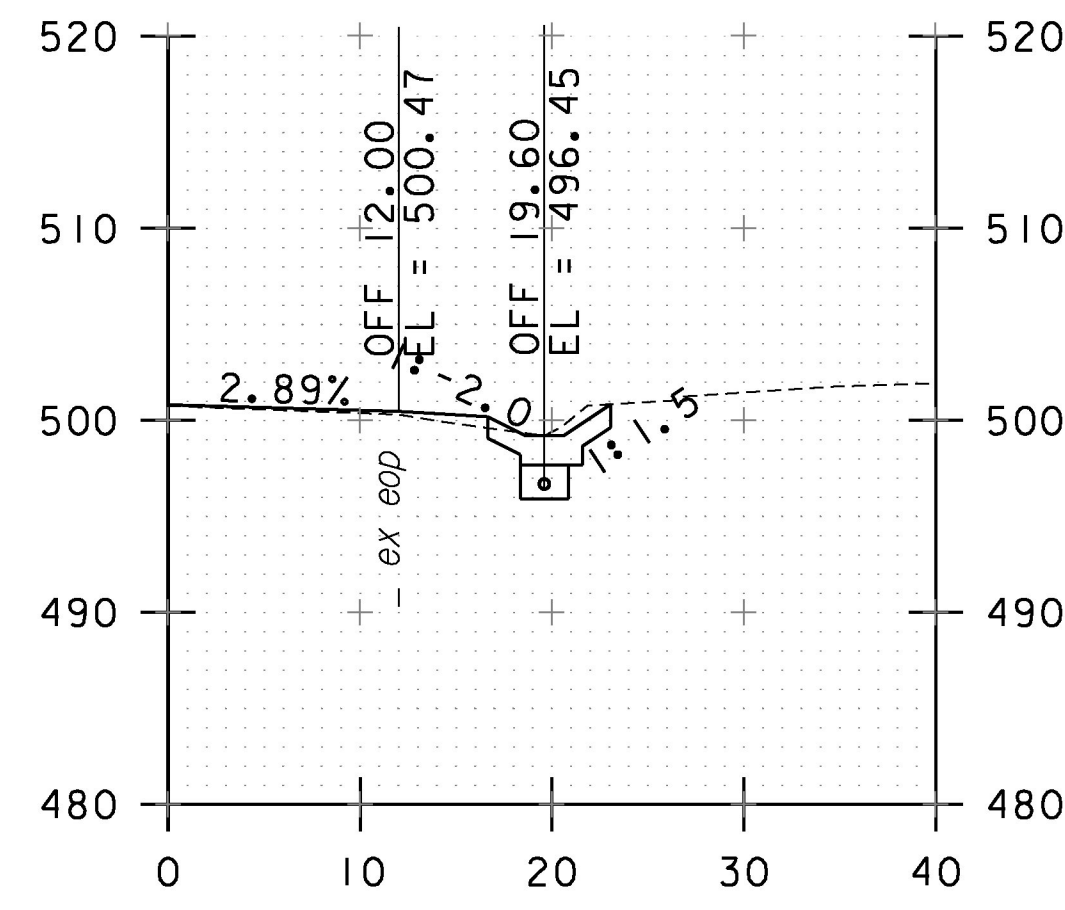

58+00

|                                  |               |
|----------------------------------|---------------|
| PROJECT NAME:                    | RICHFORD      |
| PROJECT NUMBER:                  | STP 2916(I)   |
| FILE NAME:                       | z10c234xs.dgn |
| PROJECT LEADER:                  | G. EDWARDS    |
| DESIGNED BY:                     | G. BURGMEIER  |
| UNDERDRAIN CROSS SECTION SHEET 7 |               |
| PLOT DATE:                       | 4/2/2018      |
| DRAWN BY:                        | G. BURGMEIER  |
| CHECKED BY:                      | J. LITTLE     |
| SHEET                            | 205 OF 222    |

