




60+50

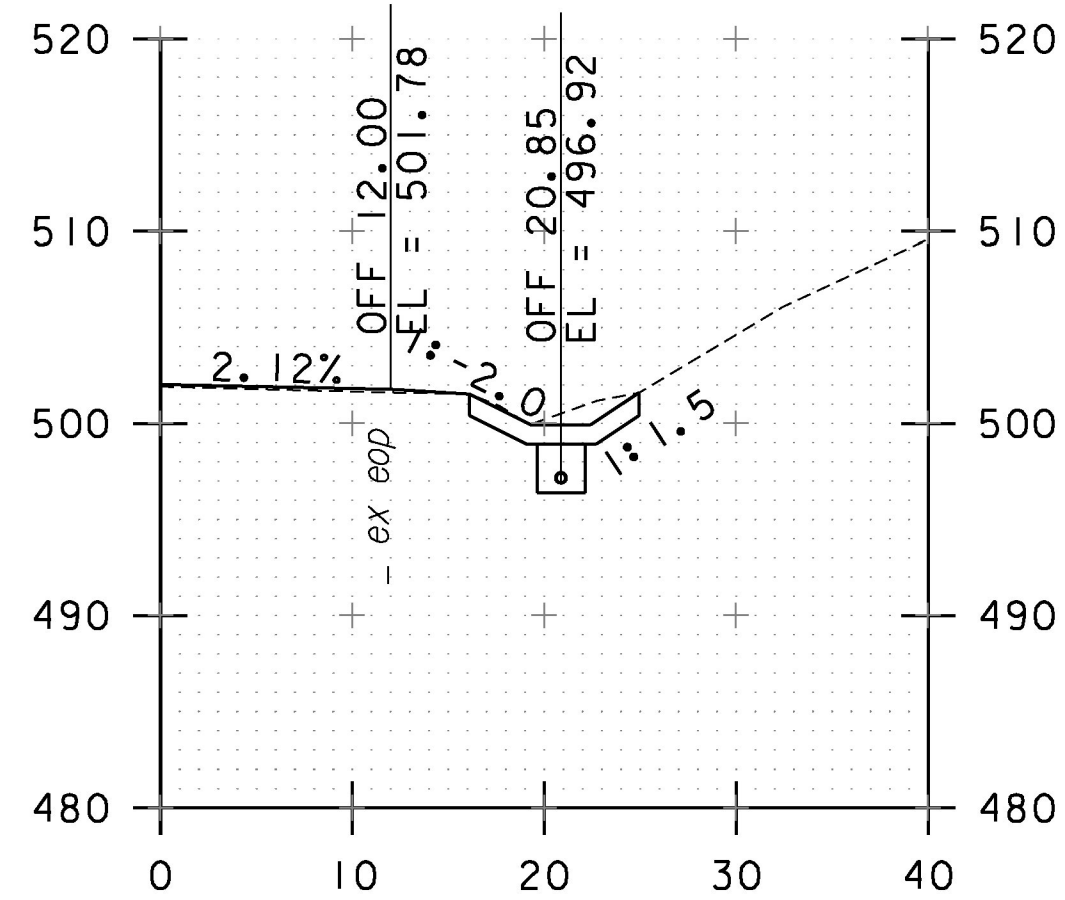


62+00

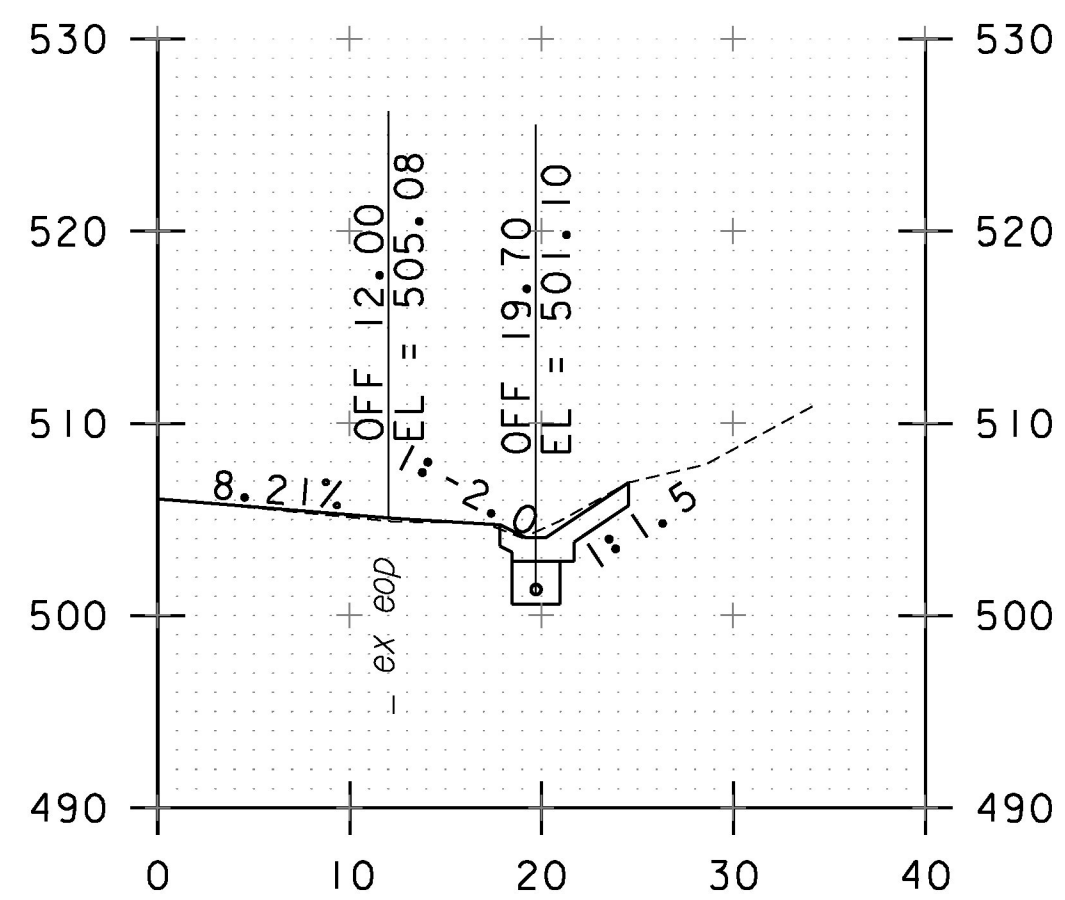


63+50

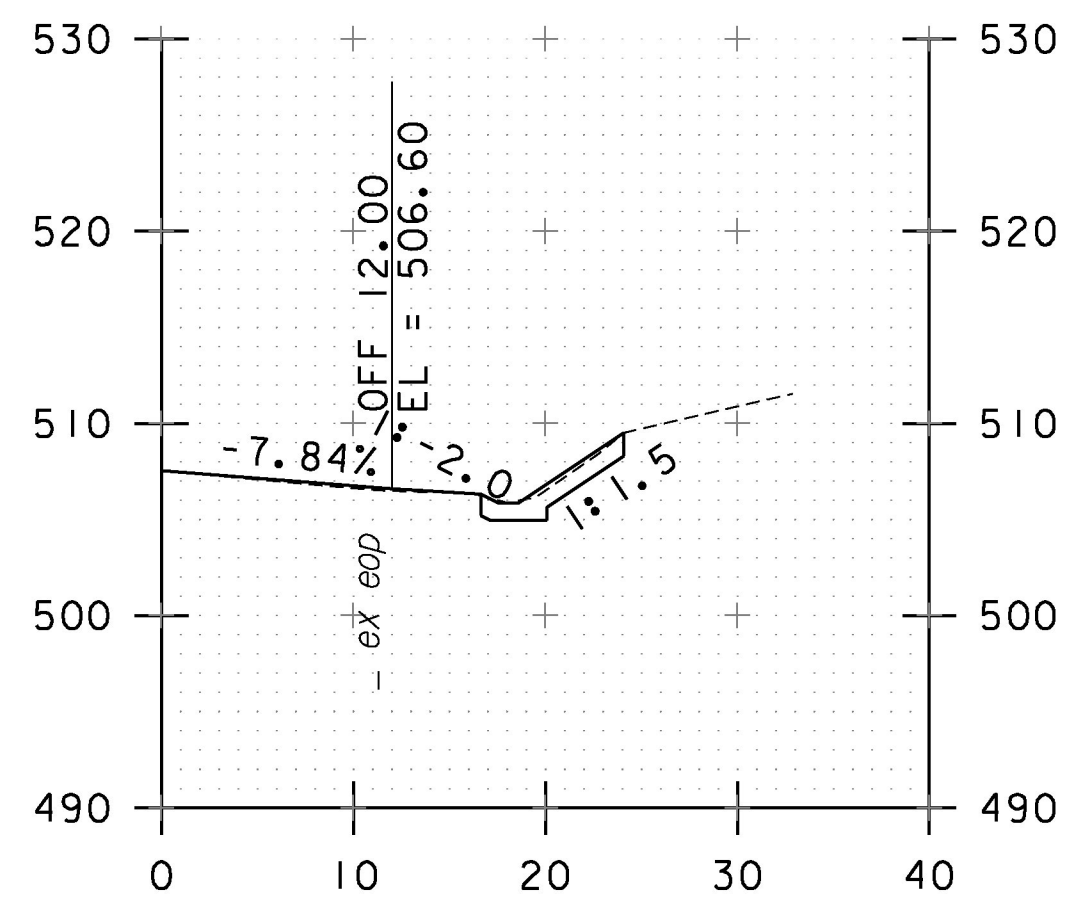


65+00

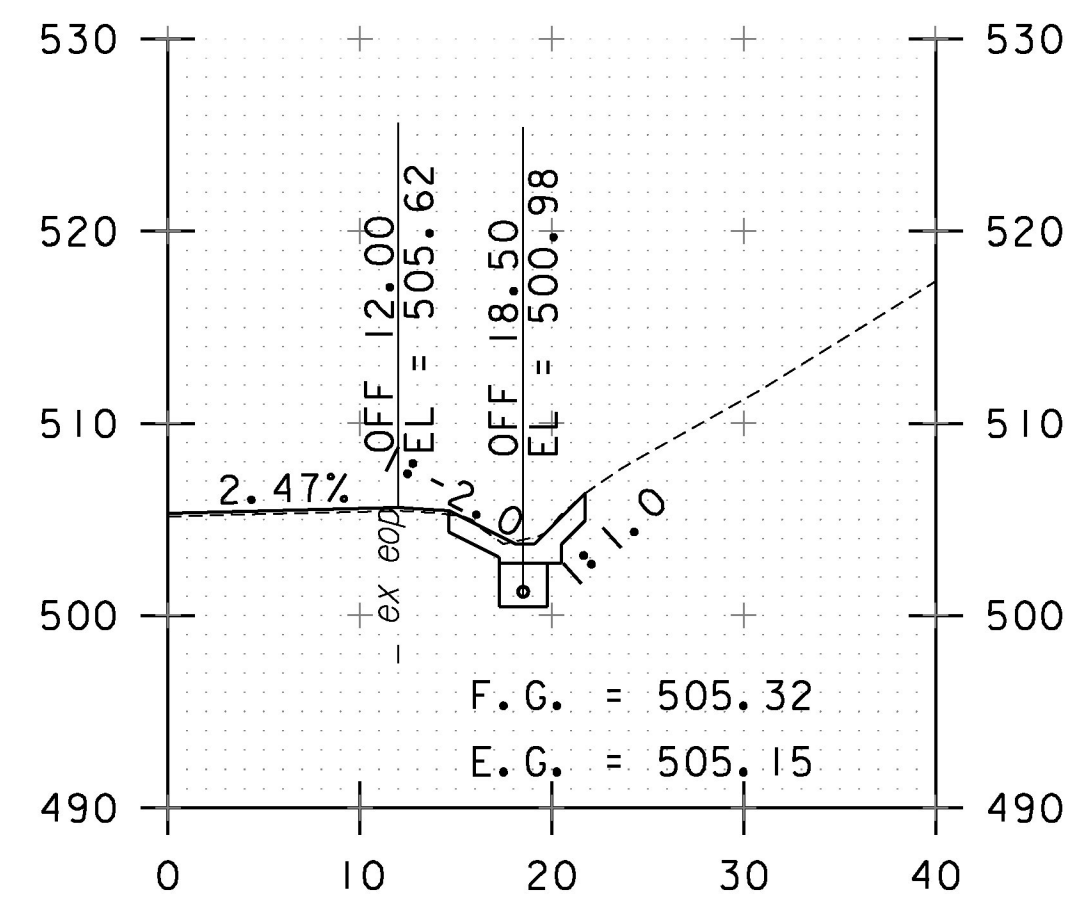


69+50

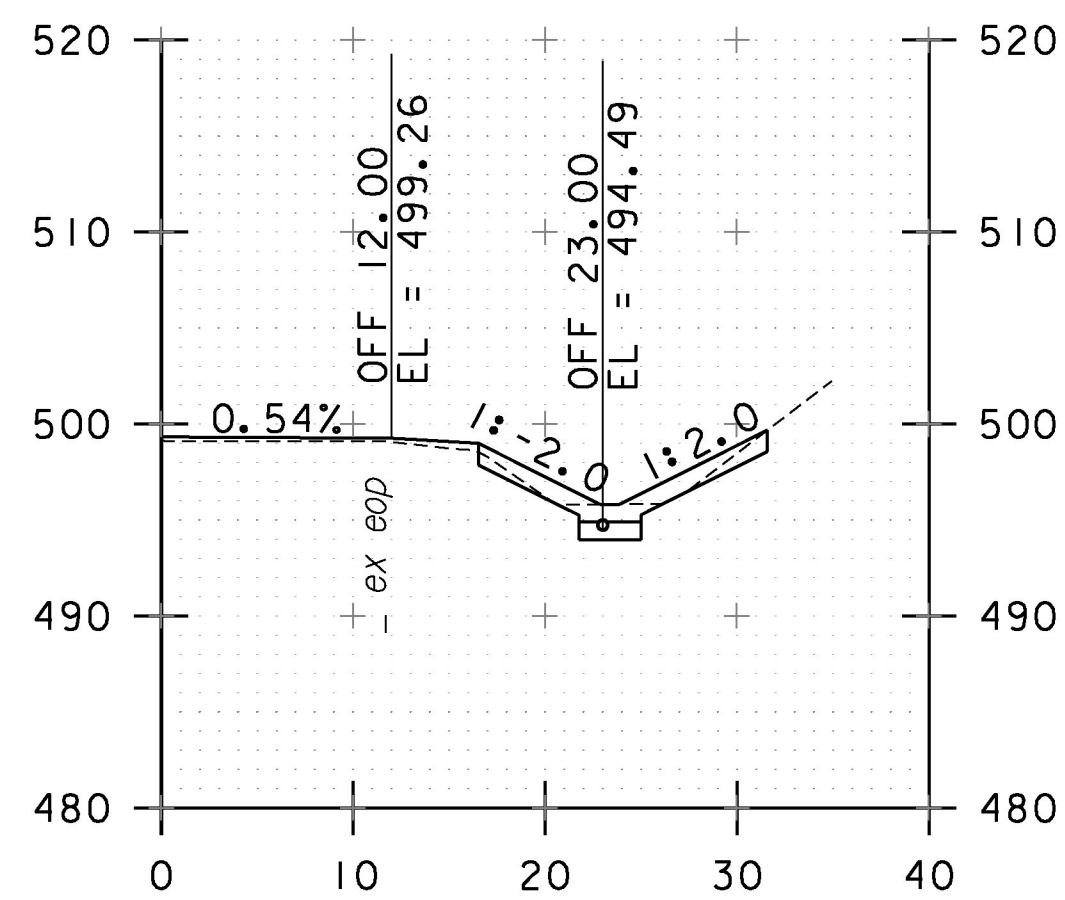


60+00

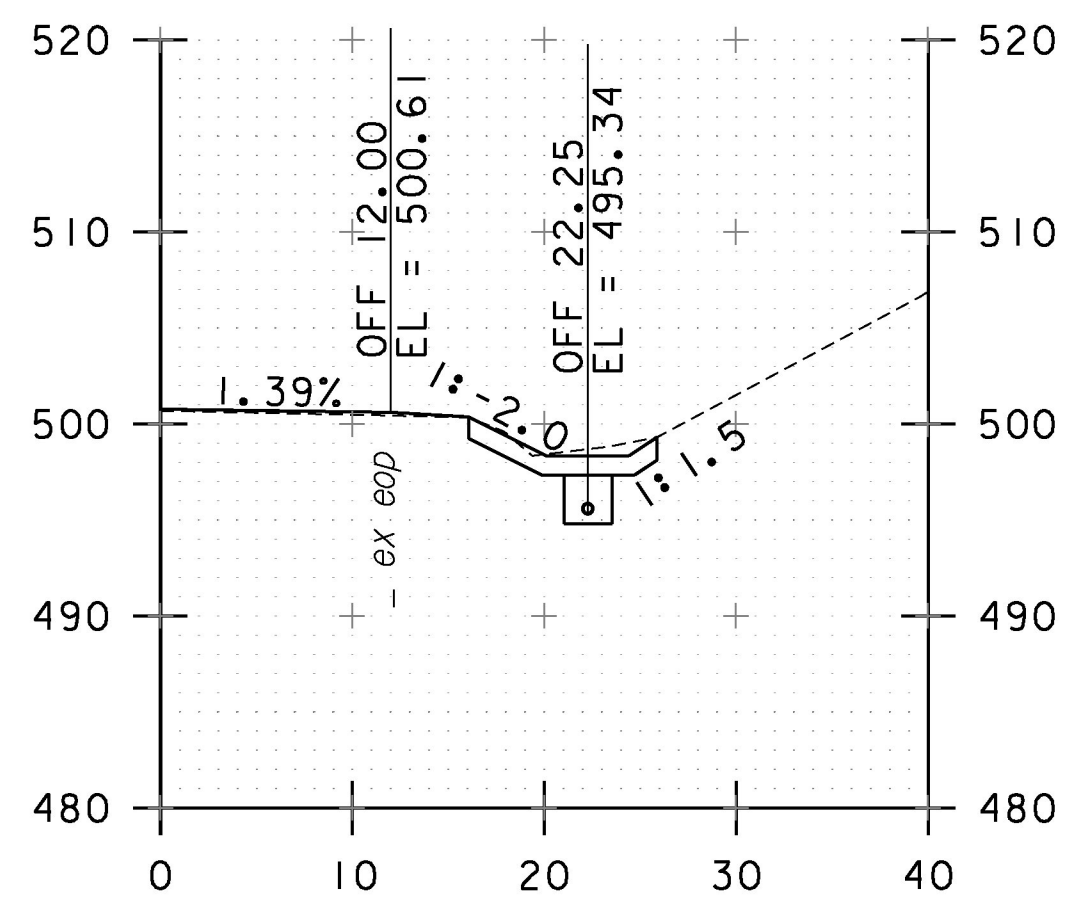


61+50

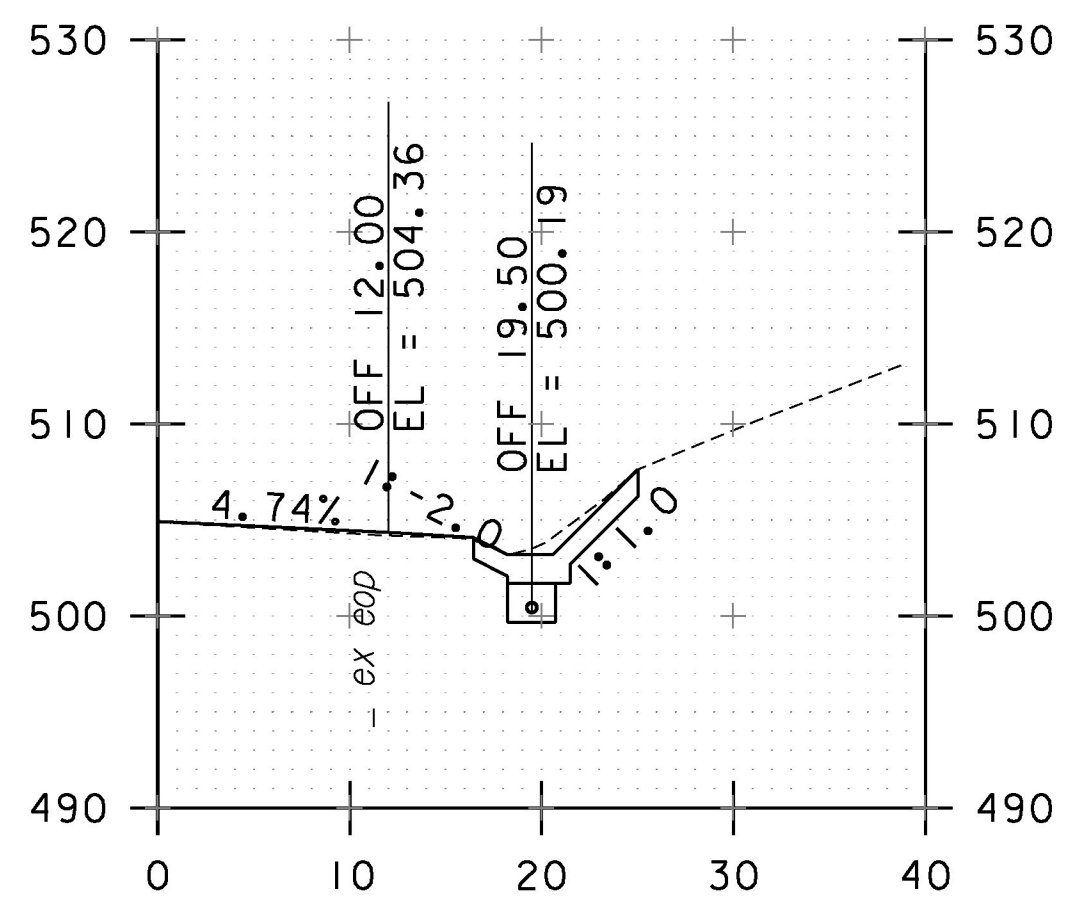


63+00

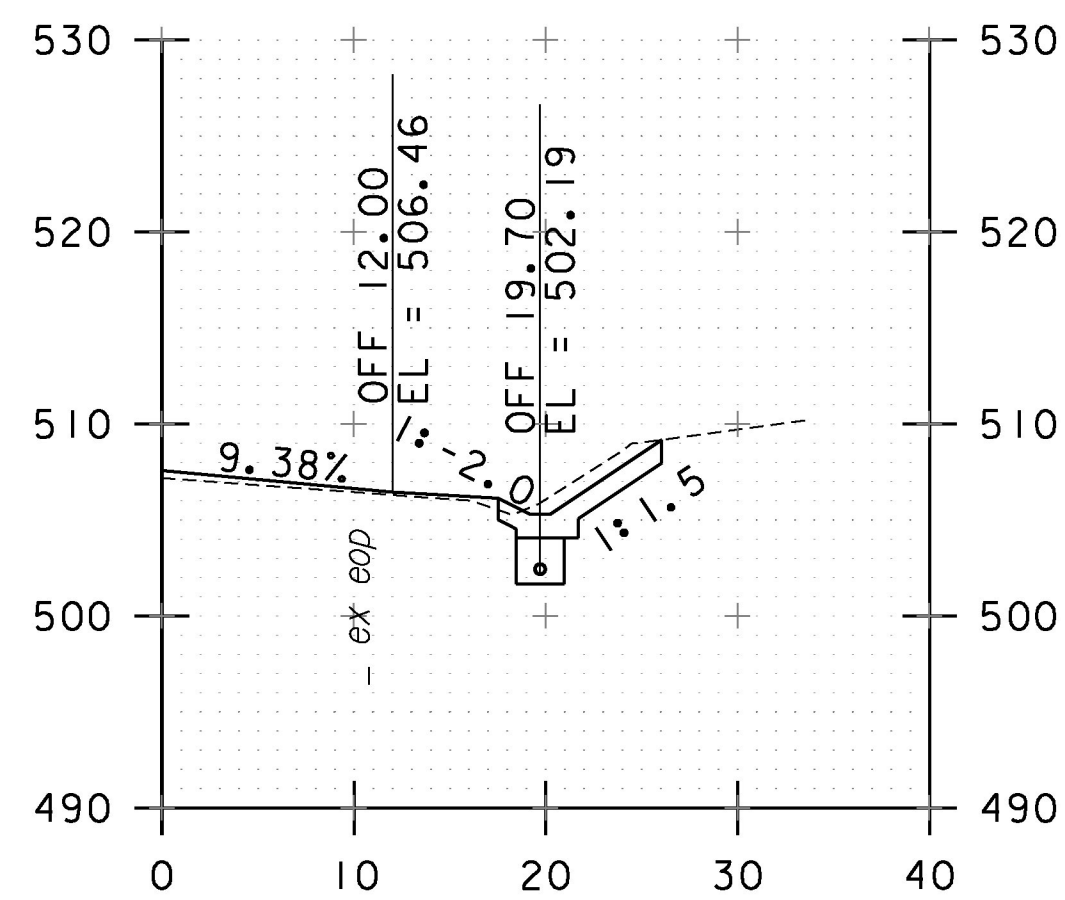


64+50

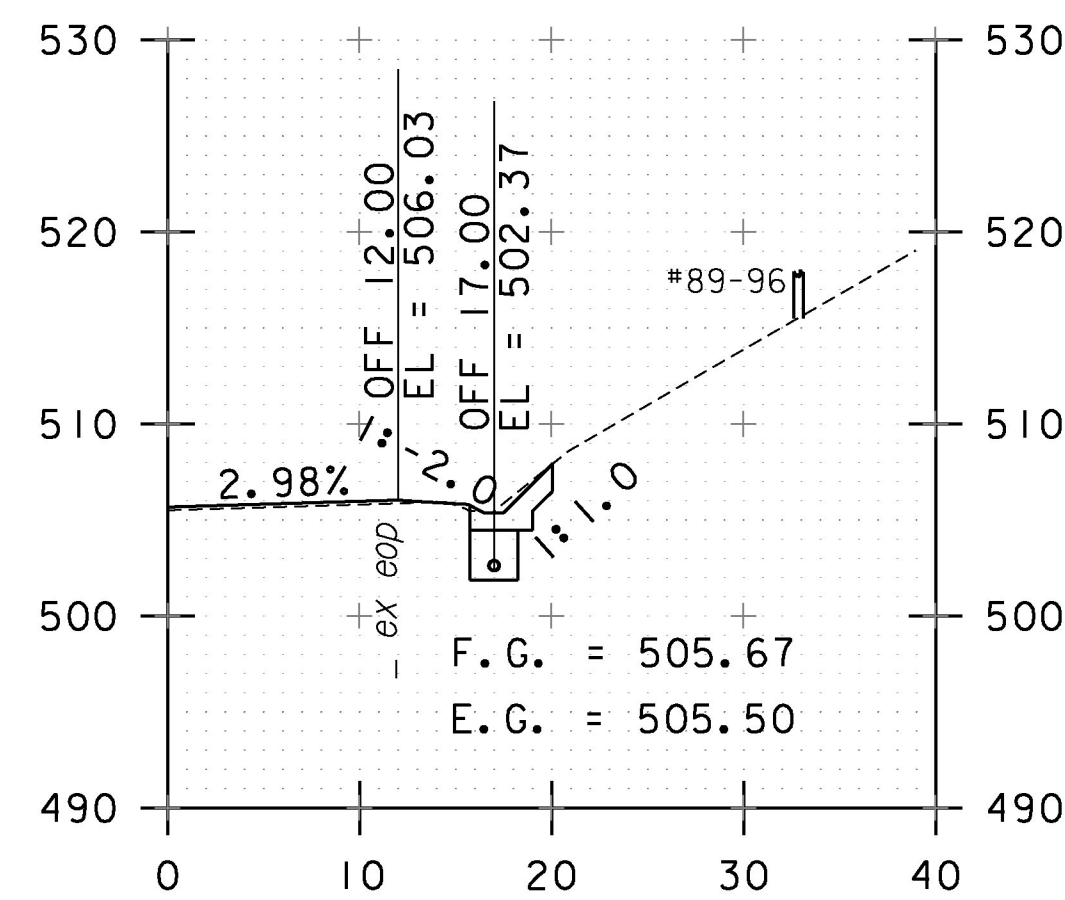


69+00

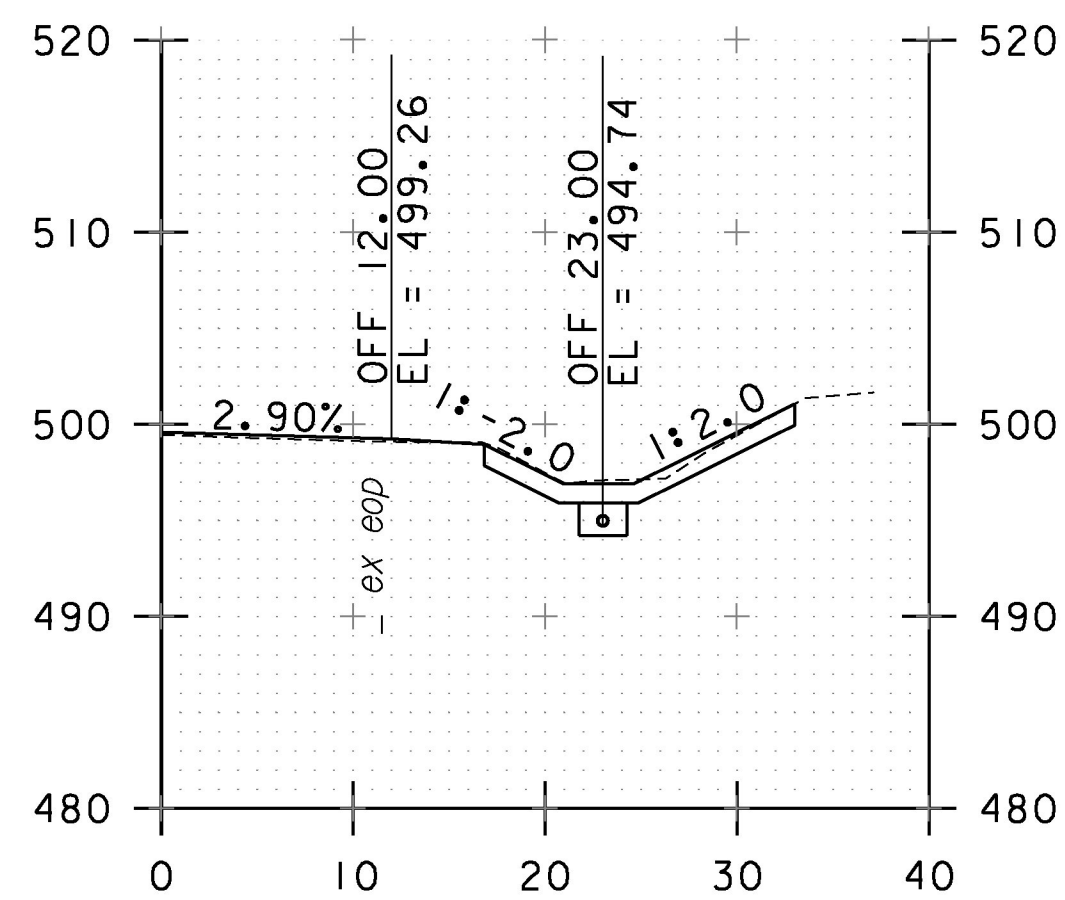


59+50

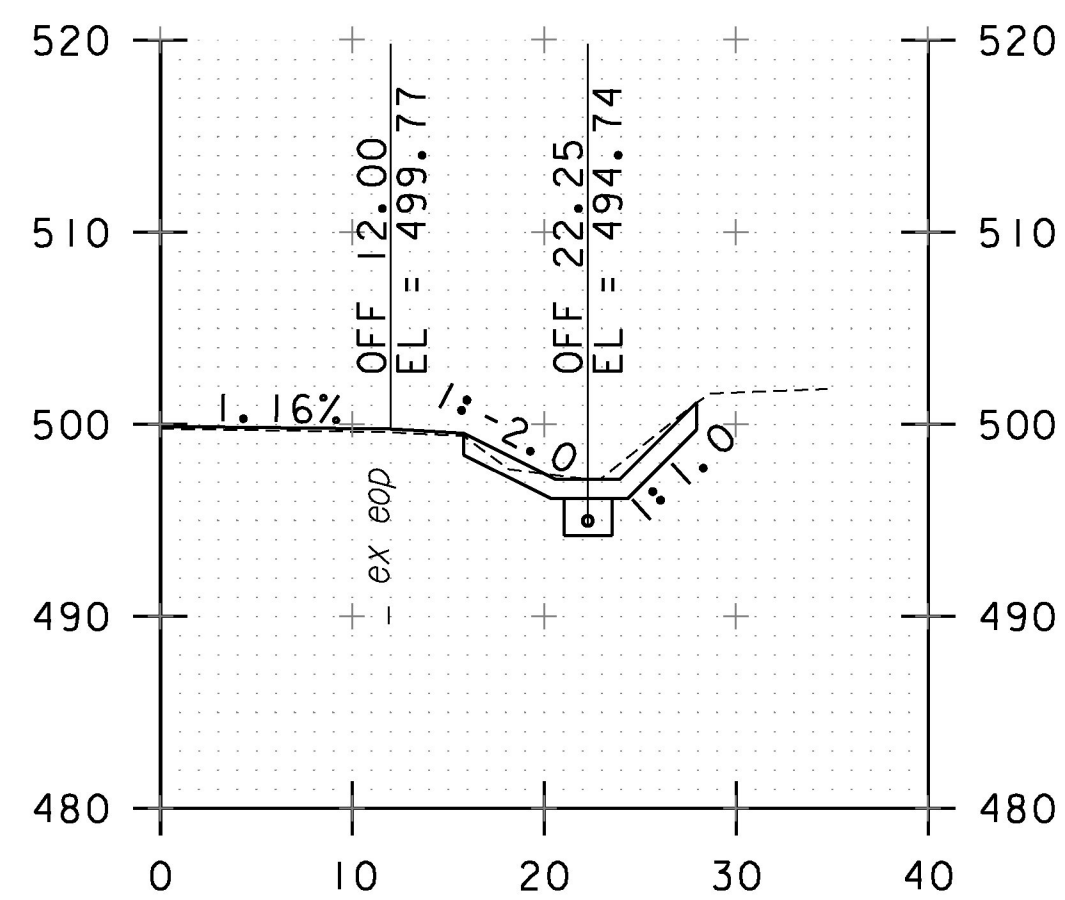


61+00

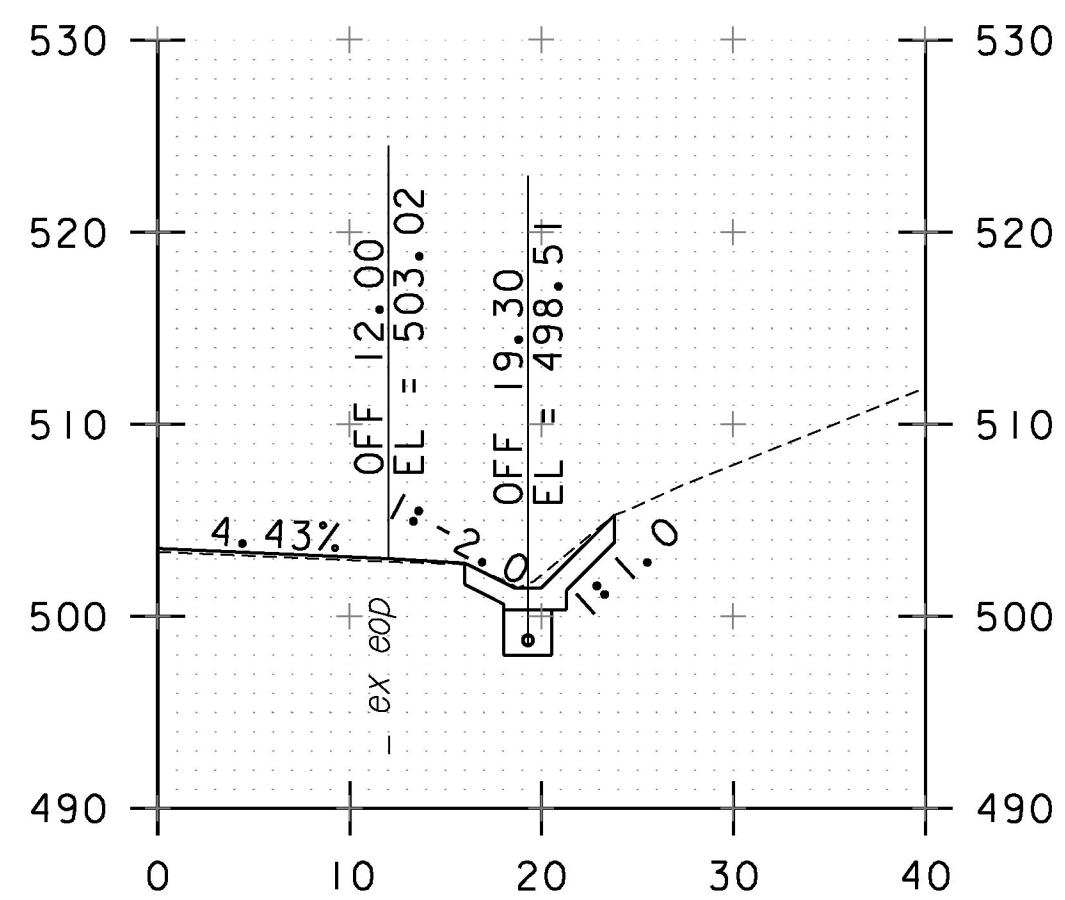

62+50

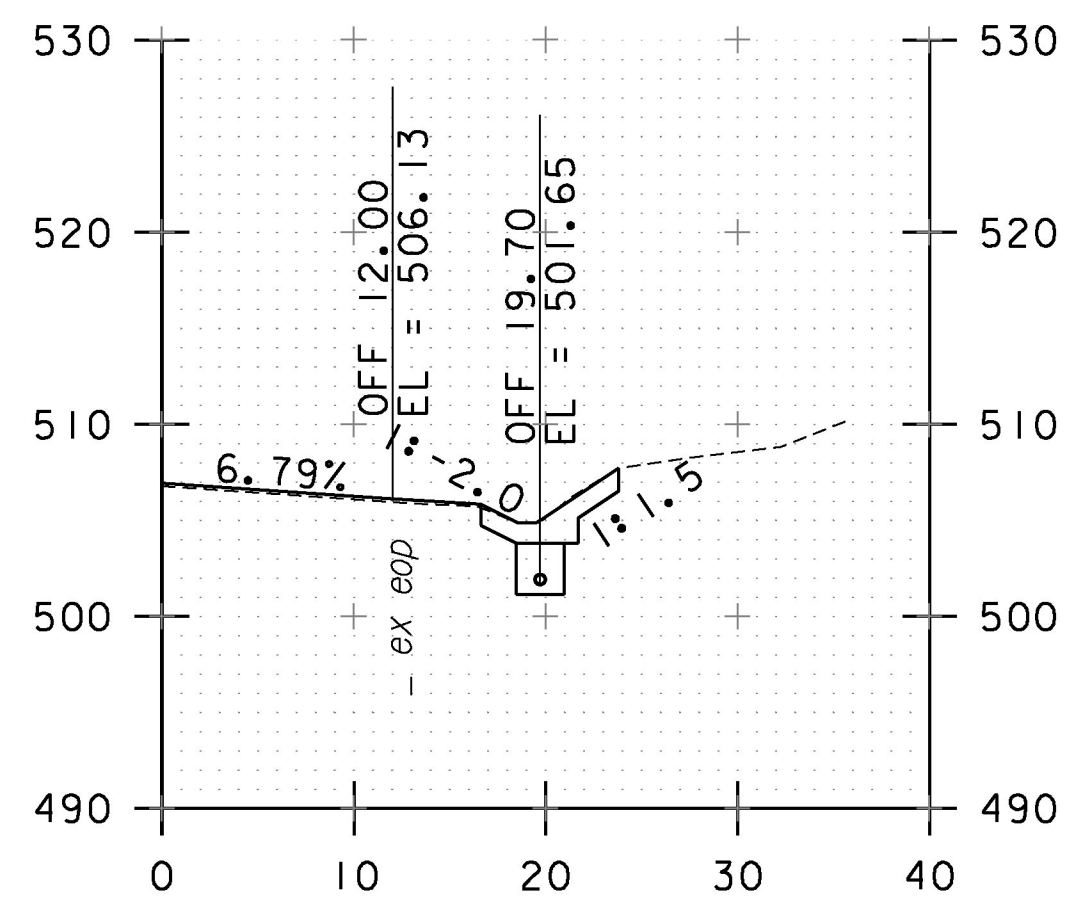

64+00

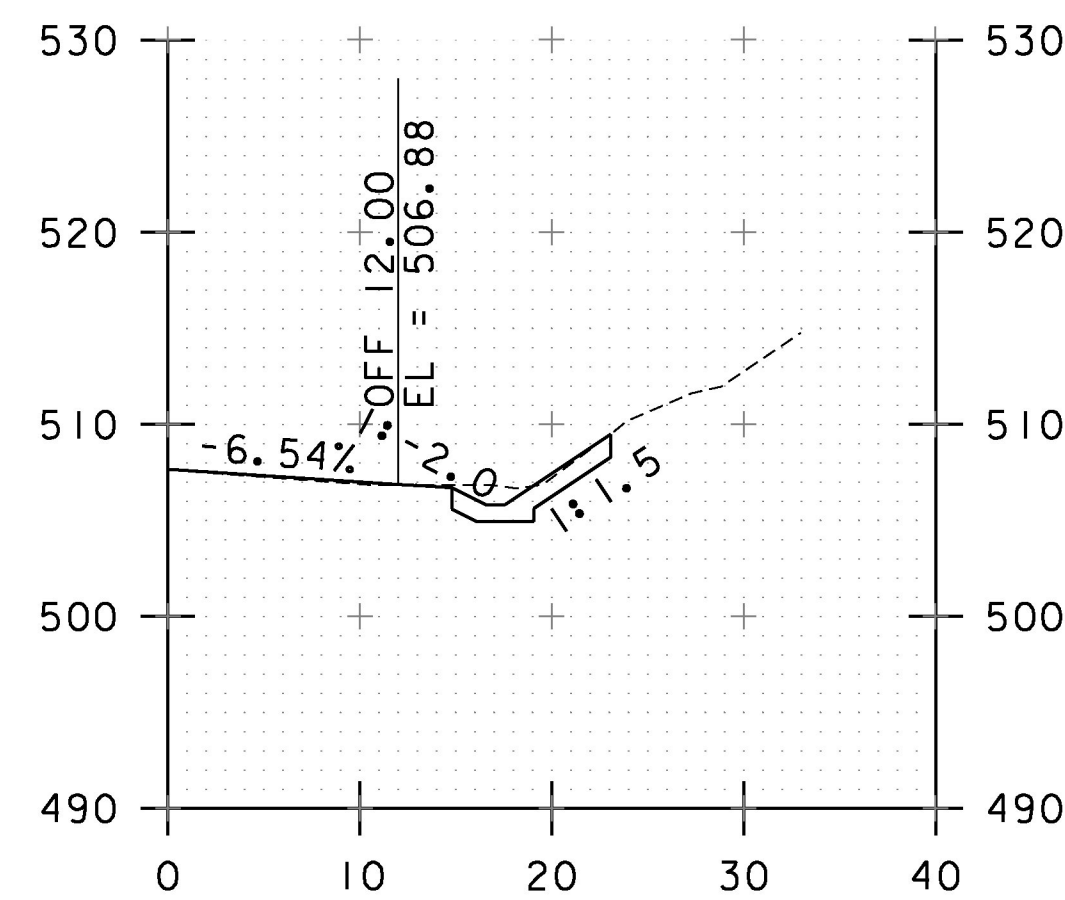

65+50

PROJECT NAME:	RICHFORD
PROJECT NUMBER:	STP 2916(I)
FILE NAME:	z10c234xs.dgn
PROJECT LEADER:	G. EDWARDS
DESIGNED BY:	G. BURGMEIER
UNDERDRAIN CROSS SECTION SHEET 8	
PLOT DATE:	4/2/2018
DRAWN BY:	G. BURGMEIER
CHECKED BY:	J. LITTLE
SHEET	206 OF 222

