




71+00

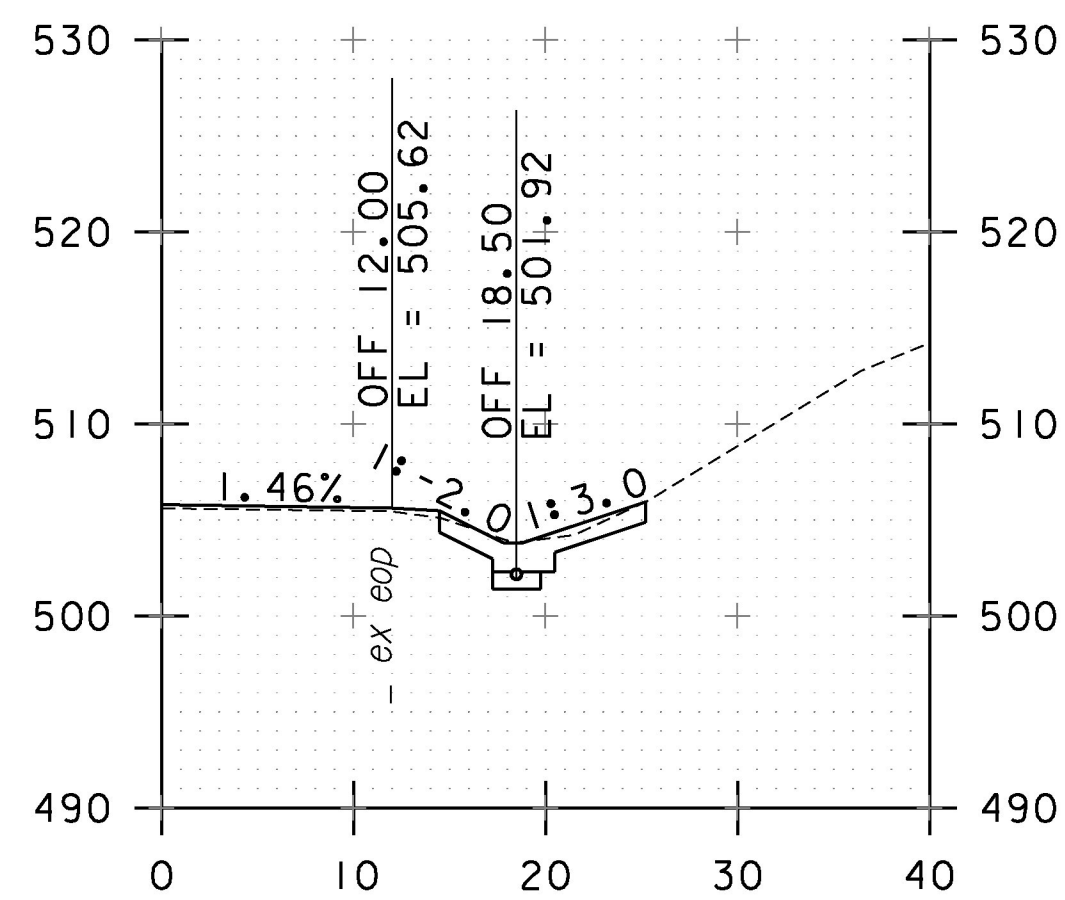


70+50

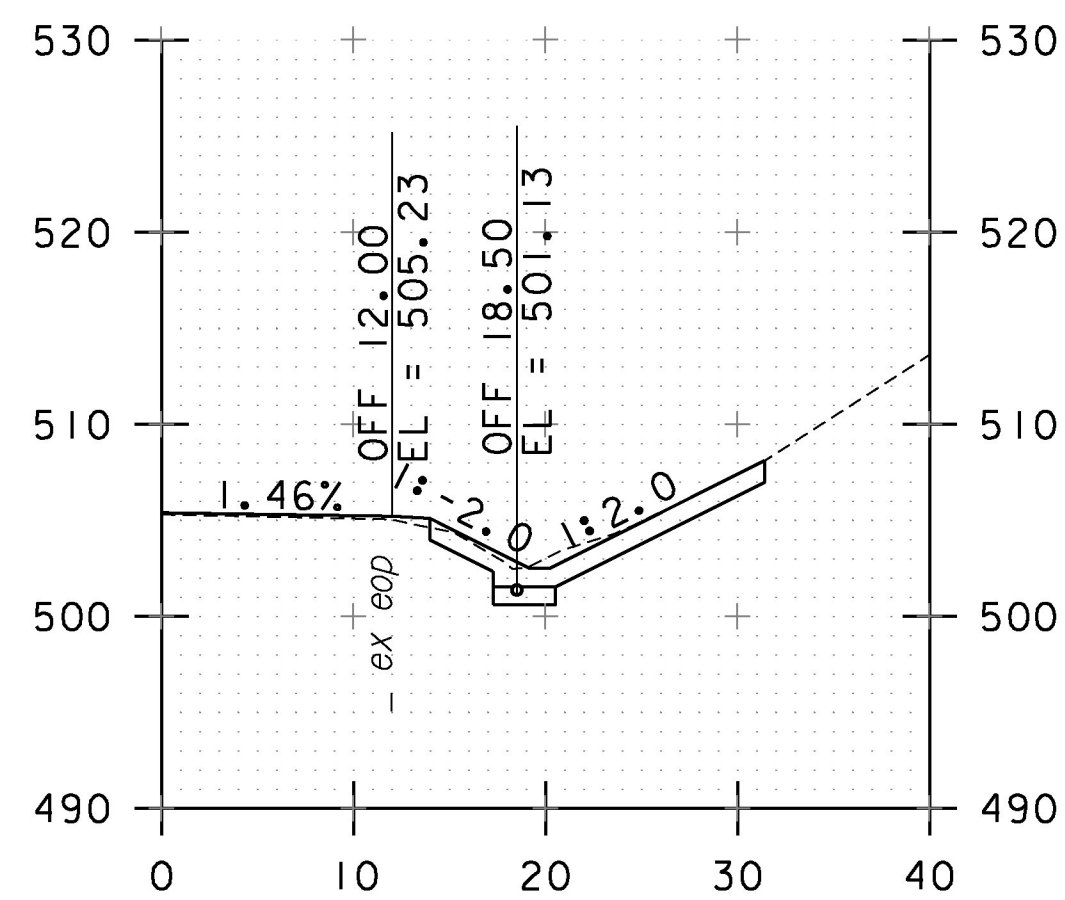


70+00

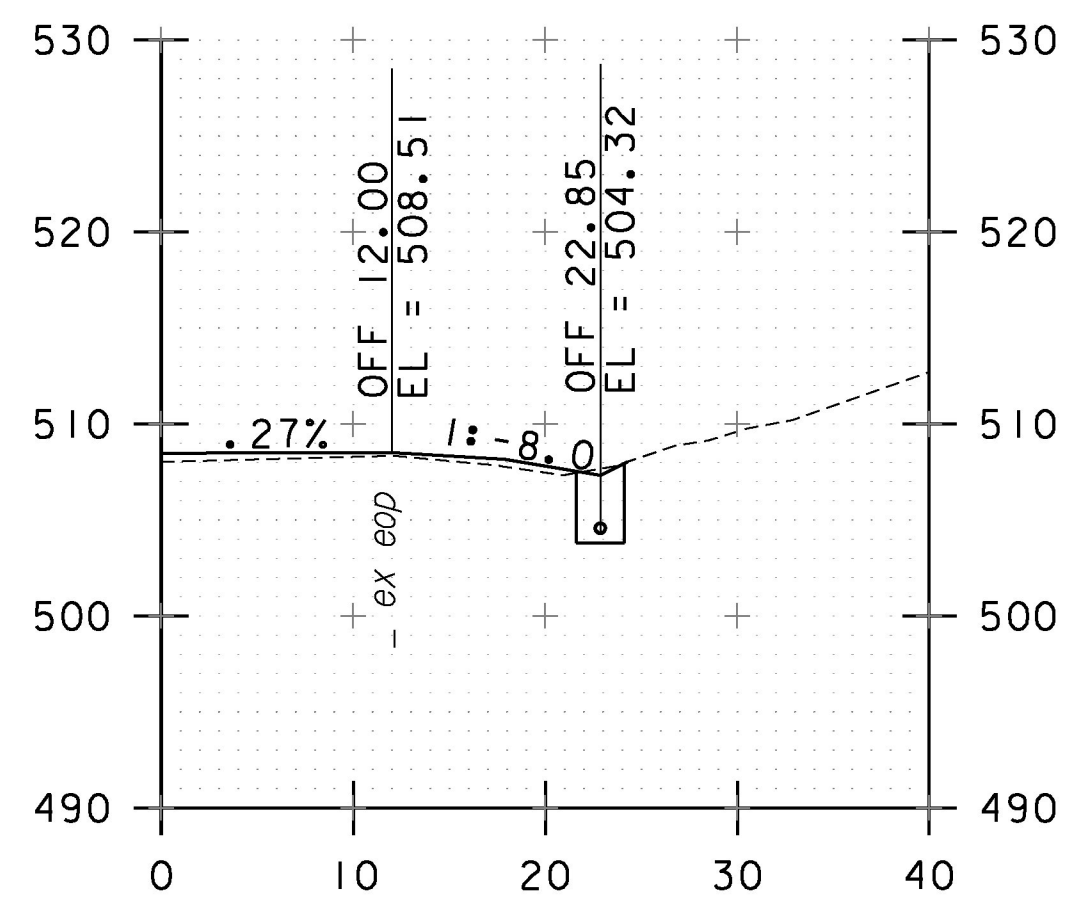


72+00

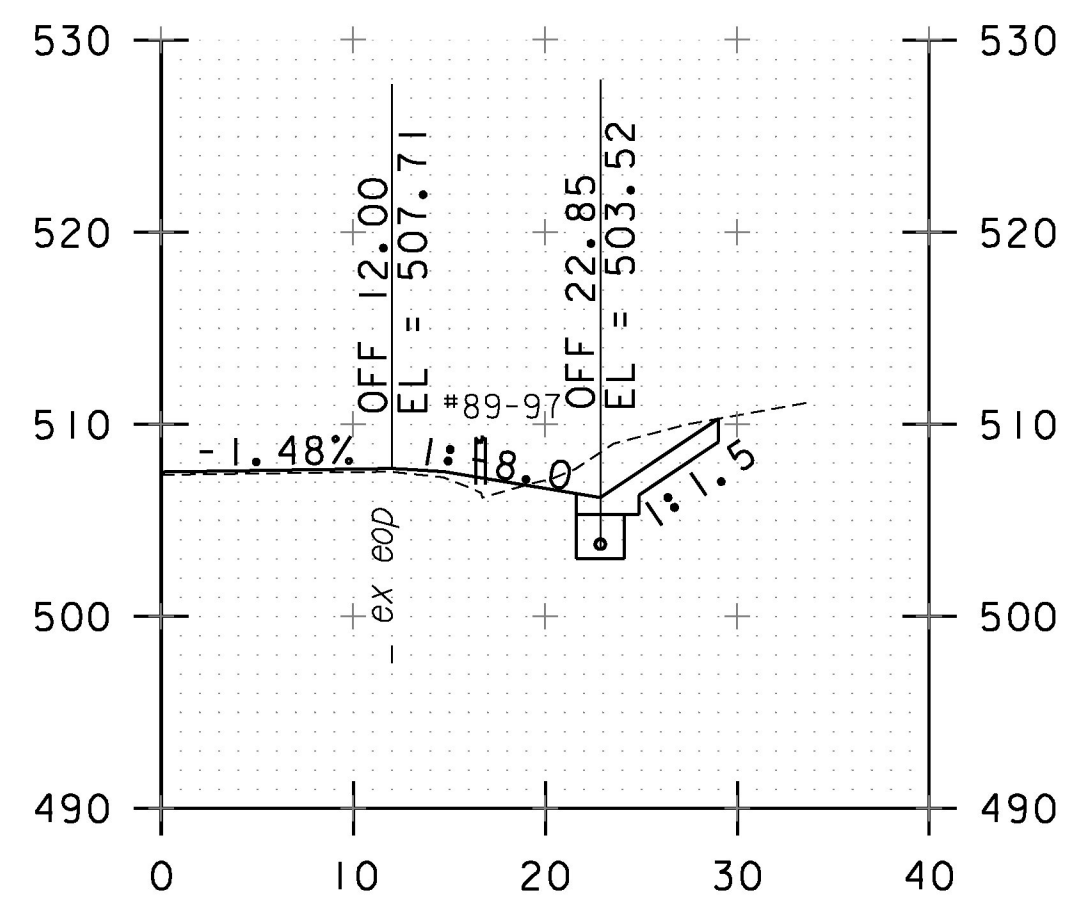


71+50

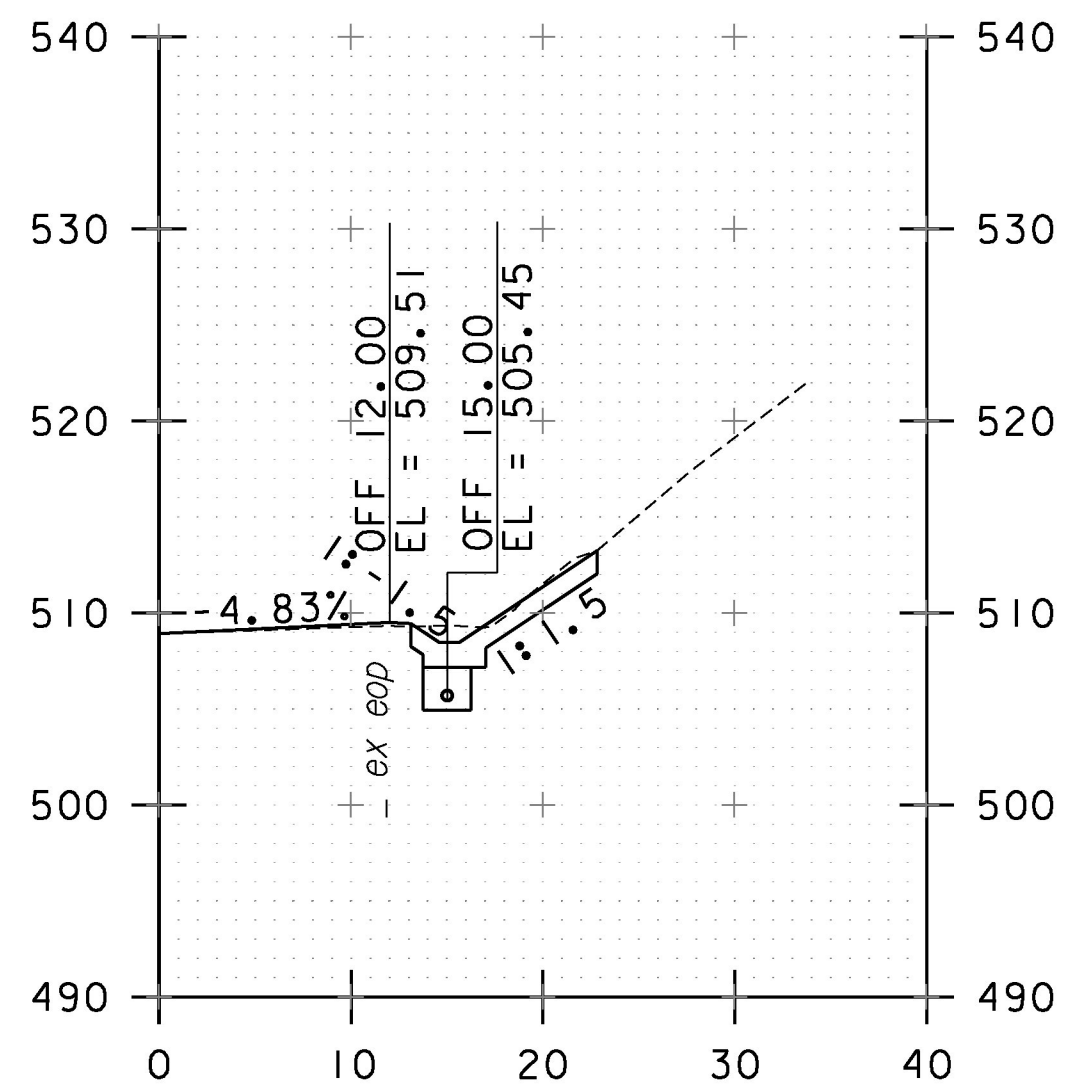


73+00

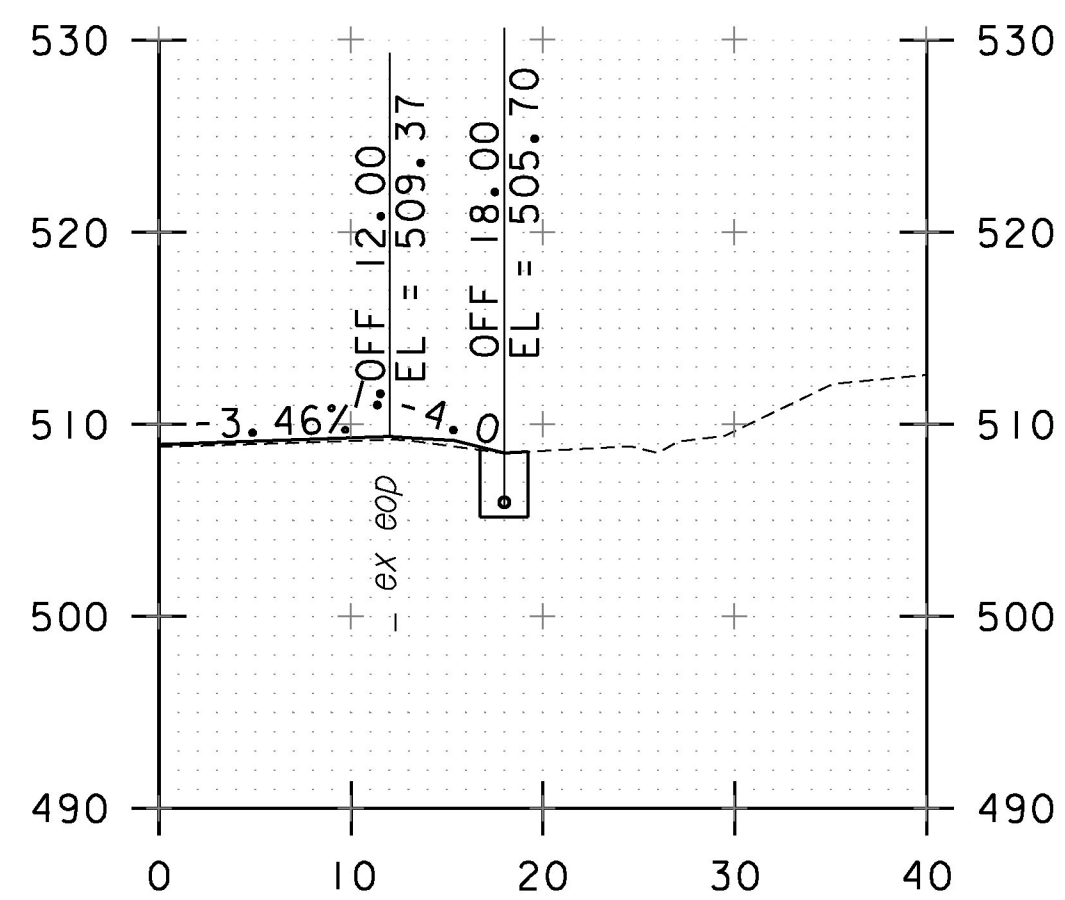


72+50

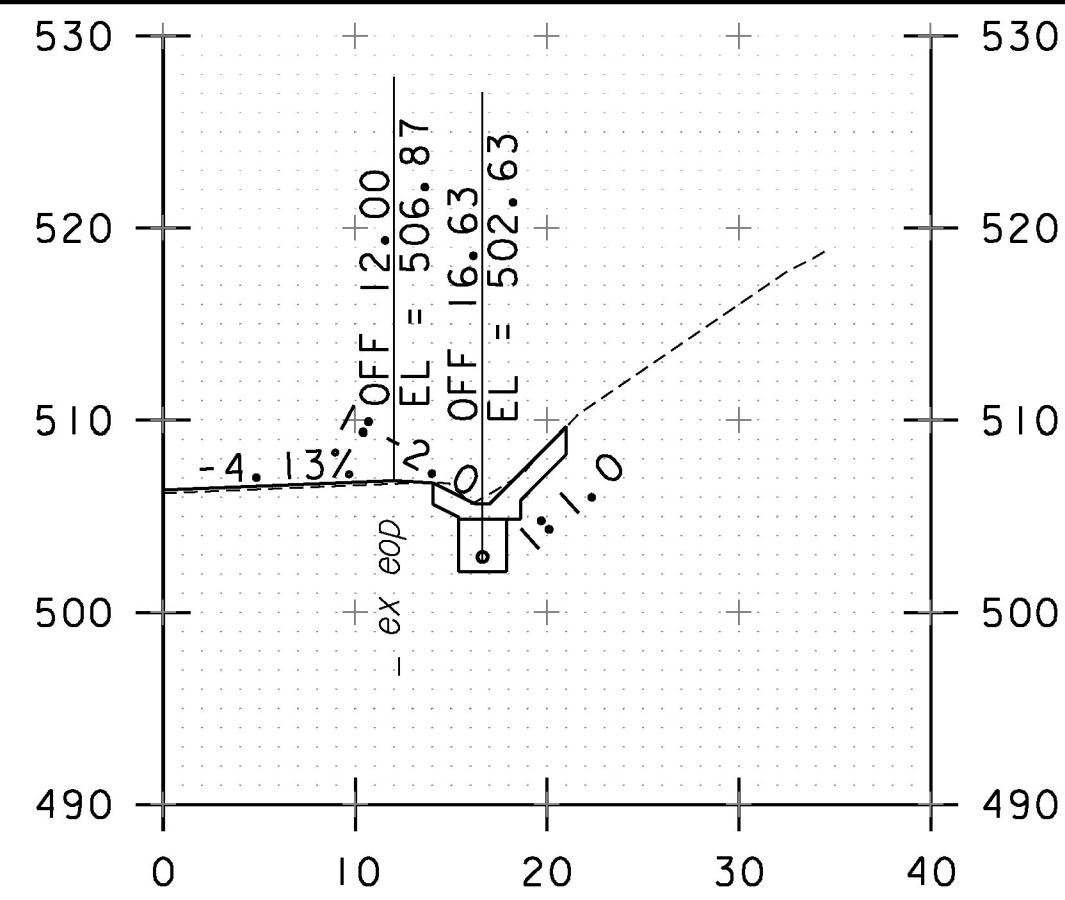


74+50

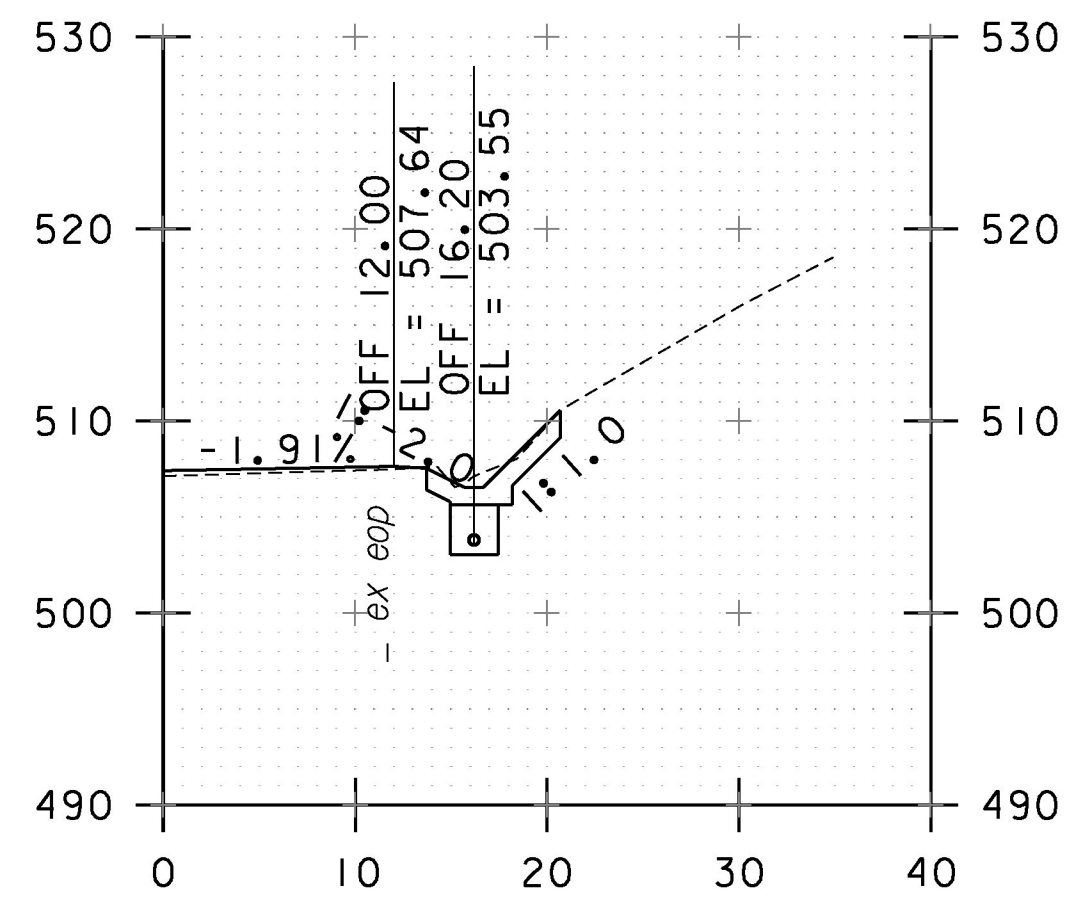


74+00

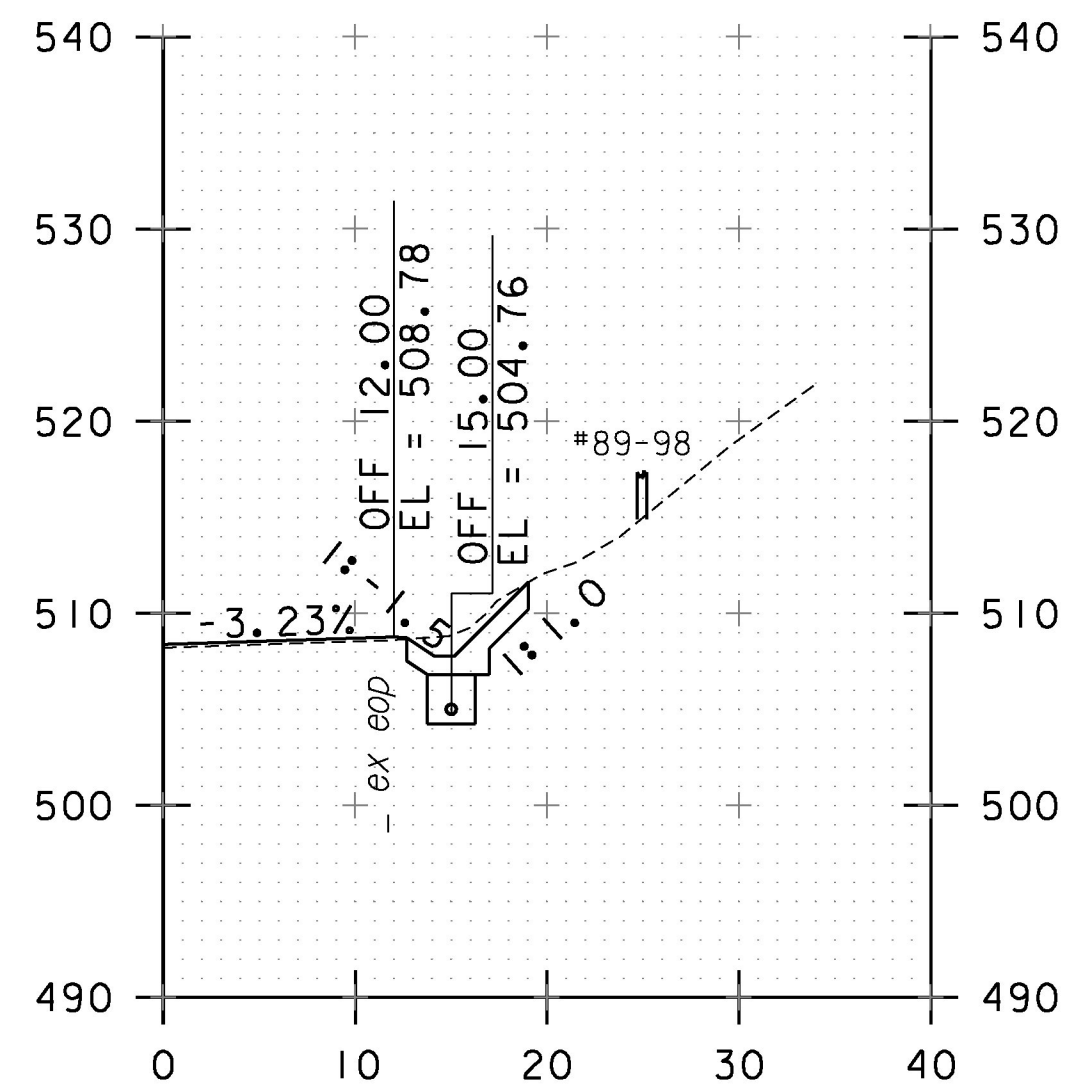


73+50

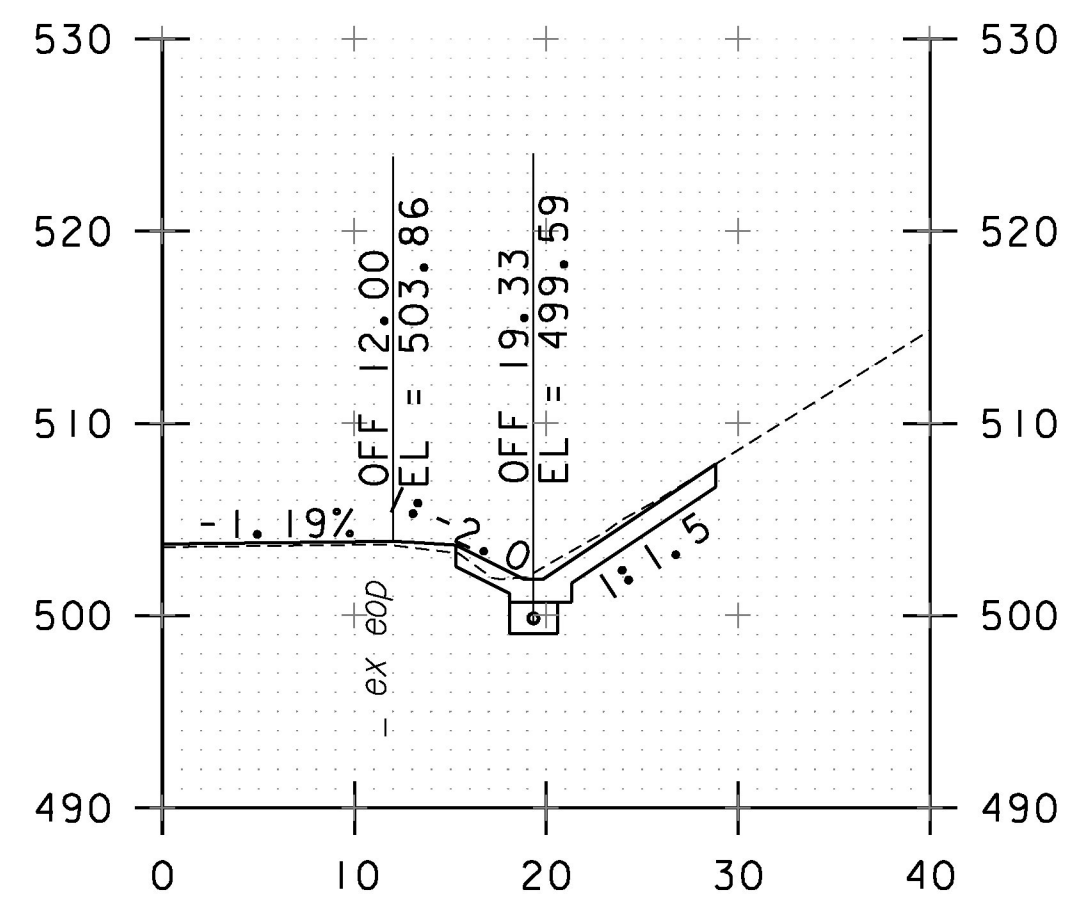

76+00

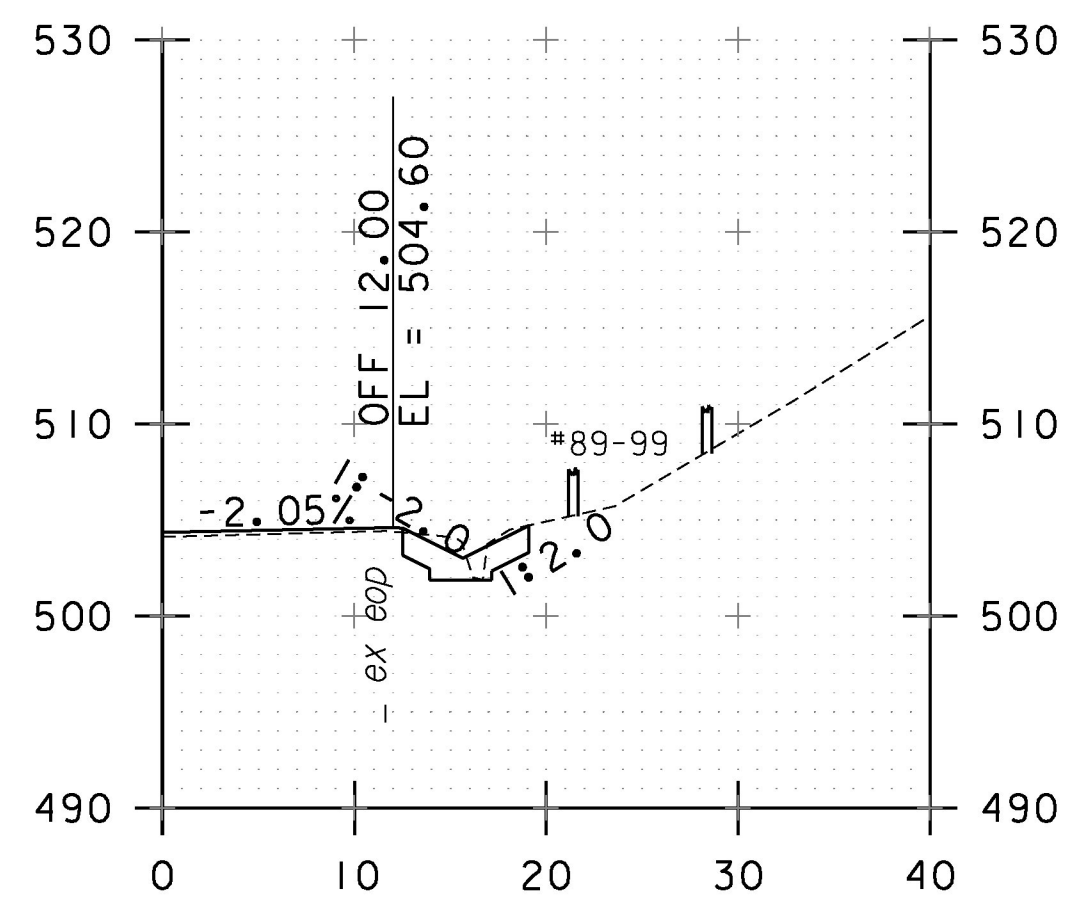

75+50

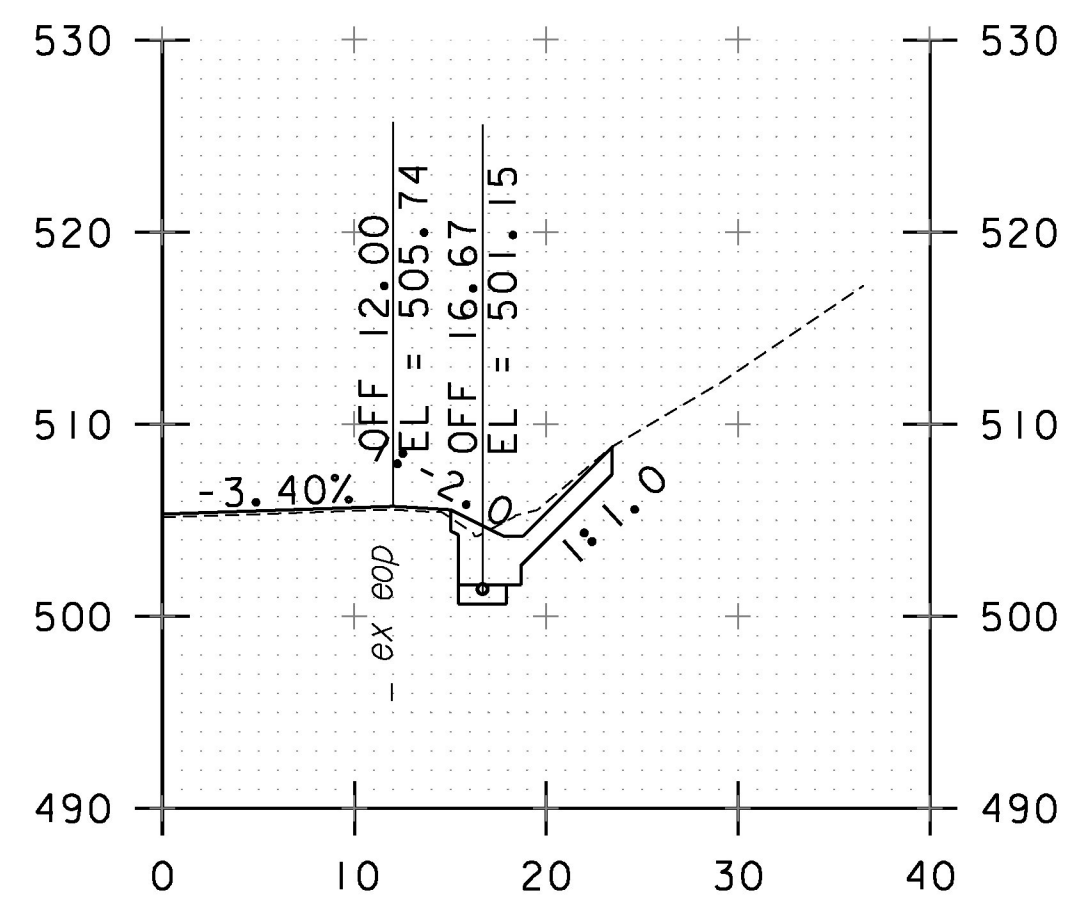

75+00



PROJECT NAME:	RICHFORD	PLOT DATE:	4/2/2018
PROJECT NUMBER:	STP 2916(I)	DRAWN BY:	G. BURGMEIER
FILE NAME:	z10c234xs.dgn	DESIGNED BY:	G. BURGMEIER
PROJECT LEADER:	G. EDWARDS	CHECKED BY:	J. LITTLE
UNDERDRAIN CROSS SECTION SHEET 9		SHEET	207 OF 222