




77+50

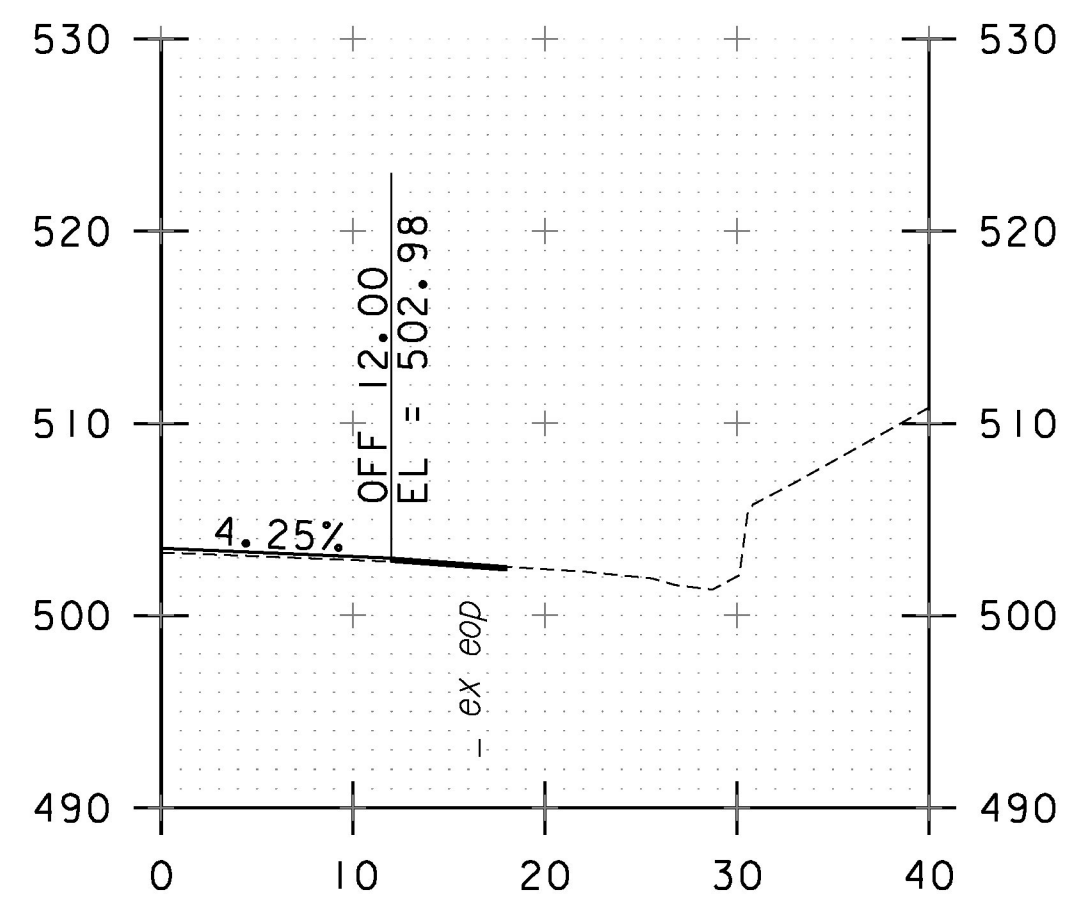


79+00

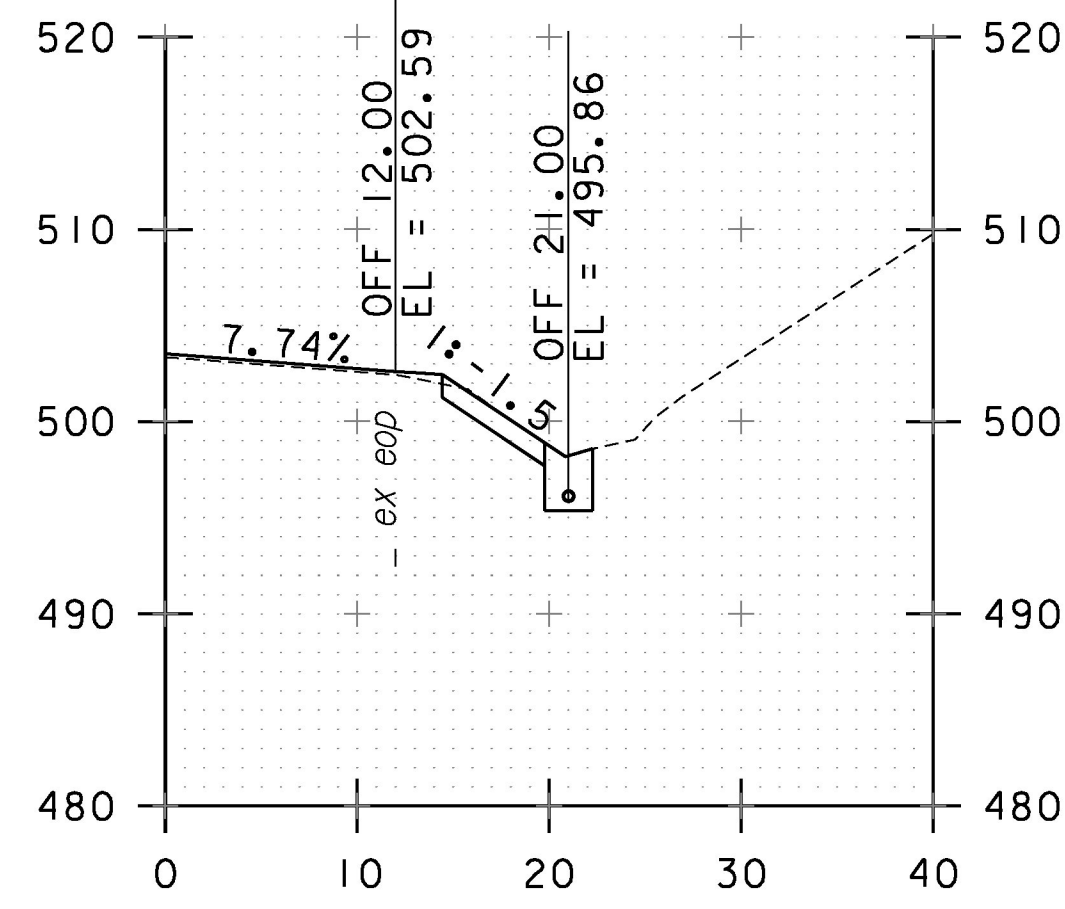


80+50

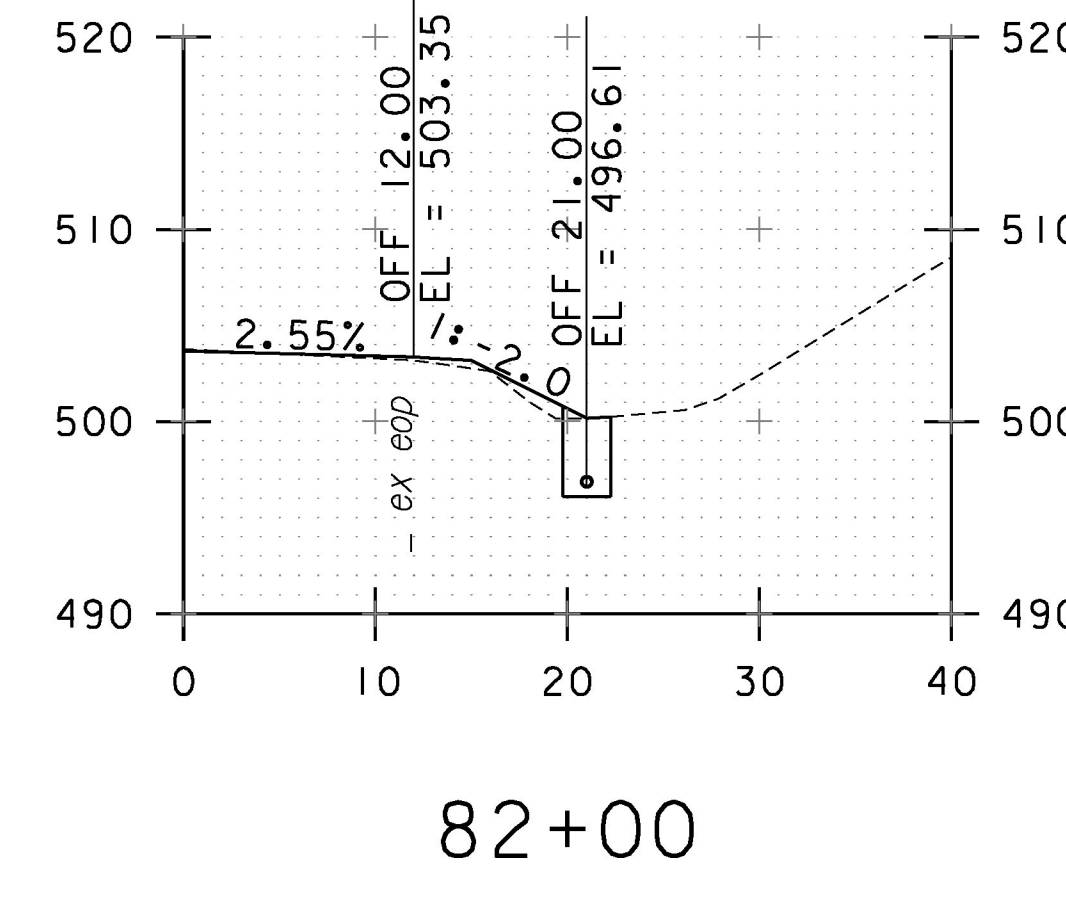


82+00

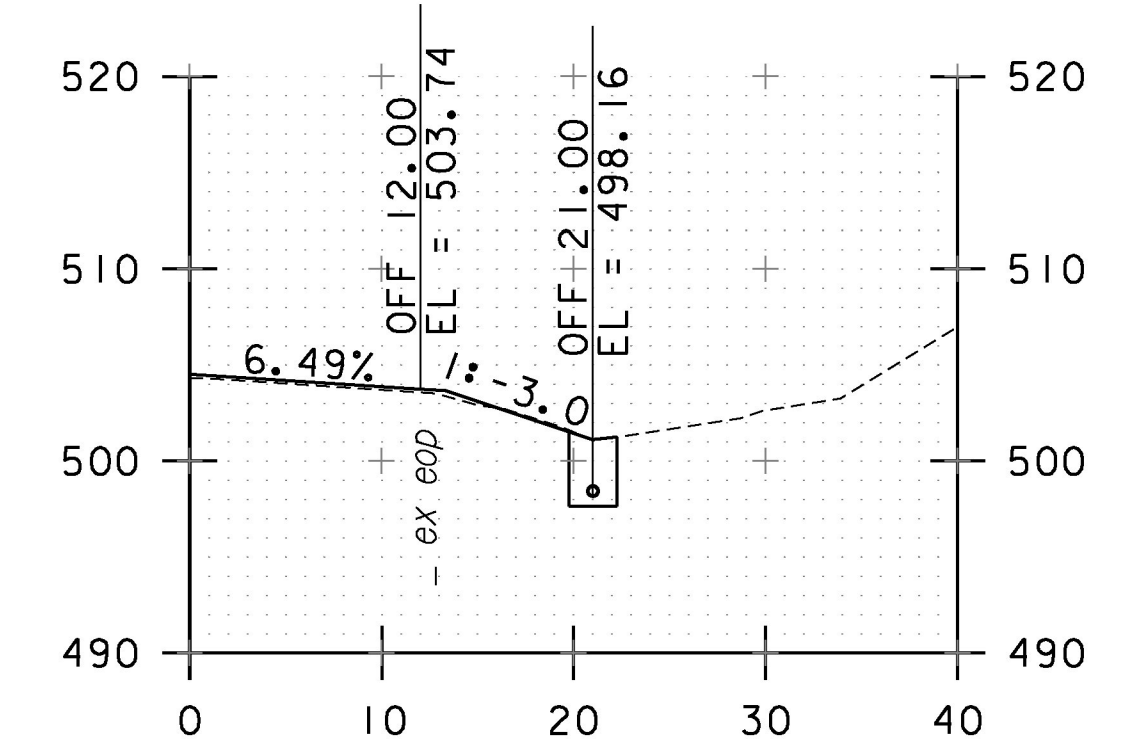


83+50

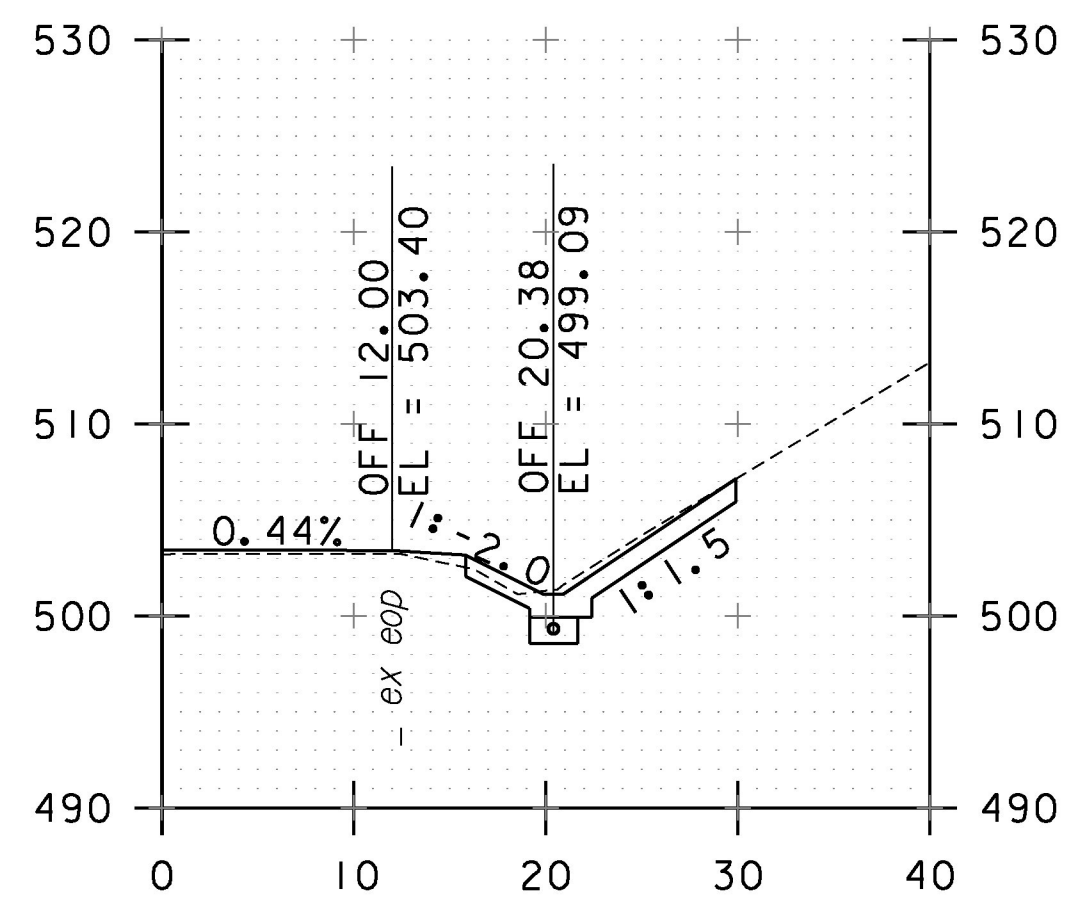


77+00

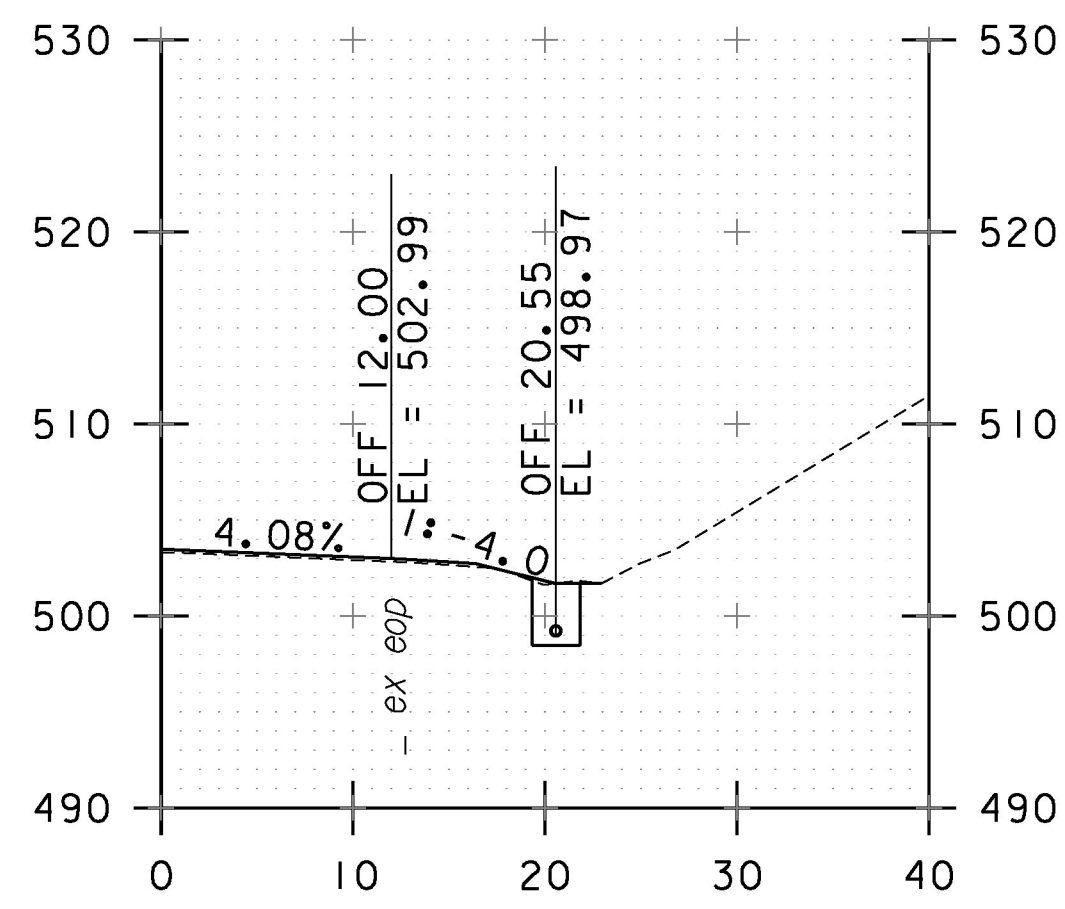


78+50

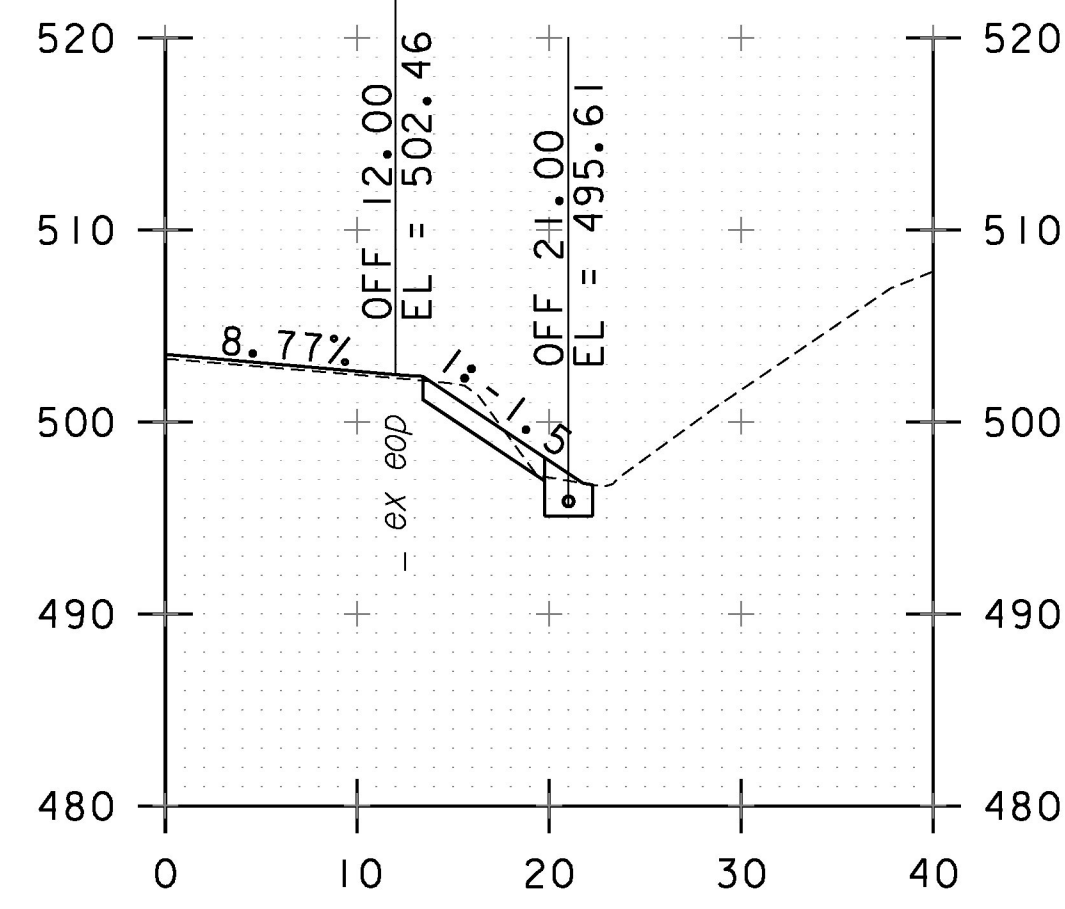


80+00

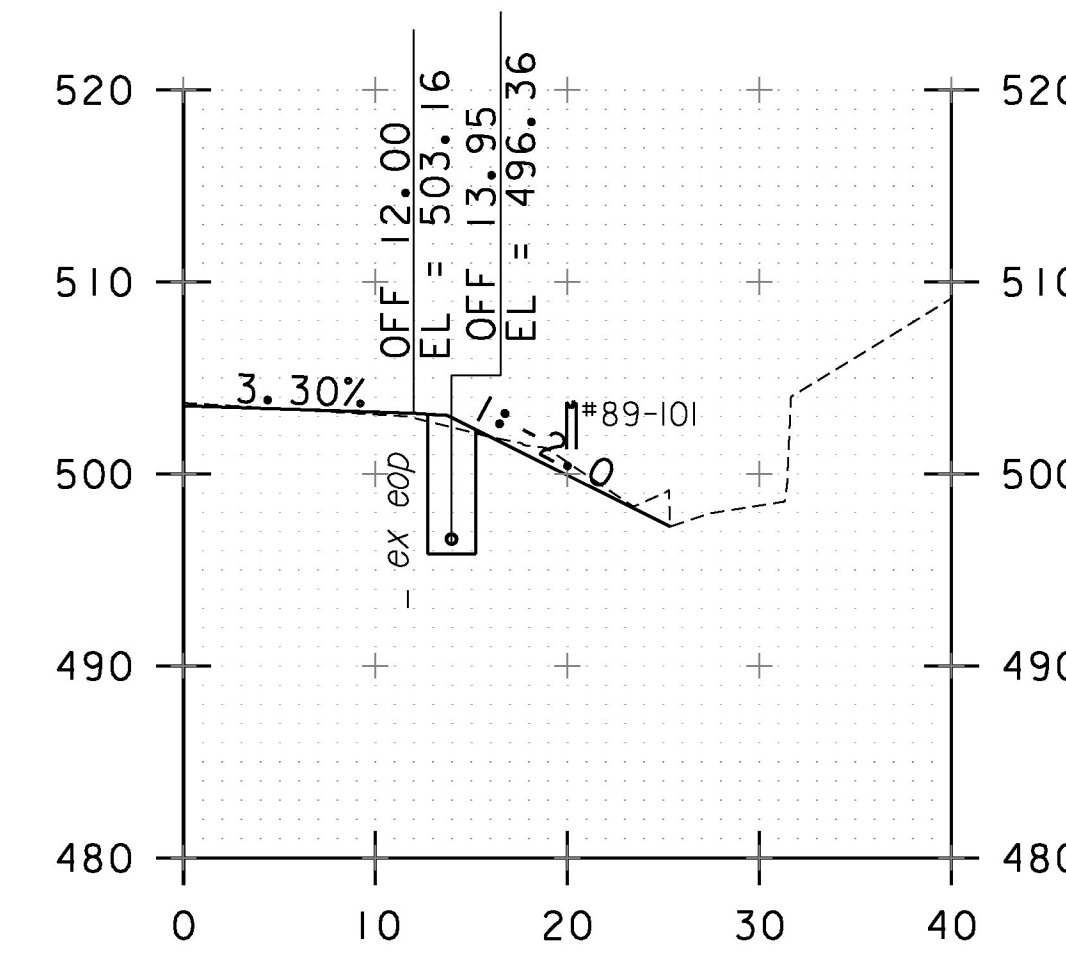


81+50

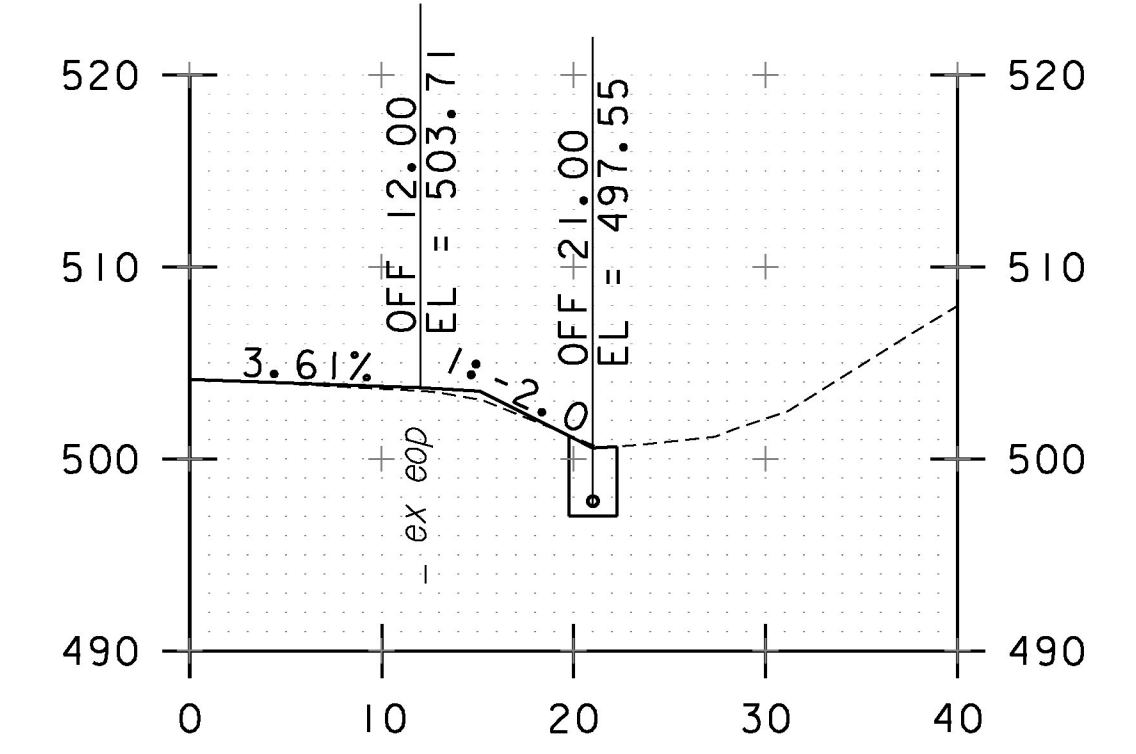


83+00

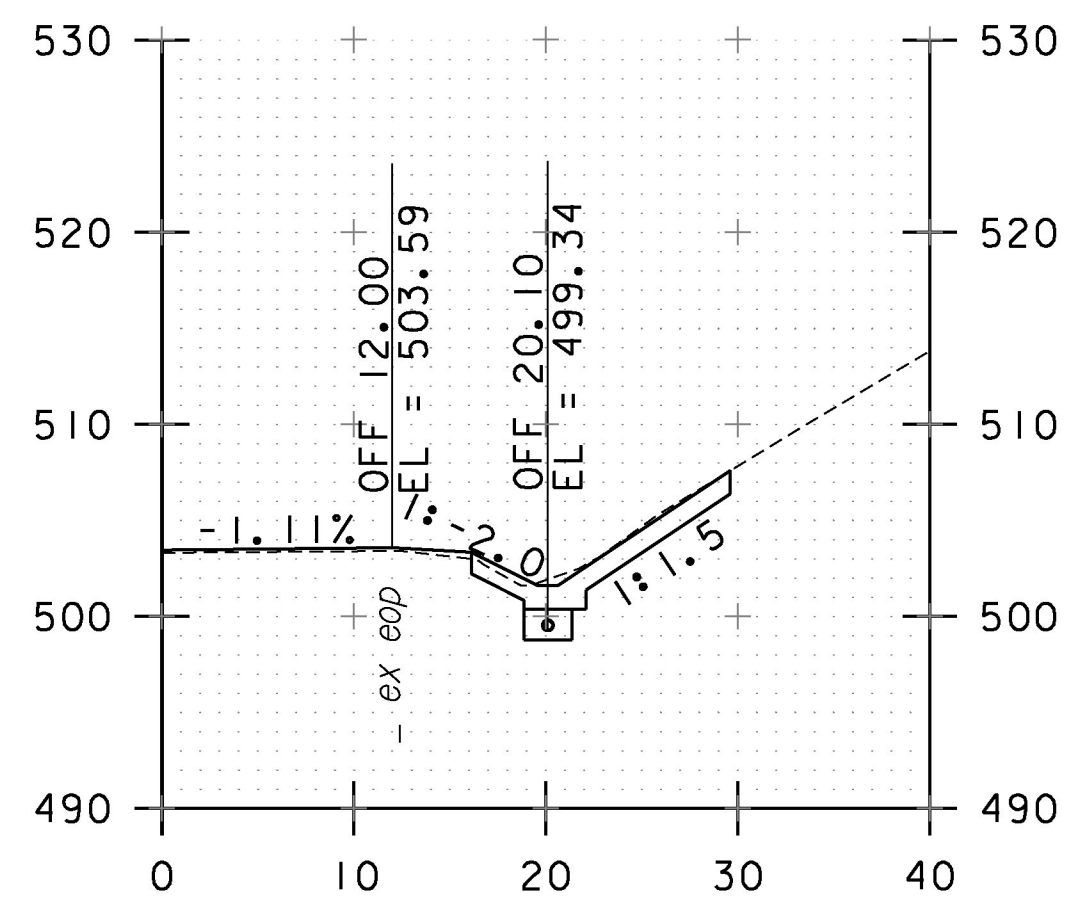


76+50

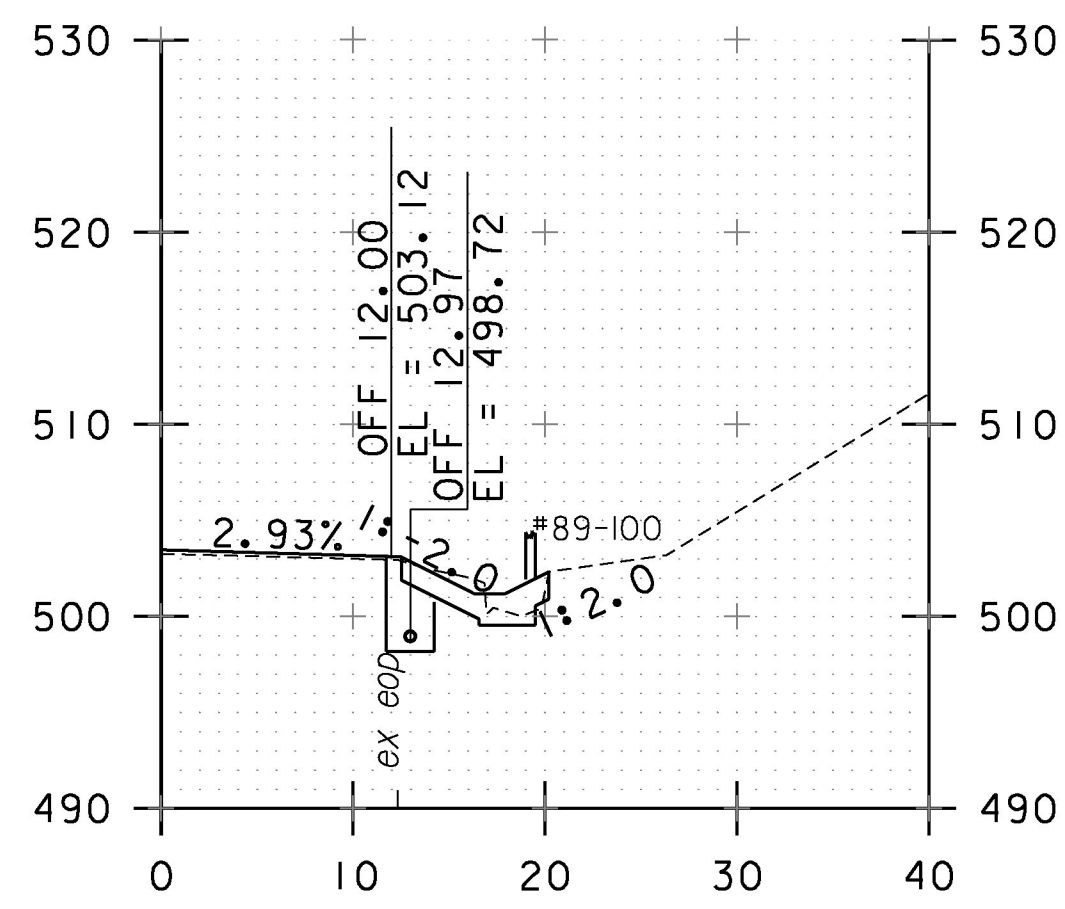


78+00

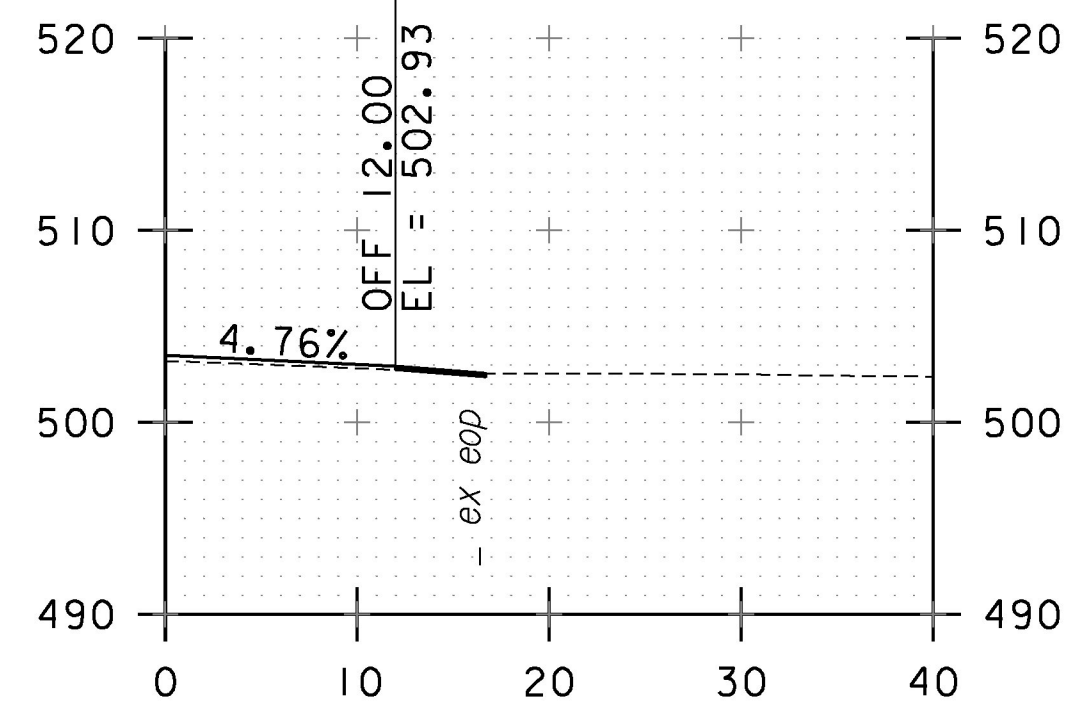

79+50

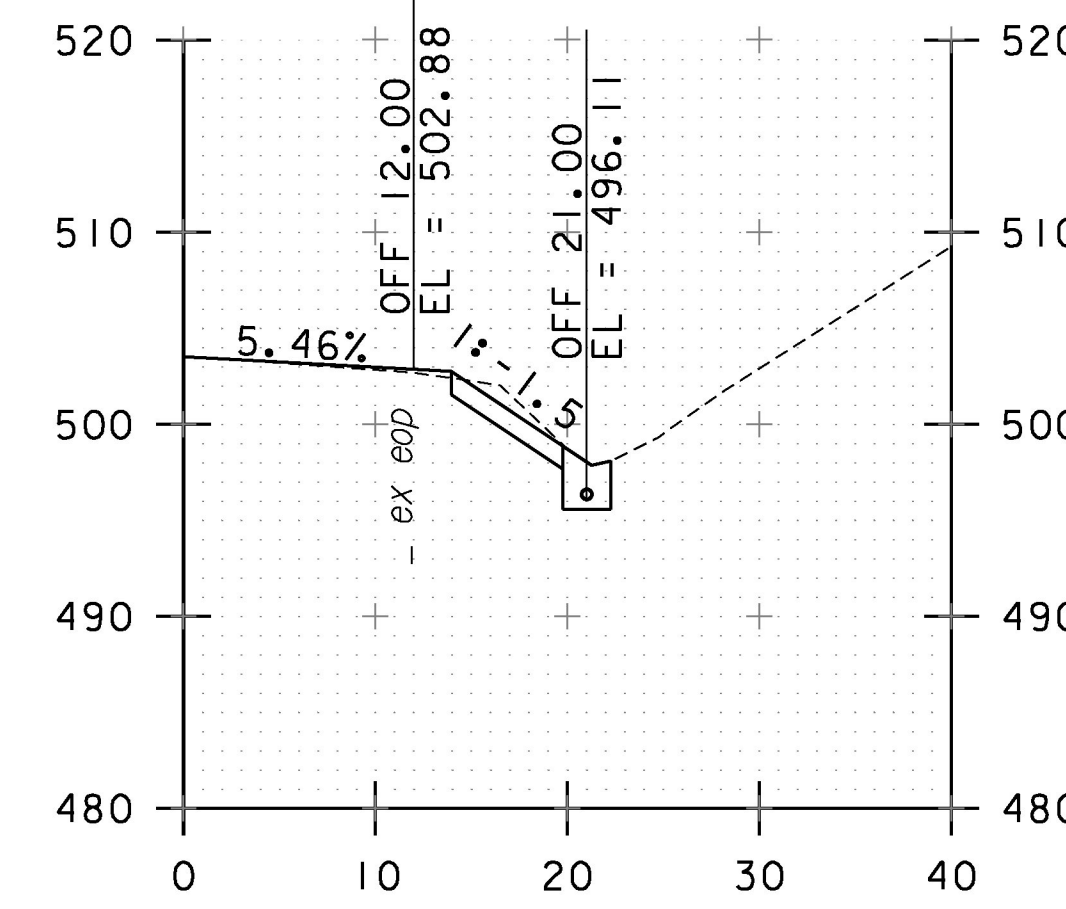

81+00

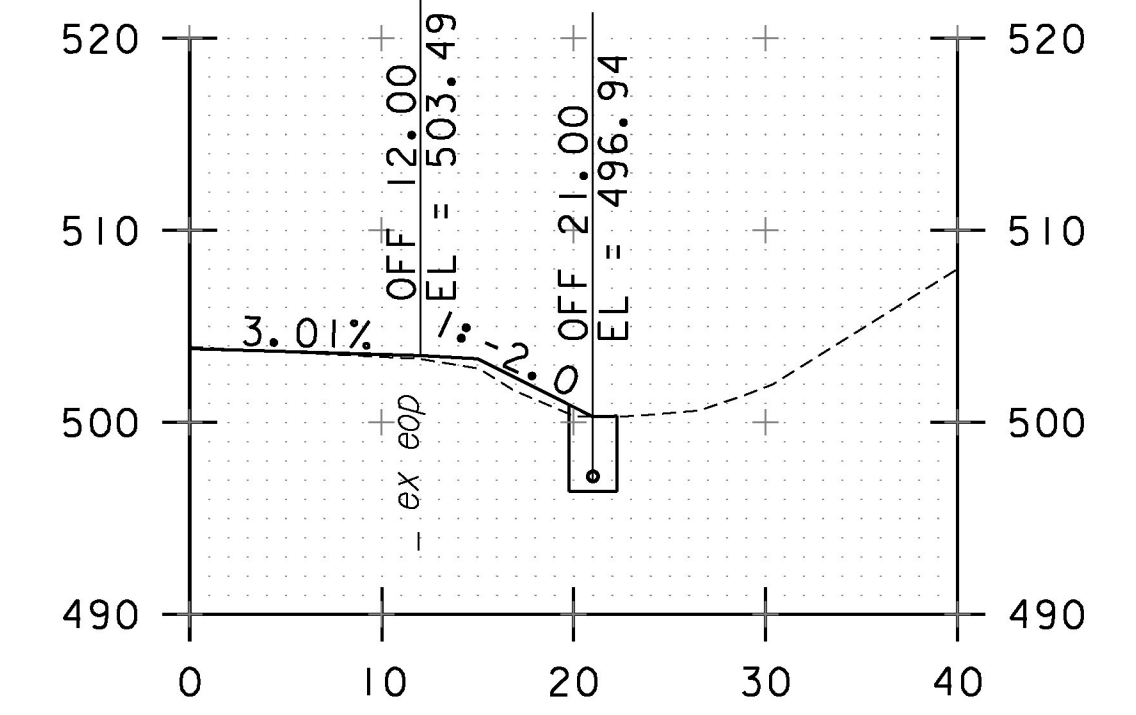

82+50

PROJECT NAME:	RICHFORD
PROJECT NUMBER:	STP 2916(I)
FILE NAME:	z10c234xs.dgn
PROJECT LEADER:	G. EDWARDS
DESIGNED BY:	G. BURGMEIER
UNDERDRAIN CROSS SECTION SHEET 10	
PLOT DATE:	4/2/2018
DRAWN BY:	G. BURGMEIER
CHECKED BY:	J. LITTLE
SHEET	208 OF 222

