

TEMPORARY 4 INCH WHITE LINE, PAINT
 4 INCH WHITE LINE, WATERBORNE PAINT
 0+77 TO 2+04 RT (SOLID)
 0+93 TO 3+34 LT (SOLID)
 3+23 TO 3+34 RT (SOLID)
 3+42 TO 3+60 LT (SOLID)
 3+42 TO 3+60 RT (SOLID)
 499+92 TO 501+64 RT (SOLID)
 500+34 TO 501+51 LT (SOLID)

TEMPORARY 4 INCH YELLOW LINE, PAINT
 4 INCH YELLOW LINE, WATERBORNE PAINT
 0+93 TO 1+99 LT & RT (SOLID)
 3+03 TO 3+34 LT & RT (SOLID)
 3+42 TO 3+60 LT & RT (SOLID)
 500+70 TO 501+43 LT & RT (SOLID)


TEMPORARY 24 INCH STOP BAR, PAINT
 24 INCH STOP BAR, WATERBORNE PAINT
 0+93 LT (10')
 1+99 RT (10')
 2+83 TO 3+02 RT (TH 2)
 3+03 LT (11')
 500+70 LT (11')
 501+43 RT (10')

TEMPORARY LETTER OR SYMBOL, PAINT
 LETTER OR SYMBOL, WATERBORNE PAINT
 1+01 LT (STOP)
 1+90 RT (STOP)
 2+91 RT (STOP) (TH 2)
 3+12 LT (STOP)
 500+79 LT (STOP)
 501+35 RT (STOP)

TEMPORARY CROSSWALK MARKING, PAINT
 CROSSWALK MARKING, WATERBORNE PAINT
 3+38 LT TO RT (31')


PORTLAND CEMENT
 CONCRETE SIDEWALK, 5 INCH
 3+35 TO 3+45 RT (RAMP TYPE 6)

DETECTABLE WARNING SURFACE (DWS)
 3+40 RT

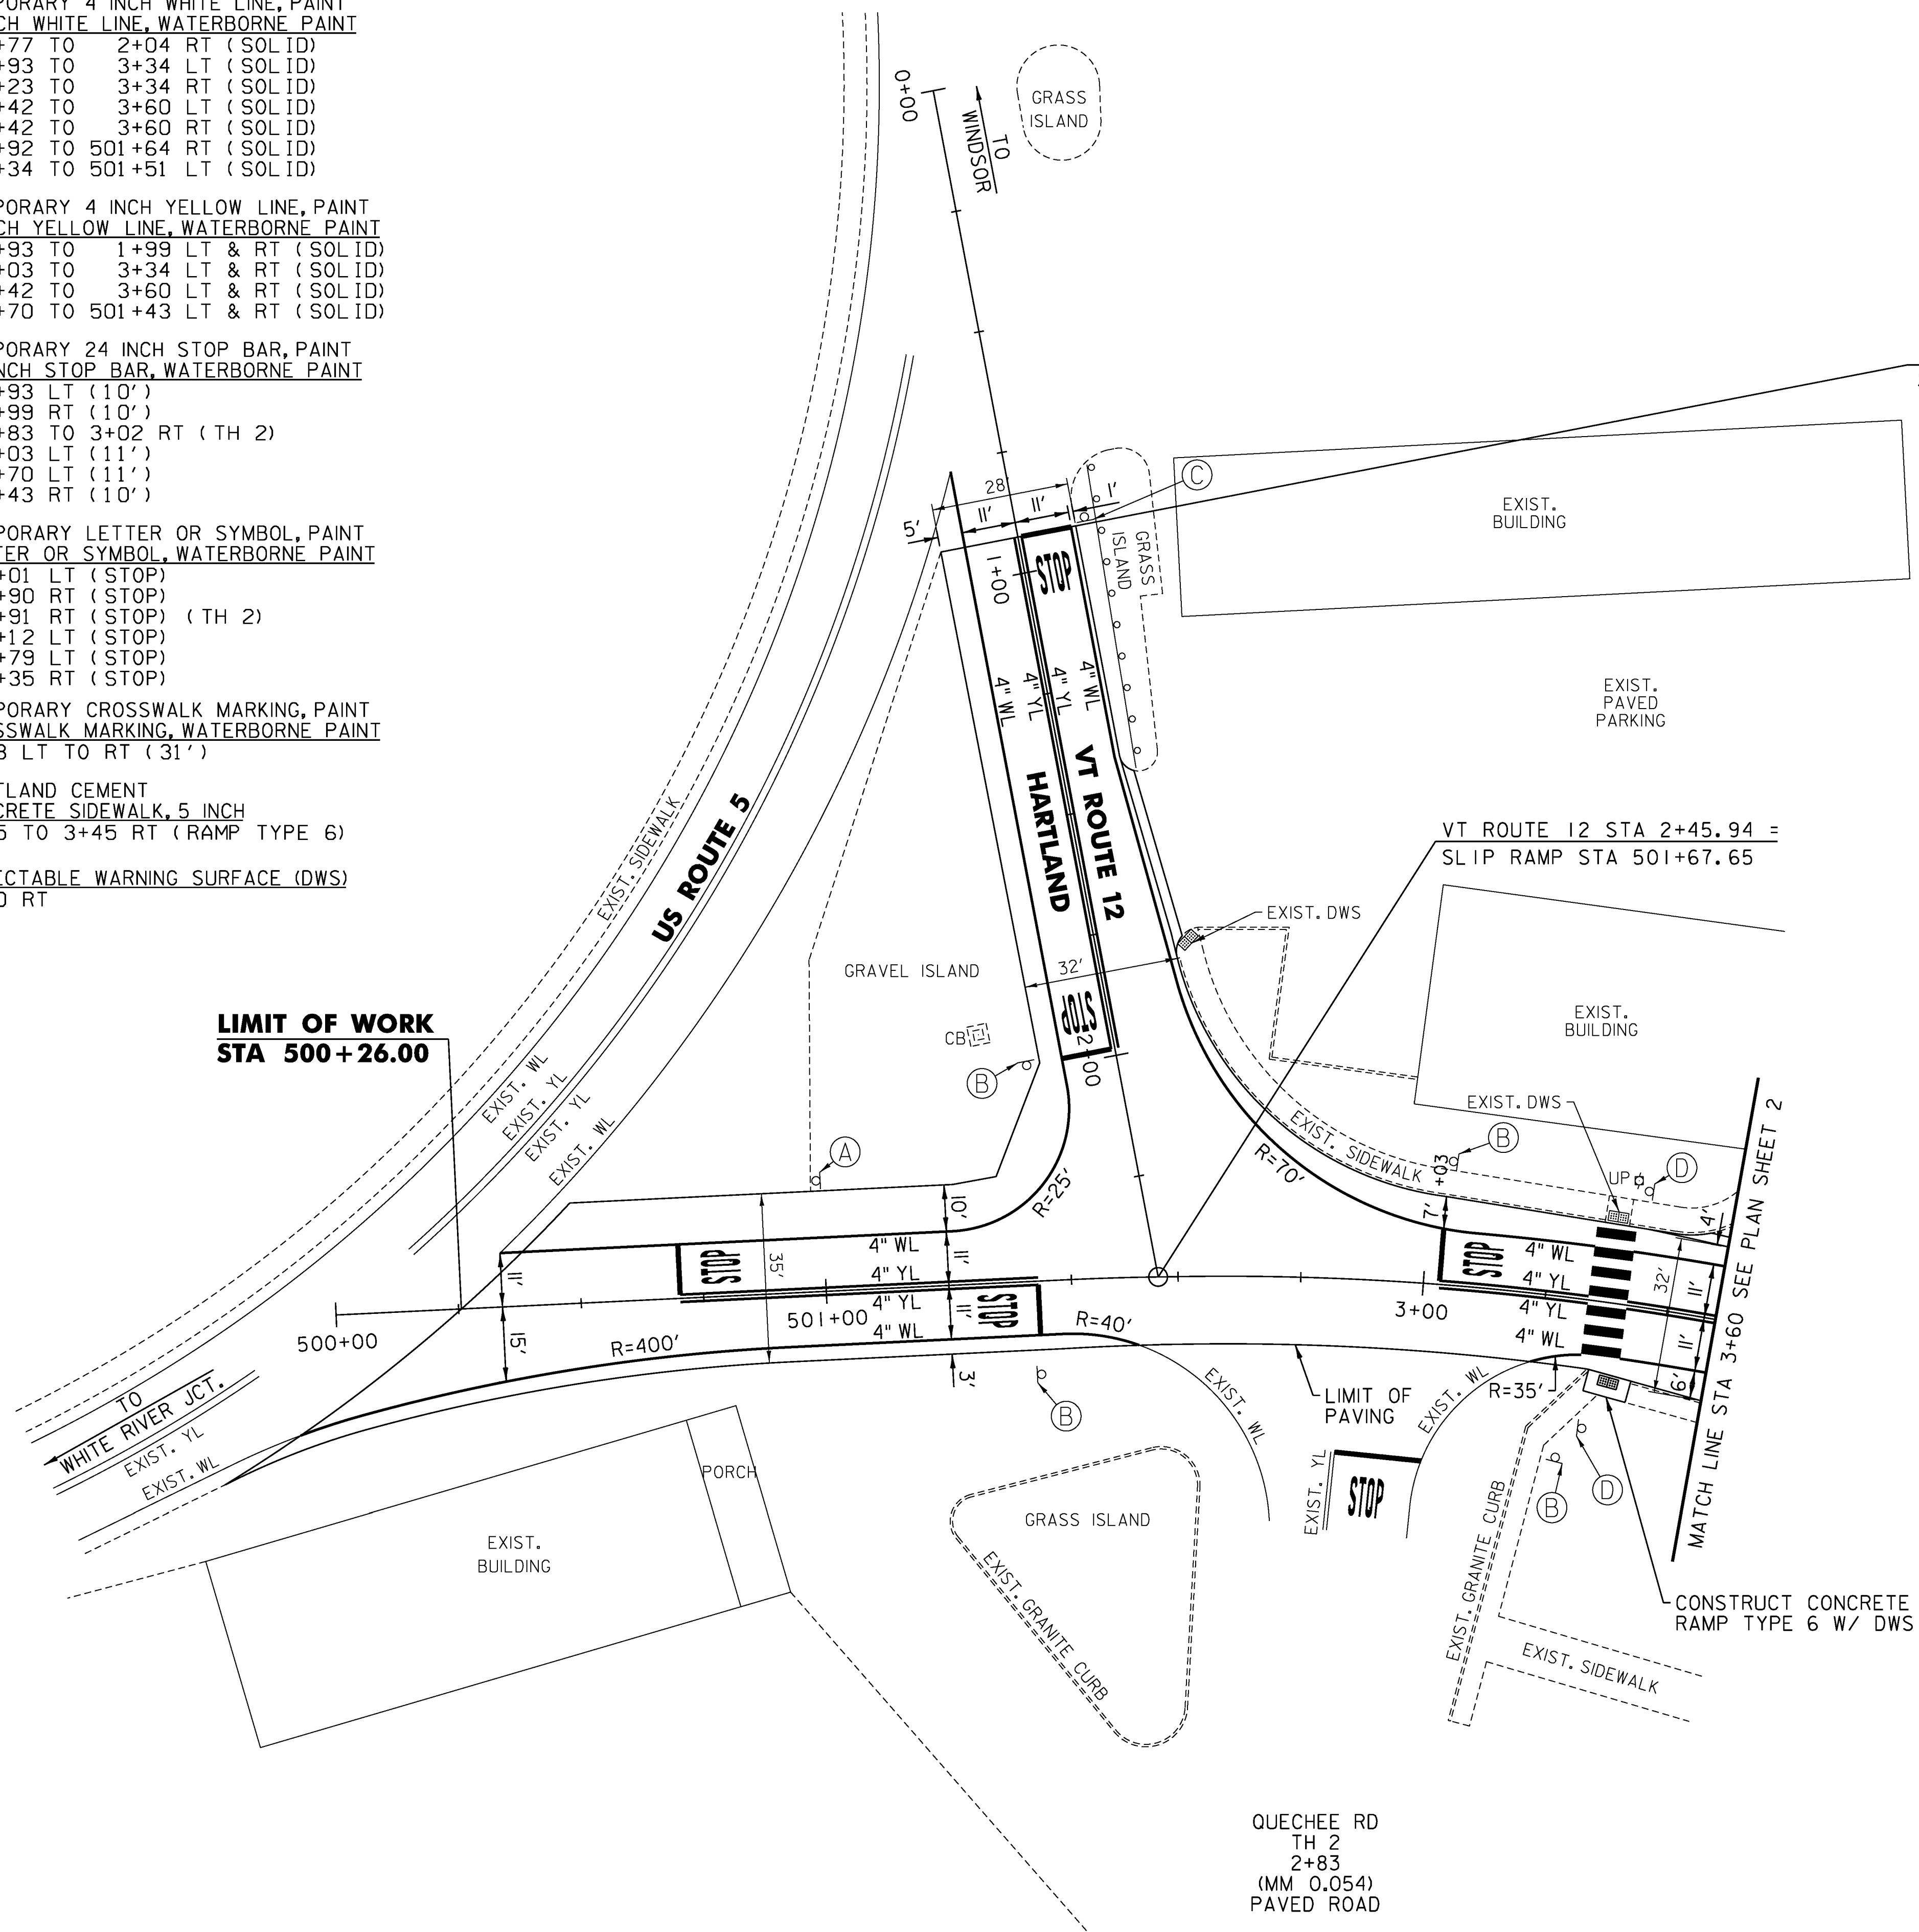

BEGIN HARTLAND STP FPAV(8)
STA 0+93.00 (MM 0.018)
BEGIN COLD PLANE AND OVERLAY

LIMIT OF WORK
STA 500+26.00

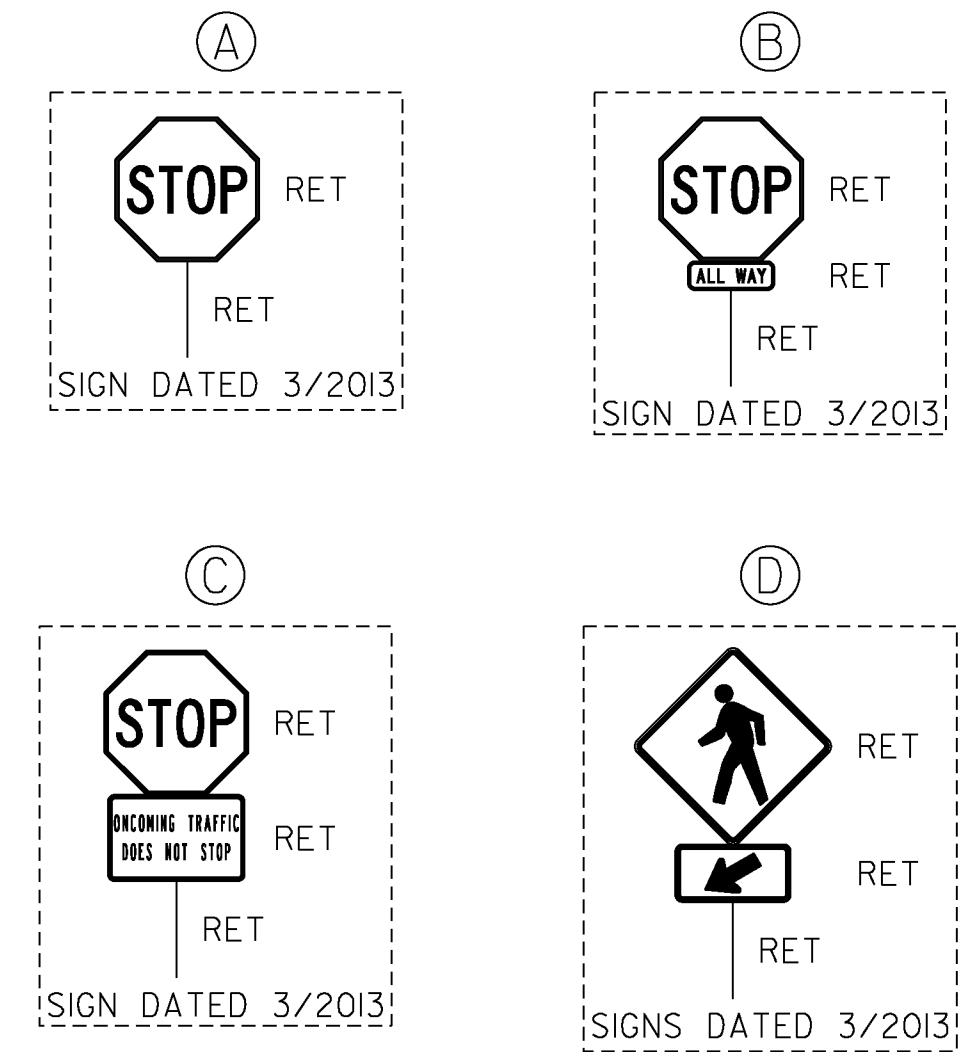

QUECHEE RD
 TH 2
 2+83
 (MM 0.054)
 PAVED ROAD

NOT TO SCALE

PROJECT NAME: HARTLAND
 PROJECT NUMBER: STP FPAV(8)

FILE NAME: z16vl47detall.dgn
 PROJECT LEADER: P. SHEDD
 DESIGNED BY: S. GOODWIN
 PLAN SHEET 1

PLOT DATE: 4/14/2017
 DRAWN BY: S. GOODWIN
 CHECKED BY: N. LEMAY
 SHEET 16 OF 33