

TEMPORARY 4 INCH WHITE LINE, PAINT
 4 INCH WHITE LINE, WATERBORNE PAINT
 (ALL LINES WILL INCLUDE EDGE LINE
 BREAKS AND RADII FOR SIDE ROADS)
 30+00 TO 58+00 LT & RT (SOLID)

TEMPORARY 4 INCH YELLOW LINE, PAINT
 4 INCH YELLOW LINE, WATERBORNE PAINT
 (ALL LINES WILL INCLUDE $\frac{1}{2}$
 BREAKS FOR SIDE ROADS)
 30+00 TO 58+00 LT & RT (SOLID)

REHAB. DROP INLETS, CATCH BASINS,
 OR MANHOLES, CLASS I
 50+84 LT
 52+56 LT

BITUMINOUS CONCRETE
 GUTTERS AND TRAFFIC ISLANDS
 50+60 TO 52+75 LT


STEEL BEAM GUARDRAIL, GALVANIZED
 48+04 TO 48+41.5 RT
 49+45.5 TO 49+83 LT

ANCHOR FOR STEEL BEAM RAIL
 48+16.5 RT
 49+70.5 LT

ADJUST HEIGHT OF GUARDRAIL
 48+41.5 TO 48+54 RT

REMOVAL AND DISPOSAL OF GUARDRAIL
 48+04 TO 48+41.5 RT
 49+45.5 TO 49+83 LT

DELINEATOR WITH STEEL POST
 48+04 RT
 48+30 LT
 49+50 RT
 49+83 LT

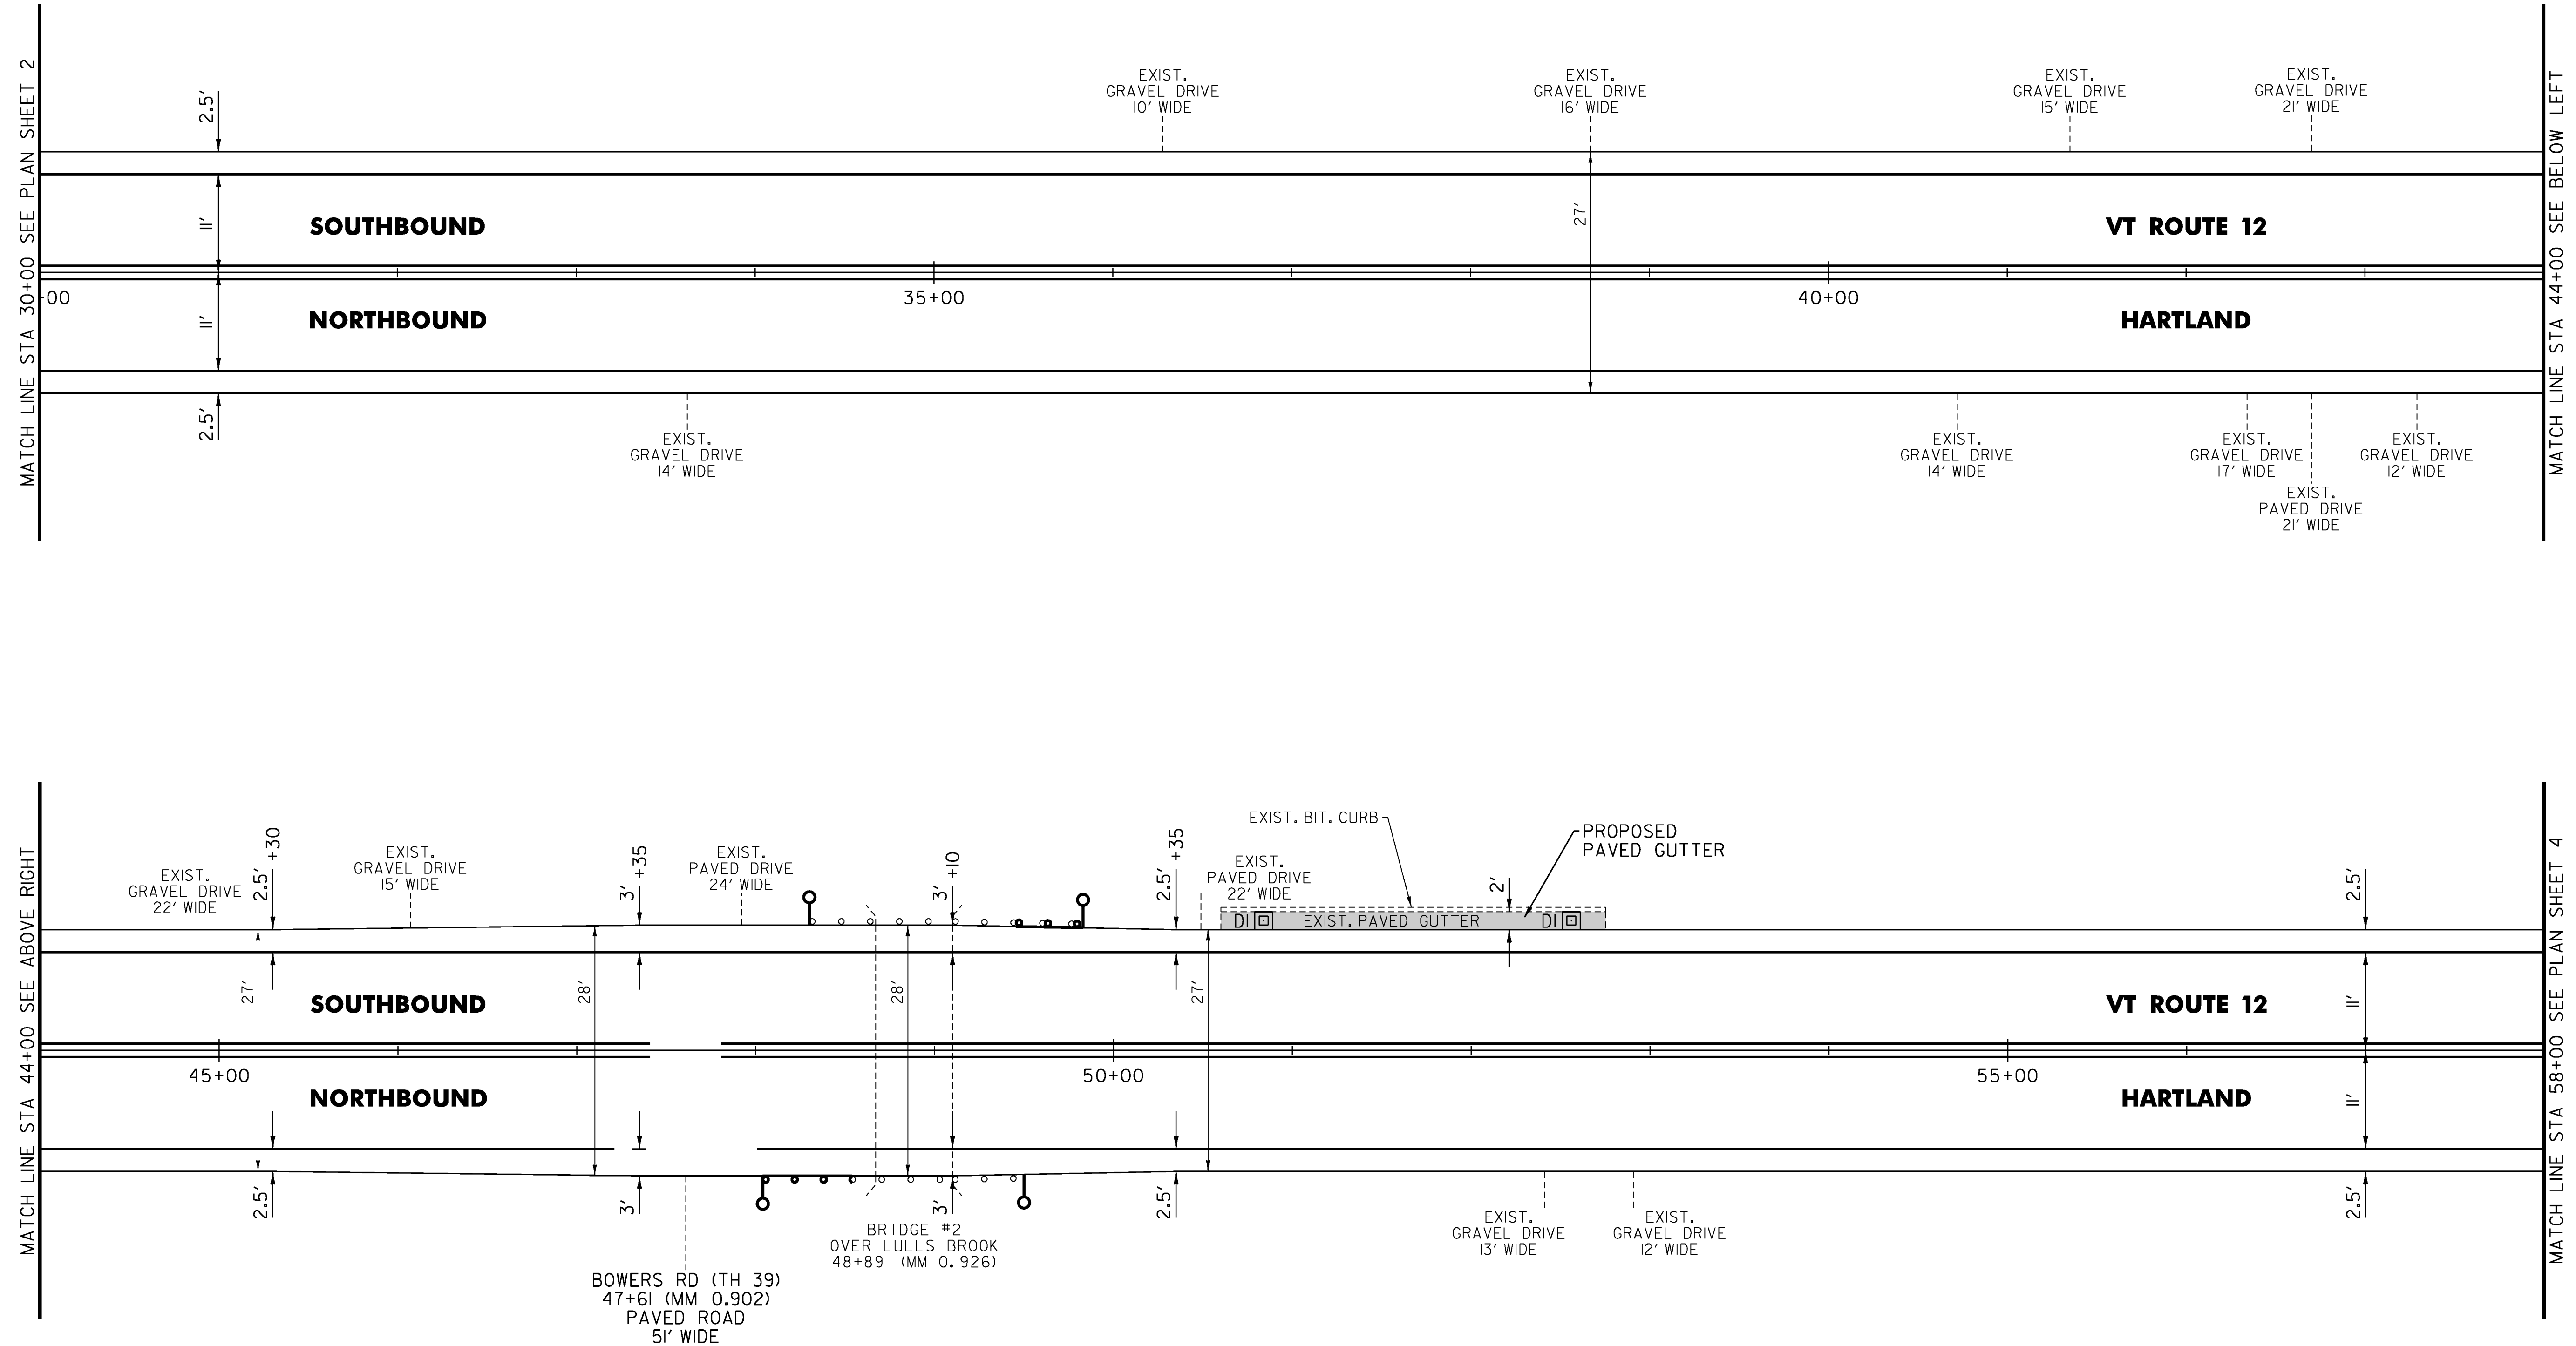

NOT TO SCALE

PROJECT NAME:	HARTLAND	PLOT DATE:	4/14/2017
PROJECT NUMBER:	STP FPAV(8)	DRAWN BY:	S. GOODWIN
FILE NAME:	z16vl47bdr.dgn	CHECKED BY:	P. SHEDD
DESIGNED BY:	N. LEMAY	PLAN SHEET 3	SHEET 18 OF 33