

TEMPORARY 4 INCH WHITE LINE, PAINT  
 4 INCH WHITE LINE, WATERBORNE PAINT  
 (ALL LINES WILL INCLUDE EDGE LINE  
 BREAKS AND RADII FOR SIDE ROADS)  
 58+00 TO 86+00 LT & RT (SOLID)

TEMPORARY 4 INCH YELLOW LINE, PAINT  
 4 INCH YELLOW LINE, WATERBORNE PAINT  
 (ALL LINES WILL INCLUDE  $\square$   
 BREAKS FOR SIDE ROADS)  
 58+00 TO 86+00 LT & RT (SOLID)

REHAB. DROP INLETS, CATCH BASINS,  
 OR MANHOLES, CLASS I  
 77+07 RT



STEEL BEAM GUARDRAIL, GALVANIZED  
 75+53.5 TO 75+91 RT  
 75+57.5 TO 75+95 LT  
 82+21.5 TO 82+59 LT

REMOVAL AND DISPOSAL OF GUARDRAIL  
 75+53.5 TO 75+91 RT  
 75+57.5 TO 75+95 LT  
 82+21.5 TO 82+59 LT

ANCHOR FOR STEEL BEAM RAIL  
 75+78.5 RT  
 75+82.5 LT  
 82+46.5 LT

DELINEATOR WITH STEEL POST  
 74+29 RT  
 74+36 LT  
 75+91 RT  
 75+95 LT  
 81+17 RT  
 81+58 LT  
 81+78 RT  
 82+59 LT

ADJUST HEIGHT OF GUARDRAIL  
 74+36 TO 74+48.5 LT  
 75+28.5 TO 75+53.5 RT  
 75+45 TO 75+57.5 LT

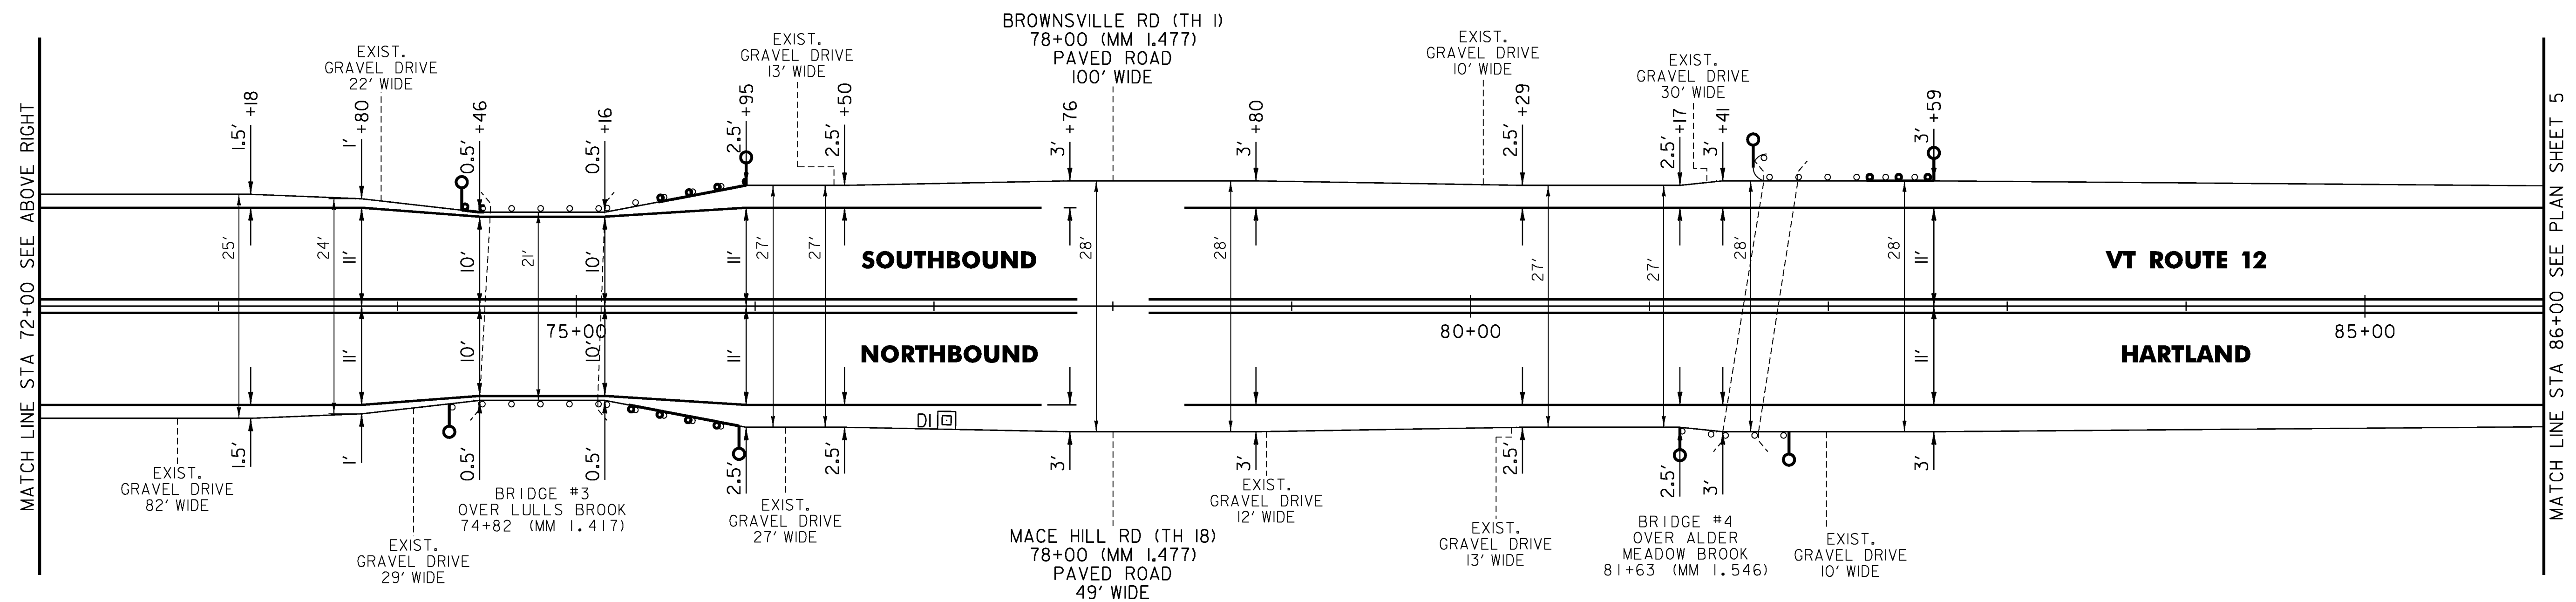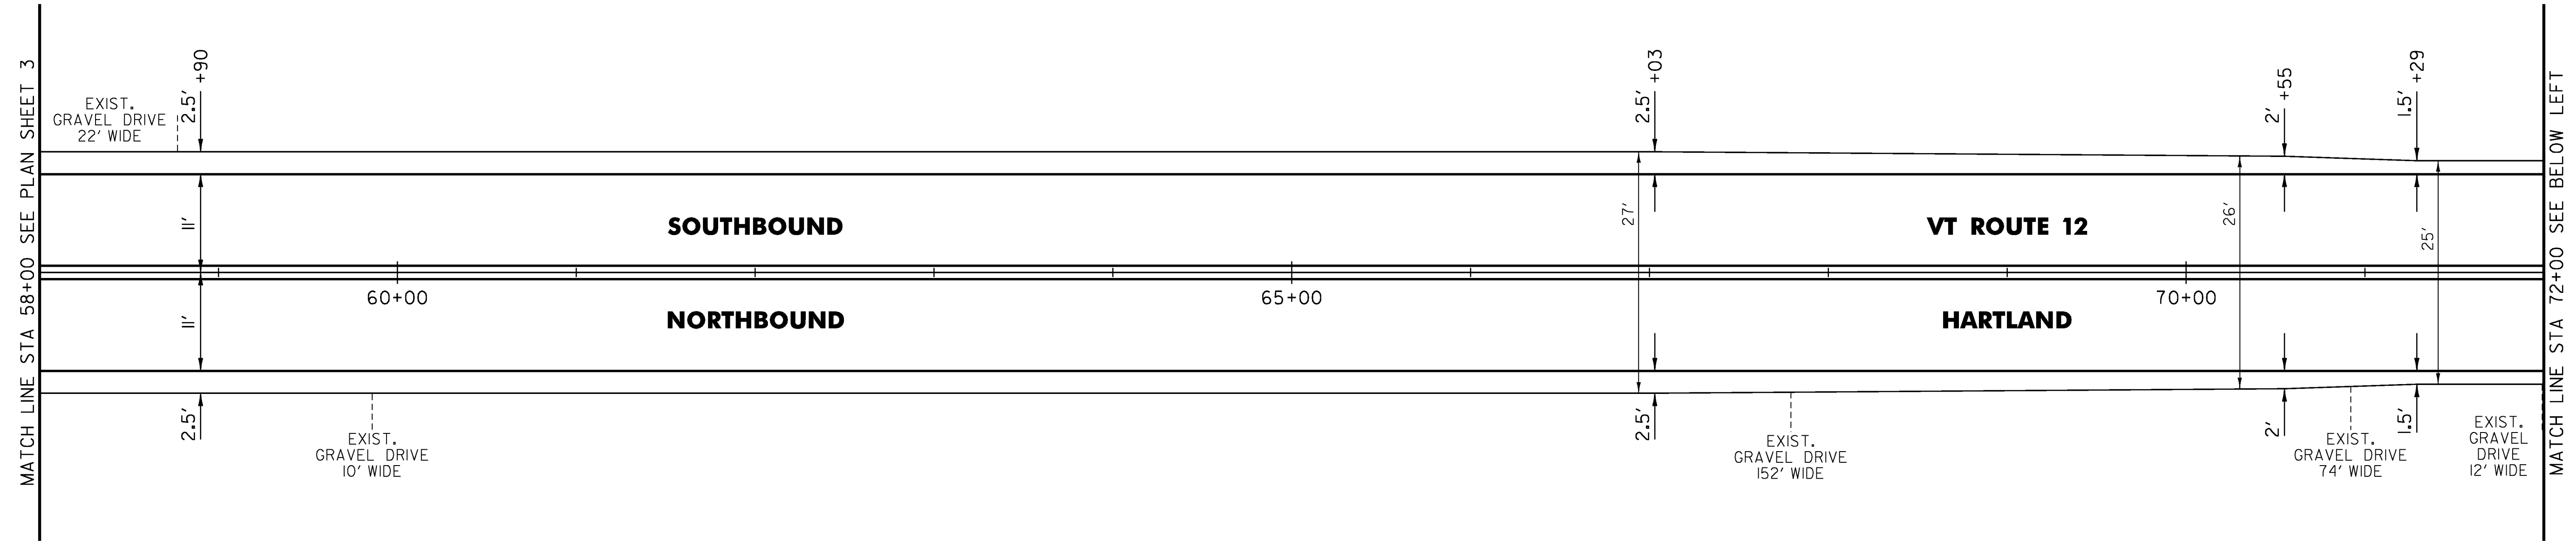

NOT TO SCALE

PROJECT NAME:	HARTLAND	PLOT DATE:	4/14/2017
PROJECT NUMBER:	STP FPAV(8)	DRAWN BY:	S. GOODWIN
FILE NAME:	z16vl47bdr.dgn	CHECKED BY:	P. SHEDD
DESIGNED BY:	N. LEMAY	SHEET	19 OF 33
PLAN SHEET 4			