


TEMPORARY 4 INCH WHITE LINE, PAINT
 4 INCH WHITE LINE, WATERBORNE PAINT
 (ALL LINES WILL INCLUDE EDGE LINE
 BREAKS AND RADII FOR SIDE ROADS)
 86+00 TO 114+00 LT & RT (SOLID)

TEMPORARY 4 INCH YELLOW LINE, PAINT
 4 INCH YELLOW LINE, WATERBORNE PAINT
 (ALL LINES WILL INCLUDE ϕ
 BREAKS FOR SIDE ROADS)
 86+00 TO 88+70 LT & RT (SOLID)
 88+70 TO 94+80 LT (DASHED), RT (SOLID)
 94+80 TO 114+00 LT & RT (SOLID)

REHAB, DROP INLETS, CATCH BASINS,
 OR MANHOLES, CLASS I
~~104+78 RT~~
 NO REHAB

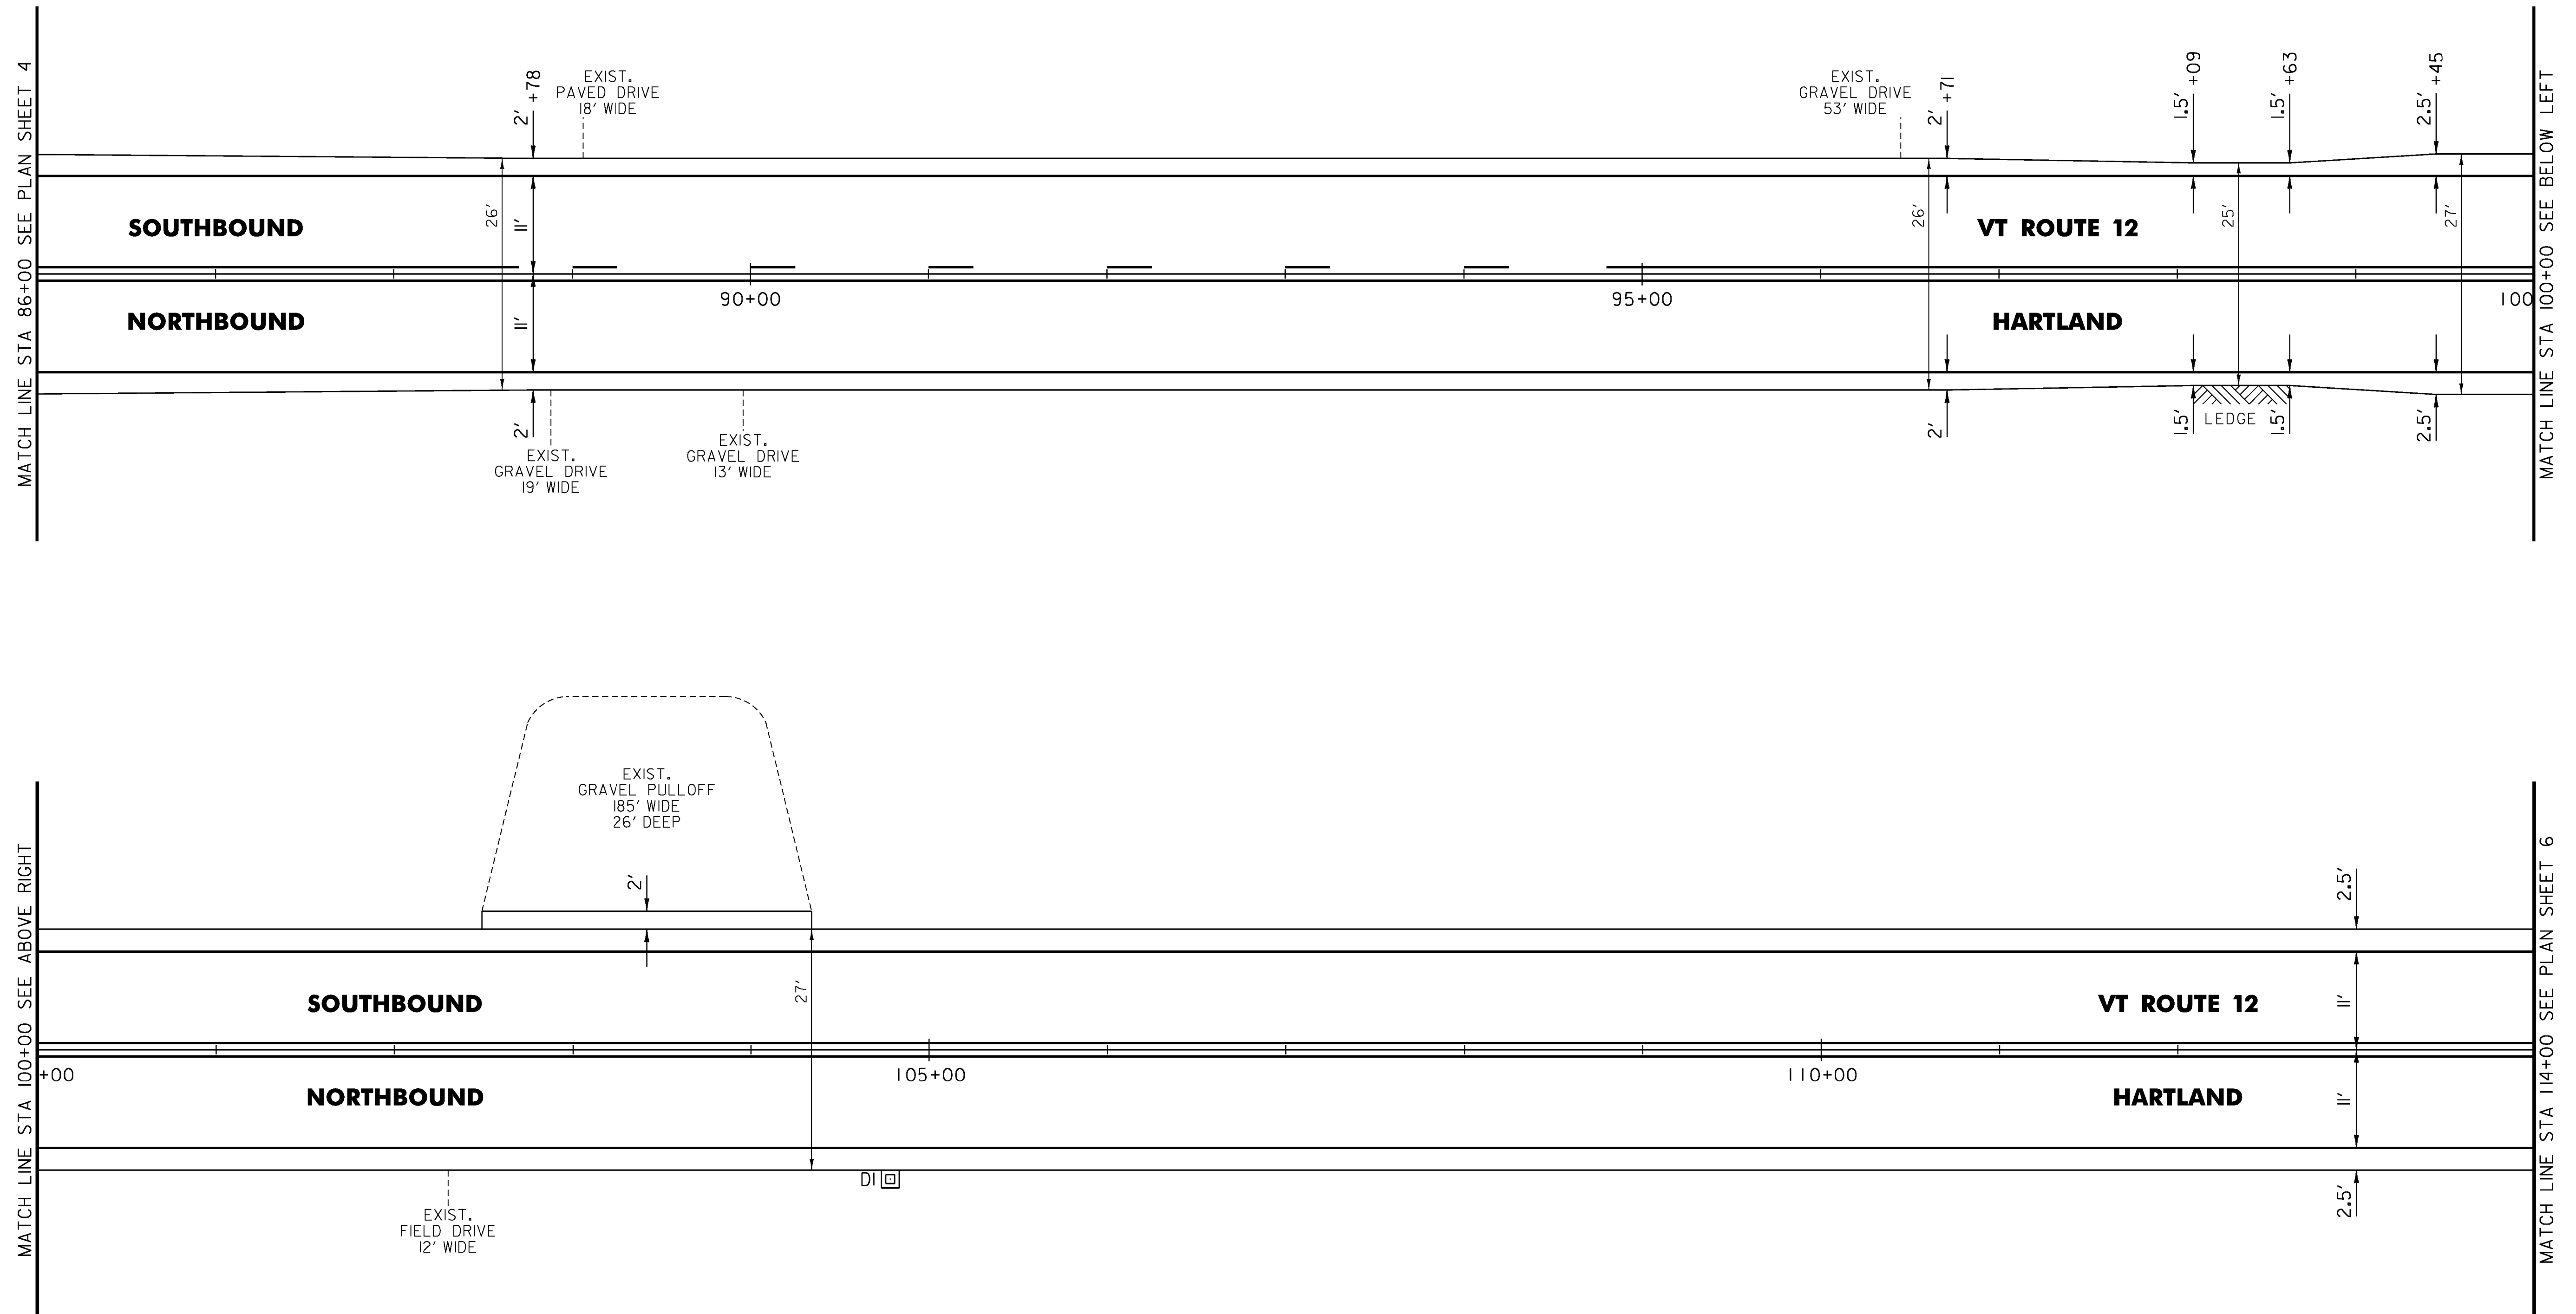

NOT TO SCALE

PROJECT NAME:	HARTLAND	PLOT DATE:	4/14/2017
PROJECT NUMBER:	STP FPAV(8)	DRAWN BY:	S. GOODWIN
FILE NAME:	z16v147bdr.dgn	DESIGNED BY:	N. LEMAY
PROJECT LEADER:	P. SHEDD	CHECKED BY:	P. SHEDD
PLAN SHEET 5		SHEET	20 OF 33