

TEMPORARY 4 INCH WHITE LINE, PAINT  
 4 INCH WHITE LINE, WATERBORNE PAINT  
 (ALL LINES WILL INCLUDE EDGE LINE  
 BREAKS AND RADII FOR SIDE ROADS)  
 170+00 TO 198+00 LT & RT (SOLID)

TEMPORARY 4 INCH YELLOW LINE, PAINT  
 4 INCH YELLOW LINE, WATERBORNE PAINT  
 (ALL LINES WILL INCLUDE  $\square$   
 BREAKS FOR SIDE ROADS)  
 170+00 TO 198+00 LT & RT (SOLID)

STEEL BEAM GUARDRAIL, GALVANIZED  
 189+20.5 TO 189+58 LT  
 190+13 TO 190+50.5 LT  
 191+88 TO 192+25.5 RT



ANCHOR FOR STEEL BEAM RAIL  
 189+45.5 LT  
 190+25.5 LT  
 192+00.5 RT

ADJUST HEIGHT OF GUARDRAIL  
 170+00 TO 171+69.5 LT  
 176+69.5 TO 178+69.5 LT  
 181+44.5 TO 182+44.5 LT  
 190+50.5 TO 191+00.5 LT  
 194+63 TO 195+38 RT  
 196+63 TO 197+13 RT

REPLACE GUARDRAIL POST ASSEMBLY  
 REPLACE GUARDRAIL BEAM UNIT  
 197+13 TO 197+38 RT

REMOVAL AND DISPOSAL OF GUARDRAIL  
 189+20.5 TO 189+58 LT  
 190+13 TO 190+50.5 LT  
 191+88 TO 192+25.5 RT

DELINEATOR WITH STEEL POST  
 189+58 LT  
 190+13 LT  
 191+88 RT  
 194+11 LT

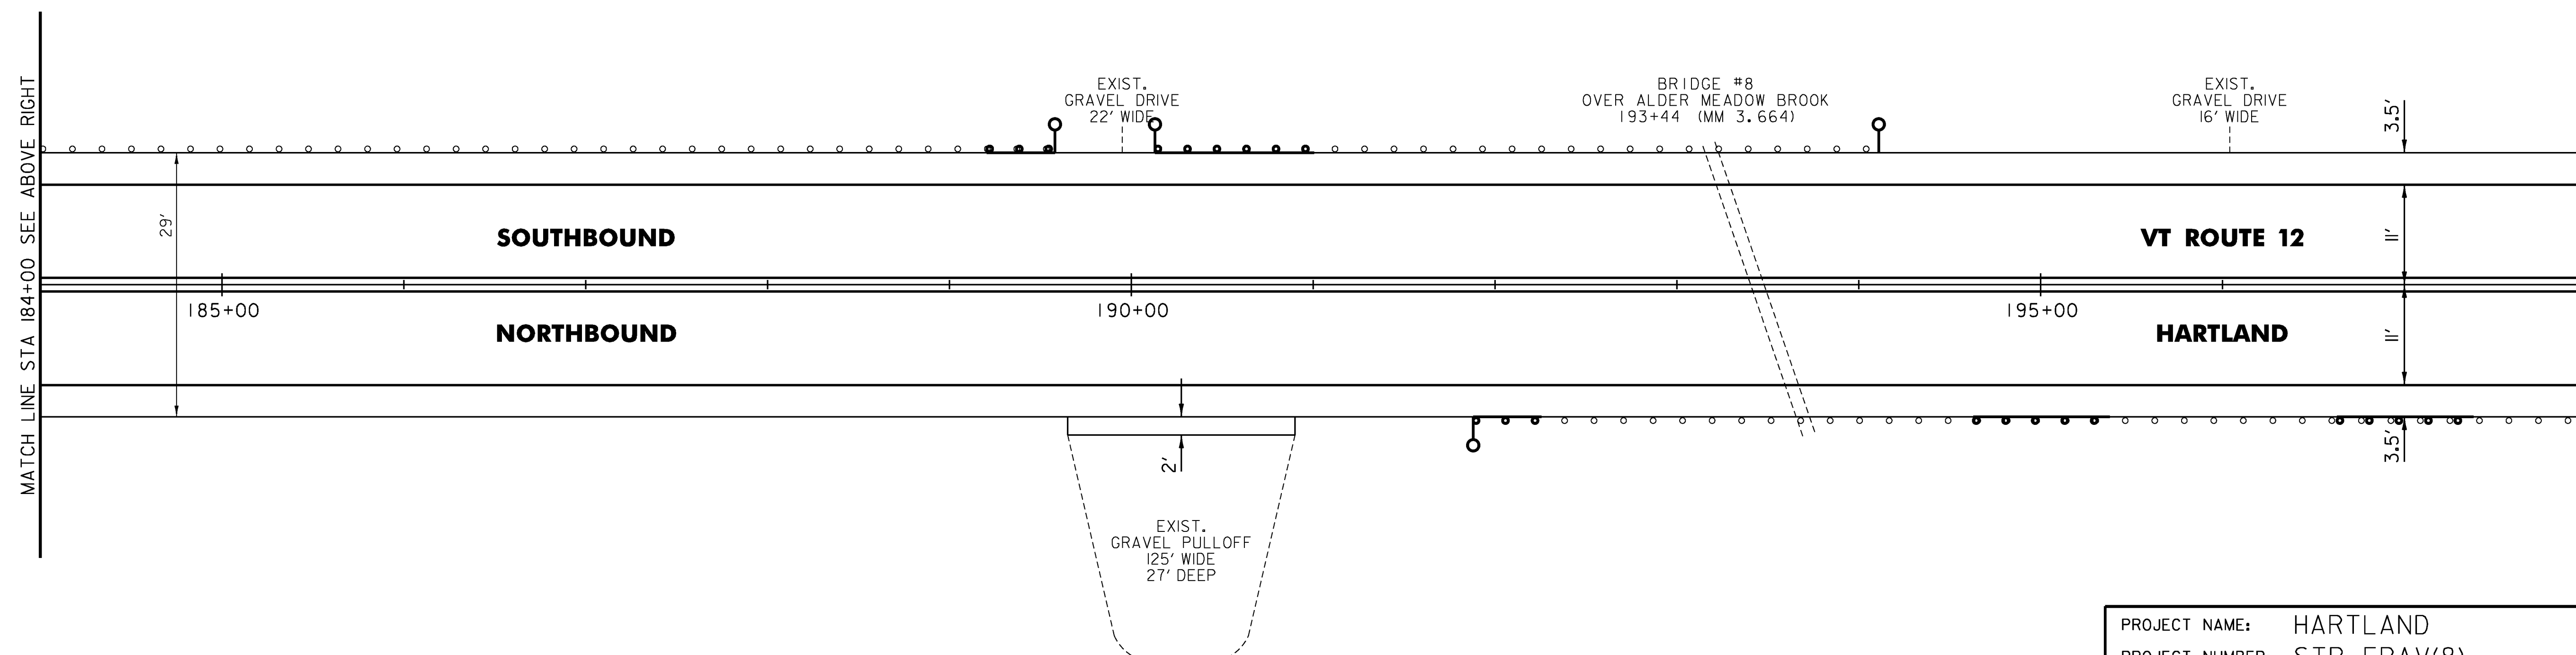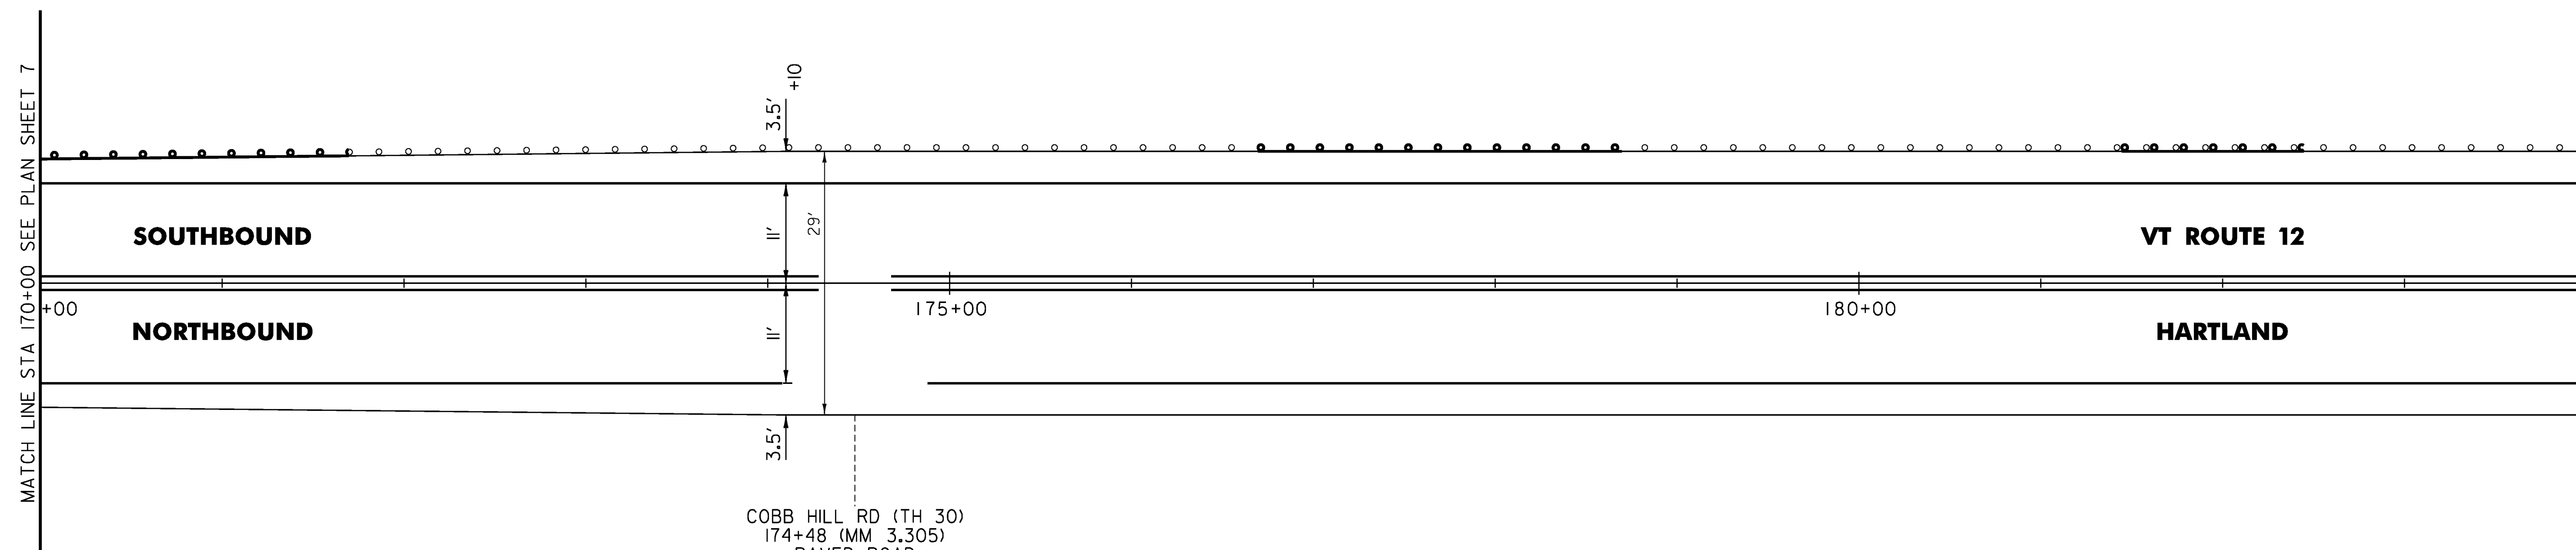

NOT TO SCALE

PROJECT NAME:	HARTLAND	PLOT DATE:	4/14/2017
PROJECT NUMBER:	STP FPAV(8)	DRAWN BY:	S. GOODWIN
FILE NAME:	z16vl47bdr.dgn	CHECKED BY:	P. SHEDD
DESIGNED BY:	N. LEMAY	PLAN SHEET	8
		SHEET	23 OF 33