



TEMPORARY 4 INCH WHITE LINE, PAINT
 4 INCH WHITE LINE, WATERBORNE PAINT
 (ALL LINES WILL INCLUDE EDGE LINE
 BREAKS AND RADII FOR SIDE ROADS)
 226+00 TO 254+00 LT & RT (SOL ID)

TEMPORARY 4 INCH YELLOW LINE, PAINT
 4 INCH YELLOW LINE, WATERBORNE PAINT
 (ALL LINES WILL INCLUDE ϕ
 BREAKS FOR SIDE ROADS)
 226+00 TO 254+00 LT & RT (SOL ID)

STEEL BEAM GUARDRAIL, GALVANIZED
 232+07.5 TO 232+45 RT
 ANCHOR FOR STEEL BEAM RAIL
 232+32.5 RT

ADJUST HEIGHT OF GUARDRAIL
 231+32.5 TO 231+57.5 RT

REMOVAL AND DISPOSAL OF GUARDRAIL
 232+07.5 TO 232+45 RT
 DELINEATOR WITH STEEL POST
 232+45 RT

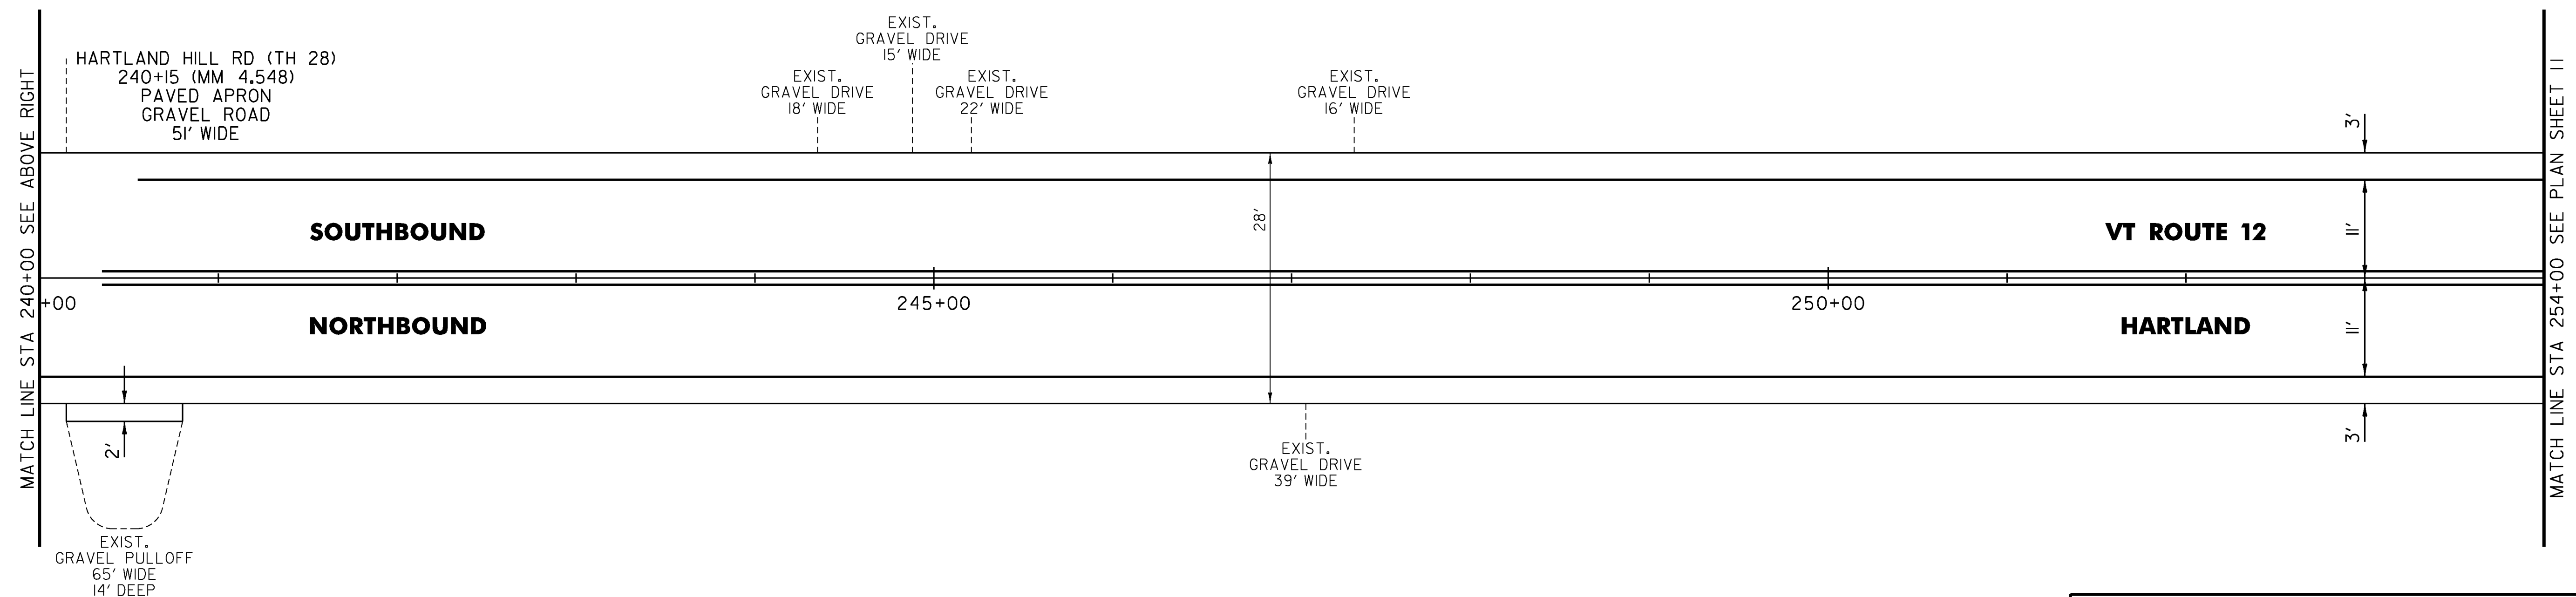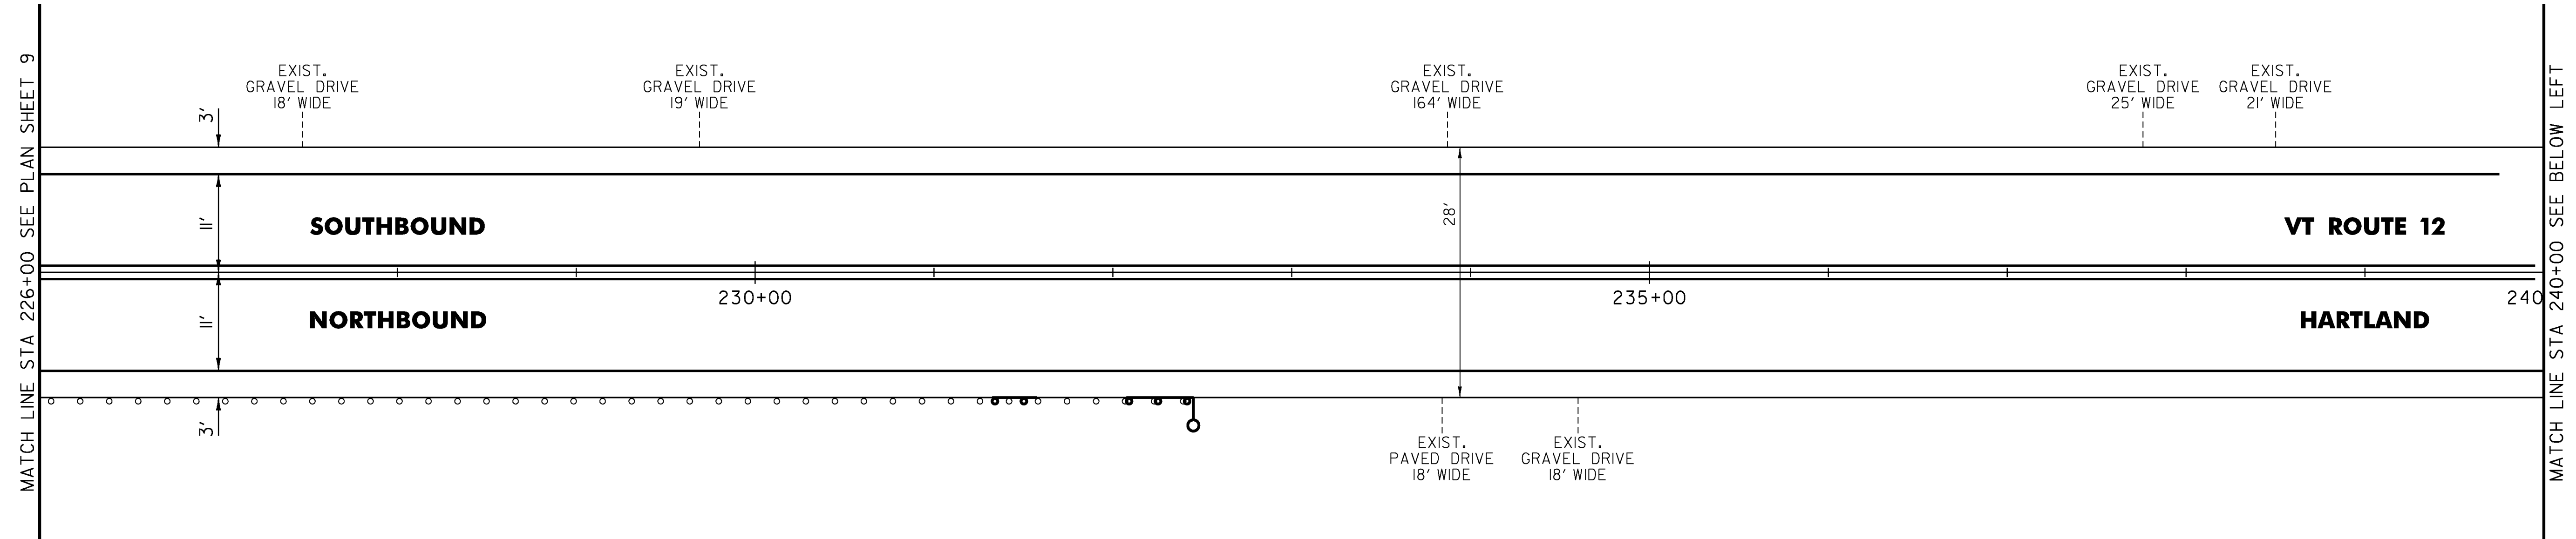

NOT TO SCALE

PROJECT NAME:	HARTLAND	PLOT DATE:	4/14/2017
PROJECT NUMBER:	STP FPAV(8)	DRAWN BY:	S. GOODWIN
FILE NAME:	z16vl47bdr.dgn	CHECKED BY:	P. SHEDD
DESIGNED BY:	N. LEMAY	PLAN SHEET	10
		SHEET	25 OF 33