


TEMPORARY 4 INCH WHITE LINE, PAINT  
 4 INCH WHITE LINE, WATERBORNE PAINT  
 (ALL LINES WILL INCLUDE EDGE LINE  
 BREAKS AND RADII FOR SIDE ROADS)  
 366+00 TO 394+00 LT & RT ( SOL ID)

TEMPORARY 4 INCH YELLOW LINE, PAINT  
 4 INCH YELLOW LINE, WATERBORNE PAINT  
 (ALL LINES WILL INCLUDE  $\phi$   
 BREAKS FOR SIDE ROADS)  
 366+00 TO 394+00 LT & RT ( SOL ID)

STEEL BEAM GUARDRAIL, GALVANIZED  
 393+61 TO 393+98.5 RT  
 ANCHOR FOR STEEL BEAM RAIL  
 393+73.5 RT

ADJUST HEIGHT OF GUARDRAIL  
 369+00 TO 369+50 LT

REMOVAL AND DISPOSAL OF GUARDRAIL  
 393+61 TO 393+98.5 RT  
 DELINEATOR WITH STEEL POST  
 369+00 LT  
 369+50 LT  
 393+61 RT

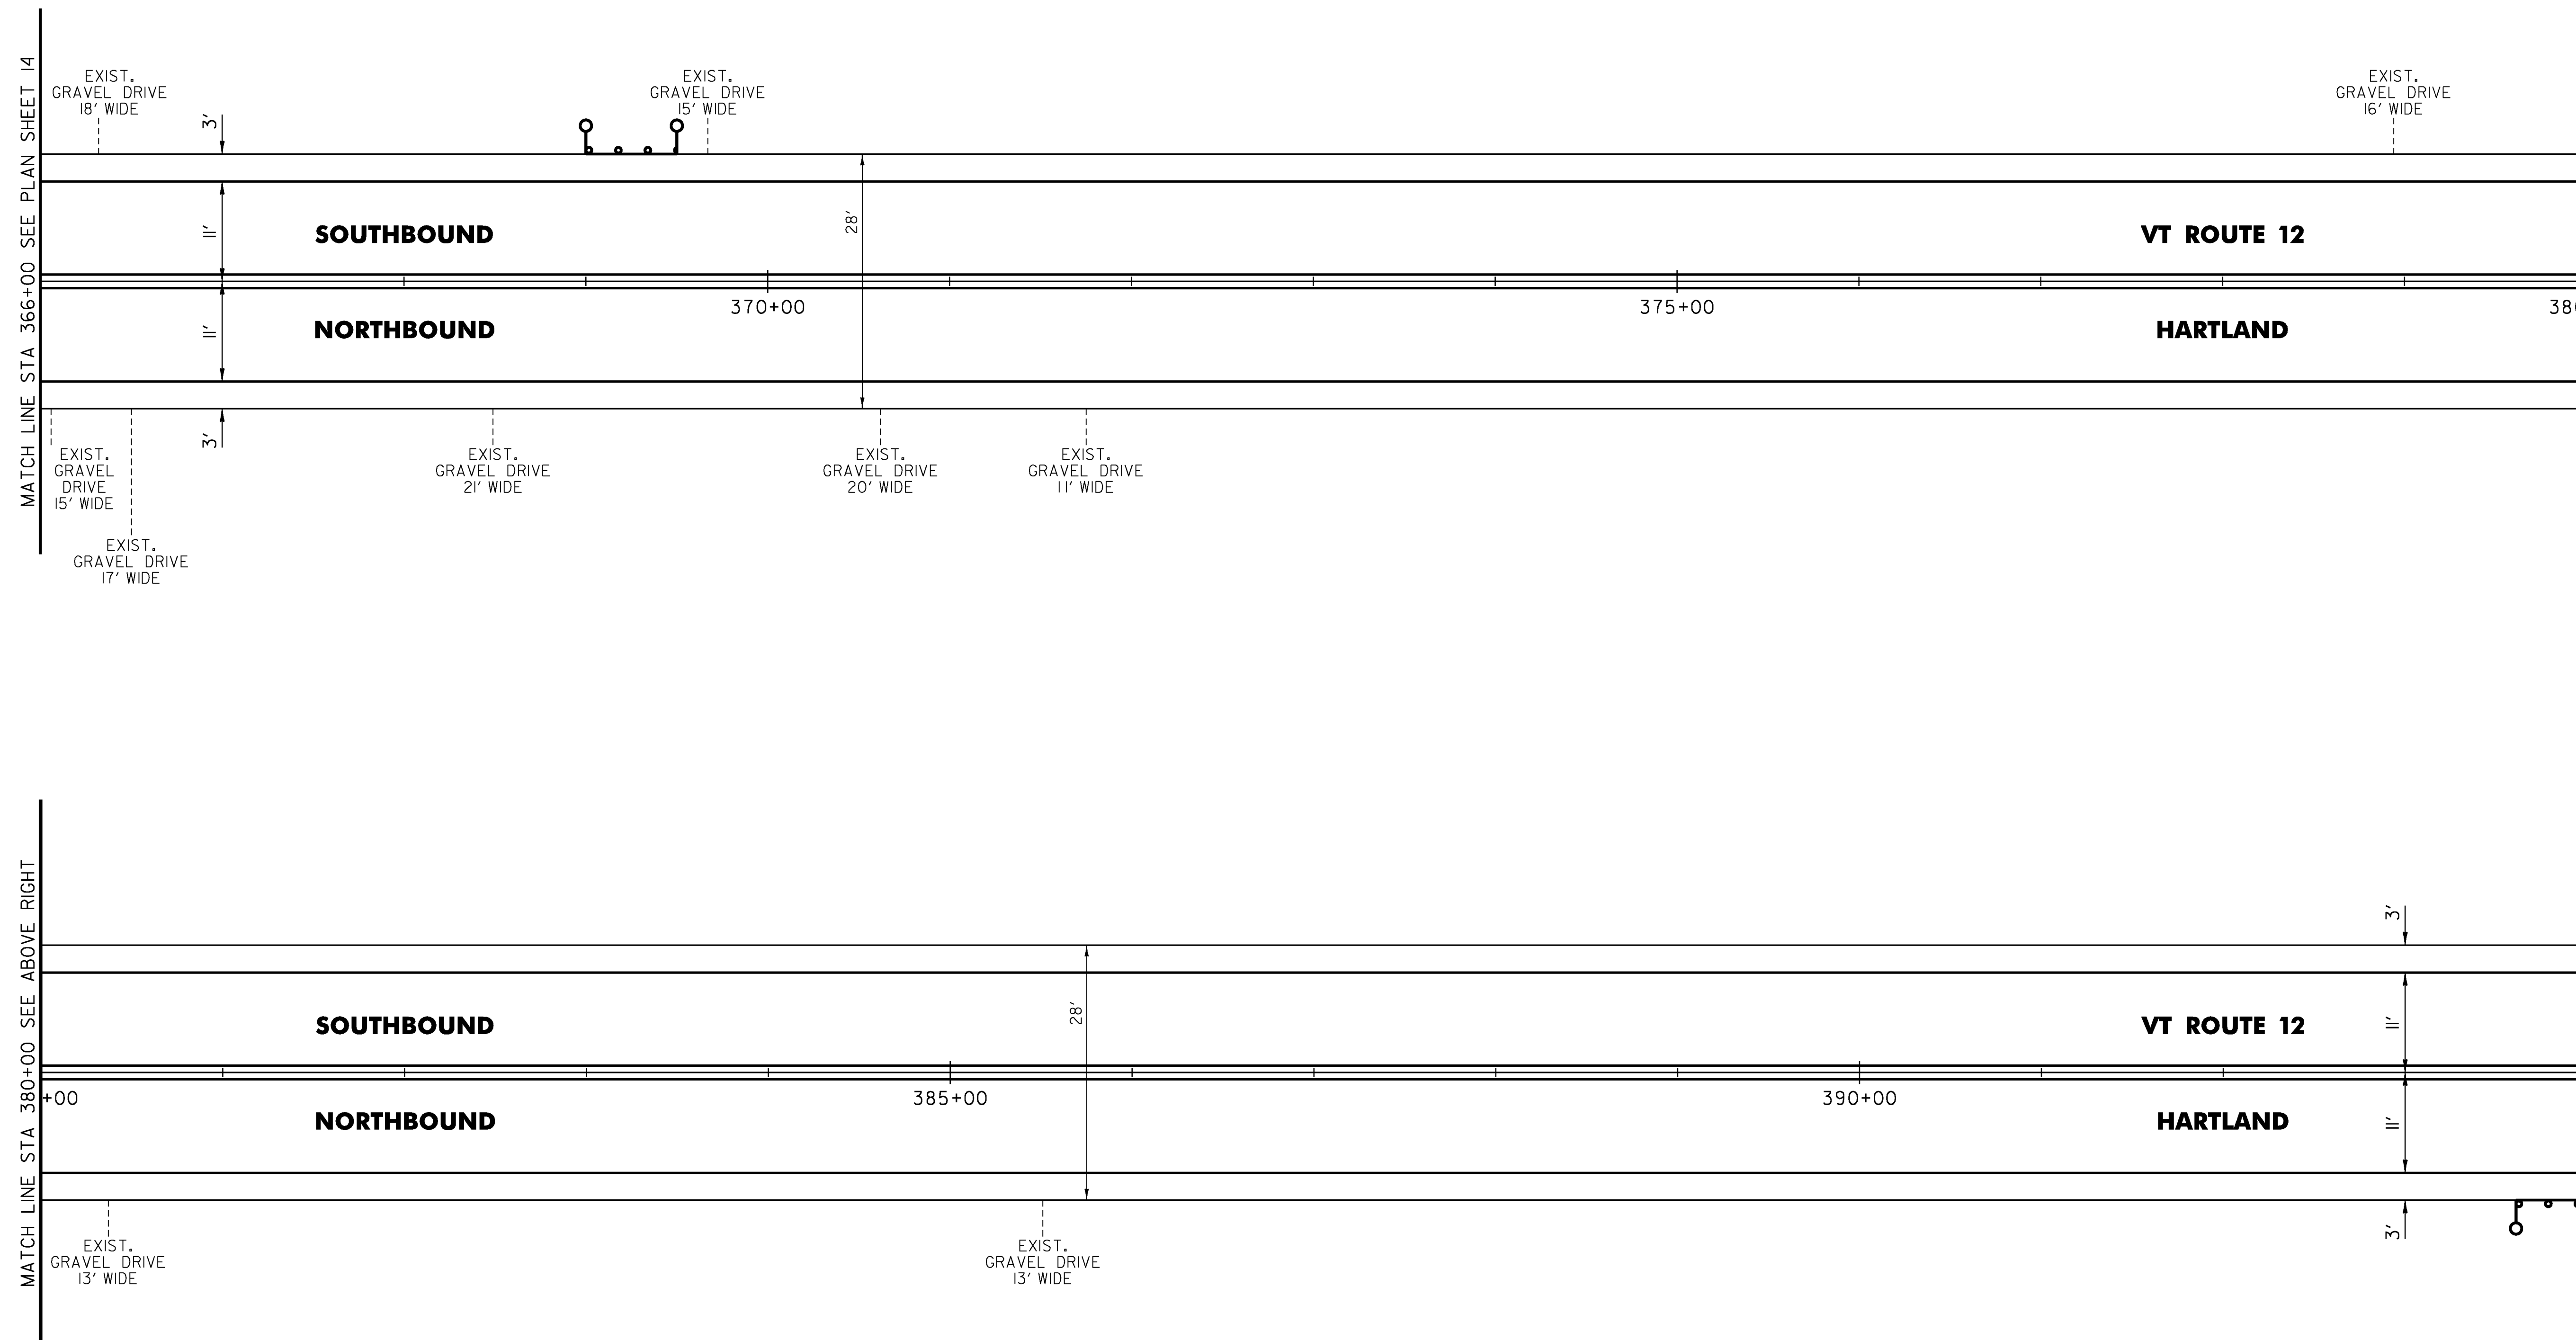

NOT TO SCALE

PROJECT NAME:	HARTLAND	PLOT DATE:	4/14/2017
PROJECT NUMBER:	STP FPAV(8)	DRAWN BY:	S. GOODWIN
FILE NAME:	z16vl47bdr.dgn	CHECKED BY:	P. SHEDD
DESIGNED BY:	N. LEMAY	PLAN SHEET 15	SHEET 30 OF 33