

STATE OF VERMONT AGENCY OF TRANSPORTATION





PROPOSED IMPROVEMENT TOWNS OF DANVILLE & ST. JOHNSBURY COUNTY OF CALEDONIA

VT ROUTE 2B (MAJOR COLLECTOR & MINOR ARTERIAL)

BEGINNING IN THE TOWN OF DANVILLE ON VT ROUTE 2B AT MM 0.000 AND EXTENDING EASTERLY
ALONG VT ROUTE 2B FOR A DISTANCE OF 18,263.52 FEET (3.459 MILES) AND STOPPING AT MM 1.543 IN THE TOWN OF ST. JOHNSBURY.

LENGTH OF ROADWAY = 18,263.52 FEET (3.459 MILES)
LENGTH OF PROJECT = 18,263.52 FEET (3.459 MILES)

WORK TO BE PERFORMED UNDER THIS PROJECT INCLUDES PAVING THE
EXISTING HIGHWAY, PAVEMENT MARKINGS, GUARDRAIL AND OTHER HIGHWAY RELATED ITEMS.

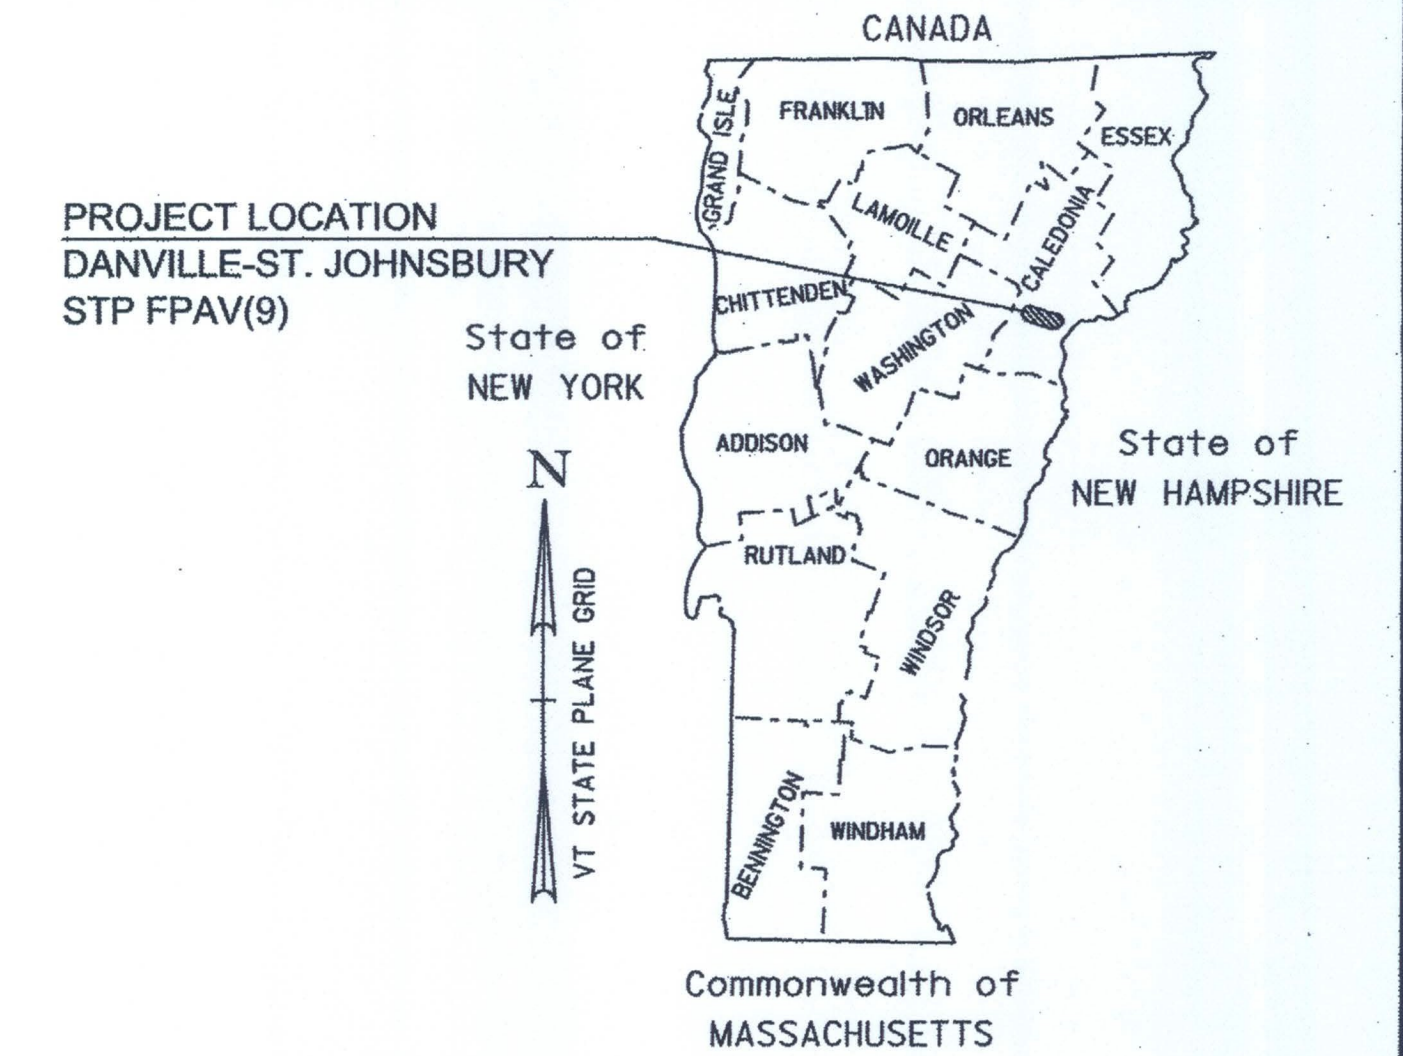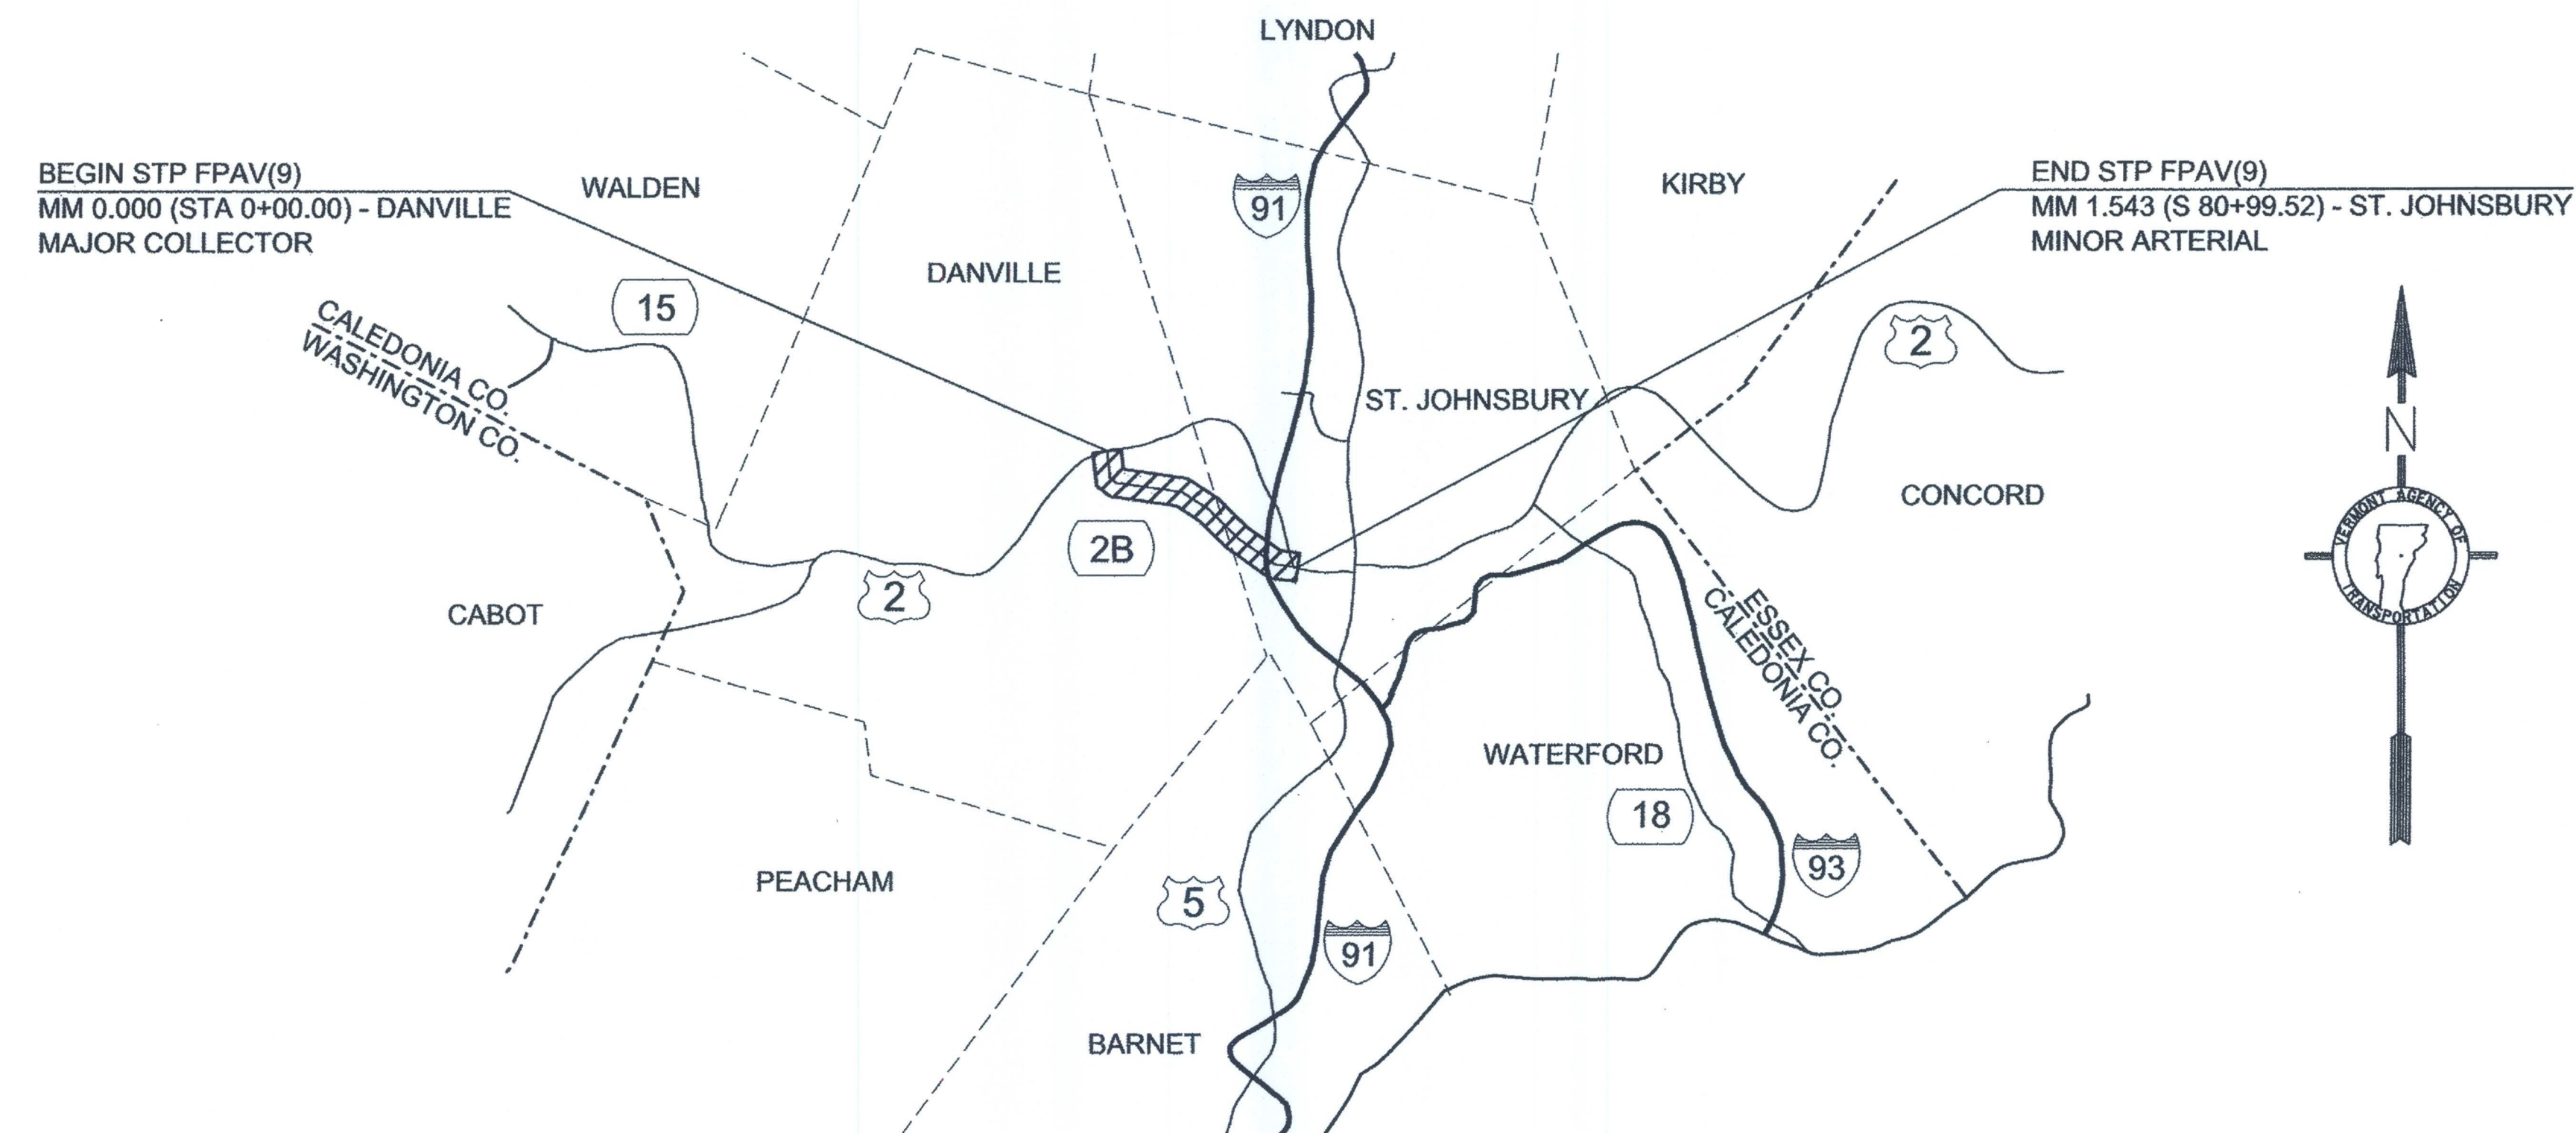

RECORD PLANS	
CONTRACTOR:	PIKE INDUSTRIES, INC. - BERLIN, VT
RESIDENT ENGINEER:	JAY STRONG
CONSTRUCTION BEGAN:	SEPTEMBER 05, 2017
CONSTRUCTION COMPLETE:	MAY 01, 2018
RECORD PLANS BY:	JAY STRONG & JESSE IVES
I HEREBY CERTIFY THAT ALL THE CONSTRUCTION REQUIRED BY THIS SET OF DRAWINGS HAS BEEN ACCOMPLISHED AS INDICATED HEREIN.	
BY	RESIDENT ENGINEER
DATE	5/30/2018
NOTE: Any further information concerning final quantities, amounts or other details relative to this project may be found by contacting Vtrans Records Management.	

CONSTRUCTION IS TO BE CARRIED ON IN ACCORDANCE WITH THESE PLANS AND THE STANDARD SPECIFICATIONS FOR CONSTRUCTION DATED 2011, AS APPROVED BY THE FEDERAL HIGHWAY ADMINISTRATION ON JULY 20, 2011 FOR USE ON THIS PROJECT, INCLUDING ALL SUBSEQUENT REVISIONS AND SUCH REVISED SPECIFICATIONS AND SPECIAL PROVISIONS AS ARE INCORPORATED IN THESE PLANS.

QUALITY ASSURANCE PROGRAM : LEVEL 1	
SURVEYED BY :	NA
SURVEYED DATE :	NA
DATUM	
VERTICAL	NA
HORIZONTAL	NA

NOT TO SCALE

BUILT AS DESIGNED

DIRECTOR OF PROJECT DELIVERY	
APPROVED	DATE 5/19/2017
PROJECT MANAGER : BRANDON KIPP, P.E.	
PROJECT NAME : DANVILLE-ST. JOHNSBURY	
PROJECT NUMBER : STP FPAV(9)	
SHEET 1 OF 33 SHEETS	