


BRIDGE #1

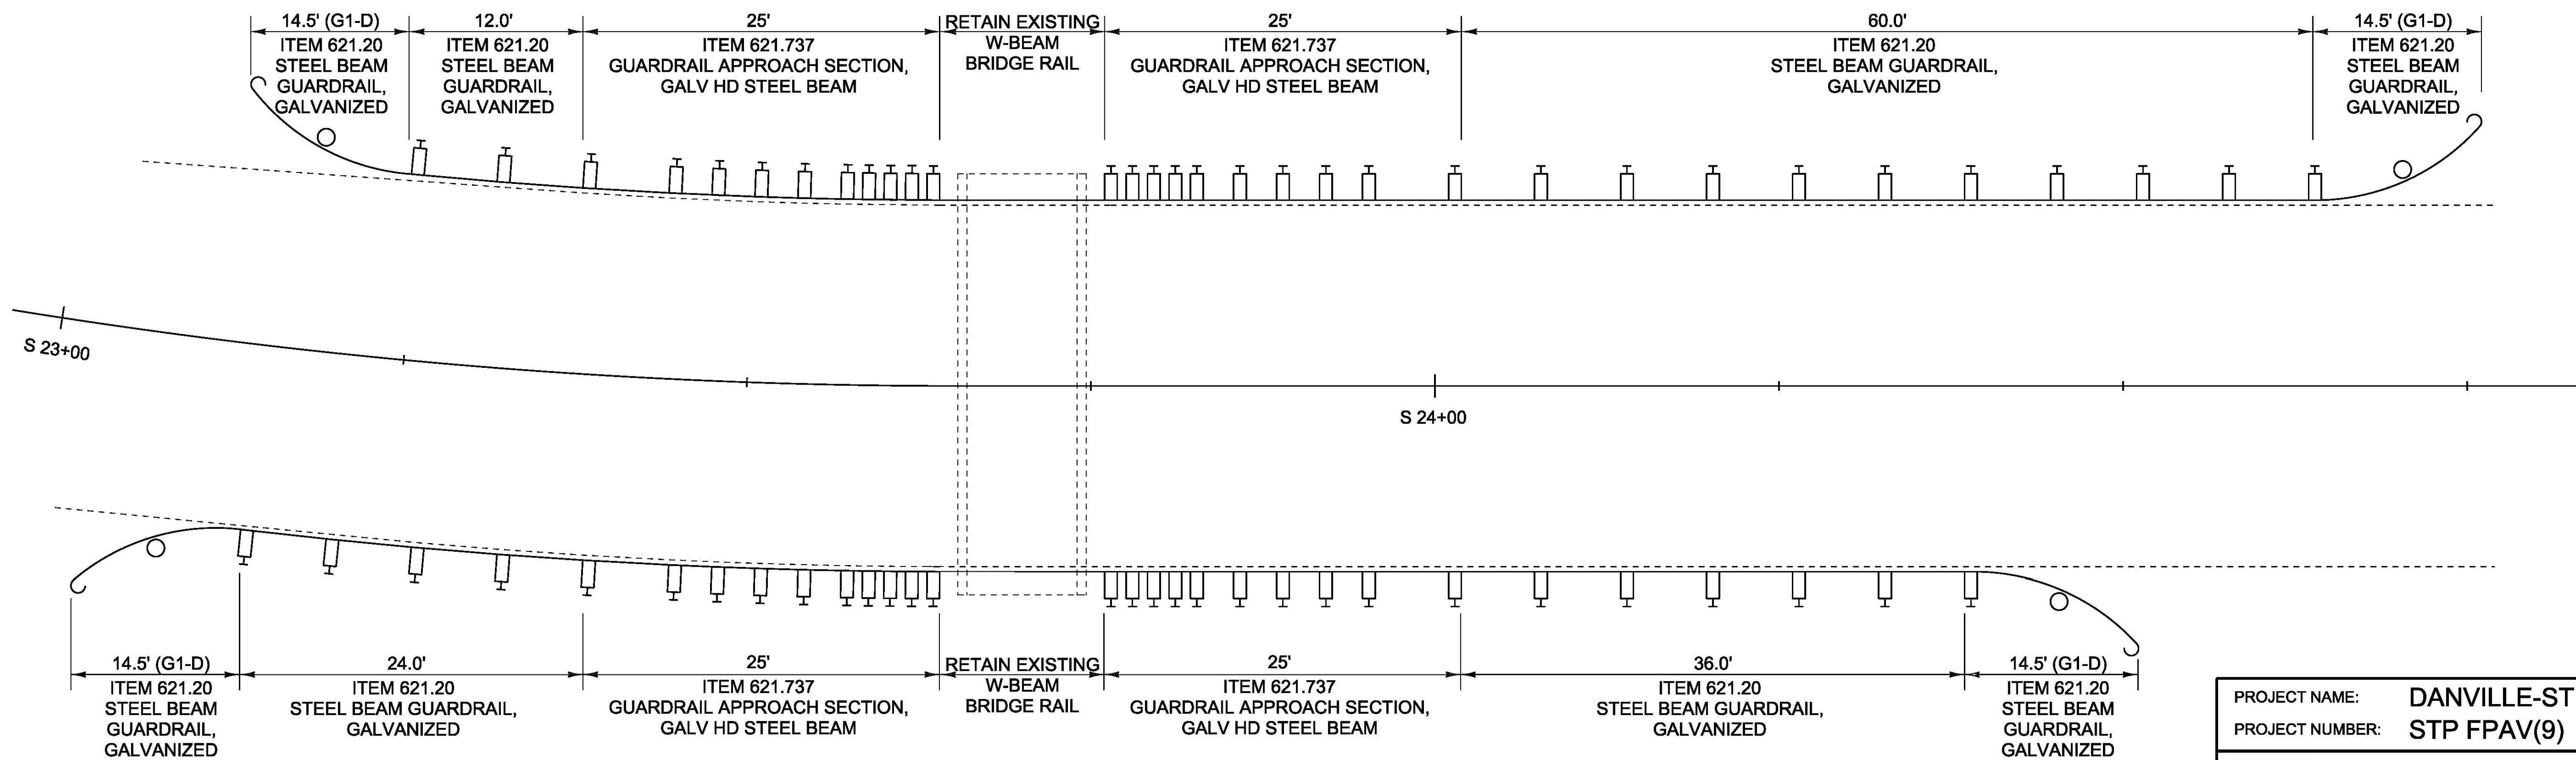

BRIDGE #5

PROJECT NAME:	DANVILLE-ST. JOHNSBURY
PROJECT NUMBER:	STP FPAV(9)
FILE NAME:	16v148.dgn
PROJECT LEADER:	B. KIPP
DESIGNED BY:	B. KIPP
BRIDGE RAILING DETAIL SHEET	
PLOT DATE:	05-JUN-2017
DRAWN BY:	B. KIPP
CHECKED BY:	M. FOWLER
SHEET	13 OF 33