


4 INCH YELLOW LINE, WATERBORNE PAINT
 11+00 TO 15+55 SOLID RT & LT
 16+15 TO 22+00 SOLID RT & LT
 TEMPORARY 4 INCH YELLOW LINE, PAINT
 11+00 TO 15+55 SOLID RT & LT
 16+15 TO 22+00 SOLID RT & LT

4 INCH WHITE LINE, WATERBORNE PAINT
 11+00 TO 15+12 LT
 11+00 TO 15+28 RT
 16+30 TO 22+00 RT
 16+38 TO 22+00 LT
 TEMPORARY 4 INCH WHITE LINE, PAINT
 11+00 TO 15+12 LT
 11+00 TO 15+28 RT
 16+30 TO 22+00 RT
 16+38 TO 22+00 LT

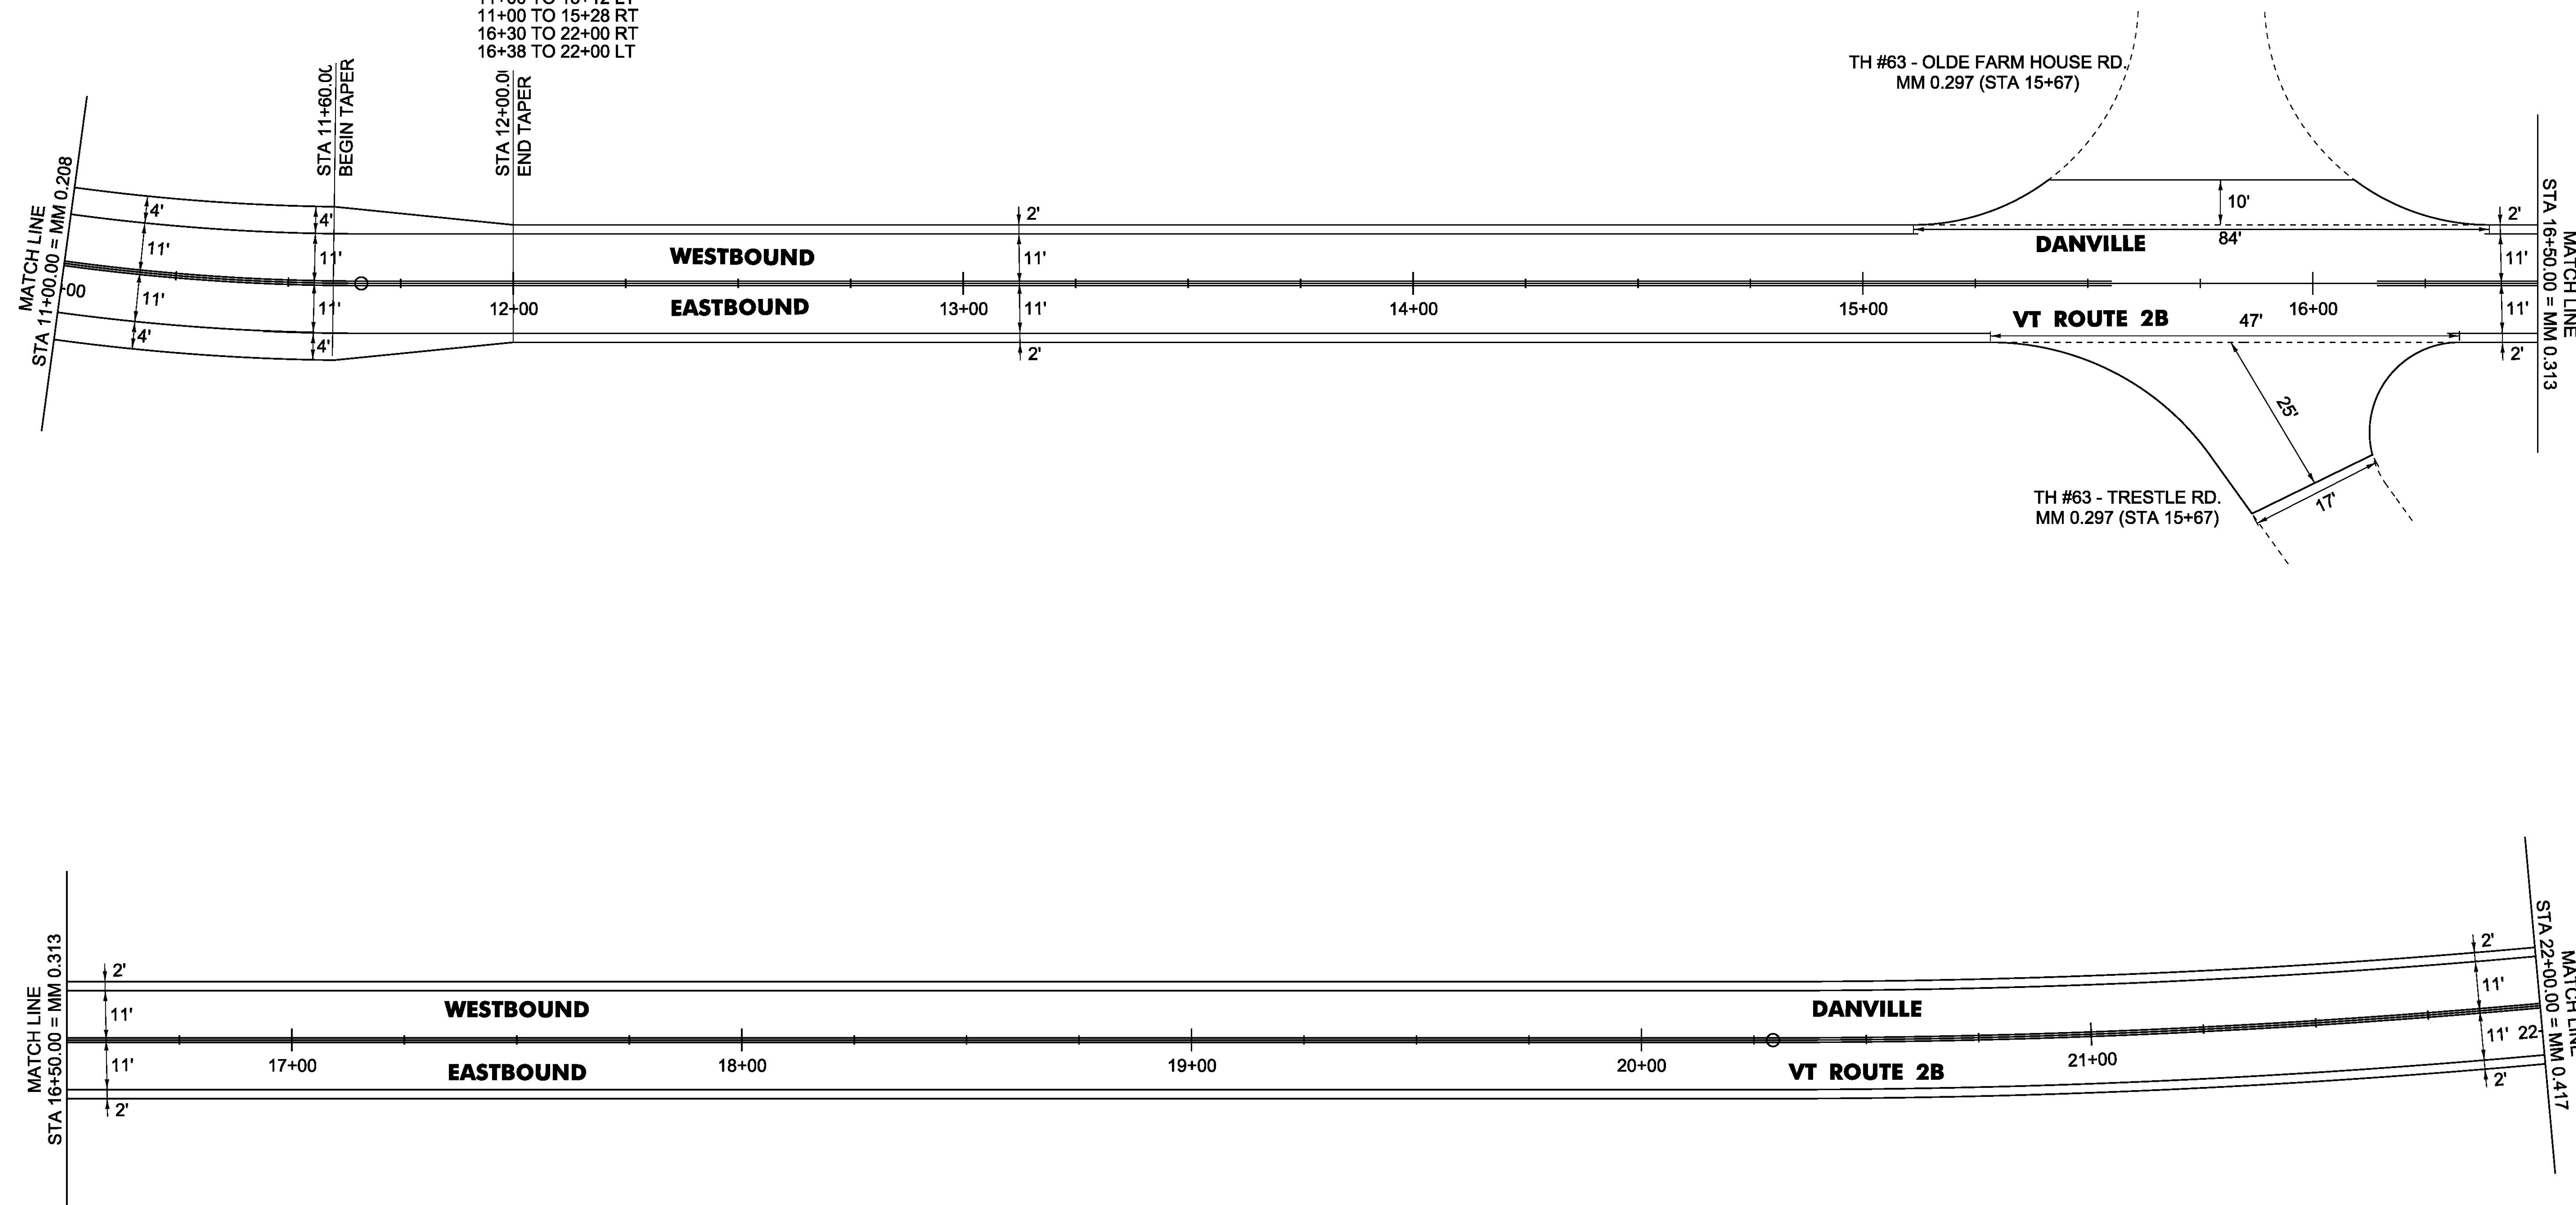

NOT TO SCALE

PROJECT NAME:	DANVILLE-ST. JOHNSBURY
PROJECT NUMBER:	STP FPAV(9)
FILE NAME:	16v148.dgn
PROJECT LEADER:	B. KIPP
DESIGNED BY:	B. KIPP
PLAN SHEET 2	
PLOT DATE:	05-JUN-2017
DRAWN BY:	B. KIPP
CHECKED BY:	M. FOWLER
SHEET 17	OF 33