

4 INCH YELLOW LINE, WATERBORNE PAINT
 22+00 TO 27+14 SOLID RT & LT
 27+54 TO 33+00 SOLID RT & LT

4 INCH WHITE LINE, WATERBORNE PAINT
 22+00 TO 33+00 SOLID LT
 22+00 TO 27+00 SOLID RT
 27+68 TO 33+00 SOLID RT

STEEL BEAM GUARDRAIL, GALVANIZED
 31+98 TO 32+12 LT
 31+98 TO 32+12 RT
 32+88 TO 33+00 LT
 32+88 TO 33+00 RT

ANCHOR FOR STEEL BEAM RAIL
 4 (SEE STANDARD G-1D)



DELINEATOR WITH STEEL POST
 31+98 RT
 31+98 LT
 33+00 LT
 33+00 RT

TEMPORARY 4 INCH YELLOW LINE, PAINT
 22+00 TO 27+14 SOLID RT & LT
 27+54 TO 33+00 SOLID RT & LT

TEMPORARY 4 INCH WHITE LINE, PAINT
 22+00 TO 33+00 SOLID LT
 22+00 TO 27+00 SOLID RT
 27+68 TO 33+00 SOLID RT

GUARDRAIL APPROACH SECTION, GALVANIZED HD STEEL BEAM
 32+12 TO 32+37 LT
 32+12 TO 32+37 RT
 32+63 TO 32+88 LT
 32+63 TO 32+88 RT

REMOVAL AND DISPOSAL OF GUARDRAIL
 31+25 TO 32+37 RT
 31+88 TO 32+37 LT
 32+63 TO 33+00 RT
 32+63 TO 33+00 LT

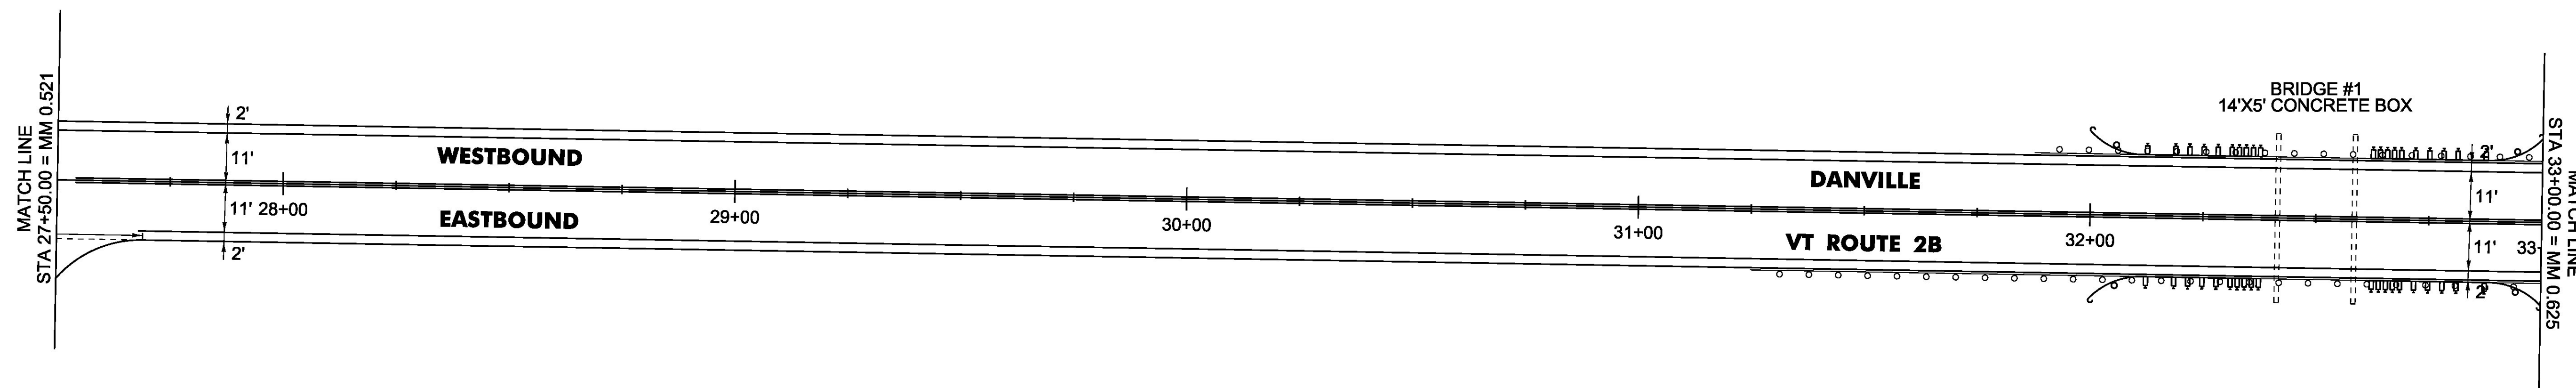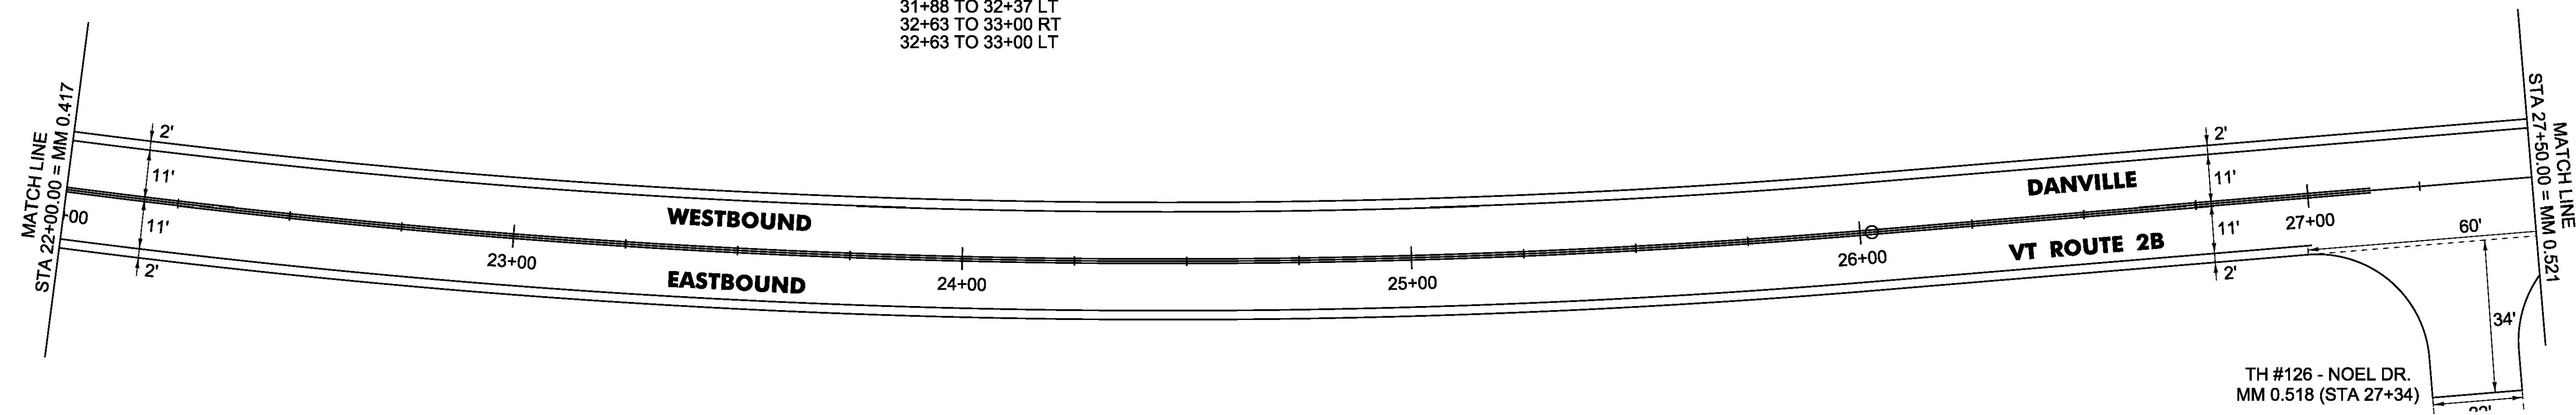

NOT TO SCALE

PROJECT NAME: DANVILLE-ST. JOHNSBURY
 PROJECT NUMBER: STP FPAV(9)

FILE NAME: 16v148.dgn PLOT DATE: 05-JUN-2017
 PROJECT LEADER: B. KIPP DRAWN BY: B. KIPP
 DESIGNED BY: B. KIPP CHECKED BY: M. FOWLER
 PLAN SHEET 3 SHEET 18 OF 33