

4 INCH YELLOW LINE, WATERBORNE PAINT
44+00 TO 55+00 SOLID RT & LT

4 INCH WHITE LINE, WATERBORNE PAINT
44+00 TO 55+00 SOLID RT & LT

4 INCH WHITE LINE, WATERBORNE PAINT
44+00 TO 55+00 SOLID RT & LT

STEEL BEAM GUARDRAIL, GALVANIZED
46+56 TO 46+68 LT
47+06 TO 47+44 LT

REMOVAL AND DISPOSAL OF GUARDRAIL
46+68 TO 47+16 LT



TEMPORARY 4 INCH YELLOW LINE, PAINT
44+00 TO 55+00 SOLID RT & LT

TEMPORARY 4 INCH WHITE LINE, PAINT
44+00 TO 55+00 SOLID RT & LT

HD STEEL BEAM GUARDRAIL, GALVANIZED
46+68 TO 47+06 LT

ANCHOR FOR STEEL BEAM RAIL
1 (SEE STANDARD G-1D)

DELINEATOR WITH STEEL POST
46+68 LT

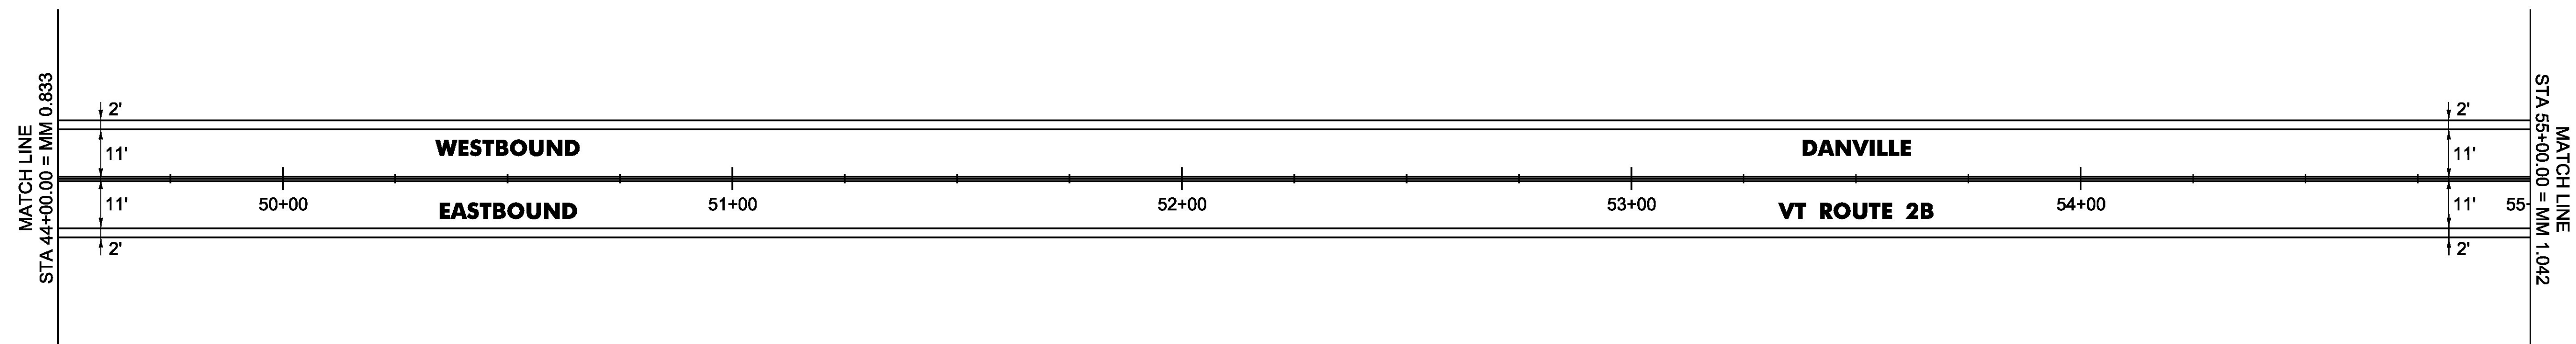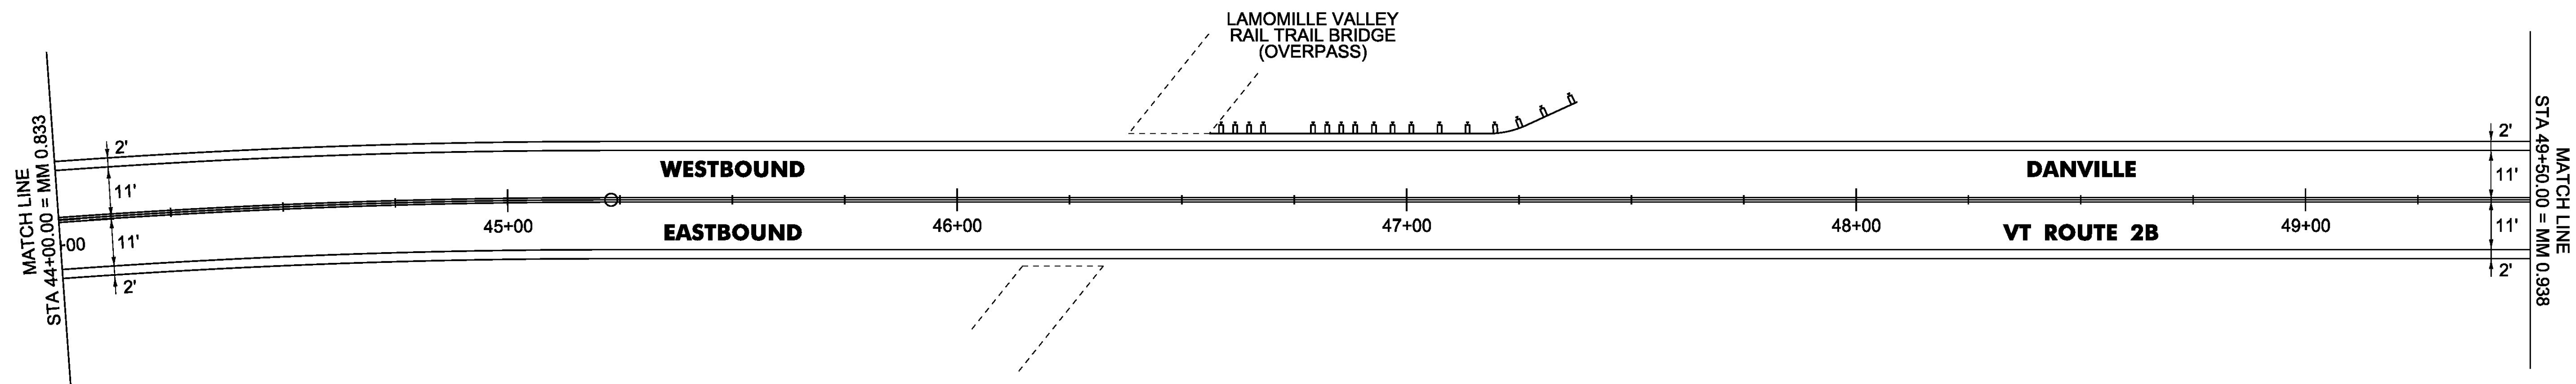

NOT TO SCALE

PROJECT NAME:	DANVILLE-ST. JOHNSBURY	PLOT DATE:	05-JUN-2017
PROJECT NUMBER:	STP FPAV(9)	DRAWN BY:	B. KIPP
FILE NAME:	16v148.dgn	CHECKED BY:	M. FOWLER
DESIGNED BY:	B. KIPP	SHEET	20 OF 33
PLAN SHEET 5			