
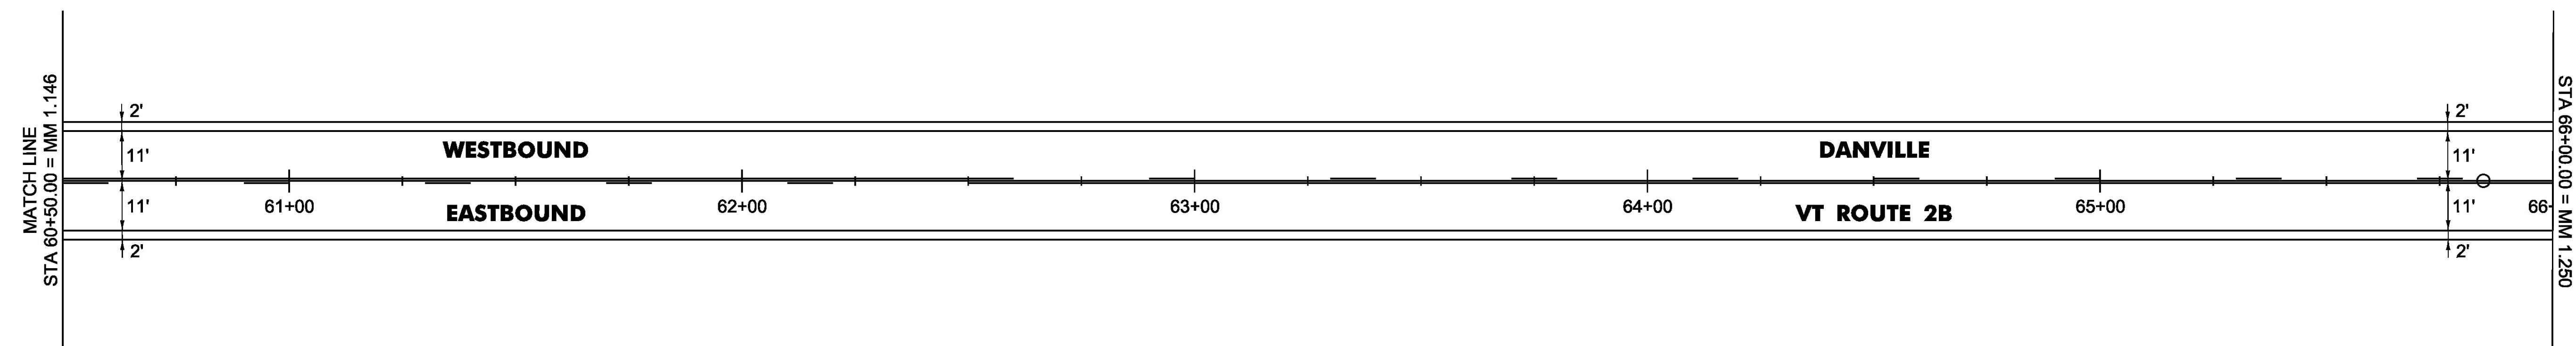


4 INCH YELLOW LINE, WATERBORNE PAINT  
 55+00 TO 56+50 SOLID RT & LT  
 56+50 TO 62+50 DASHED RT, SOLID LT  
 62+50 TO 66+00 SOLID RT, DASHED LT  
 TEMPORARY 4 INCH YELLOW LINE, PAINT  
 55+00 TO 56+50 SOLID RT & LT  
 56+50 TO 62+50 DASHED RT, SOLID LT  
 62+50 TO 66+00 SOLID RT, DASHED LT

4 INCH WHITE LINE, WATERBORNE PAINT  
 44+00 TO 55+00 SOLID RT & LT  
 TEMPORARY 4 INCH WHITE LINE, PAINT  
 44+00 TO 55+00 SOLID RT & LT

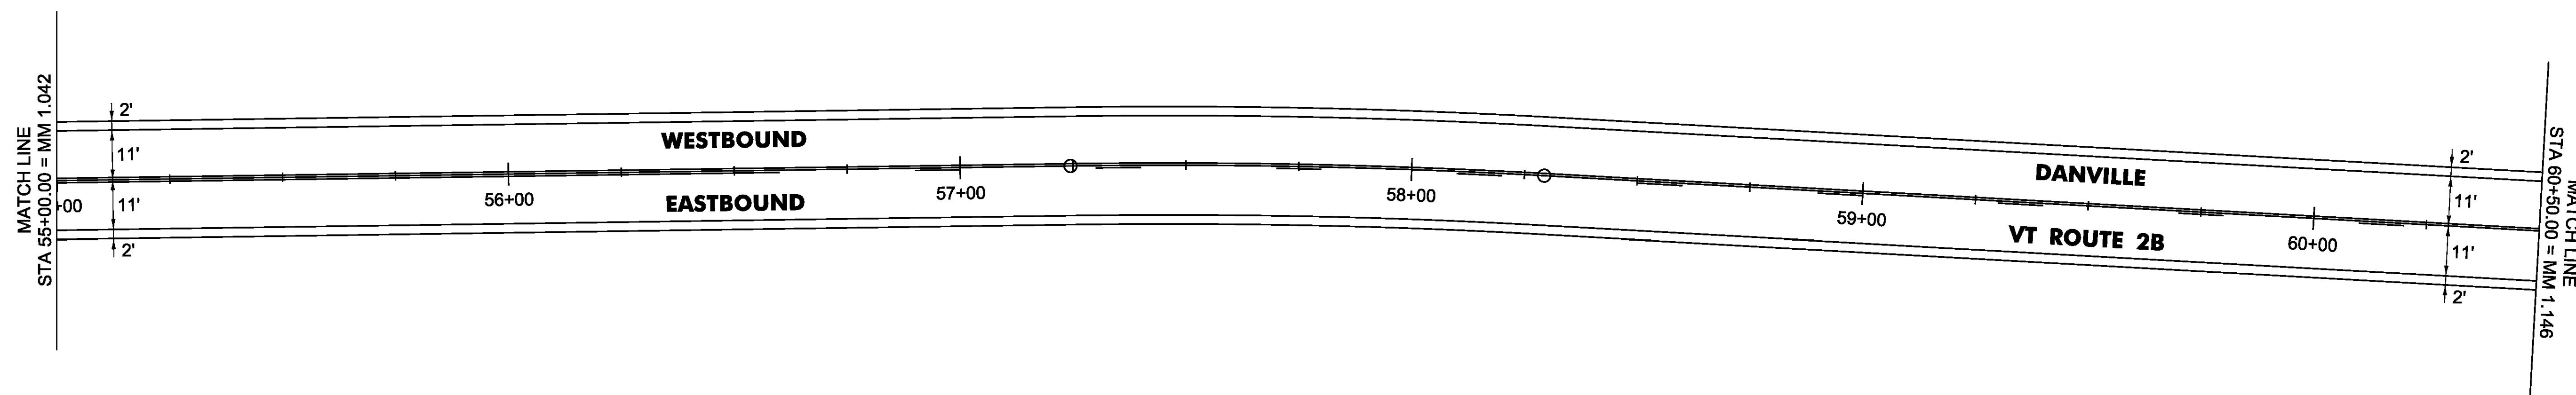

NOT TO SCALE

PROJECT NAME:	DANVILLE-ST. JOHNSBURY	PLOT DATE:	05-JUN-2017
PROJECT NUMBER:	STP FPAV(9)	DRAWN BY:	B. KIPP
FILE NAME:	16v148.dgn	CHECKED BY:	M. FOWLER
DESIGNED BY:	B. KIPP	SHEET 21	OF 33
PLAN SHEET 6			