


4 INCH YELLOW LINE, WATERBORNE PAINT  
 66+00 TO 69+16 SOLID RT, DASHED LT  
 69+16 TO 70+16 SOLID RT & LT  
 70+56 TO 77+00 SOLID RT & LT  
 TEMPORARY 4 INCH YELLOW LINE, PAINT  
 66+00 TO 69+16 SOLID RT, DASHED LT  
 69+16 TO 70+16 SOLID RT & LT  
 70+56 TO 77+00 SOLID RT & LT

4 INCH WHITE LINE, WATERBORNE PAINT  
 66+00 TO 77+00 SOLID LT  
 66+00 TO 70+00 SOLID RT  
 70+73 TO 77+00 SOLID RT  
 TEMPORARY 4 INCH WHITE LINE, PAINT  
 66+00 TO 77+00 SOLID LT  
 66+00 TO 70+00 SOLID RT  
 70+73 TO 77+00 SOLID RT

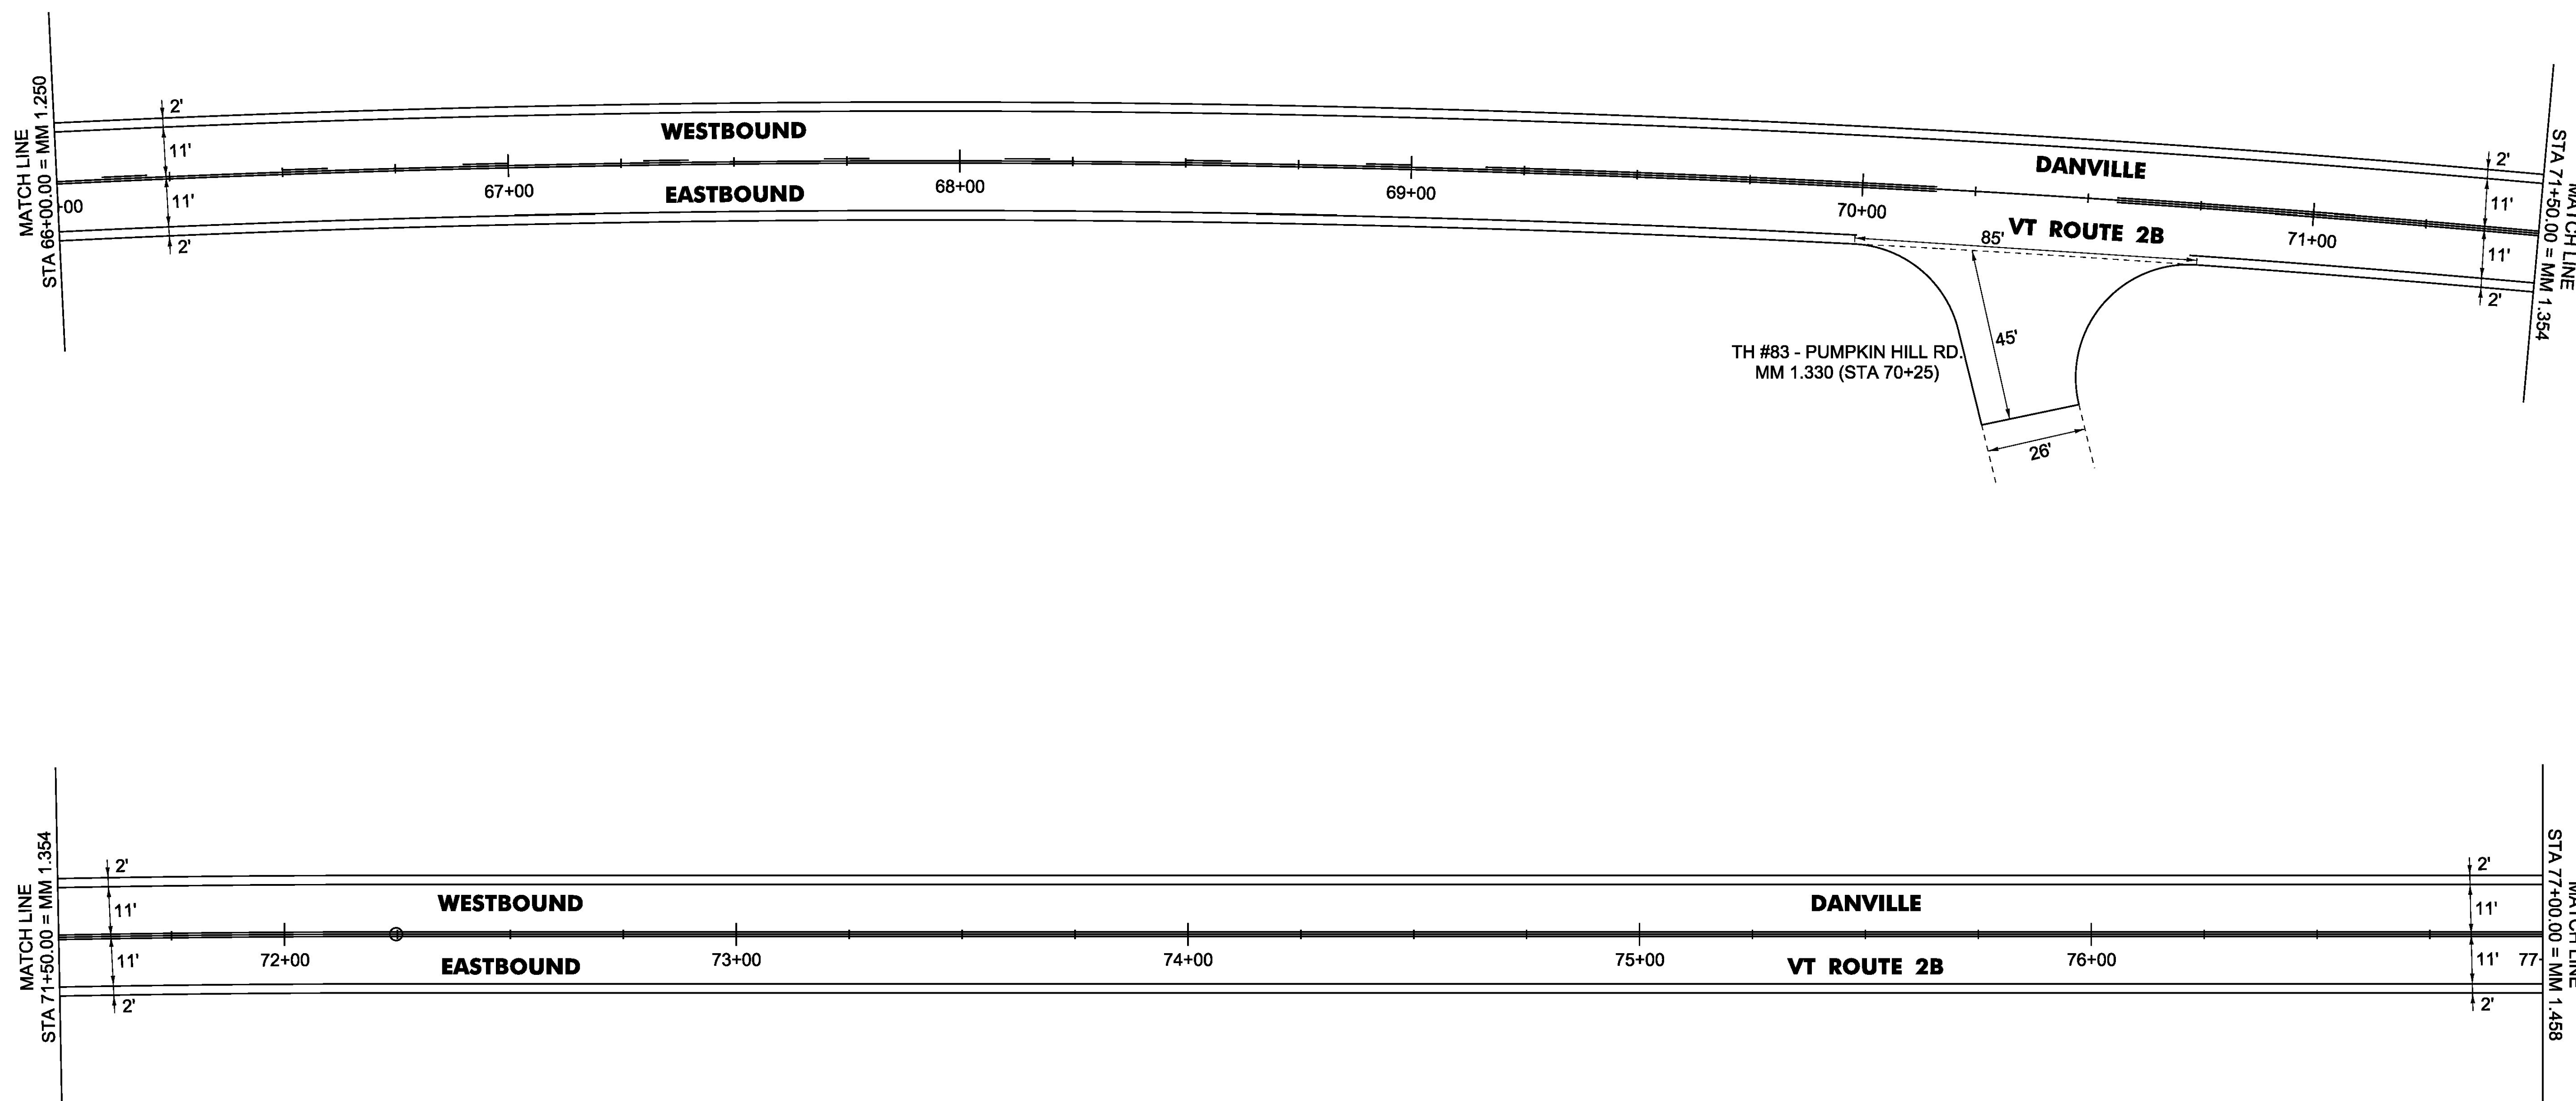

NOT TO SCALE

PROJECT NAME:	DANVILLE-ST. JOHNSBURY	PLOT DATE:	05-JUN-2017
PROJECT NUMBER:	STP FPAV(9)	DRAWN BY:	B. KIPP
FILE NAME:	16v148.dgn	CHECKED BY:	M. FOWLER
PROJECT LEADER:	B. KIPP	SHEET	22 OF 33
DESIGNED BY:	B. KIPP	PLAN SHEET	7