
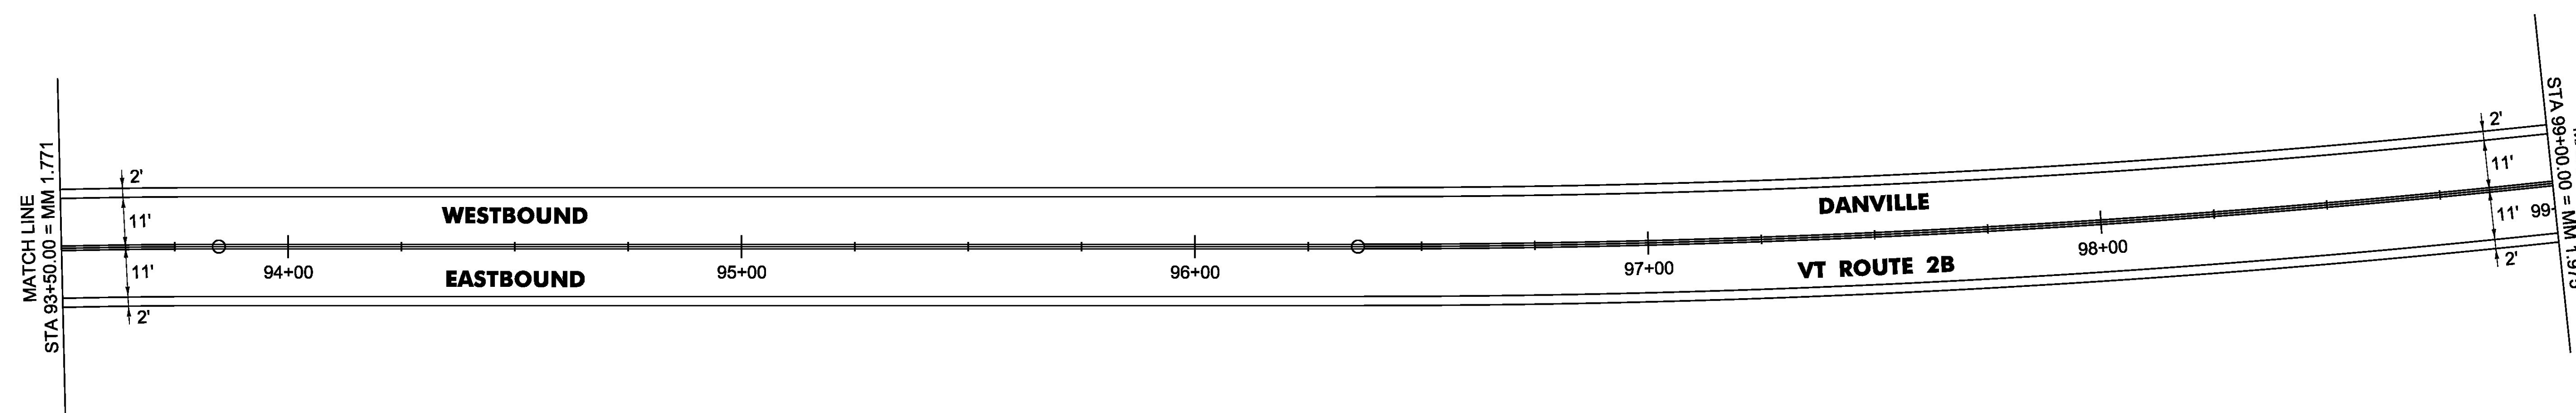


4 INCH YELLOW LINE, WATERBORNE PAINT  
88+00 TO 99+00 SOLID RT & LT

4 INCH WHITE LINE, WATERBORNE PAINT  
88+00 TO 99+00 SOLID RT & LT

TEMPORARY 4 INCH YELLOW LINE, PAINT  
88+00 TO 99+00 SOLID RT & LT

TEMPORARY 4 INCH WHITE LINE, PAINT  
88+00 TO 99+00 SOLID RT & LT

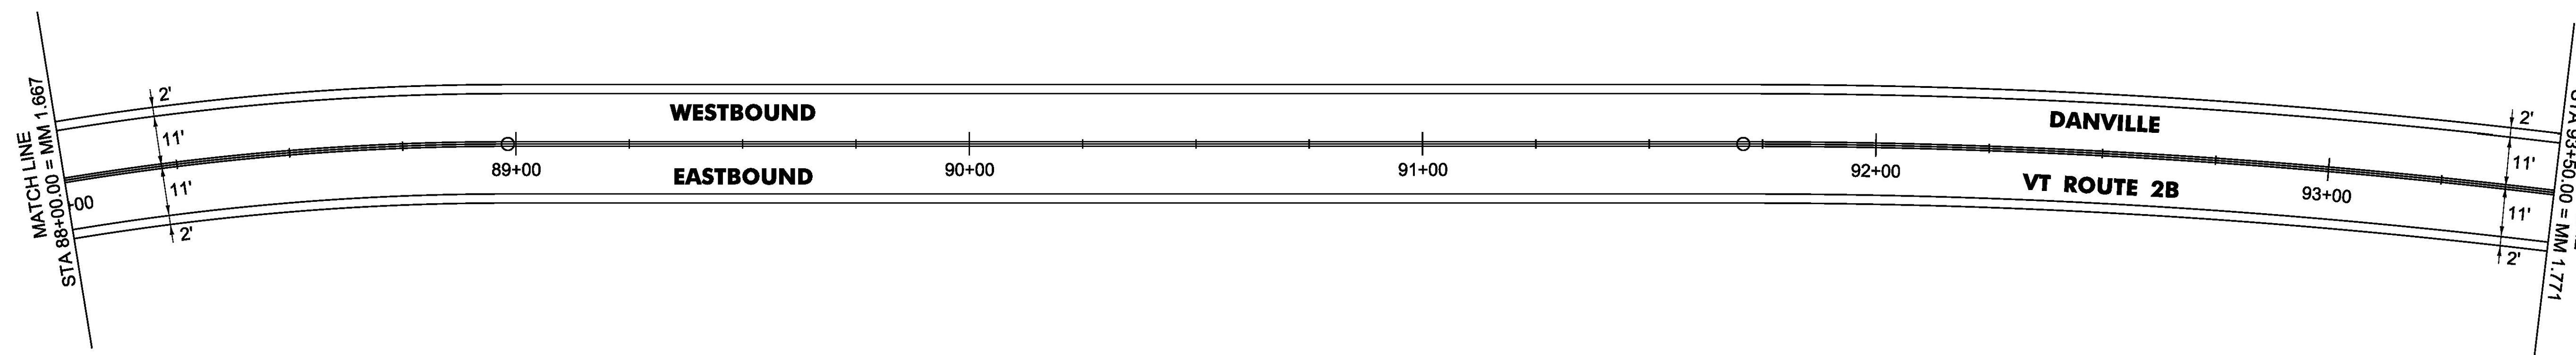

NOT TO SCALE

PROJECT NAME: DANVILLE-ST. JOHNSBURY  
PROJECT NUMBER: STP FPAV(9)

FILE NAME: 16v148.dgn	PLOT DATE: 05-JUN-2017
PROJECT LEADER: B. KIPP	DRAWN BY: B. KIPP
DESIGNED BY: B. KIPP	CHECKED BY: M. FOWLER
PLAN SHEET 9	SHEET 24 OF 33